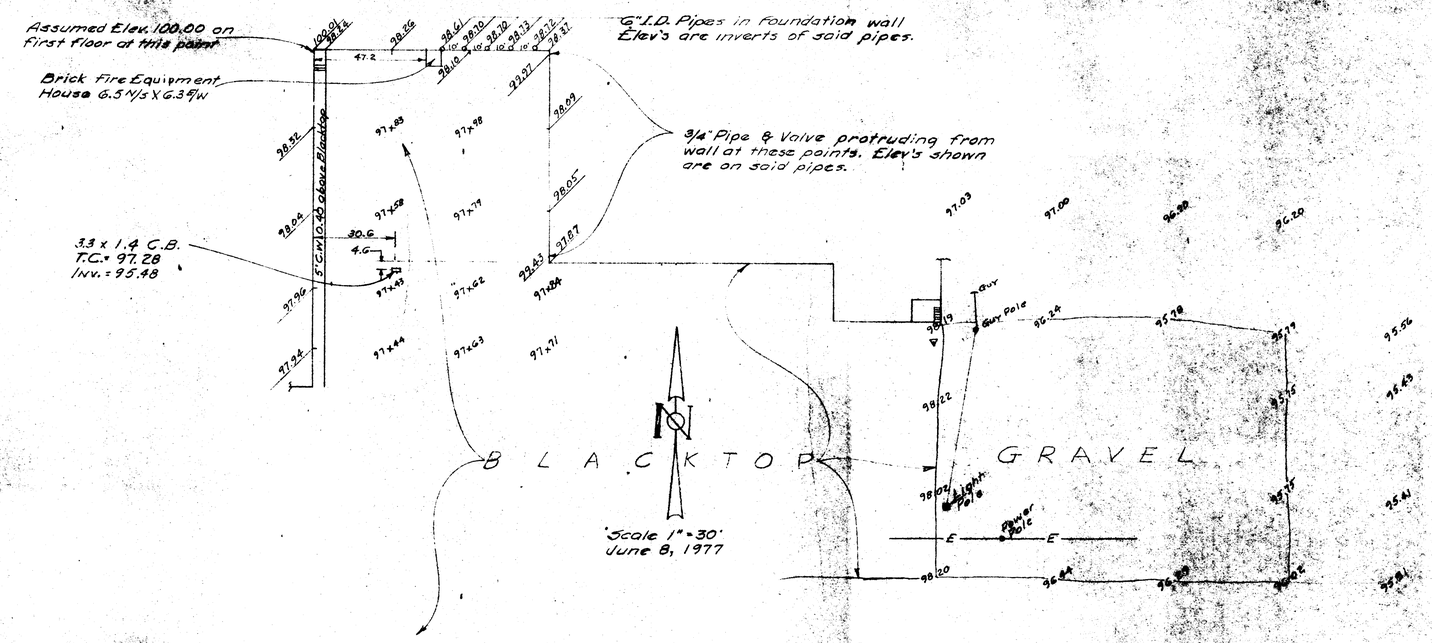

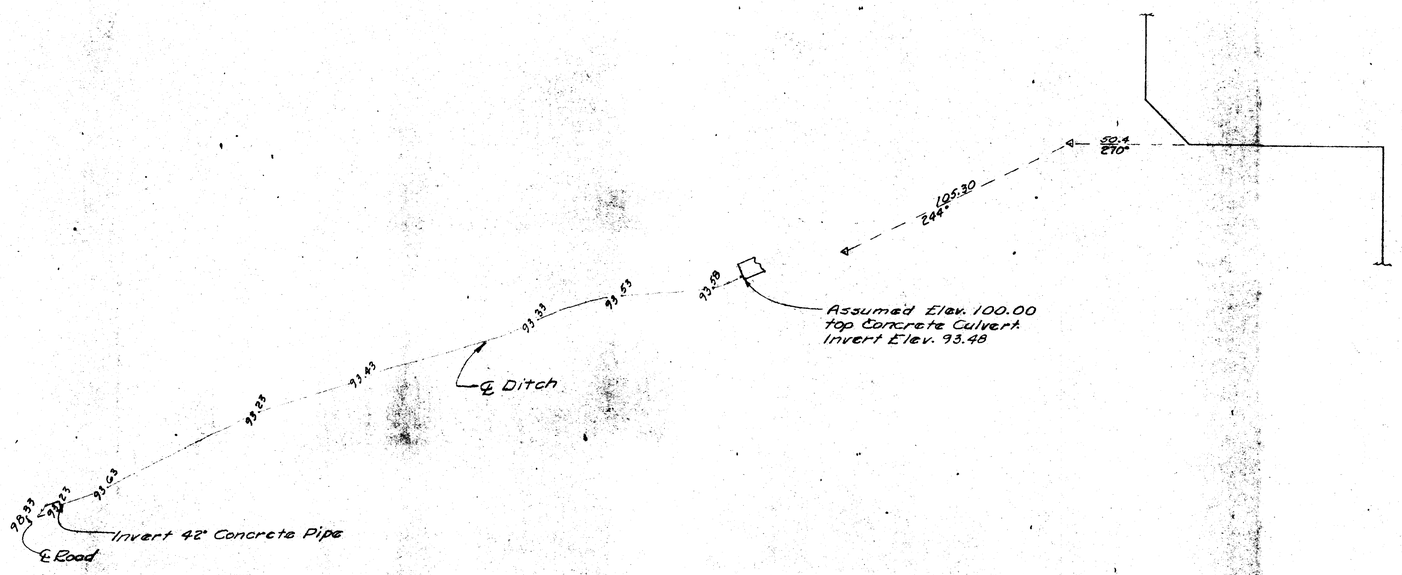

Topo - Kroger Warehouse
Poth Rd.
Tracing to Curt Lindberg June 8/77