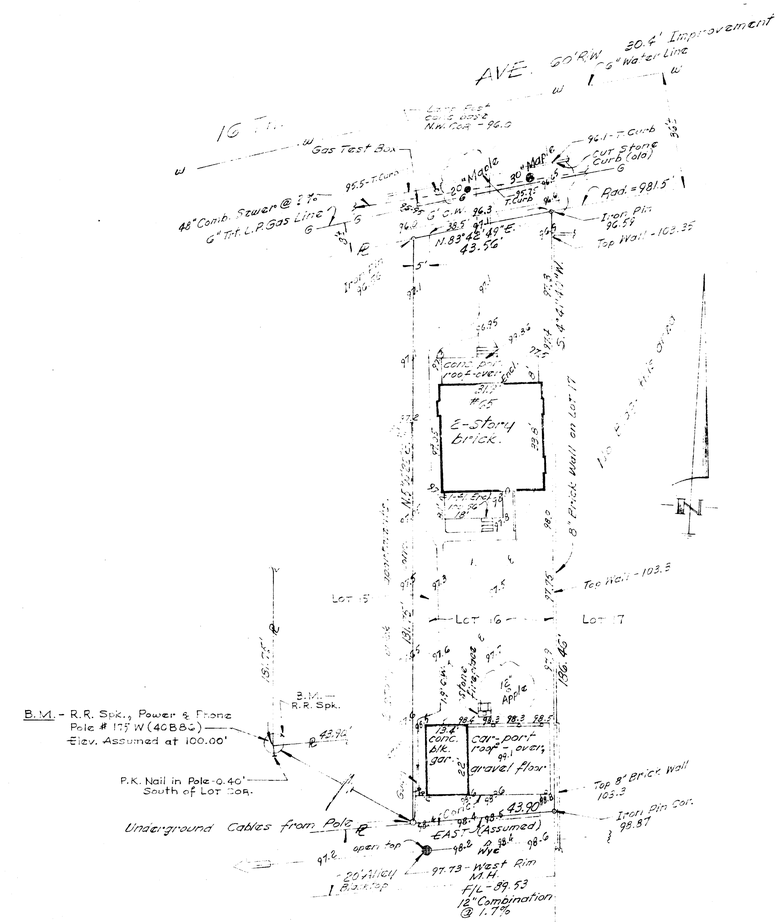

Topo. and Survey Map showing No. 65 E. 16th AVE., Columbus, Ohio, being LOT 16 and 5.0 ft. off the East Side LOT 15, of UNOLA ADDITION, plat book 7, page 130, Recorder's Office, Franklin County, Ohio.

Nov. 18, 1971 Scale 1" = 20'

Harry L. Greene

Harry L. Greene, Reg. Surveyor - No. 4058.