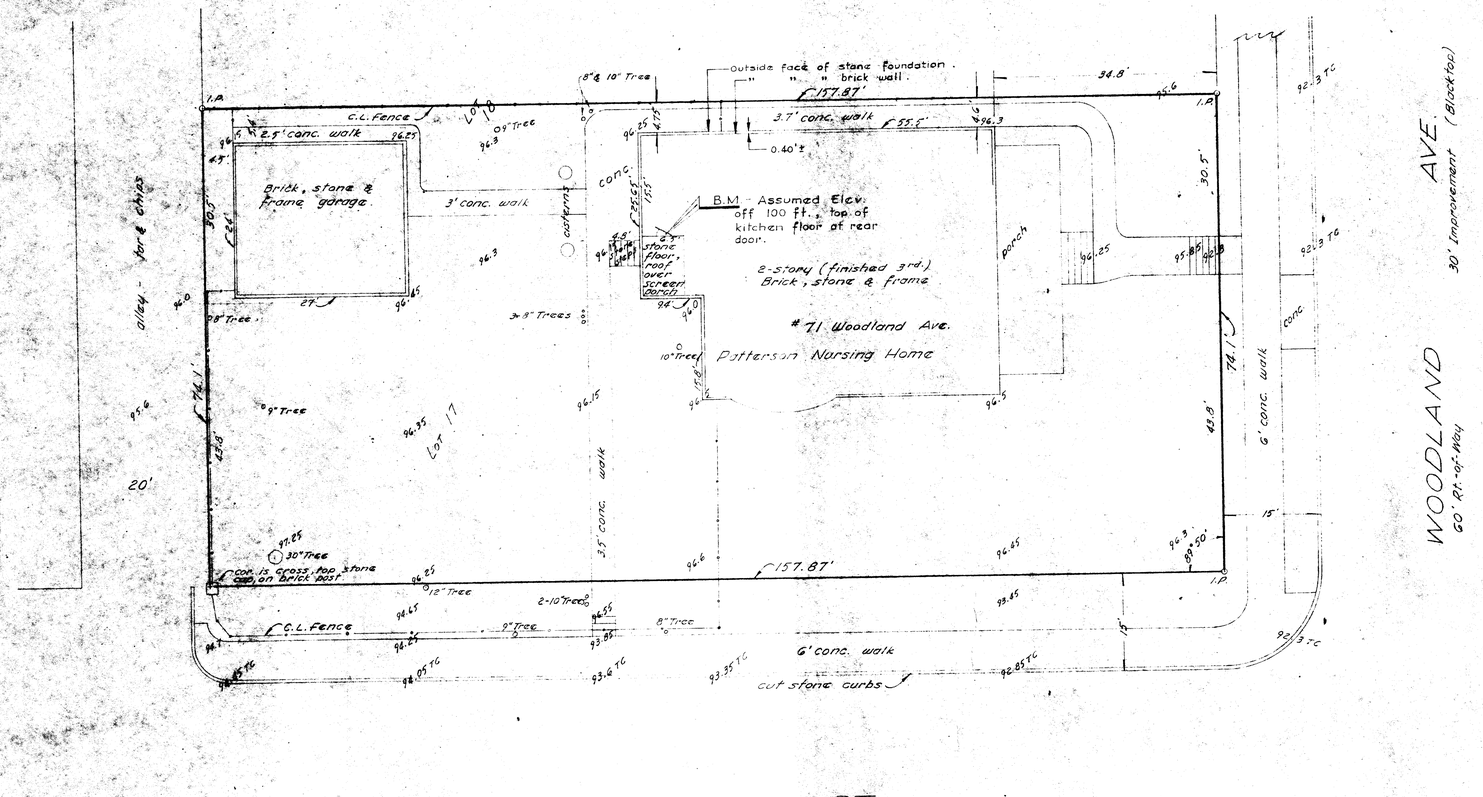


Plat showing survey and topo of Lot 17 & 30' off south side of Lot 18 of CALENDER and ROCKWELLS SUBDIVISION of Lots Nos. 15, 16, 17, 18 of Keyes Barr's North Addition to Eastwood, City of Columbus, Ohio, of record in Plat Book 4, pg. 175, Recorders Office, Franklin County, Ohio.

Harry L. Green
Harry L. Green, Reg. Surveyor No. 4058

121 A.