


Aug. 31, 1972
 Scale 1 in. = 10 ft. 0 in.
 Revised June 4, 1972

Decimal Point in Elev. Figure represents location of shot, unless shown otherwise.
 Small plantings and underground utilities not shown.
 T.C. - Top Curb

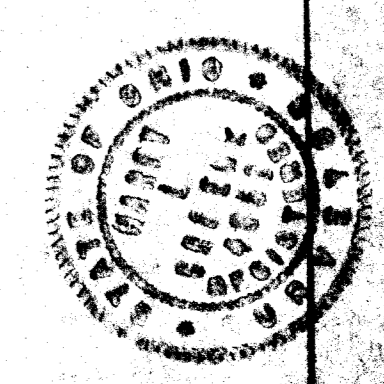


AVE.

URLIN

RIDGEWAY

PL

LOT 20 RESERVE NO. 3

Blacktop Drive

#1100

garage 3-car

B.M. - Assumed Elev. of 100.00 ft on top of conc. step at foundation

2-story brick & frame

conc. walk

concrete patio

outside bsmt. entrance

5' conc. walk

5' conc. walk

5' conc. walk

conc. apron

50' Right-of-Way

Power & Phone Pole

42" C.L. Fence

T&E Service

roof over

concrete storage

concrete

concrete

