


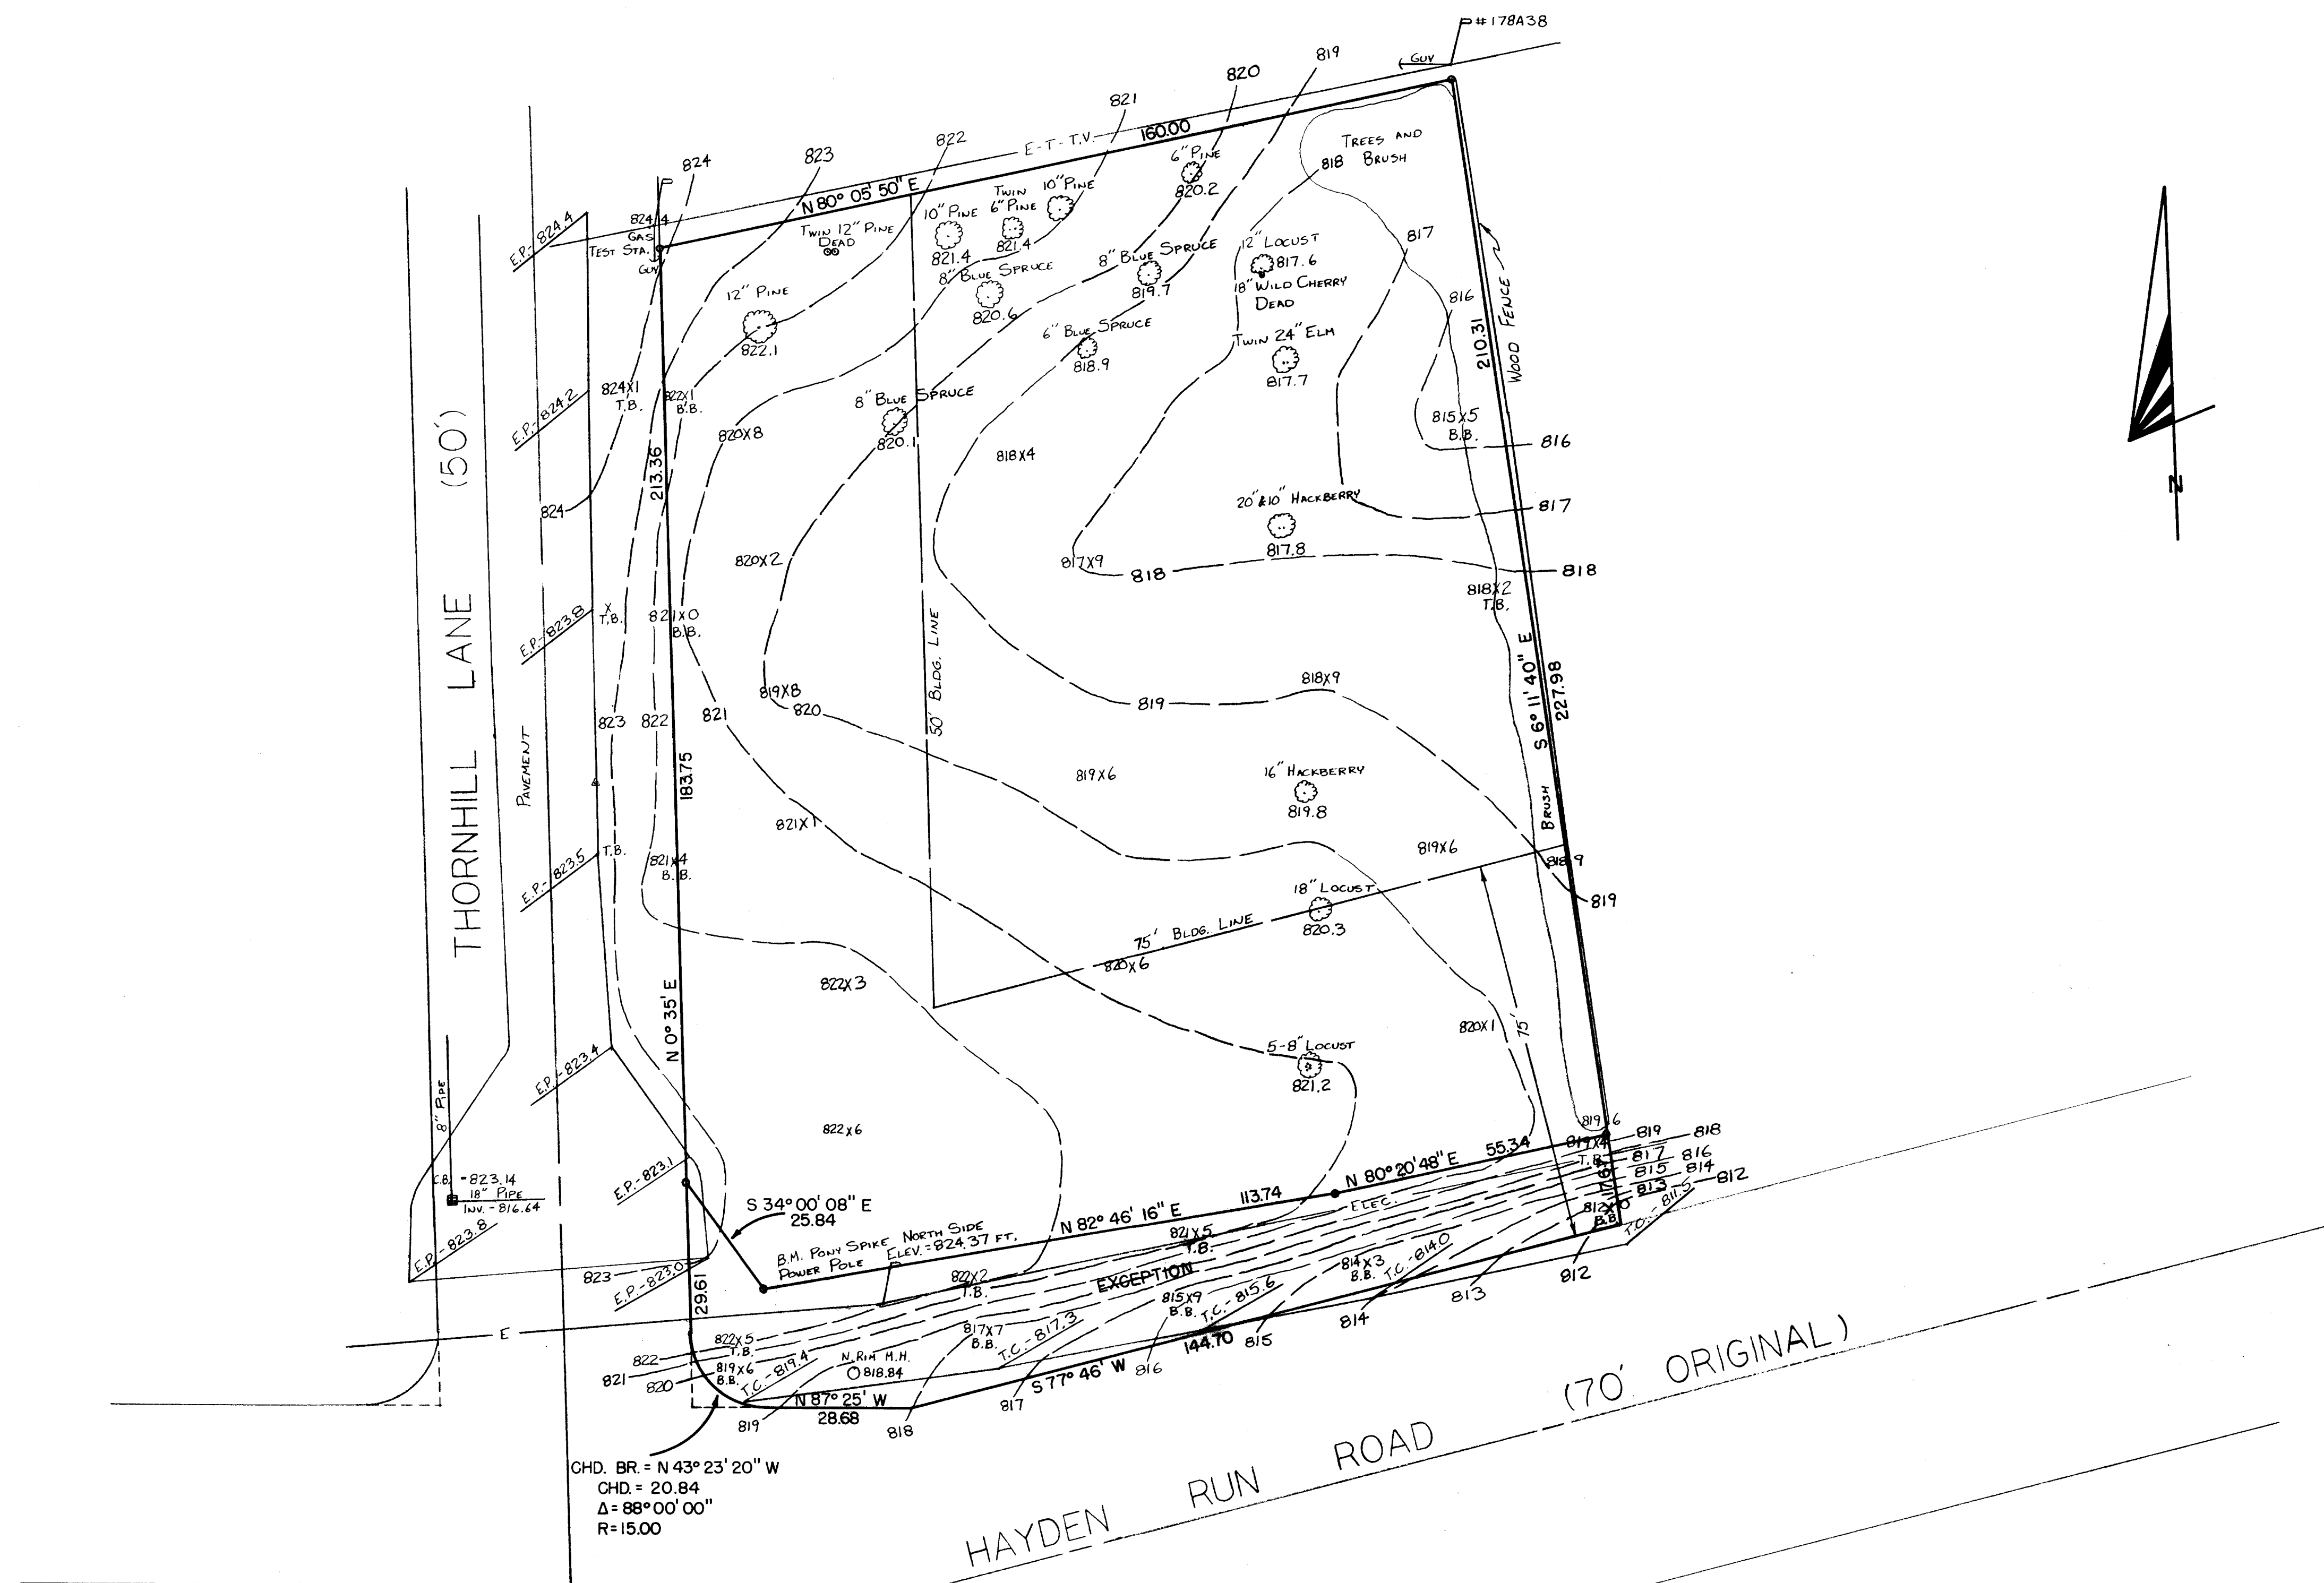

PLAT SHOWING TOPO OF LOT 17 OF HAYDEN FARMS
ADDITION (PLAT BOOK 26, PAGE 22, RECORDER'S OFFICE,
FRANKLIN COUNTY, OHIO) AND ITS RIGHT-OF-WAY EXCEPTION
FOR HAYDEN RUN ROAD, LOCATED IN THE VILLAGE OF
DUBLIN, FRANKLIN COUNTY, OHIO.

SCALE: 1" = 20' AUGUST 12, 1987

Harry L. Greene
HARRY L. GREENE, REGISTERED SURVEYOR-NO. 4058

116-K