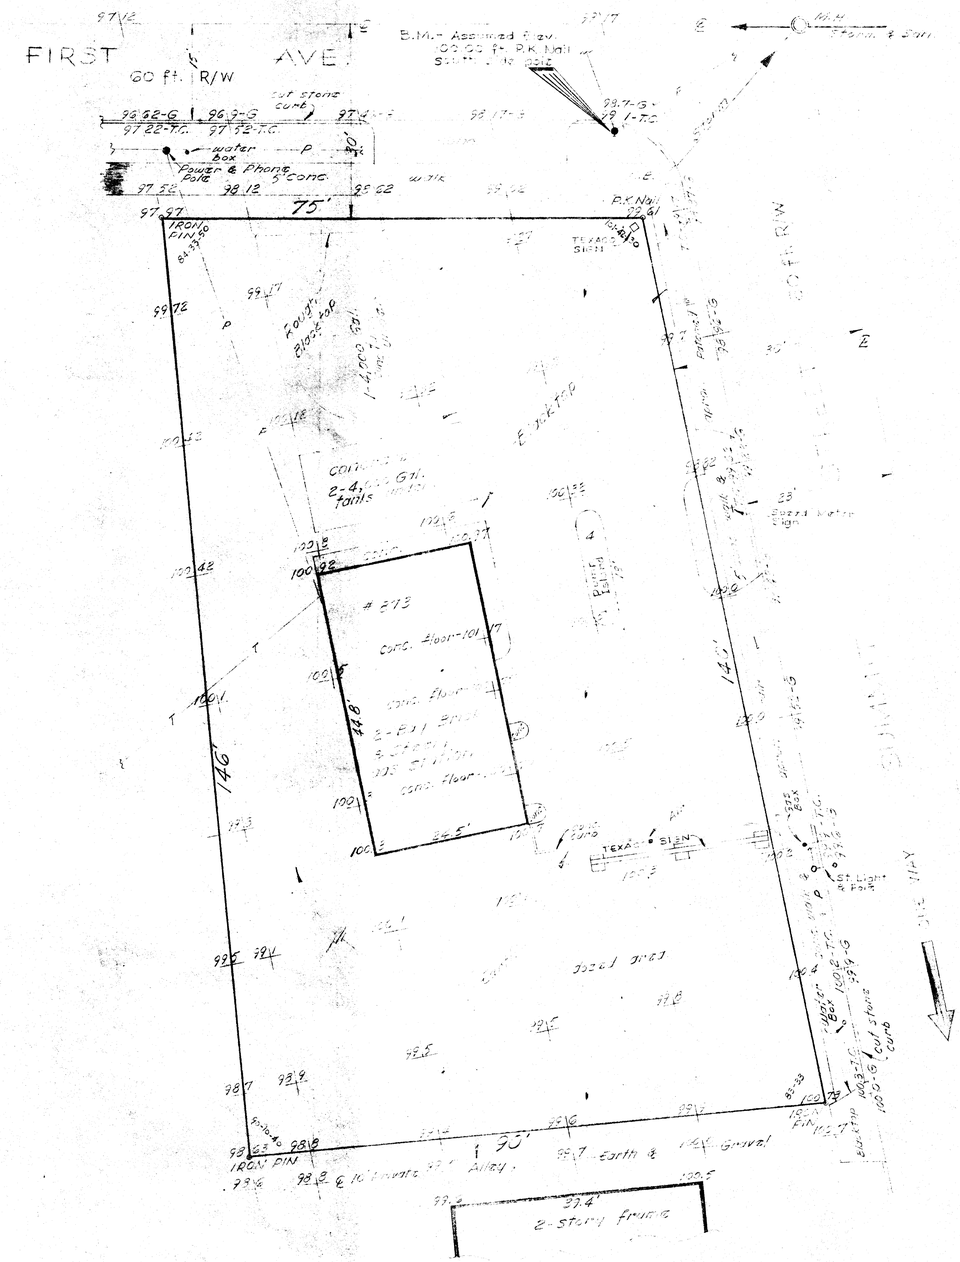

July 12 - 1967
Scale 1 inch = 10 feet.

P - Power
T - Telephone
G - Gutter
T.C. - Top Curb.

Underground utilities not shown,
For Mr. Steve Butsko.

TOPO MAP, 20 ft. Grid Sections, showing an existing TEXACO Service Station, City of Columbus, Franklin County, Ohio
Southwest Corner FIRST AVE. & SUMMIT STREET. -- for --
TEXACO

Harry L. Greene
Harry L. Greene, Reg. Surveyor No. 4058.

114-B