



# STRINGTOWN ROAD

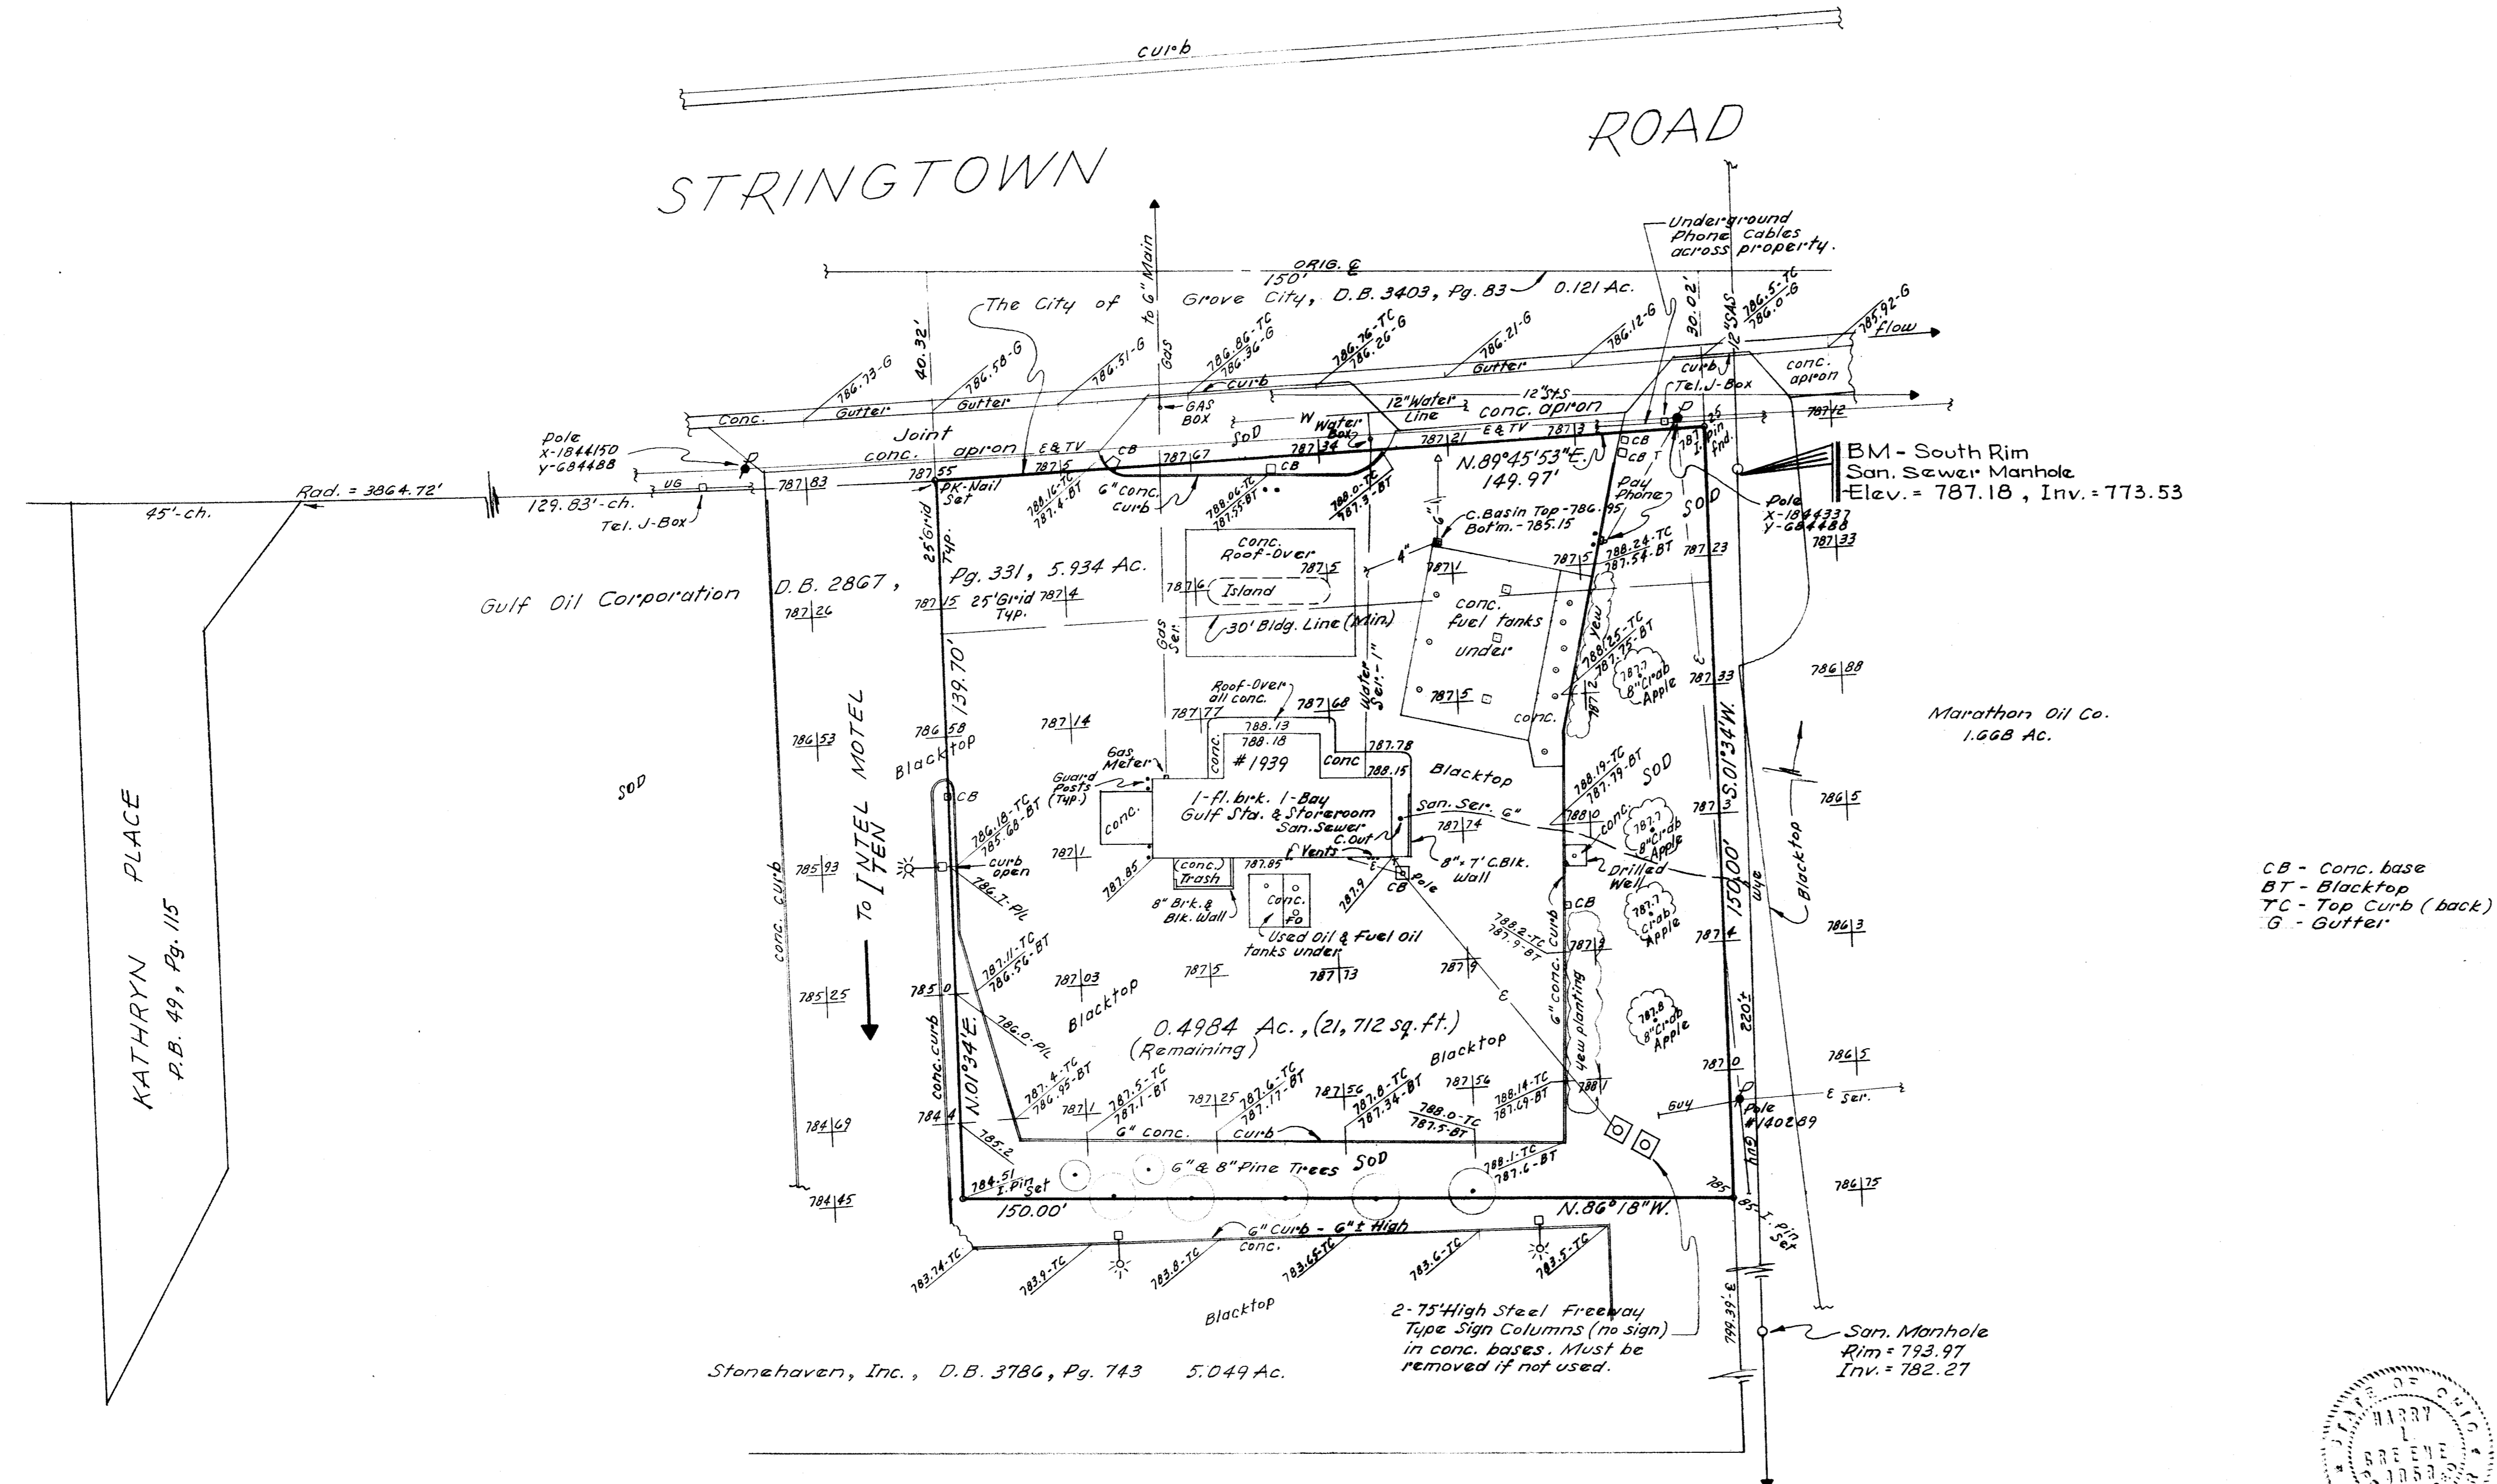

CB - Conc. base  
 BT - Blacktop  
 TC - Top Curb (back)  
 G - Gutter

Plat showing survey and topo, 0.4984 Acre Tract, City of Grove City, Ohio, on property of Gulf Oil Corporation, of record in D.B. 2867, Pg. 331, Recorder's Office, Franklin County, Ohio.

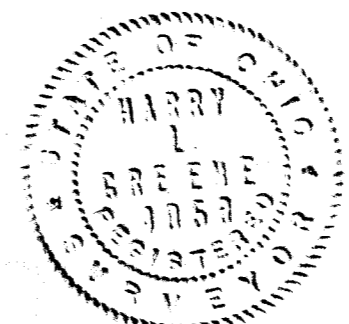

for  
 G. D. Ritzky's Inc.  
 Harry L. Greene, Reg. Surveyor - 4058. Ph. 486-0714  
 1" = 20'  
 April 20-83