
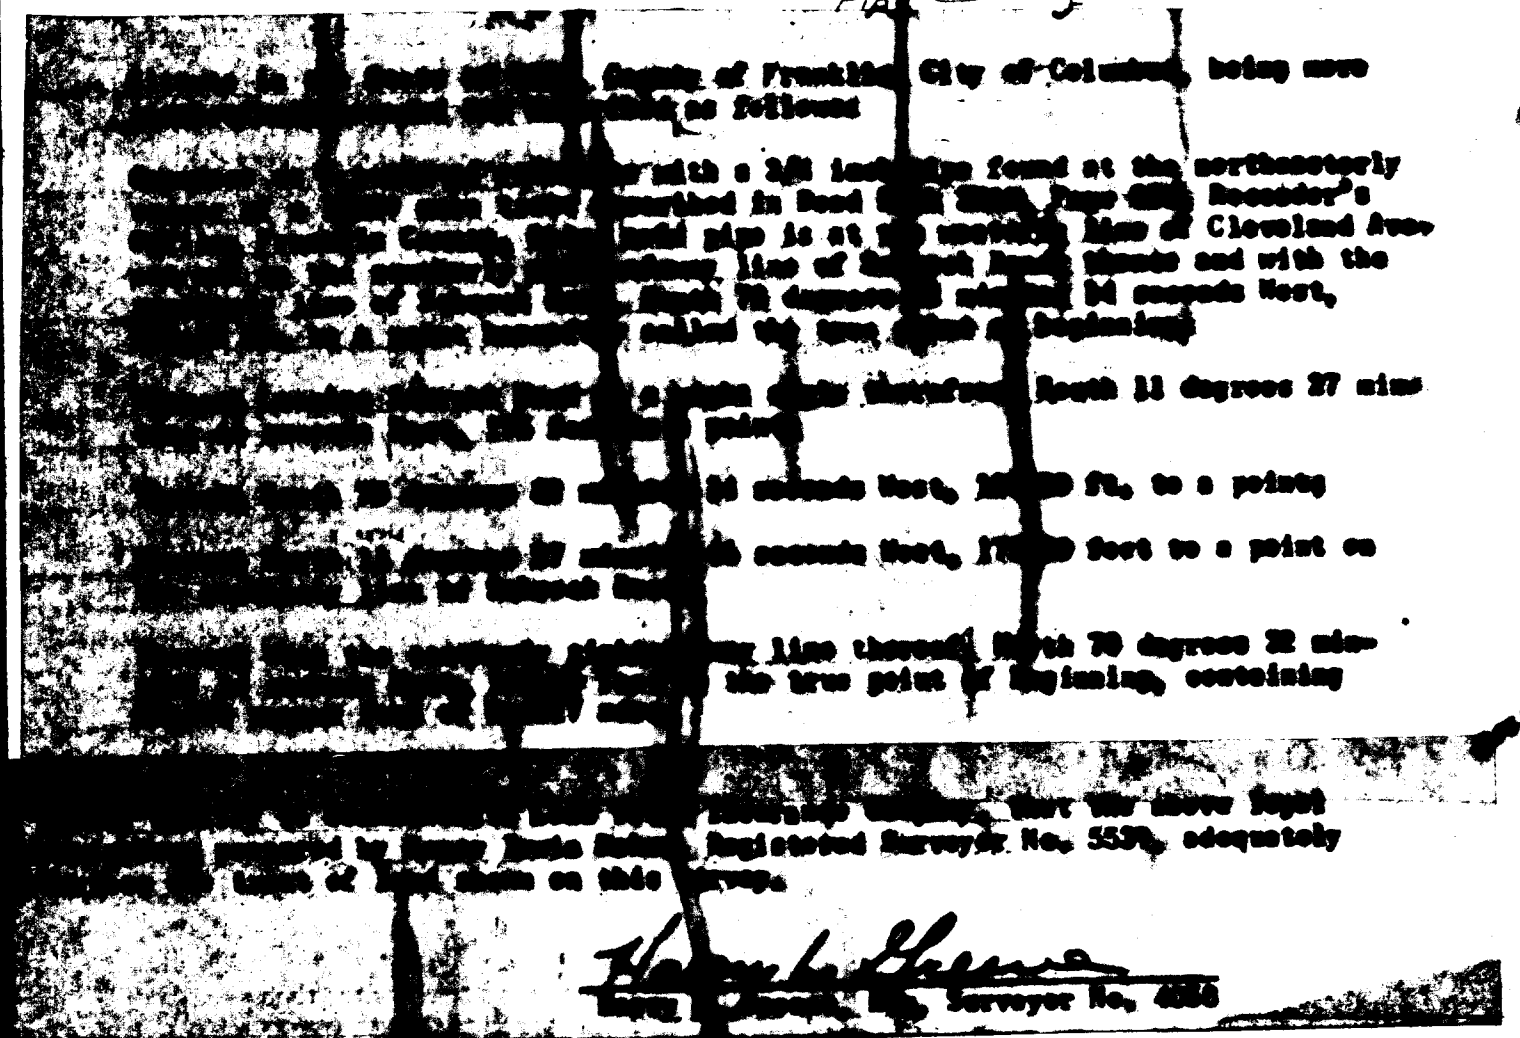


Bench Mark No. 1
Top of concrete, N. side of Wendy's.
Elev. = 861.38

Bench Mark No. 2
Chiseled square on S.E. corner of concrete
base for metal shed, Union 76 gasoline
station, N.W. corner Cleveland Ave. and
Schrock Road.
Elev. = 861.43

NOTE: The information shown on the attached
drawing was prepared from a field survey
and from record plans.

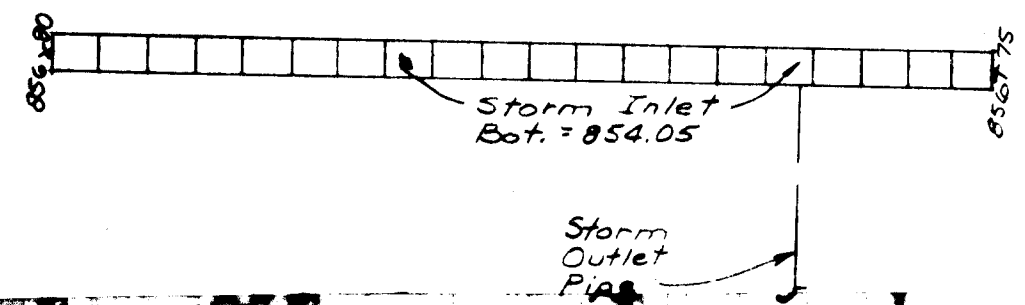

Plat showing "AS-BUILT SURVEY" of a 0.4017 acre
tract and being a part of Flag Center Shopping Center,
Schrock Road, Columbus, Ohio.

May 23, 1985
Revised December 22, 1988

Scale: 1" = 10'

Harry L. Green, Reg. Surveyor No. 4058

