


KENNY HEIGHTS ADDITION

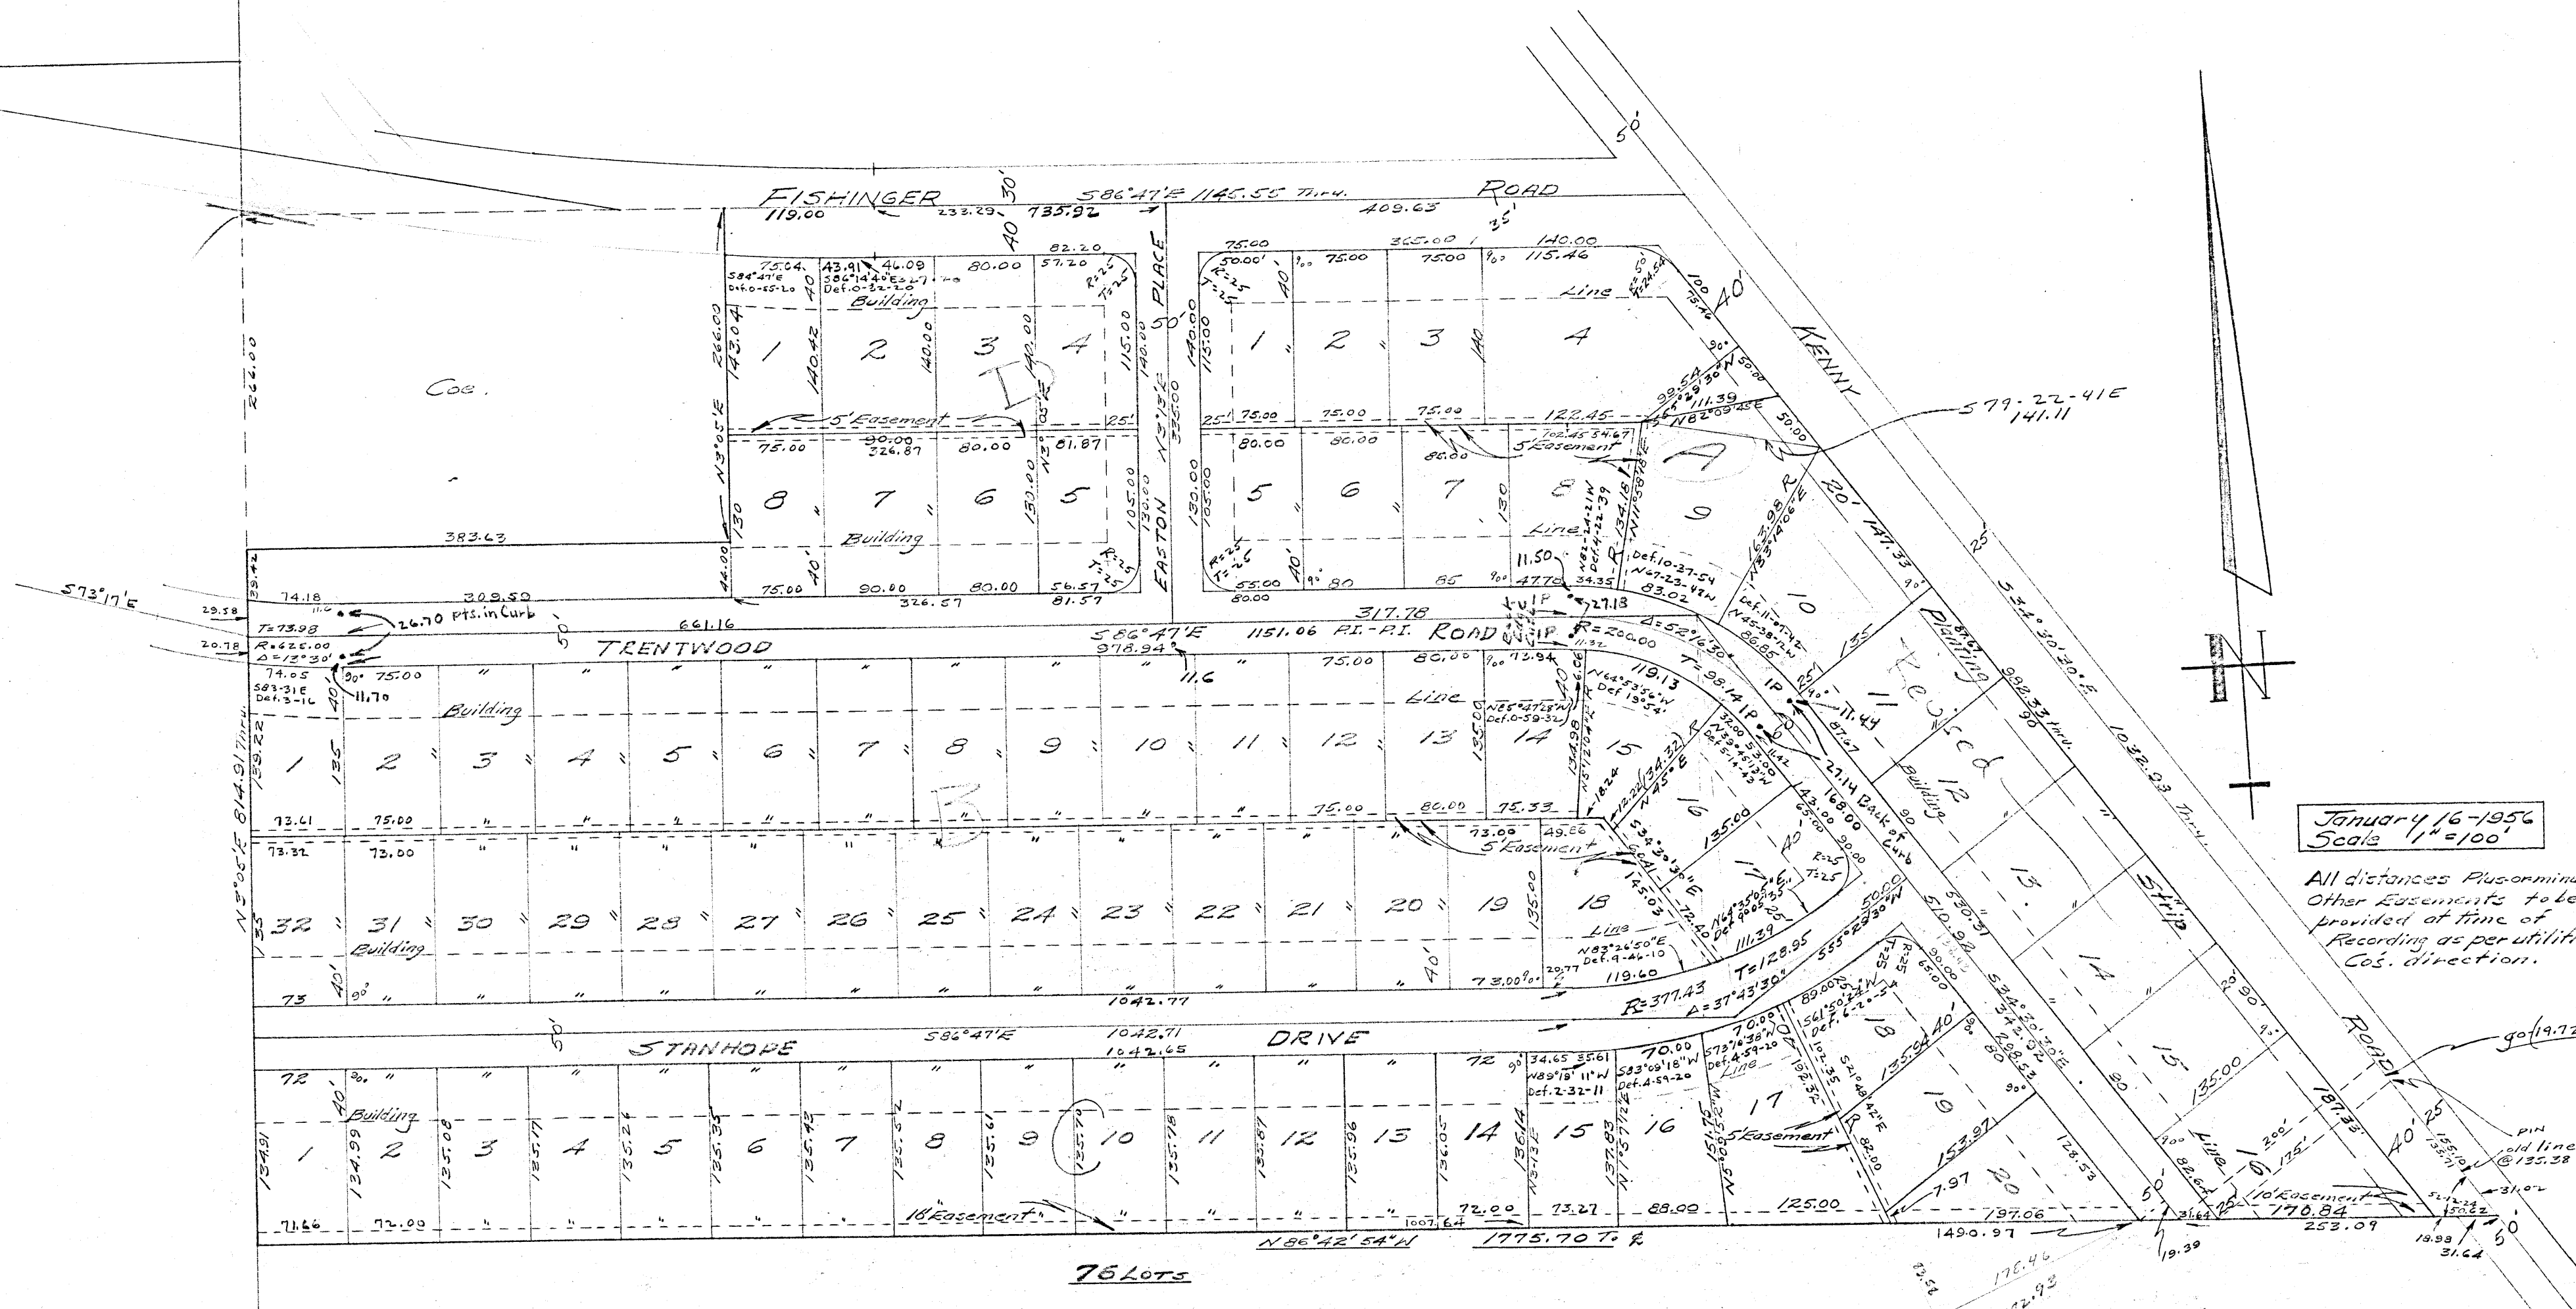

January 16-1956
Scale 1"=100'

All distances Plus or Minus.
Other Easements to be
provided at time of
Recording as per utilities
Co's. direction.