

FRANKLIN COUNTY, OHIO


FRANKLIN TOWNSHIP

U. S. MILITARY DISTRICT

SCHEDULE OF SIDINGS AND CROSSOVERS

Side Track Number	Location	Class	Length June 30, 1928 R.R. Co. Private	Total	Remarks
5	Grandview Heights School Dist	P	7 5 7	7 5 7	See Map No 5
7		B	1 5 6	1 5 6	Unknown Unknown
9		V			See Map No 5
16 A		Y			See Map No 5
18		P	1 6 6	1 6 6	See Map No 5
5	Grandview Heights Corp.	P	1 7 2	1 7 2	See Map No 5
18		Y	1 9 2	1 9 2	See Map No 5
01			4 6 0	4 6 0	Added 6-30-20
26			5 0	5 0	Added 6-30-20
6 5					See Map No 5 Added 6-30-20
6 6					See Map No 5 Added 6-30-20
ROLL 6 IMAGE 1

 

COLUMBUS

P.C.L. 702  
23.659 AC.  
GRANDVIEW HTS.  
CITY

COLUMBUS

P.C.L. 100751. 26.248 AC.  
COLS. CORP.

PHILA. BALTO. & WASHINGTON R. R.  
FORMERLY

RIGHT OF WAY AND TRACK MAP  
PITTSBURGH, CINCINNATI, CHICAGO & ST. LOUIS RY.

STATION 105+60 TO STATION 156+40  
SCALE 1"=100' ONE SQUARE

OFFICE OF ENGINEERING  
PHILADELPHIA, PA.



ROLL 6 IMAGE 2

Side Track Number	Location	Class	Length June 30, 1935	Remarks

SCHEDULE OF SIDINGS AND CROSSOVERS

Side Track Number	Location	Class	Length June 30, 1935	Remarks

FRANKLIN COUNTY, OHIO  
U. S. MILITARY DISTRICT  
FRANKLIN TOWNSHIP

 

ROLL 6 IMAGE 3


NO.	REVISED
1927	
1928	
- Correct as of Dec. 31st, 1955-Map Revised
- Correct as of Dec. 31st, 1954-Map Revised
- Correct as of Dec. 31st, 1953-No Revision
- Correct as of Dec. 31st, 1952-No Revision
- Correct as of Dec. 31st, 1951-No Revision
- Correct as of Dec. 31st, 1950-Map Revised
- Correct as of Dec. 31st, 1949-Map Revised
- Correct as of Dec. 31st, 1948-No Revision
- Correct as of Dec. 31st, 1947-Map Revised
- Correct as of Dec. 31st, 1946-Map Revised
- Correct as of Dec. 31st, 1945-Map Revised
- Correct as of Dec. 31st, 1944-No Revision
- Correct as of Dec. 31st, 1943-No Revision
- Correct as of Dec. 31st, 1942-Map Revised
- Correct as of Dec. 31st, 1941-Map Revised
- Correct as of Dec. 31st, 1940-Map Revised
- Correct as of Dec. 31st, 1939-No Revision
- Correct as of Dec. 31st, 1938-Map Revised
- Correct as of Dec. 31st, 1937-Map Revised
- Correct as of Dec. 31st, 1936-Map Revised
- Correct as of Dec. 31st, 1935-Map Revised
- Correct as of Dec. 31st, 1934-Map Revised
- Correct as of Dec. 31st, 1933-No Revision
- Correct as of Dec. 31st, 1932-Map Revised
- Correct as of Dec. 31st, 1931-Map Revised
- Correct as of Dec. 31st, 1930-Map Revised
- Correct as of Dec. 31st, 1929-Map Revised
- Correct as of Dec. 31st, 1928-Map Revised
- Correct as of Dec. 31st, 1927-Map Revised
- Correct as of Dec. 31st, 1926-Map Revised
- Correct as of Dec. 31st, 1925-Map Revised
- Correct as of Dec. 31st, 1924-Map Revised
- Correct as of Dec. 31st, 1923-Map Revised
- Correct as of Dec. 31st, 1922-Map Revised
- Correct as of Dec. 31st, 1921-Map Revised
- Correct as of Dec. 31st, 1920-Map Revised
- Correct as of Dec. 31st, 1919-Map Revised
- Correct as of Dec. 31st, 1918-Map Revised
- Correct as of Dec. 31st, 1917-Map Revised

PHILA. BALTO. & WASHINGTON R. R.  
FORMERLY  
RIGHT OF WAY AND TRACK MAP  
PITTSBURGH, CINCINNATI, CHICAGO & ST. LOUIS RY.  
INDIANAPOLIS DIVISION

Sheet No. 5 V.A. Ohio, of Pittsburgh, Cincinnati, Chicago & St. Louis Railway, from Survey Station 52180 to Survey Station 105400.

FRANKLIN COUNTY, OHIO

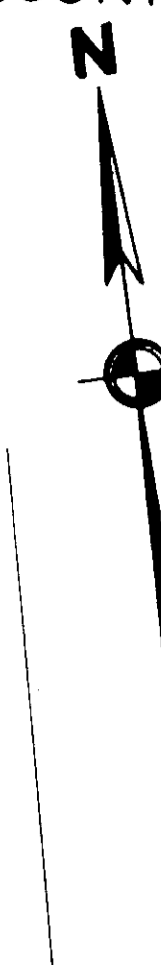

ROLL 6 IMAGE 4


ROLL 6 IMAGE 5

Parcel No.	Owner	Area	Remarks
5	Columbus Corpn.	3170'	Added 6-30-24
6		1508'	
7		1519'	
8		1888'	
9		1375'	
10		718'	
11		1385'	
12		1250'	
13		729'	
14		3457'	
15		445'	
16		761'	
17		911'	
18		720'	
19		2770'	

Parcel No.	Owner	Area	Remarks
39	Columbus Corpn.	2825'	Added 6-30-24
40		359'	
41		1013'	
42		1097'	
43		1893'	
44		185'	
45		1349'	
46		489'	
47		448'	
48		452'	
49		352'	
50		670'	
51		527'	
52		424'	
53		240'	
54		647'	
55		1178'	
56		1591'	
57		197'	
58		210'	
59		167'	
60		210'	
61		210'	
**SCHEDULE OF SIDINGS AND CROSSOVERS**

Side Trk Number	Location	Class	R.R. Co.	Private	Total	Remarks
709	Columbus Corpn.	Y	85'	1277'	1262'	
710			65'	348'	413'	
713			930'		930'	
717			64'		64'	
718			60'	947'	1007'	
719			283'	1159'	1442'	
724			268'	1357'	1625'	
725			417'		417'	
726			488'		488'	
727			197'		197'	
728			197'		197'	Absorbed by No. 5, 6-30-24
729						No. 15.
730			140'		140'	
731			290'		290'	Shortened 235' 6-30-24
732						Absorbed by No. 73.
733						No. 11.
734						Removed 6-30-24
735						
736						
737						
738						
739						
740			720'		720'	Absorbed by No. 39, 6-30-24
83A			189'		189'	12-31-27
005			197'		197'	12-31-27
090			393'		393'	
77 to 199						Engine Ho. Trks. L. 150' Added 6-30-24

 

Parcel No.	Owner	Area	Remarks
729	Columbus Corpn.	Y	Absorbed by No. 57, 6-30-24
731			Shifted 12-31-27
732		189'	189'
733		189'	189'
734		187'	187'
1048			Removed 6-30-24
777			
745			
746			
747		188'	188'
748			Shifted 6-30-24 & 12-31-27
749			Removed
751			
752			
Parcel No.	Owner	Area	Remarks
751	Columbus Corpn.	Y	Removed 6-30-24
752			12-31-27
753			
754		2097'	2097'
755		75'	375'
756		237'	237'
757		76'	407'
758		2349'	2349'
759		1187'	1187'
760			Removed 6-30-24
761			Narrow Gauge
762			Wheel Storage
763			
764			
Correct as of Dec. 31st, 1942 - Map Revised  
 Correct as of Dec. 31st, 1941 - Map Revised  
 Correct as of Dec. 31st, 1940 - No Revision  
 Correct as of Dec. 31st, 1939 - No Revision  
 Correct as of Dec. 31st, 1938 - Map Revised  
 Correct as of Dec. 31st, 1937 - Map Revised  
 Correct as of Dec. 31st, 1936 - No Revision  
 Correct as of Dec. 31st, 1935 - No Revision  
 Correct as of Dec. 31st, 1934 - Map Revised  
 Correct as of Dec. 31st, 1933 - Map Revised  
 Correct as of Dec. 31st, 1932 - No Revision  
 Correct as of Dec. 31st, 1931 - Map Revised  
 Correct as of Dec. 31st, 1930 - Map Revised

Correct as of June 30th 1926 - Map Revised  
 Correct as of June 30th 1925 - Map Revised  
 Correct as of June 30th 1924 - Map Revised  
 Correct as of June 30th 1923 - Map Revised  
 Correct as of June 30th 1922 - Map Revised  
 Correct as of June 30th 1921 - No Revision  
 Correct as of June 30th 1920 - Map Revised  
 Correct as of June 30th 1919 - Map Revised  
 Correct as of June 30th 1918 - Map Revised  
 Correct as of June 30th 1917 - No Revision

Correct as of Dec 31st 1929 - No Revision  
 Correct as of Dec 31st 1928 - Map Revised  
 Correct as of Dec 31st 1927 - Map Revised  
 Correct as of June 30th 1927 - Map Revised

Year	Map	Revised
1955	Map	Revised
1954	No	Revision
1953	Map	Revised
1952	Map	Revised
1951	No	Revision
1950	No	Revision
1949	Map	Revised
1948	Map	Revised
1947	Map	Revised
1946	Map	Revised
1945	Map	Revised
1944	Map	Revised
1943	Map	Revised

Note: Valuation Section B Ohio includes all terminal lands and facilities owned by The P.C.C. & St. L. Ry. Co. between M.P. P188 and M.P. C3, except the right of way and improvements thereon between M.P. P188 and High Street, known as the C. & N. Division, owned jointly with the B. & O.R.R. Co. and included in Valuation Section 2 Ohio.

Sheet No. S.T. 4 V.3 Ohio, of Pittsburgh, Cincinnati, Chicago and St. Louis Railway, from Survey Station (0266) to Survey Station 524-00


**PHILA. BALTO. & WASHINGTON R. R.**  
 FORMERLY  
**PITTSBURGH, CINCINNATI, CHICAGO & ST. LOUIS**

PITTSBURGH DIVISION  
 STATION  
 OFFICE





# COLUMBUS

 

P.C. 66023  
0.769 AC.  
JT. WITH B:O

PT P.C. 66258 39.425 AC.  
LI. MI. P.C. ON V-11.1

PT. P.C. 66258  
39.425 AC.  
COMBINES  
2 CONNECTING P.C.S.  
1 L. MIAMI  
3 BIC4  
2 PB:4

66257  
29.227 AC.

P.C. 70584



P.C.  
39841  
7.663 AC.

Correct as of Dec. 31st 1929	No Revision
Correct as of Dec. 31st 1928	No Revision
Correct as of Dec. 31st 1927	No Revision
Correct as of June 30th 1927	Map Revised
Correct as of June 30th 1926	No Revision
Correct as of June 30th 1925	No Revision
Correct as of June 30th 1924	No Revision
Correct as of June 30th 1923	No Revision
Correct as of June 30th 1922	No Revision
Correct as of June 30th 1921	No Revision
Correct as of June 30th 1920	No Revision
Correct as of June 30th 1919	No Revision
Correct as of June 30th 1918	No Revision
Correct as of June 30th 1917	No Revision

Correct as of Dec. 31st 1942	Map Revised
Correct as of Dec. 31st 1941	No Revision
Correct as of Dec. 31st 1940	No Revision
Correct as of Dec. 31st 1939	No Revision
Correct as of Dec. 31st 1938	No Revision
Correct as of Dec. 31st 1937	No Revision
Correct as of Dec. 31st 1936	No Revision
Correct as of Dec. 31st 1935	No Revision
Correct as of Dec. 31st 1934	No Revision
Correct as of Dec. 31st 1933	No Revision
Correct as of Dec. 31st 1932	No Revision
Correct as of Dec. 31st 1931	No Revision
Correct as of Dec. 31st 1930	No Revision
Correct as of Dec. 31st 1929	No Revision
Correct as of Dec. 31st 1928	No Revision
Correct as of Dec. 31st 1927	No Revision
Correct as of Dec. 31st 1926	No Revision
Correct as of Dec. 31st 1925	No Revision
Correct as of Dec. 31st 1924	No Revision
Correct as of Dec. 31st 1923	No Revision
Correct as of Dec. 31st 1922	No Revision
Correct as of Dec. 31st 1921	No Revision
Correct as of Dec. 31st 1920	No Revision
Correct as of Dec. 31st 1919	No Revision
Correct as of Dec. 31st 1918	No Revision
Correct as of Dec. 31st 1917	No Revision

AS SH.	REVISED	NO	NO
1927			
1928			
1929			
1930			
1931			
1932			
1933			
1934			
1935			
1936			
1937			
1938			
1939			
1940			
1941			
1942			

PHILA. BALTO. & WASHINGTON R. R.  
FORMERLY  
STATION MAP - LANDS  
PITTSBURGH, CINCINNATI, CHICAGO & ST. LOUIS RY.  
PITTSBURGH DIVISION  
STATION 5966+488 TO STATION 6005+288  
SCALE 1 IN = 100 FT. JUNE 30, 1946  
OFFICE OF VALUATION ENGINEER  
PITTSBURGH, PA.

 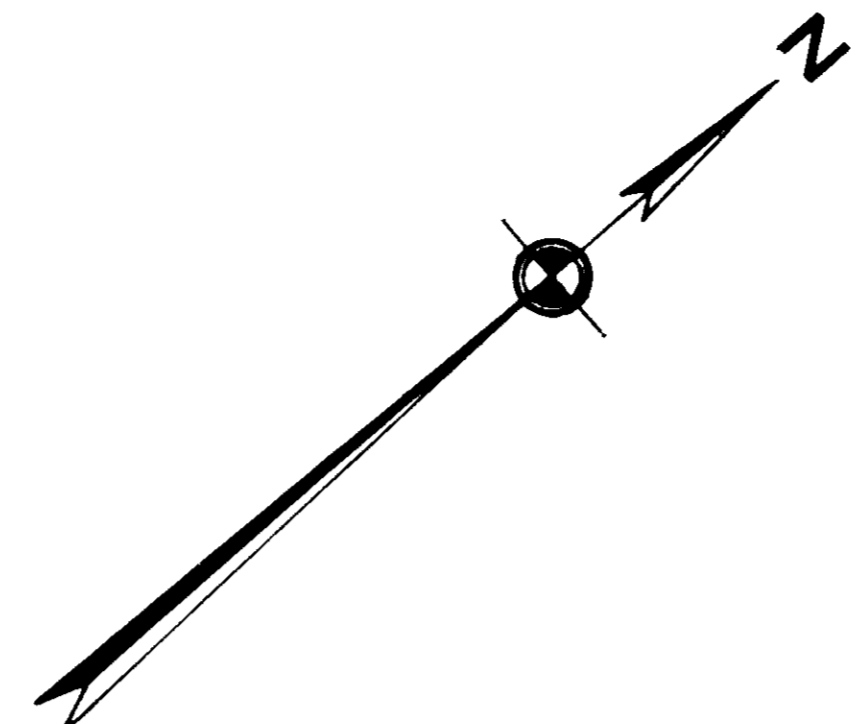



**SCHEDULE OF SIDINGS AND CROSSOVERS**


Side Trk Number	Location	Class	Length, June 30, R.R. Co.	Private	Total	Remarks
369	Columbus Corp'n	Y				See Map No. 2, Removed 6-30-21
367						
365						
Side Trk Number	Location	Class	Length, June 30, R.R. Co.	Private	Total	Remarks
522	Columbus Corp'n	B				Changed 6-30-28
524						
526						
Side Trk Number	Location	Class	Length, June 30, R.R. Co.	Private	Total	Remarks
770						
772						
774						
776						
778						
780						
782						

Correct as of Dec. 31st, 1955.	No Revision
Correct as of Dec. 31st, 1954.	No Revision
Correct as of Dec. 31st, 1953.	No Revision
Correct as of Dec. 31st, 1952.	No Revision
Correct as of Dec. 31st, 1951.	No Revision
Correct as of Dec. 31st, 1950.	No Revision
Correct as of Dec. 31st, 1949.	Revised
Correct as of Dec. 31st, 1948.	Revised
Correct as of Dec. 31st, 1947.	Map Revised
Correct as of Dec. 31st, 1946.	Revised
Correct as of Dec. 31st, 1945.	Map Revised
Correct as of Dec. 31st, 1944.	Revised
Correct as of Dec. 31st, 1943.	Revised

CORRECTED	REVISED
AS OF	DATE
DEC. 31	1955
DEC. 31	1954
DEC. 31	1953
DEC. 31	1952
DEC. 31	1951
DEC. 31	1950
DEC. 31	1949
DEC. 31	1948
DEC. 31	1947
DEC. 31	1946
DEC. 31	1945
DEC. 31	1944
DEC. 31	1943

 

Correct as of Dec. 31st, 1929.	Map Revised
Correct as of Dec. 31st, 1928.	No Revision
Correct as of Dec. 31st, 1927.	No Revision
Correct as of Dec. 31st, 1926.	No Revision
Correct as of Dec. 31st, 1925.	No Revision
Correct as of Dec. 31st, 1924.	No Revision
Correct as of Dec. 31st, 1923.	No Revision
Correct as of Dec. 31st, 1922.	No Revision
Correct as of Dec. 31st, 1921.	No Revision
Correct as of Dec. 31st, 1920.	No Revision
Correct as of Dec. 31st, 1919.	No Revision
Correct as of Dec. 31st, 1918.	No Revision
Correct as of Dec. 31st, 1917.	No Revision

Correct as of Dec. 31st, 1927.	Revised
Correct as of Dec. 31st, 1926.	Revised
Correct as of Dec. 31st, 1925.	Revised
Correct as of Dec. 31st, 1924.	Revised
Correct as of Dec. 31st, 1923.	Revised
Correct as of Dec. 31st, 1922.	Revised
Correct as of Dec. 31st, 1921.	Revised
Correct as of Dec. 31st, 1920.	Revised
Correct as of Dec. 31st, 1919.	Revised
Correct as of Dec. 31st, 1918.	Revised
Correct as of Dec. 31st, 1917.	Revised

PHILA. BALTO. & WASHINGTON R.R.  
 FORMERLY  
 STATION MAP - LANDS  
 PITTSBURGH, CINCINNATI, CHICAGO & ST. LOUIS RY.  
 PITTSBURGH DIVISION  
 STATION 9913+688 TO STATION 9966+48.8  
 SCALE 1" = 100 FT.  
 OFFICIAL SURVEYING ENGINEER  
 PITTSBURGH, PA.

SCHEDULE OF SIDINGS AND CROSSOVERS

Table with columns: Side Trk Number, Location, Class, R.R. Co., Private, Total Length, Remarks. Lists various siding and crossover details for Columbus Corp.

Table with columns: Side Trk Number, Location, Class, R.R. Co., Private, Total Length, Remarks. Continuation of siding and crossover details.

FRANKLIN COUNTY, OHIO.

ROLL 6 IMAGE 13



 



Note: Valuation Section 8 Ohio includes all terminal leads and facilities owned by the P.C. & St. L. Ry Co. between R.P. 108 and M.R. 63, except the right of way and improvements thereon between M.P. 188 and High Street, known to the C. & N. Division, owned jointly with the B. & O. R. Co. and included in Valuation Section 2 Ohio.

ROLL 6 IMAGE 13. Correct as of Dec. 31st, 1955. Map Revised. Correct as of Dec. 31st, 1954. Map Revised. Correct as of Dec. 31st, 1953. Map Revised. Correct as of Dec. 31st, 1951. No Revision. Correct as of Dec. 31st, 1949. No Revision. Correct as of Dec. 31st, 1948. No Revision. Correct as of Dec. 31st, 1947. Map Revised. Correct as of Dec. 31st, 1946. Map Revised. Correct as of Dec. 31st, 1945. Map Revised. Correct as of Dec. 31st, 1944. Map Revised.

PHILA. BALTO. & WASHINGTON R.R. FORMERLY RIGHT OF WAY AND TRACK OF PITTSBURGH, CINCINNATI, CHICAGO & ST. LOUIS RAILWAY PITTSBURGH DIVISION

 

Correct as of Dec. 31st, 1942. Map Revised  
 Correct as of Dec. 31st, 1941. Map Revised  
 Correct as of Dec. 31st, 1940. No Revision  
 Correct as of Dec. 31st, 1939. No Revision  
 Correct as of Dec. 31st, 1938. No Revision  
 Correct as of Dec. 31st, 1937. No Revision  
 Correct as of Dec. 31st, 1936. No Revision  
 Correct as of Dec. 31st, 1935. Map Revised  
 Correct as of Dec. 31st, 1934. Map Revised  
 Correct as of Dec. 31st, 1933. No Revision  
 Correct as of Dec. 31st, 1932. No Revision  
 Correct as of Dec. 31st, 1931. Map Revised  
 Correct as of Dec. 31st, 1930. Map Revised

Correct as of Dec. 31st, 1955. No Revision  
 Correct as of Dec. 31st, 1954. No Revision  
 Correct as of Dec. 31st, 1953. No Revision  
 Correct as of Dec. 31st, 1952. No Revision  
 Correct as of Dec. 31st, 1951. Map Revised  
 Correct as of Dec. 31st, 1950. No Revision  
 Correct as of Dec. 31st, 1949. No Revision  
 Correct as of Dec. 31st, 1948. No Revision  
 Correct as of Dec. 31st, 1947. Map Revised  
 Correct as of Dec. 31st, 1946. Map Revised  
 Correct as of Dec. 31st, 1945. No Revision  
 Correct as of Dec. 31st, 1944. Map Revised  
 Correct as of Dec. 31st, 1943. No Revision

ADDITION	REVISED

Correct as of Dec. 31st 1919. Map Revised  
 Correct as of Dec. 31st 1928. Map Revised  
 Correct as of Dec. 31st 1927. No Revision  
 Correct as of June 30th 1927. Map Revised  
 Correct as of June 30th 1926. Map Revised  
 Correct as of June 30th 1925. Map Revised  
 Correct as of June 30th 1924. No Revision  
 Correct as of June 30th 1923. Map Revised  
 Correct as of June 30th 1922. Map Revised  
 Correct as of June 30th 1921. No Revision  
 Correct as of June 30th 1920. Map Revised  
 Correct as of June 30th 1919. Map Revised  
 Correct as of June 30th 1918. No Revision  
 Correct as of June 30th 1917. No Revision

Subscribed and sworn to before me this \_\_\_\_\_ day of \_\_\_\_\_ 1916.  
 Notary Public for the County of Franklin, Ohio.

**PHILA. BALTO. & WASHINGTON R. R.**  
 FORMERLY  
**PITTSBURGH, CINCINNATI, CHICAGO & ST. LOUIS RAIL ROAD**  
 STATION MAP - LANDS  
 STATION 9858+82.5 TO STATION 9913+68.8  
 SCALE 1"=100' JUNE 30, 1916  
 OFFICE OF VALUATION ENGINEER  
 PHILADELPHIA, PA.

V3  
 OHIO  
 S.E.

ROLL 6 IMAGE 16

SCHEDULE OF SIDINGS AND CROSSOVERS

Side No.	Location	Class	Length	Priority	Total	Remarks





ROLL 6 IMAGE 17

Correct as of Dec 31st 1942 Map Revised  
 Correct as of Dec 31st 1941 Map Revised  
 Correct as of Dec 31st 1940 Map Revised  
 Correct as of Dec 31st 1939 No Revision  
 Correct as of Dec 31st 1938 Map Revised  
 Correct as of Dec 31st 1937 Map Revised  
 Correct as of Dec 31st 1936 Map Revised  
 Correct as of Dec 31st 1935 Map Revised  
 Correct as of Dec 31st 1934 Map Revised  
 Correct as of Dec 31st 1933 Map Revised  
 Correct as of Dec 31st 1932 Map Revised  
 Correct as of Dec 31st 1931 Map Revised  
 Correct as of Dec 31st 1930 Map Revised

Correct as of Dec 31st 1955 Map Revised  
 Correct as of Dec 31st 1954 Map Revised  
 Correct as of Dec 31st 1953 Map Revised  
 Correct as of Dec 31st 1952 Map Revised  
 Correct as of Dec 31st 1951 Map Revised  
 Correct as of Dec 31st 1950 No Revision  
 Correct as of Dec 31st 1949 Map Revised  
 Correct as of Dec 31st 1948 No Revision  
 Correct as of Dec 31st 1947 Map Revised  
 Correct as of Dec 31st 1946 No Revision  
 Correct as of Dec 31st 1945 Map Revised  
 Correct as of Dec 31st 1944 Map Revised  
 Correct as of Dec 31st 1943 Map Revised

CORRECT	NO OF DEC 31	REVISION
	1955	
	1954	
	1953	
	1952	
	1951	
	1950	
	1949	
	1948	
	1947	
	1946	
	1945	
	1944	
	1943	

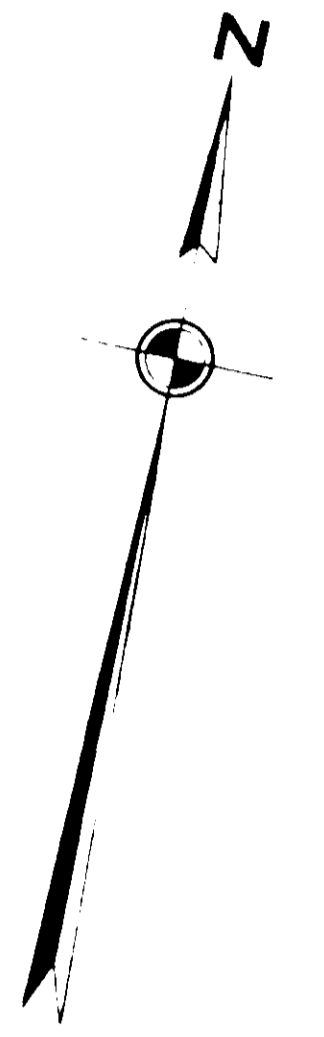 


NOTES  
 Valuation Section includes all terminal lands and facilities owned by The P.C. & St. L. Ry. Co. between MD P15B and MD C-3, except the right of way and improvements between MD P15B and a high street, known as the C.N. Division owned by the B.C. & R.R. Co. and included in Valuation Section 2-D-6.


Sheet No. 67-1-13 Ohio of Pittsburgh, Cincinnati, Chicago & St. Louis Railway from Survey Station 9854+82.5 to Survey Station 9913+68.8

RIGHT OF WAY AND TRACK MAP  
**PITTSBURGH, CINCINNATI, CHICAGO & ST. LOUIS RY.**

PITTSBURGH DIVISION  
 STATION - 9854+82.5 TO STATION 9913+68.8

SCALE 1" = 100'  
 JUNE 30, 1950  
 OFFICE OF VALUATION ENGINEER  
 PITTSBURGH, PA.



 

66307  
A.C.

66252  
29.371 AC.

AS OF DEC. 31	CORRECT	REVISED
YEAR	YES	NO

Correct as of Dec. 31st, 1935: No Revision  
 Correct as of Dec. 31st, 1934: No Revision  
 Correct as of Dec. 31st, 1933: No Revision  
 Correct as of Dec. 31st, 1932: Map Revised  
 Correct as of Dec. 31st, 1931: No Revision  
 Correct as of Dec. 31st, 1930: No Revision  
 Correct as of Dec. 31st, 1929: Map Revised  
 Correct as of Dec. 31st, 1948: No Revision  
 Correct as of Dec. 31st, 1947: Map Revised  
 Correct as of Dec. 31st, 1946: Map Revised  
 Correct as of Dec. 31st, 1945: Map Revised  
 Correct as of Dec. 31st, 1944: Map Revised  
 Correct as of Dec. 31st, 1943: No Revision  
 Correct as of Dec. 31st, 1942: Map Revised  
 Correct as of Dec. 31st, 1941: Map Revised  
 Correct as of Dec. 31st, 1940: Map Revised

**PHILA. BALTO. & WASHINGTON R. R.**  
 FORMERLY  
**RIGHT OF WAY AND TRACK MAP**  
**PITTSBURGH, CINCINNATI, CHICAGO & ST. LOUIS RY.**  
 PITTSBURGH DIVISION

STATION TO STATION  
 SCALE: 1 1/4" = 100 FT. JUNE 30, 1916  
 OFFICE OF VALUATION ENGINEER  
 PHILADELPHIA, PA.

