ROLL 7 IMAGE 1

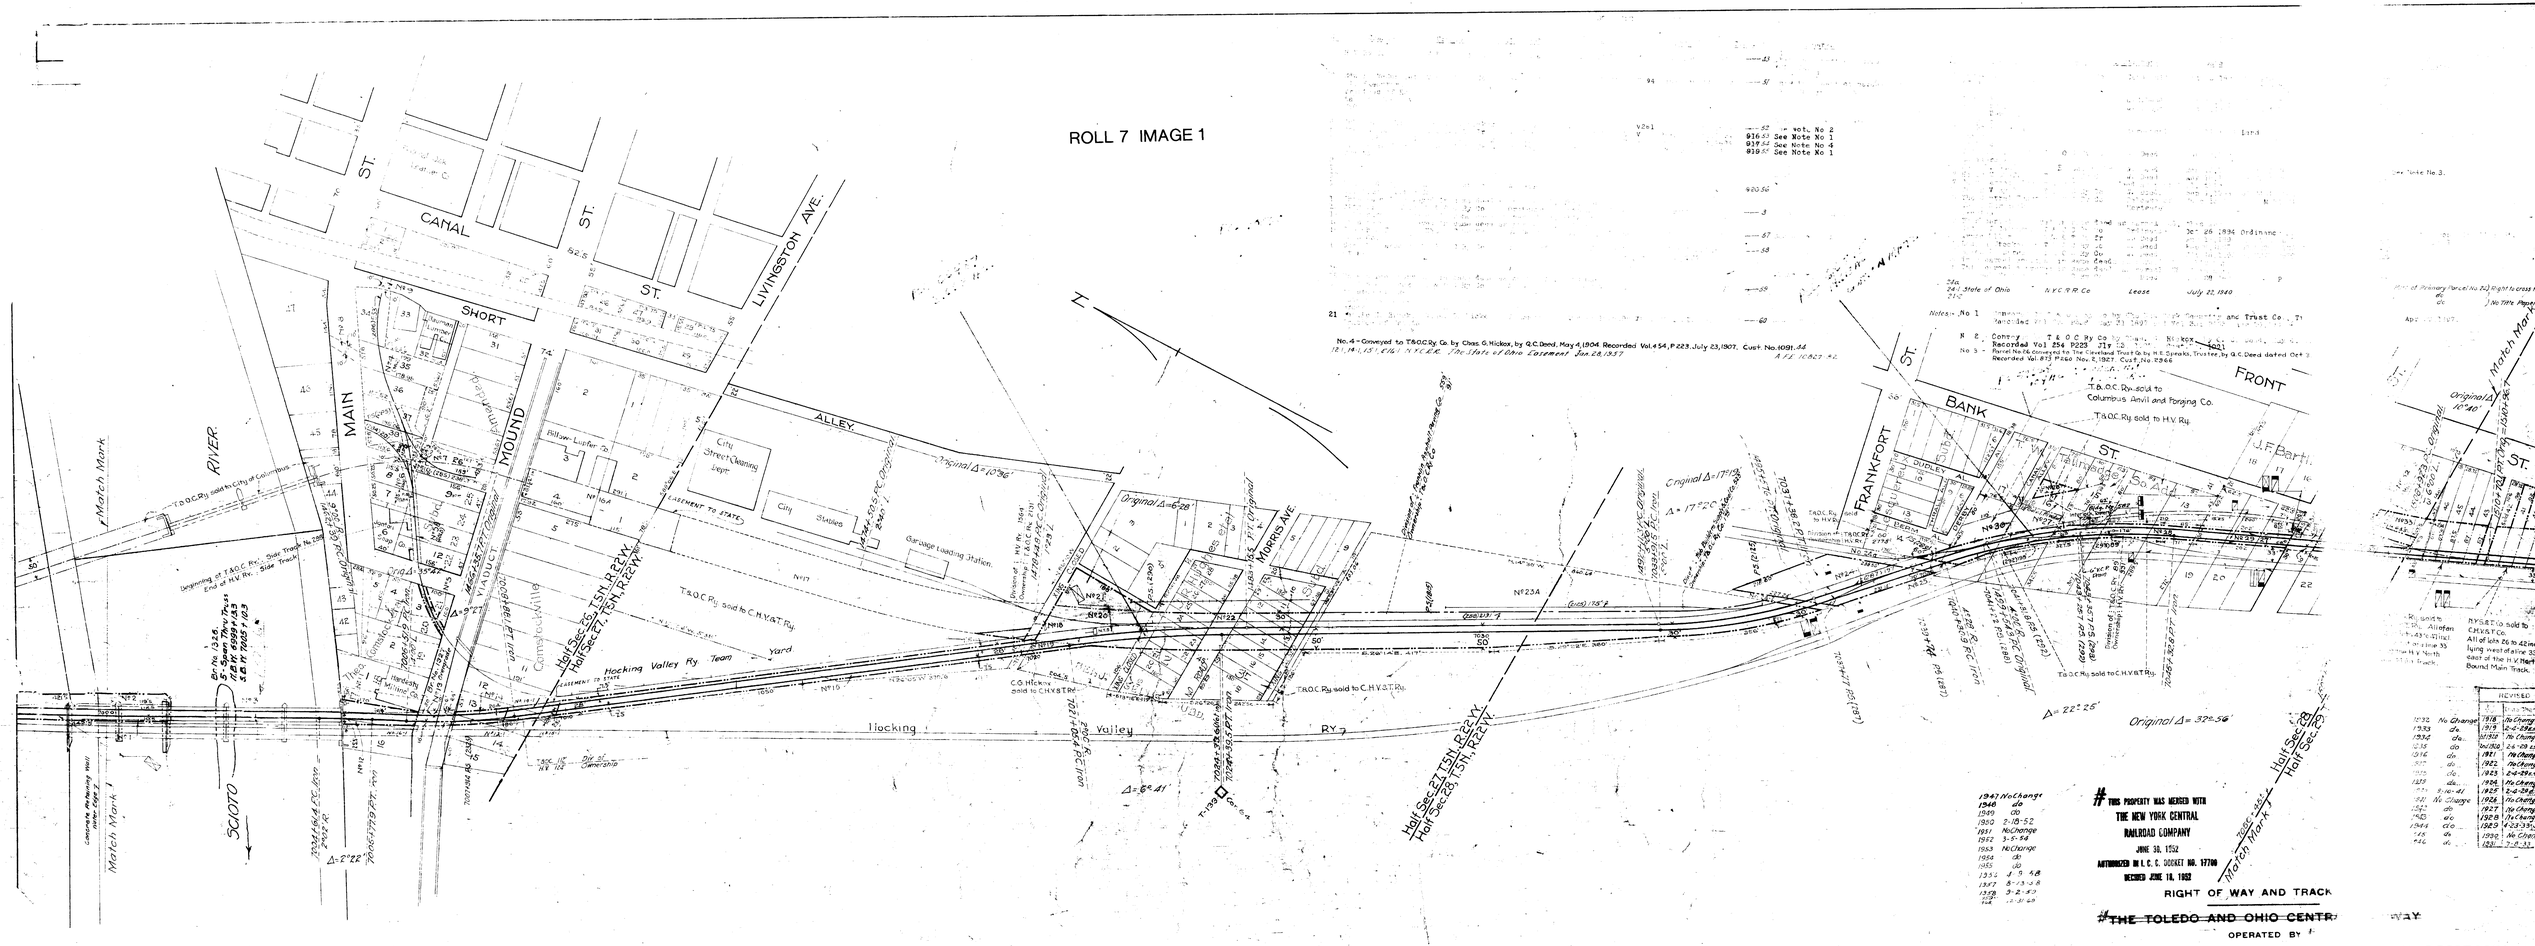
CANAL ST.
SHORT ST.
LIVINGSTON AVE.
MAIN ST.
MOUND ST.
ALLEY
RIVER
SCIOTO
Match Mark
Match Mark 1
T&O.C.Ry sold to City of Columbus
Beginning of T&O.C.Ry. Side Track No 1256
End of H.V.Ry. Side Track
Br. No. 135
5-Span Thru Truss
Br. No. 136
Original Δ=10°36'
Original Δ=6°28'
Original Δ=17°12'
Original Δ=32°56'
Δ=2°02'
Δ=6°41'
Δ=22°25'
Δ=17°12'
Half Sec.26 T5N. R22W.
Half Sec.27 T5N. R22W.
Hocking Valley Ry Team Yard
Hocking Valley RY.
T&O.C.Ry sold to C.H.V.&T.Ry.
C.G.Hickox sold to C.H.V.&T.Ry.
City Stables
City Street Cleaning Dept.
Garage Loading Station
Pillow Lieber Co.
Compactville
MORRIS AVE.
FRANKFORT
BANK ST.
FRONT
DUDLEY
T&O.C.Ry. sold to Columbus Anvil and Forging Co.
T&O.C.Ry sold to H.V.Ry.
J.F.Bert
N°15
N°16
N°16A
N°17
N°18
N°19
N°20
N°21
N°22
N°22A
N°23
N°23A
N°24
N°25
ROLL 7 IMAGE 3

ROLL 7 IMAGE 2

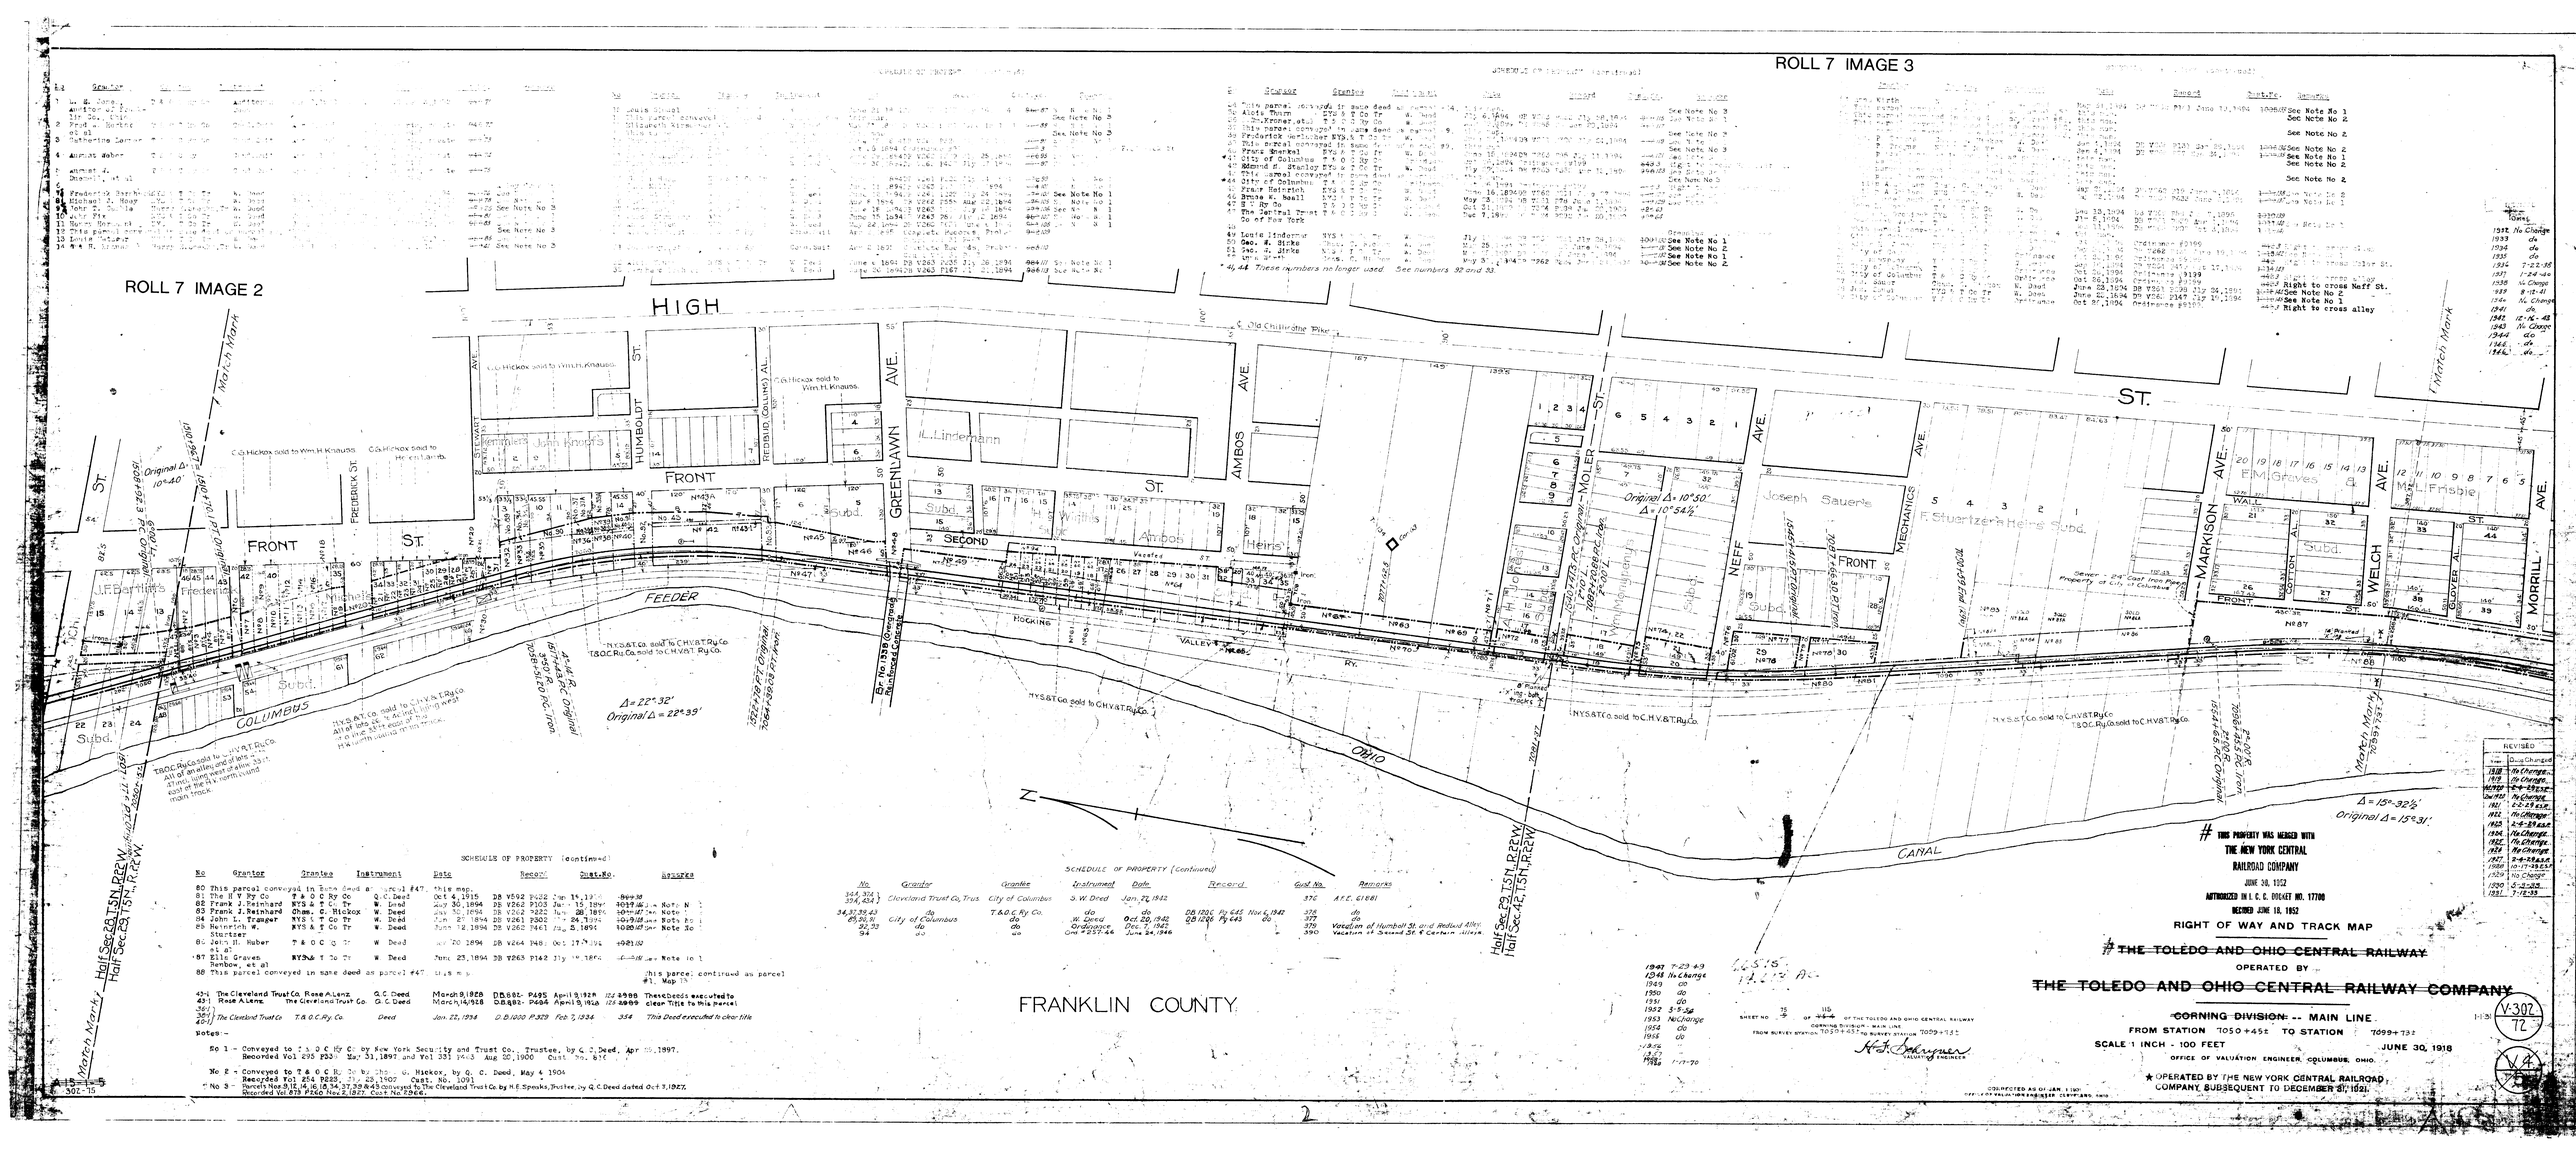

SCHEDULE OF PROPERTY (continued)

No	Grantor	Grantee	Instrument	Date	Record	Cust. No.	Remarks
80	This parcel conveyed in same deed as parcel #47, this map.						See #81
81	The H. V. Ry. Co.	T. & O. C. Ry. Co.	Q.C. Deed	Oct. 4, 1915	DB V502 P432	Jan. 15, 1917	See Note No. 1
82	Frank J. Reinhard	NYS & T. Co. Tr.	W. Deed	July 30, 1894	DB V262 P103	Jan. 15, 1895	1019.46 Lin. Note N
83	Frank J. Reinhard	Chas. C. Hickox	W. Deed	Jan. 30, 1894	DB V262 P222	July 28, 1894	10°-47' Lin. Note
84	John L. Tranger	NYS & T. Co. Tr.	W. Deed	Jan. 27, 1894	DB V261 P303	Feb. 3, 1894	10°-9.08 Lin. Note N
85	Heinrich W. Sturtzer	NYS & T. Co. Tr.	W. Deed	June 12, 1894	DB V262 P461	May 8, 1895	1080.47 Lin. Note No
86	John H. Huber et al	T. & O. C. Ry. Co.	W. Deed	July 20, 1894	DB V264 P48	Oct. 17, 1894	4°21.52
87	Ella Graves Benbow, et al	NYS & T. Co. Tr.	W. Deed	Jan. 25, 1894	DB V263 P142	July 14, 1896	See Note No 1
88	This parcel conveyed in same deed as parcel #47, this map.						This parcel continued as parcel #1, Map 78
434	The Cleveland Trust Co. Rose A. Lenz		Q.C. Deed	March 8, 1928	DB 881 P495	April 9, 1928	122 2996 This Deed executed to
435	Rose A. Lenz	The Cleveland Trust Co.	Q.C. Deed	March 14, 1928	DB 881 P494	April 9, 1928	122 2999 clear Title To this Parcel
436	The Cleveland Trust Co	T. & O.C. Ry. Co.	Deed	Jan. 22, 1934	D.B. 1000 P. 379	Feb. 7, 1934	354 This Deed executed to clear title
437							

Notes:-

No 1 - Conveyed to T. & O. C. Ry. Co. by New York Security and Trust Co., Trustee, by Q. C. Deed, Apr 30, 1897. Recorded Vol 295 P331 May 31, 1897 and Vol 331 P463 Aug 20, 1900 Cust. No. 876

No 2 - Conveyed to T. & O. C. R. Co. by Chas. C. Hickox, by Q. C. Deed, May 4, 1904 Recorded Vol 254 P223 May 23, 1907 Cust. No. 1091

No 3 - Parcels Nos 9, 10, 14, 15, 16, 34, 37, 39 & 43 conveyed by The Cleveland Trust Co. by H.E. Speaks, Trustee, by Q.C. Deed dated Oct 7, 1927, Recorded Vol. 879 P260 Nov 2, 1927 Cust. No. 12646.

SCHEDULE OF PROPERTY (Continued)

No.	Grantor	Grantee	Instrument	Date	Record	Cust No.	Remarks
324, 324-1, 324-2	Cleveland Trust Co. Trus.	City of Columbus	S.W. Deed	Jan. 22, 1942		376	A.F.E. 61881
34, 32, 39, 43	do	T. & O.C. Ry Co.	do	do	DB 1220 P. 645	Nov 6, 1942	376	do
85, 90, 91	City of Columbus	do	W. Deed	Oct. 20, 1942	DB 1220 P. 645	do	377	do
92, 93	do	do	Ordinance	Dec. 7, 1942			378	Vacation of Humbolt St. and Reduced Alley
94	do	do	Ord. # 257-44	June 24, 1946			390	Vacation of Second St. & Certain Alleys

1947 7-23-49
1948 No Change
1949 do
1950 do
1951 do
1952 5-5-54
1953 No Change
1954 do
1955 do
1956 do
1957
1958 1-14-59


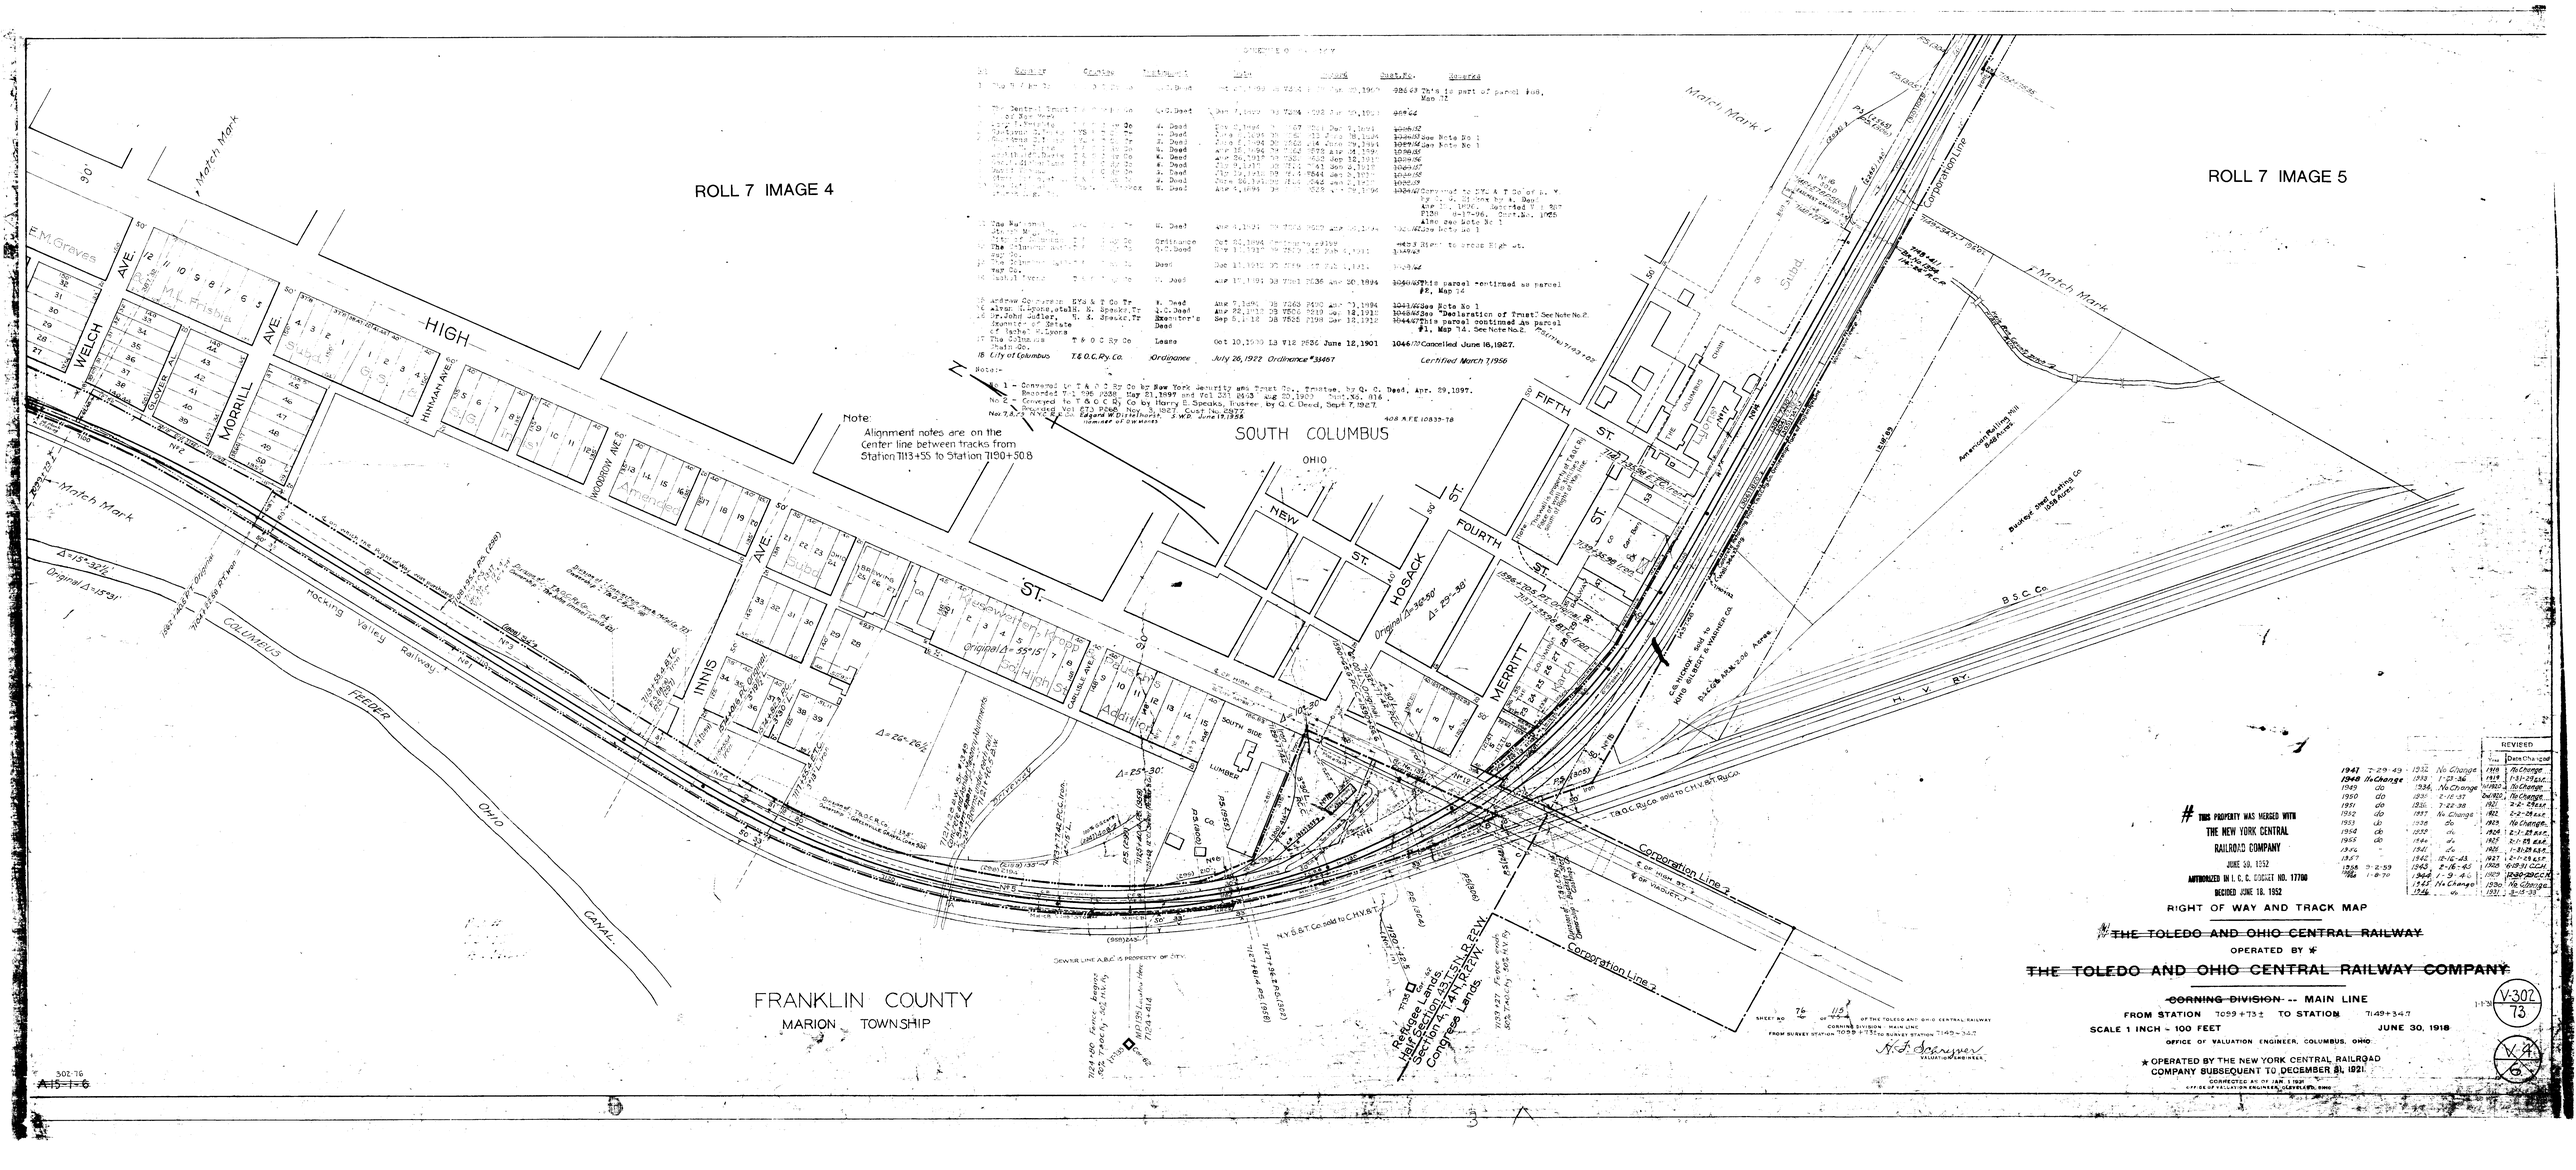
ROLL 7 IMAGE 4
ROLL 7 IMAGE 5
SOUTH COLUMBUS
FRANKLIN COUNTY
MARION TOWNSHIP
HIGH ST.
OHIO
NEW
FIFTH ST.
FOURTH ST.
HOSACK
MERRITT
WELCH AVE.
MORRILL AVE.
HIMMAN AVE.
WOODROW AVE.
INNIS AVE.
CARLISLE AVE.
Match Mark
Corporation Line
Hocking Valley Railway
OHIO CANAL
B.S.C.Co.
H.V.Ry.
N.Y.C.R.R.
N.Y.S.&T.Co. sold to C.H.V.&P.Ry.Co.
T.&O.C.Ry.Co. sold to C.H.V.&P.Ry.Co.
Note:
THIS PROPERTY WAS MERGED WITH THE NEW YORK CENTRAL RAILROAD COMPANY JUNE 30, 1952 AUTHORIZED IN I. C. C. DOCKET NO. 17700 DECIDED JUNE 18, 1952
RIGHT OF WAY AND TRACK MAP
~~THE TOLEDO AND OHIO CENTRAL RAILWAY~~
OPERATED BY *
~~THE TOLEDO AND OHIO CENTRAL RAILWAY COMPANY~~
~~CORNING DIVISION~~ -- MAIN LINE
SCALE 1 INCH = 100 FEET
JUNE 30, 1918
OFFICE OF VALUATION ENGINEER, COLUMBUS, OHIO.
* OPERATED BY THE NEW YORK CENTRAL RAILROAD COMPANY SUBSEQUENT TO DECEMBER 31, 1921.
CORRECTED AT 7TH JAN. 1 1931
OFFICE OF VALUATION ENGINEER, CLEVELAND, OHIO
V-302 73
V-14 G

ROLL 7 IMAGE 6

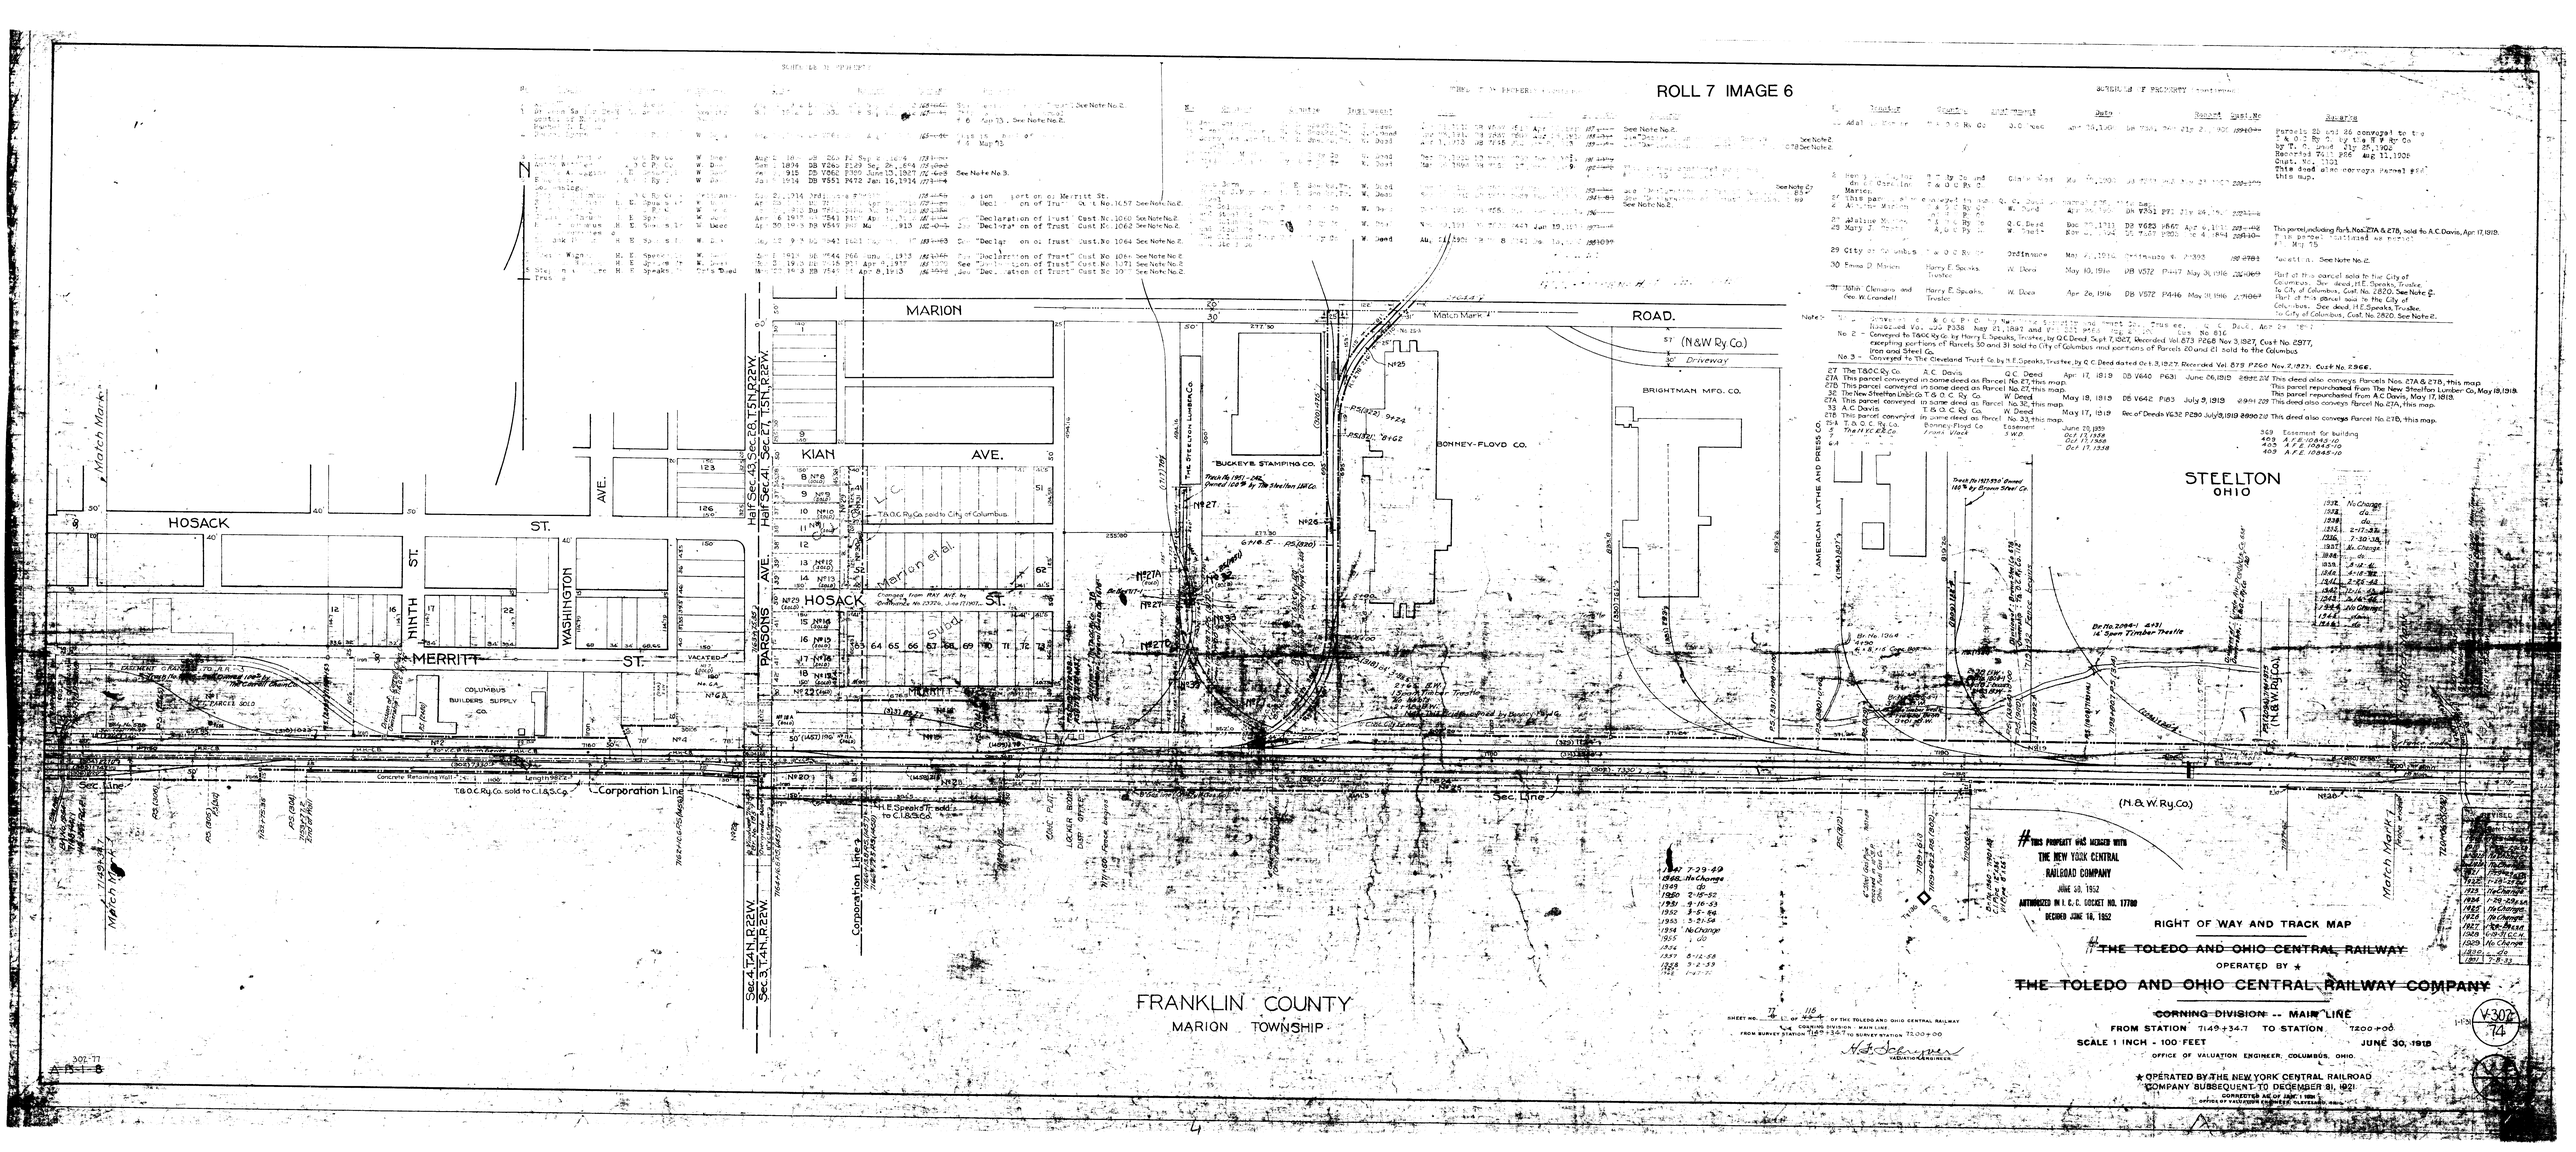

RIGHT OF WAY AND TRACK MAP

~~THE TOLEDO AND OHIO CENTRAL RAILWAY~~

OPERATED BY ★

THE TOLEDO AND OHIO CENTRAL RAILWAY COMPANY

CORNING DIVISION -- MAIN LINE

FROM STATION 7149+34.7 TO STATION 7200+00

SCALE 1 INCH - 100 FEET

JUNE 30, 1918

OFFICE OF VALUATION ENGINEER, COLUMBUS, OHIO.

★ OPERATED BY THE NEW YORK CENTRAL RAILROAD COMPANY SUBSEQUENT TO DECEMBER 31, 1921.

CORRECTED AS OF JAN. 1, 1931

OFFICE OF VALUATION ENGINEER, COLUMBUS, OHIO.

THIS PROPERTY WAS MERGED WITH THE NEW YORK CENTRAL RAILROAD COMPANY JUNE 30, 1952 AUTHORIZED IN I. C. C. DOCKET NO. 17780 DECIDED JUNE 16, 1952

SHEET NO. 72 OF 116 SHEETS OF THE TOLEDO AND OHIO CENTRAL RAILWAY CORNING DIVISION - MAIN LINE FROM SURVEY STATION 7149+34.7 TO SURVEY STATION 7200+00

Valuation Engineer

V-302 74

301-77 A 15-1-8

ROLL 7 IMAGE 7

ROLL 7 IMAGE 8

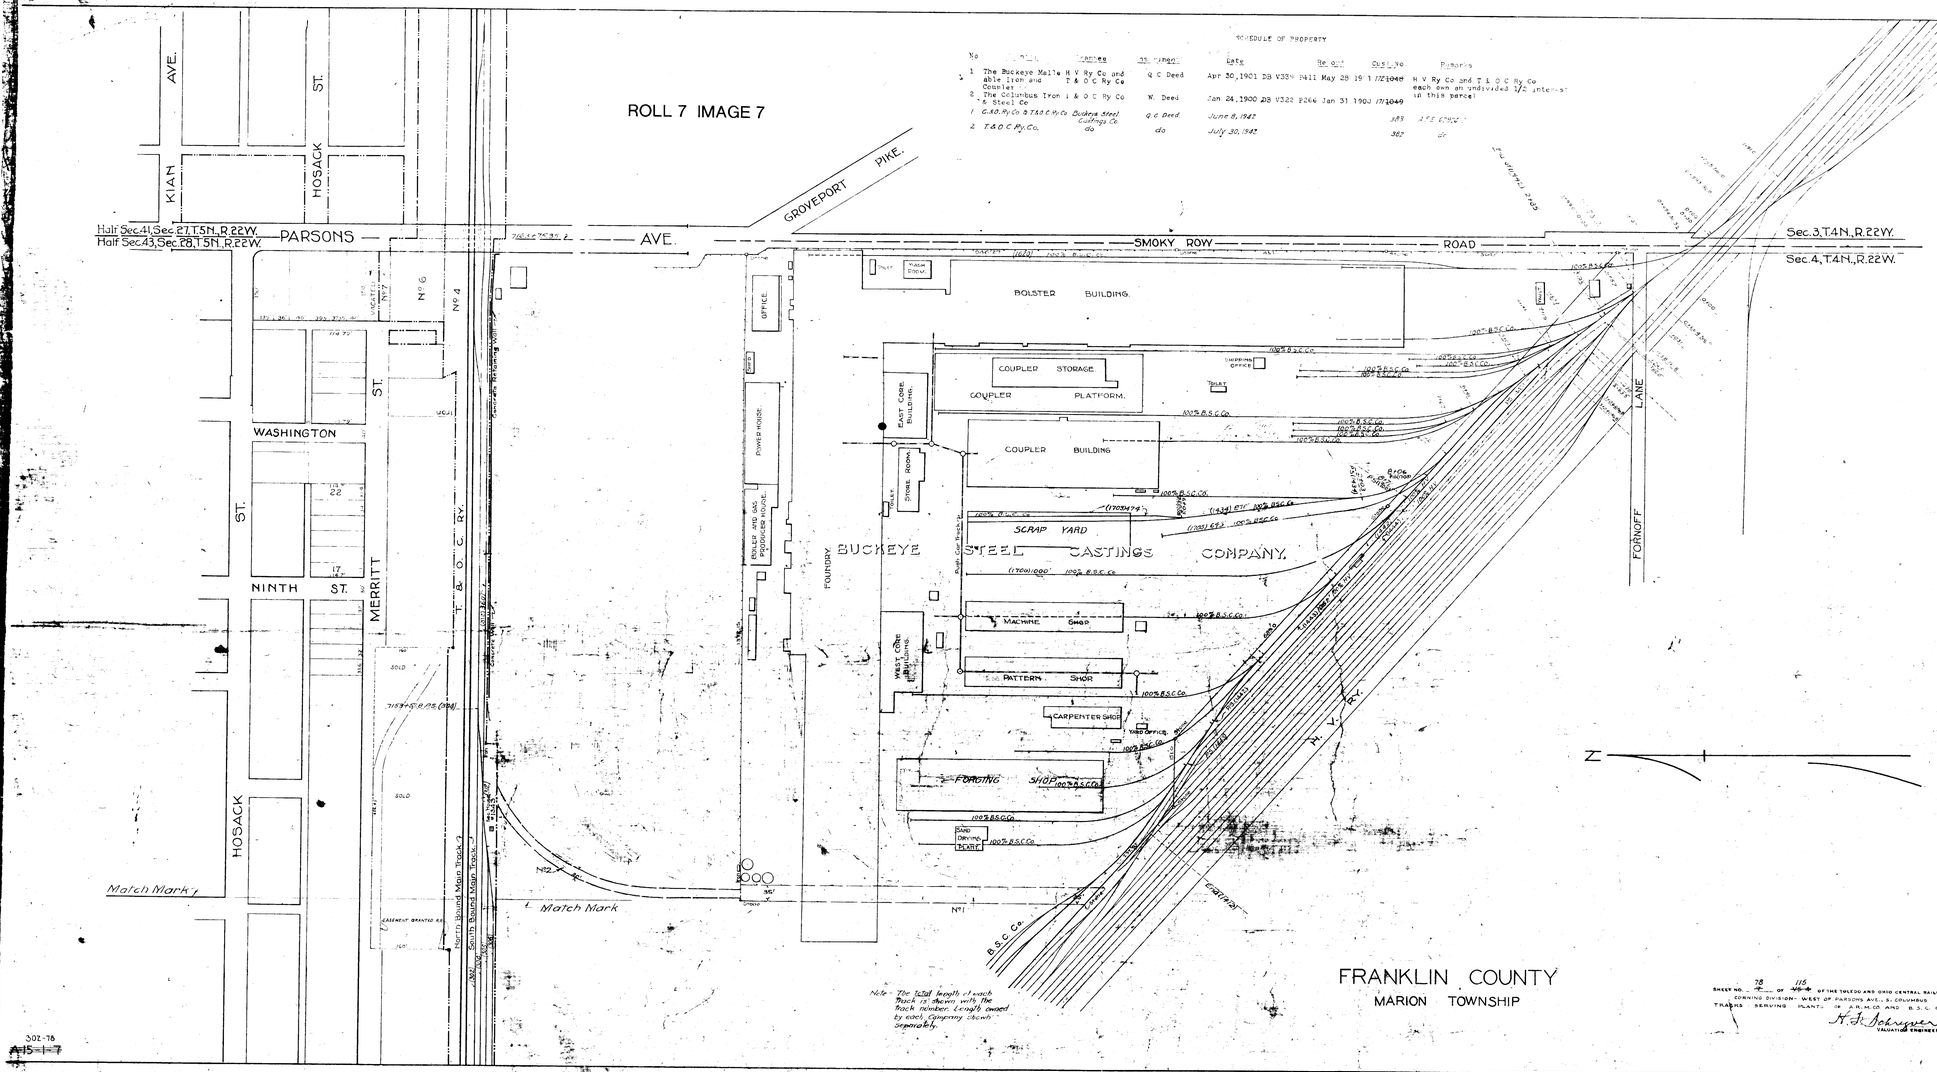

5A

ROLL 7 IMAGE 9

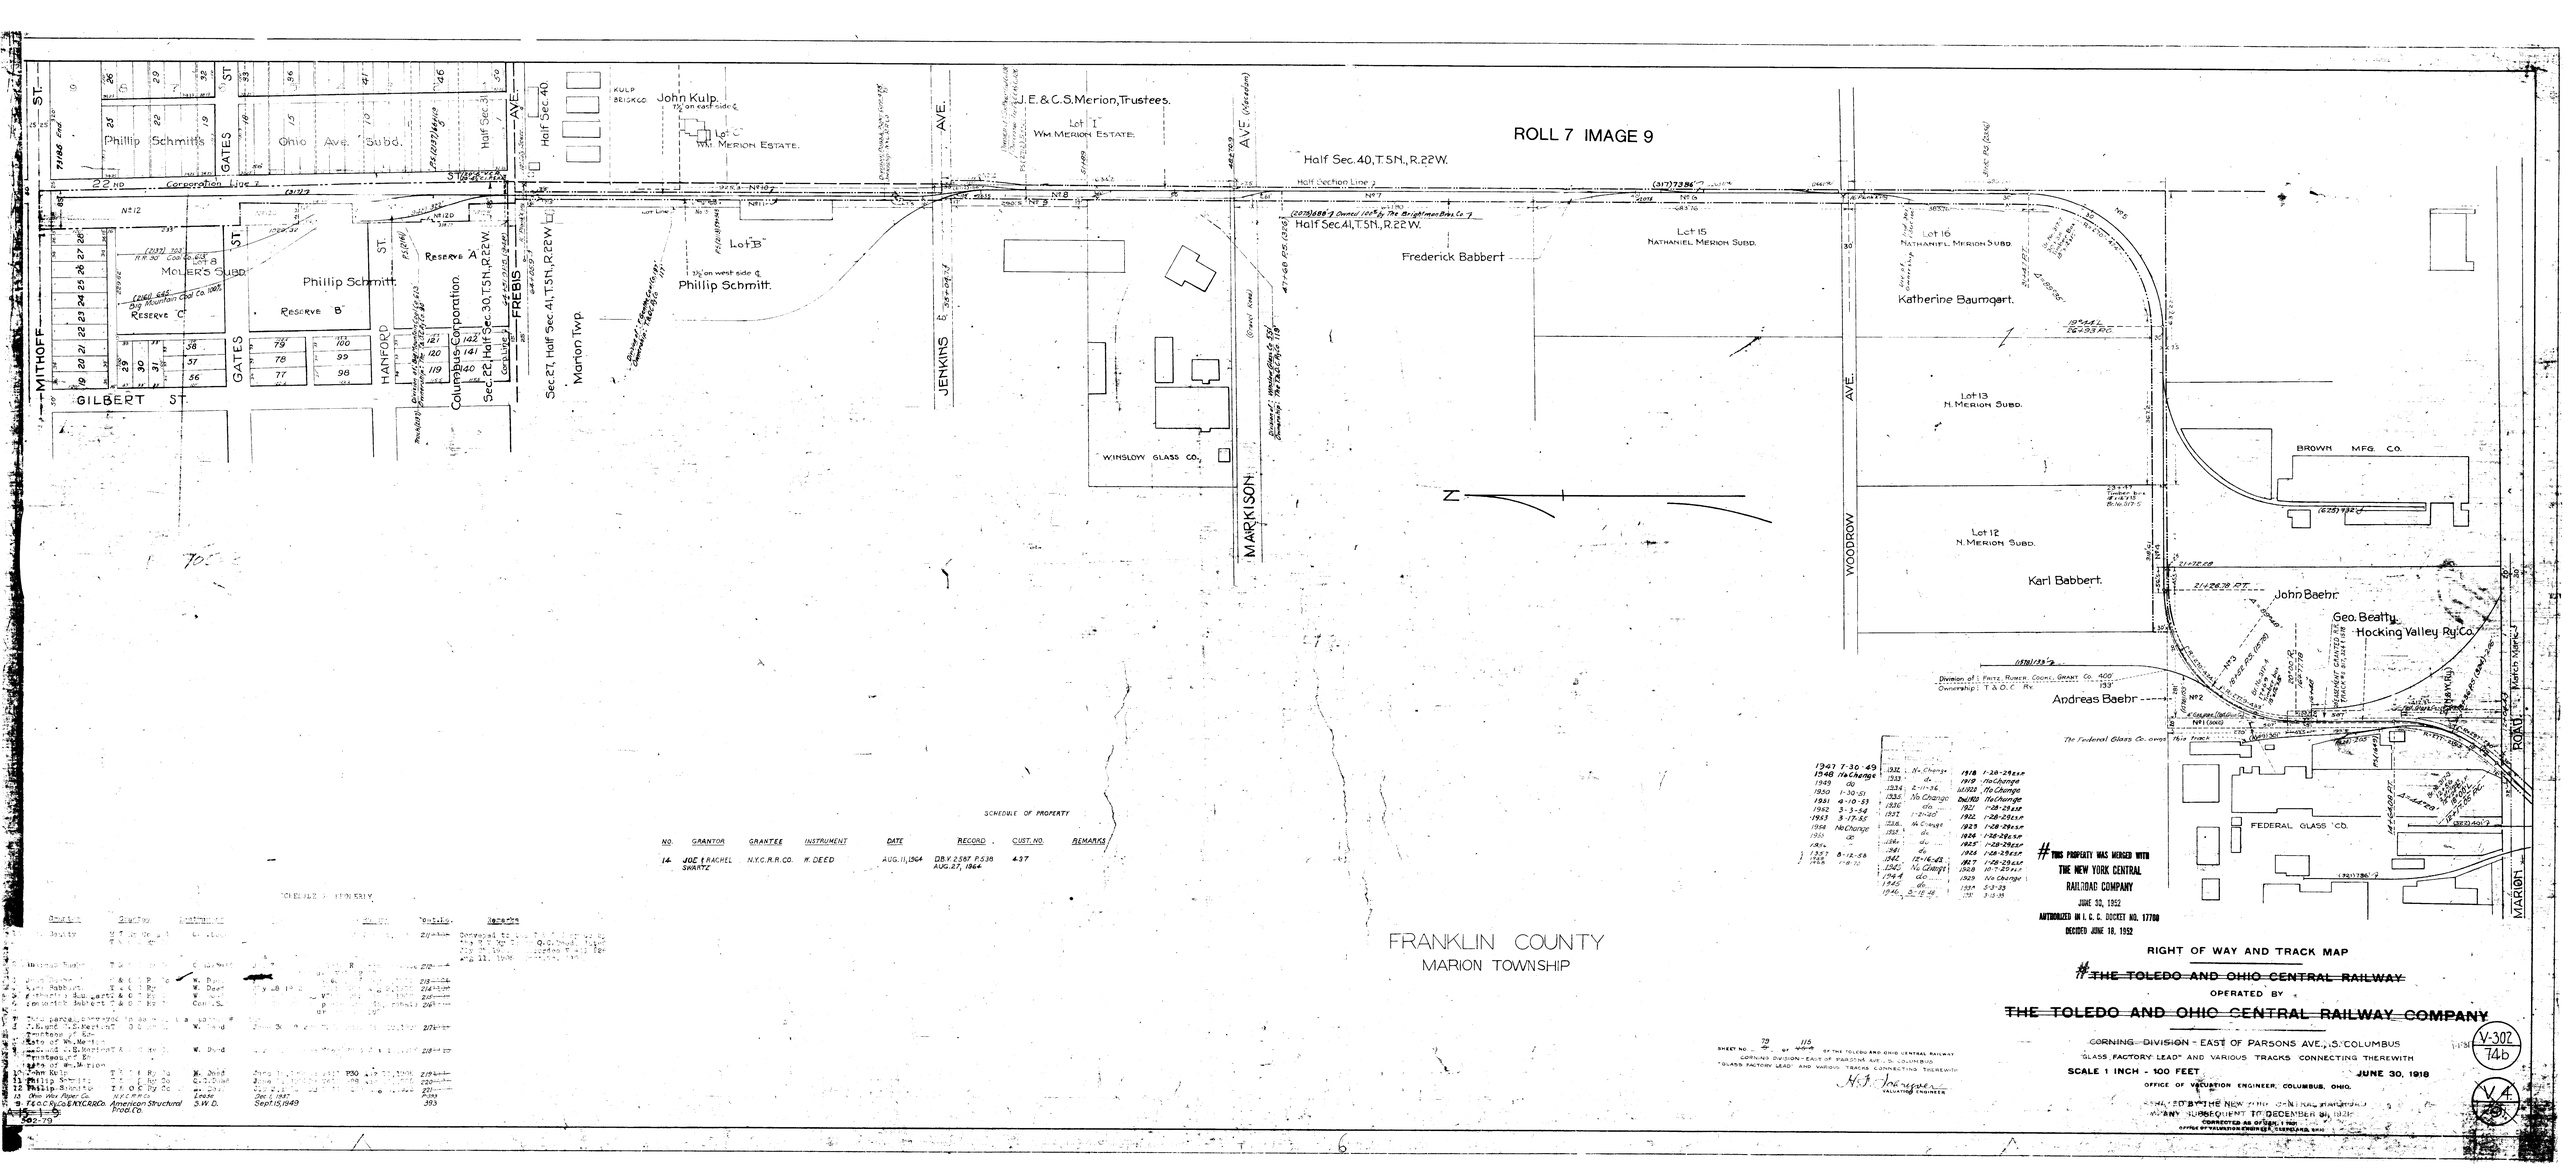

SCHEDULE OF PROPERTY

NO.	GRANTOR	GRANTEE	INSTRUMENT	DATE	RECORD	CUST. NO.	REMARKS
14	JOE & RACHEL SWARTZ	N.Y.C. R.R. CO.	W. DEED	AUG. 11, 1964	DB V. 2387 P. 539 AUG. 27, 1964	437	

1947 7-30-49 / 1948 No Change / 1949 " / 1950 1-10-51 / 1951 4-10-53 / 1952 5-3-54 / 1953 5-17-55 / 1954 No Change / 1955 " / 1956 " / 1957 8-12-58 / 1958 No Change

1931	No Change	1918	1-28-29 A.S.V.
1932	do.	1919	No Change
1934	2-11-36	1920	No Change
1935	No Change	1921	No Change
1936	do.	1922	1-28-29 A.S.V.
1937	1-2-40	1923	1-28-29 A.S.V.
1938	No Change	1924	1-28-29 A.S.V.
1939	do.	1925	1-28-29 A.S.V.
1941	do.	1926	1-28-29 A.S.V.
1942	12-14-42	1927	1-28-29 A.S.V.
1943	No Change	1928	10-7-29 A.S.V.
1944	do.	1929	No Change
1945	do.	1930	5-3-33
1946	3-12-46	1931	5-3-33

Division of Ownership: Fritz, Rumer, Cooke, Grant Co. 400 / T. & O. C. Ry.

THIS PROPERTY WAS MERGED WITH THE NEW YORK CENTRAL RAILROAD COMPANY JUNE 30, 1952 AUTHORIZED IN I. C. C. DOCKET NO. 17700 DECIDED JUNE 18, 1952

FRANKLIN COUNTY
MARION TOWNSHIP

RIGHT OF WAY AND TRACK MAP

~~THE TOLEDO AND OHIO CENTRAL RAILWAY~~

OPERATED BY

~~THE TOLEDO AND OHIO CENTRAL RAILWAY COMPANY~~

CORNING DIVISION - EAST OF PARSONS AVE., S. COLUMBUS
"GLASS FACTORY LEAD" AND VARIOUS TRACKS CONNECTING THEREWITH
SCALE 1 INCH - 100 FEET JUNE 30, 1918
OFFICE OF VALUATION ENGINEER, COLUMBUS, OHIO.

SHEET NO. 72 OF 115 SHEETS OF THE TOLEDO AND OHIO CENTRAL RAILWAY
CORNING DIVISION - EAST OF PARSONS AVE., S. COLUMBUS
"GLASS FACTORY LEAD" AND VARIOUS TRACKS CONNECTING THEREWITH

H. J. Stonecipher
VALUATION ENGINEER

OFFICE OF VALUATION ENGINEER, CLEVELAND, OHIO

V-307 74b

V-4 75

SCHEDULE OF PROPERTY

Grantor	Grantee	Instrument	Date	Record	Cust. No.	Remarks
Sundry	T. & O. C. Ry. Co.	Conveyances			214-Main	Conveyed to T. & O. C. Ry. Co. by Deeds dated Aug. 11, 1916
Wm. Merion	T. & O. C. Ry. Co.	W. Deed			212-Main	
Kurt Babbert	T. & O. C. Ry. Co.	W. Deed			213-Main	
Katherine Baumgart	T. & O. C. Ry. Co.	W. Deed			214-Main	
Commercial Subscribers	T. & O. C. Ry. Co.	Con. Sls.			215-Main	
[illegible] parcel conveyed to [illegible]		W. Deed			216-Main	
Trustees of Estate of Wm. Merion		W. Deed			217-Main	
Trustees of Estate of Wm. Merion		W. Deed			218-Main	
John Kulp	T. & O. C. Ry. Co.	W. Deed			219-Main	
Phillip Schmitt	T. & O. C. Ry. Co.	Ord. Deed			220-Main	
Phillip Schmitt	T. & O. C. Ry. Co.	Ord. Deed			221-Main	
Ohio Wax Paper Co.	N.Y.C.R.R.Co.	Lease	Dec. 1, 1947		Points 393	
T. & O. C. Ry. & N.Y.C.R.R.Co.	American Structural Prod. Co.	S.W.D.	Sept. 15, 1949			


ROLL 7 IMAGE 10

ROLL 7 IMAGE 11

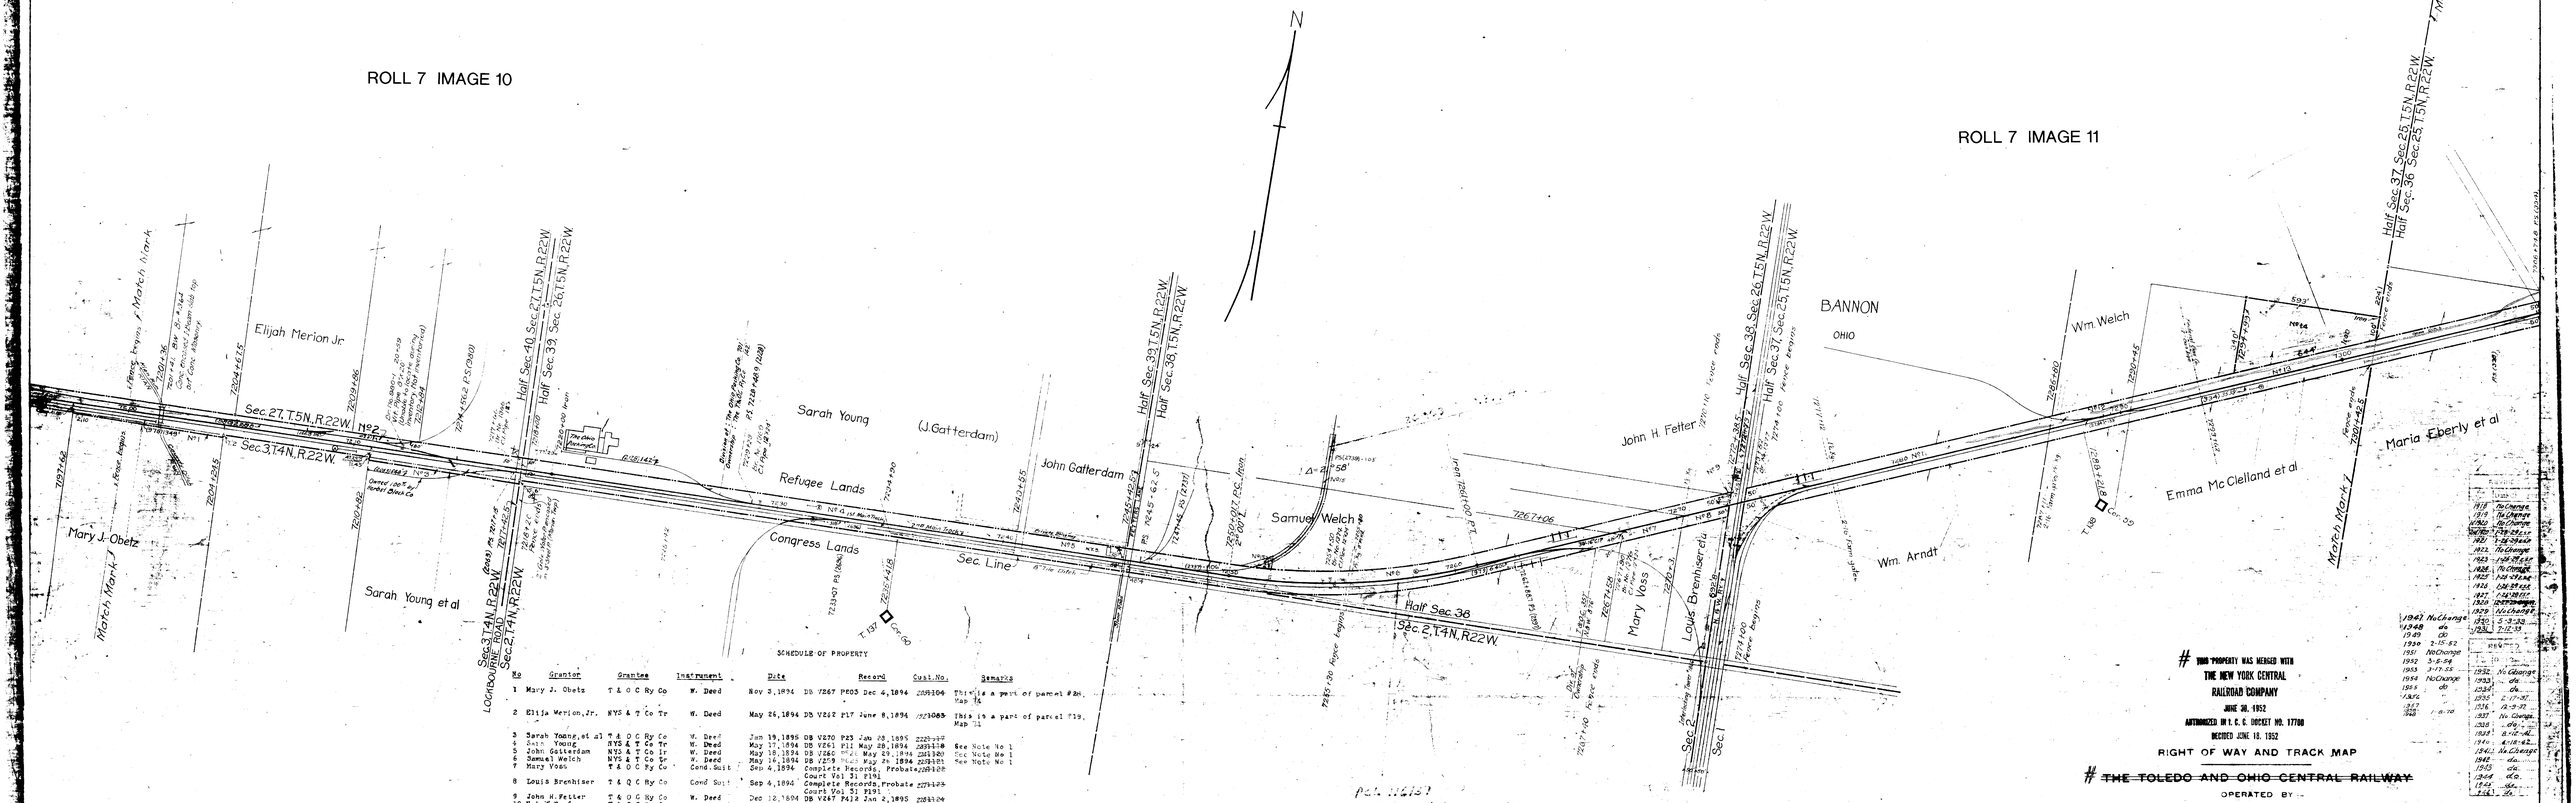

SCHEDULE OF PROPERTY

No	Grantor	Grantee	Instrument	Date	Record	Cust.No.	Remarks
1	Mary J. Obetz	T & O C Ry Co	W. Deed	Nov 3,1894	DB VZ67 PE05 Dec 4,1894	2091104	This is a part of parcel #24, Map 16
2	Elijah Merion,Jr.	NYS & T Co Tr	W. Deed	May 26,1894	DB VZ62 P17 June 8,1894	1971085	This is a part of parcel #19, Map 21
3	Sarah Young,et al	T & O C Ry Co	W. Deed	Jan 19,1895	DB VZ70 P23 Jan 28,1895	2225117	
4	John Young	NYS & T Co Tr	W. Deed	May 17,1894	DB VZ61 P11 May 28,1894	2031118	See Note No 1
5	John Gatterdam	NYS & T Co Tr	W. Deed	May 18,1894	DB VZ65 P42 May 29,1894	2061120	See Note No 1
6	Samuel Welch	NYS & T Co Tr	W. Deed	May 16,1894	DB VZ59 P425 May 26 1894	2031121	See Note No 1
7	Mary Voss	T & O C Ry Co	Cond. Suit	Dec 4,1894	Complete Records, Probate Court Vol 31 P192	2091128	
8	Louis Brenhiser	T & O C Ry Co	Cond Suit	Sep 4,1894	Complete Records,Probate Court Vol 31 P191	2771123	
9	John H.Fetter	T & O C Ry Co	W. Deed	Dec 12,1894	DB VZ67 P412 Jan 2,1895	2251104	
10	N & W Ry Co	T & O C Ry Co	Agreement	Nov 20,1896	Chief Engr's Agreement 84		Right to cross N & W Ry
11	Wm. Arndt	T & O C Ry Co	Cond.Suit	Nov 4,1896	Complete Records,Probate Court Vol 31 P242	2791105	
12	Wm. Welch	NYS & T Co Tr	W. Deed	May 14,1894	DB VZ59 P416 May 25 1894	2031120	See Note No 1
13	Emma McClelland et al	NYS & T Co Tr	W. Deed	May 31,1894	DB VZ62 P155 June 20, 1894	2031119	See Note No 1
14	Lemma McClelland et al	Chas. G. Hickox	W. Deed	May 31,1894	DB VZ61 P260 June 29 1894	2041100	See Note No 2
4	Elizabeth Gatterdam,etal	T&O C Ry Co.	Agreement	Feb. 2, 1826	V26 Misc. P516	Mar 12,1826	2328846 C.R.344. This agreement releases two private crossings, one of which is in Parcel No 5, this map.

5 Private crossing in this parcel released in same agreement as crossing in Parcel No.4, this map.
14 T. & O.C Ry Co. E.G Burkhardt Q.C. Deed June 17,1916 359 A.F.E 42176

Notes: No 1 - Conveyed to T & O C Ry Co. by New York Security and Trust Co., Trustee, by Q.C.Deed, Apr. 29,1897. Recorded Vol 295 P338 May 21,1897 and Vol 321 P405 Aug.20,1900 Cust.No. 816

No 2 - Conveyed to T & O C Ry Co by Chas. G. Hickox, by Q.C.Deed, May 4, 1904. Recorded Vol 284 P223, July 25, 1907 Cust. No. 1001

P.O. 11,213.1
74.22 A.C.

FRANKLIN COUNTY
MARION TOWNSHIP

SHEET NO. 66 OF 115 SHEETS OF THE TOLEDO AND OHIO CENTRAL RAILWAY
CORNING DIVISION - MAIN LINE
FROM SURVEY STATION 7200+00 TO SURVEY STATION 7361+42.5

K.B. Shrapnel
VALUATION ENGINEER

1918	No Change
1919	No Change
1940	No Change
1941	1-28-41
1942	1-28-42
1943	No Change
1944	No Change
1945	No Change
1946	No Change
1947	1-28-47
1948	No Change
1949	No Change
1950	1-28-50
1951	No Change
1952	5-5-52
1953	3-17-53
1954	No Change
1955	do.
1956	2-17-56
1957	12-3-57
1958	No Change
1959	do.
1960	do.
1961	do.
1962	do.
1963	do.
1964	do.
1965	do.
1966	do.
1967	do.
1968	do.
1969	do.
1970	do.
1971	1-28-71
1972	No Change
1973	do.
1974	do.
THIS PROPERTY WAS MERGED WITH THE NEW YORK CENTRAL RAILROAD COMPANY JUNE 30, 1952 AUTHORIZED IN I. C. C. DOCKET NO. 17700 DECIDED JUNE 18, 1952

RIGHT OF WAY AND TRACK MAP

~~THE TOLEDO AND OHIO CENTRAL RAILWAY~~

OPERATED BY

~~THE TOLEDO AND OHIO CENTRAL RAILWAY COMPANY~~

~~CORNING DIVISION~~ -- MAIN LINE

FROM STATION 72.00+00 TO STATION 7361+42.5

SCALE 1 INCH = 200 ~~FEET~~

JUNE 30, 1918

OFFICE OF VALUATION ENGINEER COLUMBUS, OHIO.

CORRECTED AS OF JAN. 1 19~~0~~ 60

BY VALUATION ENGINEER, CLEVELAND, OHIO.

SHORT STATION = 364.7218 ft. Sta. 7220+77.29.

DATED BY THE NEW YORK CENTRAL RAILROAD COMPANY, SUBSEQUENT TO DECEMBER

V-302
15

V-4
10

302-80

A-15-1-10

ROLL 7 IMAGE 12

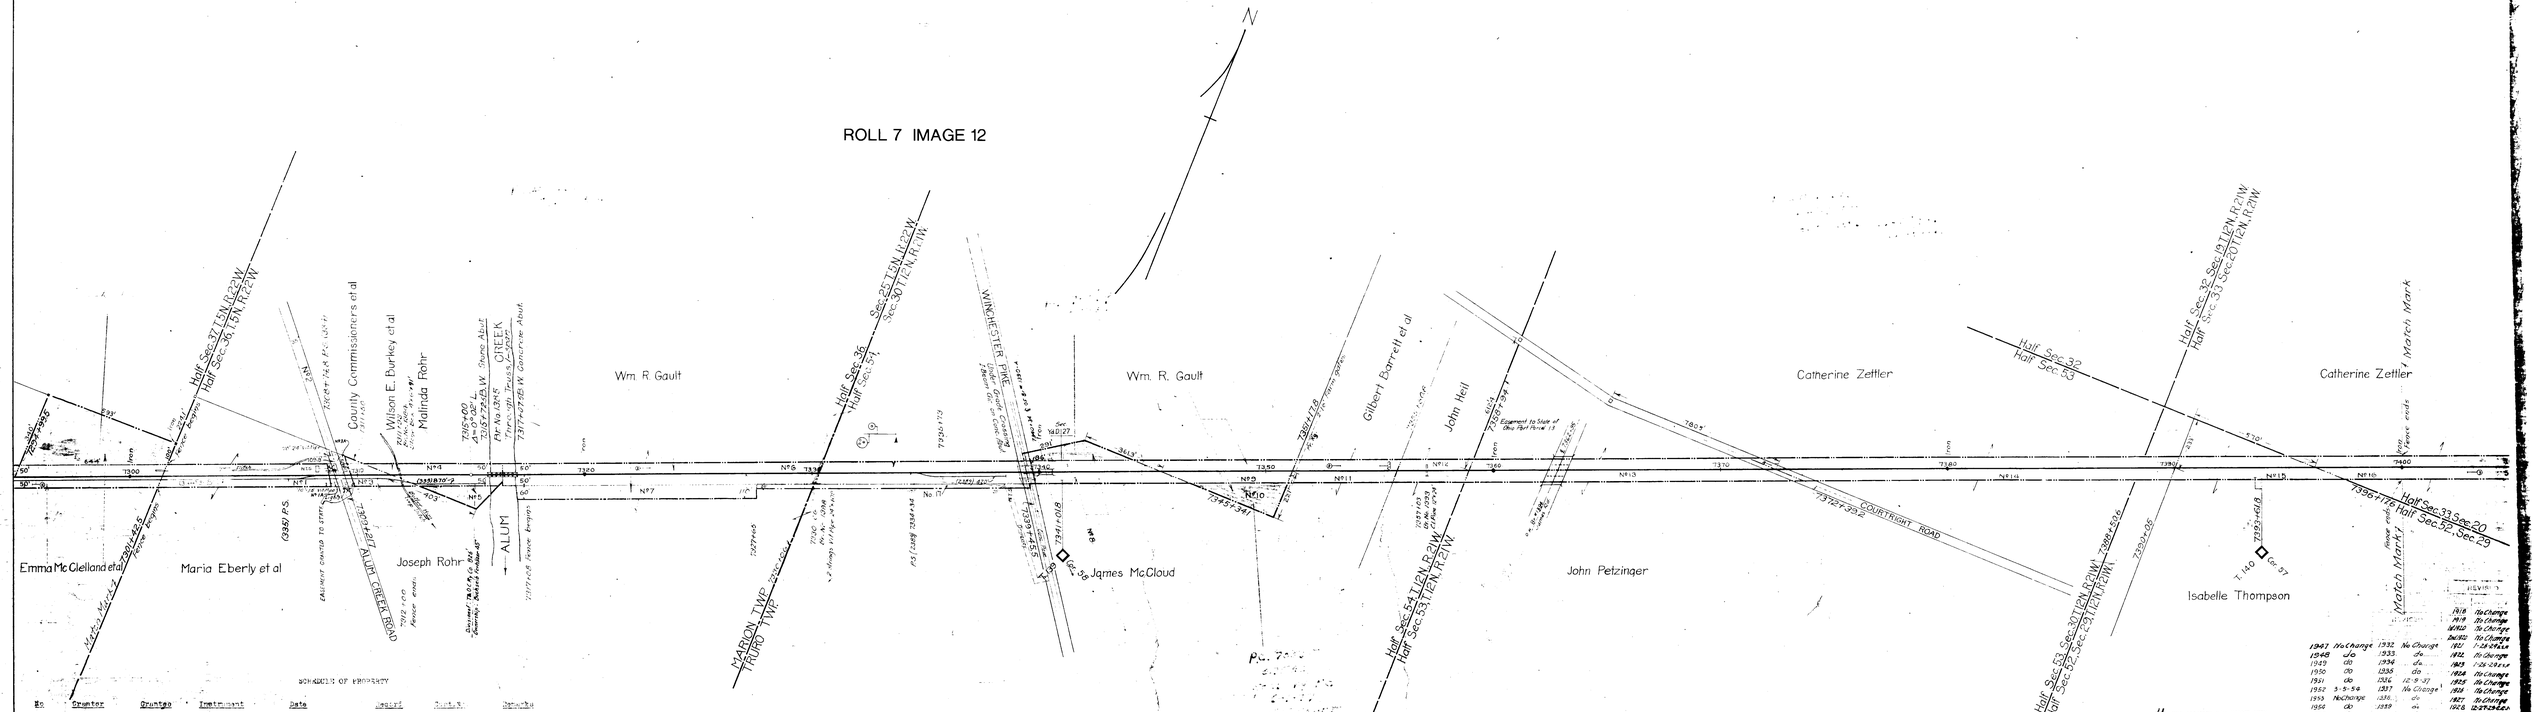
N
WINCHESTER PIKE
Wm. R. Gault
Wm. R. Gault
Gilbert Barrett et al
John Heil
Catherine Zettler
Catherine Zettler
Half Sec.32
Half Sec. 33
Half Sec.32 Sec.19 T1EN R21W
Half Sec. 31 Sec.20 T1EN R21W
County Commissioners et al
Wilson E. Burkey et al
Malinda Rohr
CREEK
Stone Abut
Concrete Abut.
Emma Mc Clelland et al
Maria Eberly et al
Joseph Rohr
ALUM CREEK ROAD
ALUM
Joseph Rohr
James McCloud
John Petzinger
Isabelle Thompson
COURTRIGHT ROAD
MARION TWP
TRURO TWP
Half Sec.64 T1EN R21W
Half Sec.53 T1EN, R21W
Half Sec.53 Sec.19 T1EN R21W
Half Sec.52 Sec.29 T1EN R21W
Half Sec.33 Sec.20
Half Sec.52, Sec.29
Match Mark
Match Mark
Match Mark

ROLL 7 IMAGE 13

ROLL 7 IMAGE 14

No.	Grantor	Grantee	Instrument	Date	Record	Cust.No.	Remarks
6	R. McKee	O.C. R.R.Co.	Deed	July 2, 1890	DD V114 P466	Aug 23, 1890	1166	Formerly T&OC Ry & O Mapoli Part
7	Robert T. Burt	T. & O.C.Ry Co	R. Deed	Aug 18, 1891	DR V138 P613	Nov 21, 1891	1165	- - -
8	Mida T. Thompson	do	R. Deed	Dec. 6, 1895	Land & Tax Dept File		141	- - -
9	Samuel Thomas	O.C.R.R.Co.	Q.C. Deed	May 14, 1882	DD V114 P249	Aug 23, 1890	1146	- - -
6,7,8,9	County Commissioners	C.L.&C.R.R.Co.	Resolution	Sept 24, 1878			3063	Right to cross highways
Adjust.	T.&O.C.Ry Co	County of Franklin	Easement	Aug 1, 1918			4221	2.73 acres

SCHEDULE OF PROPERTY

No.	Grantor	Grantee	Instrument	Date	Record	Cust.No.	Remarks
1	Catherine Zettler	NYS & T Co. Tr.	W. Deed	May 21, 1894	DB V261 P64	May 31, 1894	7461141	This is a part of parcel #16, Map 76 See Note No. 1.
2	Geo.P. Schwartz	NYS & T Co. Tr.	W. Deed	May 31, 1894	DB V262 P105	June 15, 1894	7461143	See Note No. 1.
3	Wm. T. Thompson	NYS & T Co. Tr.	W. Deed	June 28, 1894	DB V263 P163	July 21, 1894	7461144	See Note No. 1.
4	Noah Davis	NYS & T Co. Tr.	W. Deed	May 9, 1894	DB V260 P450	May 19, 1894	7461145	See Note No. 1.
5	M. F. Thompson	T & O C Ry Co.	R. Deed	Dec 4, 1885	Land and Tax Dept File		7461149	This deed also conveys parcel #2, Map 76

Note:-

No. 1 - Conveyed to T. & O. C. Ry Co. by New York Security and Trust Co., Trustee, by Q.C.Deed Apr. 29, 1897, Recorded Vol. 295 P338 May 21, 1897 and Vol. 331 P463 Aug. 20, 1900. Cust.No. 816.

30Z-82

A-15-1-12

FRANKLIN COUNTY

TRURO TOWNSHIP

RIGHT OF WAY AND TRACK MAP

~~THE TOLEDO AND OHIO CENTRAL RAILWAY~~

OPERATED BY

~~THE TOLEDO AND OHIO CENTRAL RAILWAY COMPANY~~

~~CORNING DIVISION~~ -- MAIN LINE

FROM STATION 7400+00 TO STATION 7460+80.8

SCALE 1 INCH - 200 FEET JUNE 30, 1918

OFFICE OF VALUATION ENGINEER, COLUMBUS, OHIO

CORRECTED AS OF JAN. 1, 1931

OFFICE OF VALUATION ENGINEER, CLEVELAND, OHIO

THIS PROPERTY WAS MERGED WITH THE NEW YORK CENTRAL RAILROAD COMPANY JUNE 29, 1952 AUTHORIZED IN I. C. C. DOCKET NO. 17700 DECIDED JUNE 18, 1952

V-302 77

V.5 11

V.4 4-15

ROLL 7 IMAGE 15

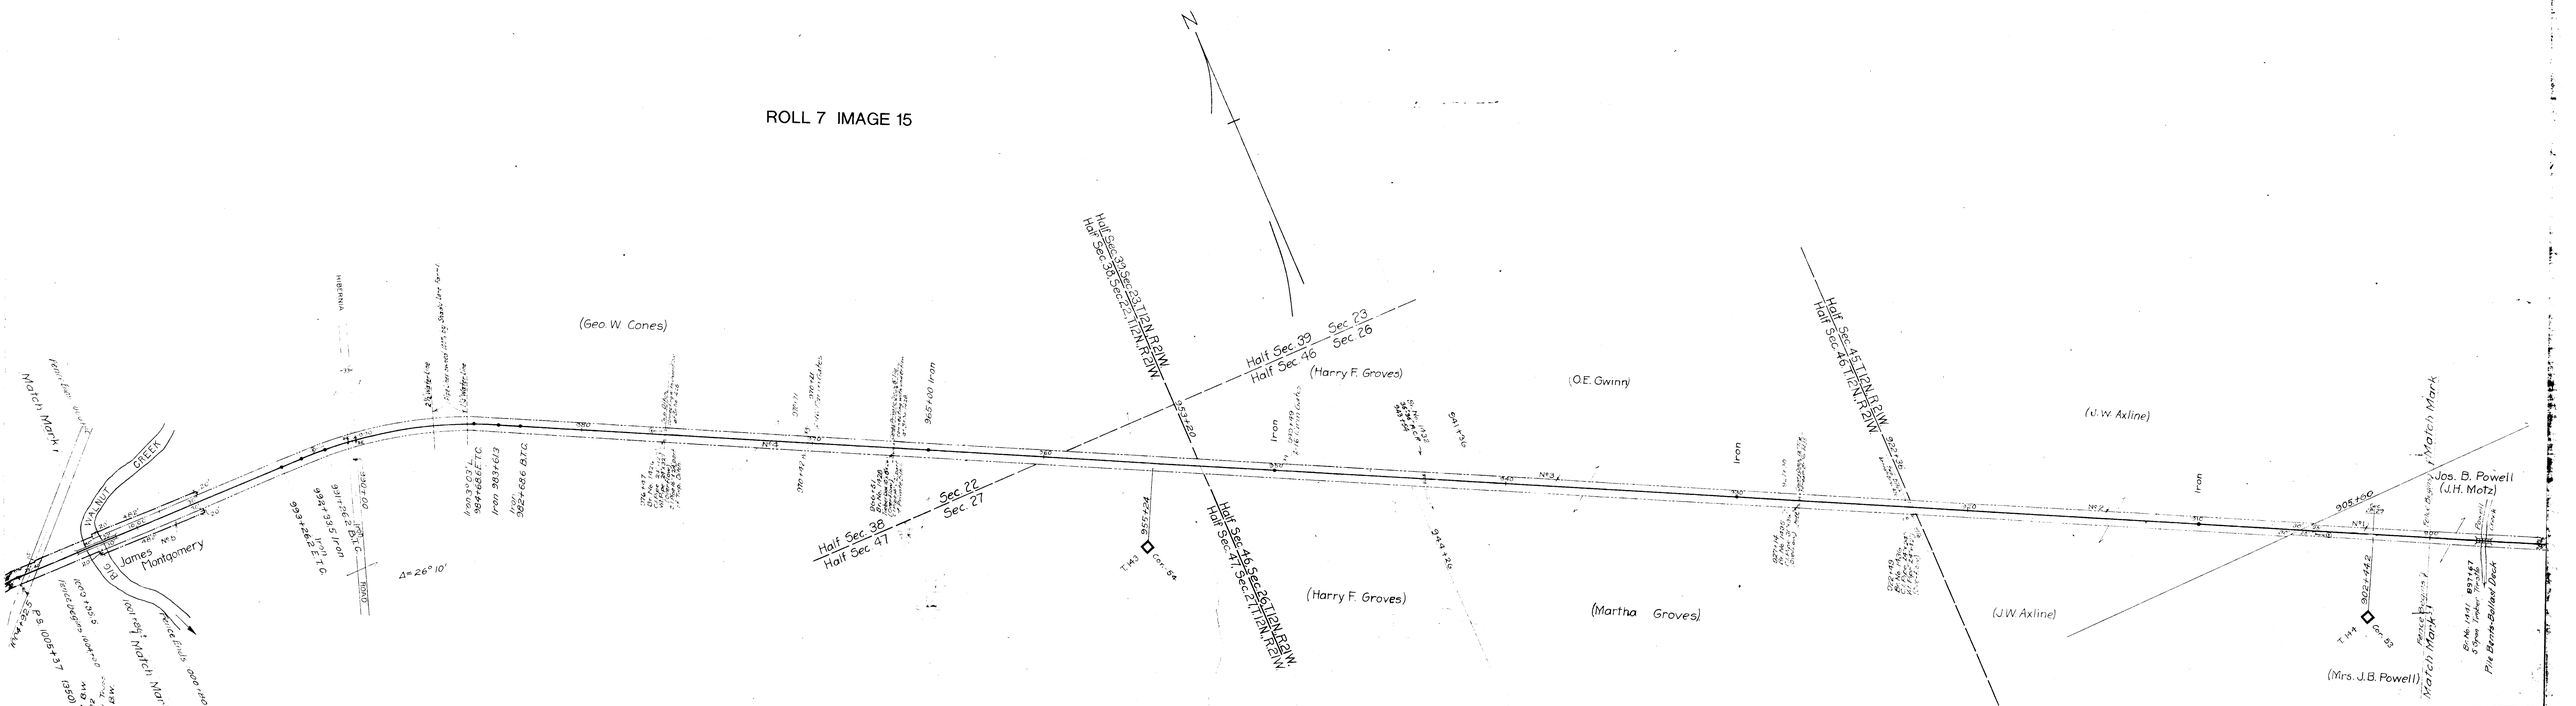

FRANKLIN COUNTY
TRURO TOWNSHIP

1941	No Change	1948	Jan 1-49	1902	No Change
1949	No Change	1950	do	1953	do
1951	do	1951	do	1954	do
1952	3-5-54	1952	3-5-54	1955	do
1953	No Change	1953	No Change	1956	do
1954	do	1954	do	1957	do
1955	do	1955	do	1958	do
1956	"	1956	"	1959	do
1957	"	1957	"	1960	do
1958	7-14-59	1958	do	1961	do
		1959	do	1962	do
		1960	do	1963	do
		1961	do	1964	do
		1962	do	1965	do
		1963	do	1966	do
		1964	do	1967	do
		1965	do	1968	do
		1966	do	1969	do
		1967	do	1970	do
		1968	do	1971	do
		1969	do	1972	do
		1970	do	1973	do
		1971	do	1974	do
		1972	do	1975	do
		1973	do	1976	do
		1974	do	1977	do
		1975	do	1978	do
		1976	do	1979	do
		1977	do	1980	do
		1978	do	1981	1-1-81

REVISED

Date Changed	
7/18	No Change
10/19	No Change
1/1924	No Change
Dec 1927	No Change
1931	2-1-32 ESM
1932	No Change
1933	2-1-33 ESM
1934	No Change
1935	2-1-35 ESM
1936	No Change
1937	2-1-37 ESM
1938	2-1-38 ESM
1939	No Change
1940	No Change

THIS PROPERTY WAS MERGED WITH THE NEW YORK CENTRAL RAILROAD COMPANY JUNE 30, 1952 AUTHORIZED IN I. C. C. DOCKET NO. 17700 DECIDED JUNE 18, 1952

RIGHT OF WAY AND TRACK MAP

~~THE TOLEDO AND OHIO CENTRAL RAILWAY~~

OPERATED BY

~~THE TOLEDO AND OHIO CENTRAL RAILWAY COMPANY~~

~~CORNING DIVISION~~ -- MAIN LINE

FROM STATION 900+00 TO STATION 1001+86±

SCALE 1 INCH - 200 FEET

JUNE 30, 1918

OFFICE OF VALUATION ENGINEER, COLUMBUS, OHIO.

OPERATED BY THE NEW YORK CENTRAL RAILROAD COMPANY SUBSEQUENT TO DECEMBER 31 1921

V-302 78

V-5 10

10

ROLL 7 IMAGE 16

ROLL 7 IMAGE 17

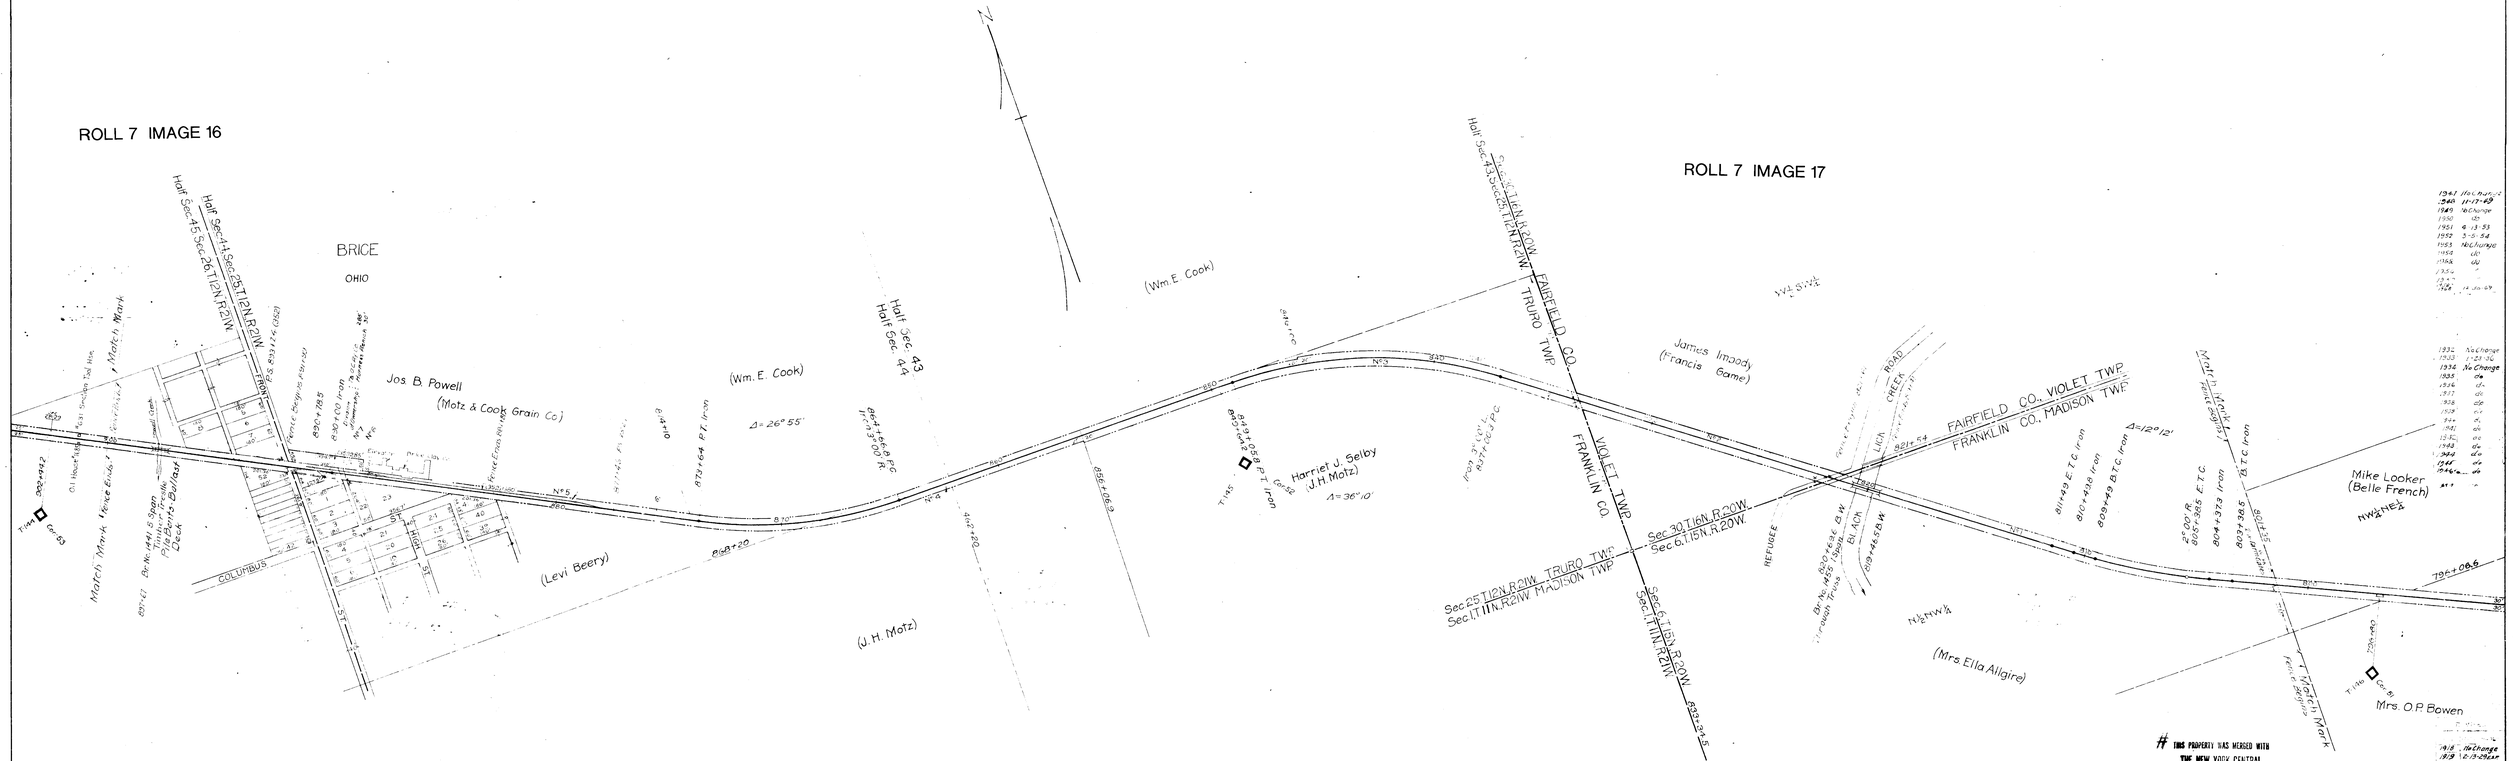
BRICE
OHIO
Half Sec. 44 Sec. 45 Sec. 26 T.12N. R.21W.
Half Sec. 44 Sec. 25 T.12N. R.21W.
Jos. B. Powell
(Motz & Cook Grain Co.)
(Wm. E. Cook)
Half Sec. 43
Half Sec. 44
Δ = 26° 55'
(Wm. E. Cook)
Harriet J. Selby
(J.H. Motz)
Δ = 36° 10'
(Levi Beery)
(J.H. Motz)
Half Sec. 43 Sec. 26 T.12N. R.20W.
FAIRFIELD CO.
TRURO TWP.
FRANKLIN CO.
VIOLET TWP.
James Imaody
(Francis Game)
FAIRFIELD CO. VIOLET TWP.
FRANKLIN CO. MADISON TWP.
Δ = 12° 12'
LICK CREEK ROAD
REFUGEE
(Mrs. Ella Allgire)
Mike Looker
(Belle French)
Mrs. O.P. Bowen
COLUMBUS
Match Mark
Match Mark
Match Mark



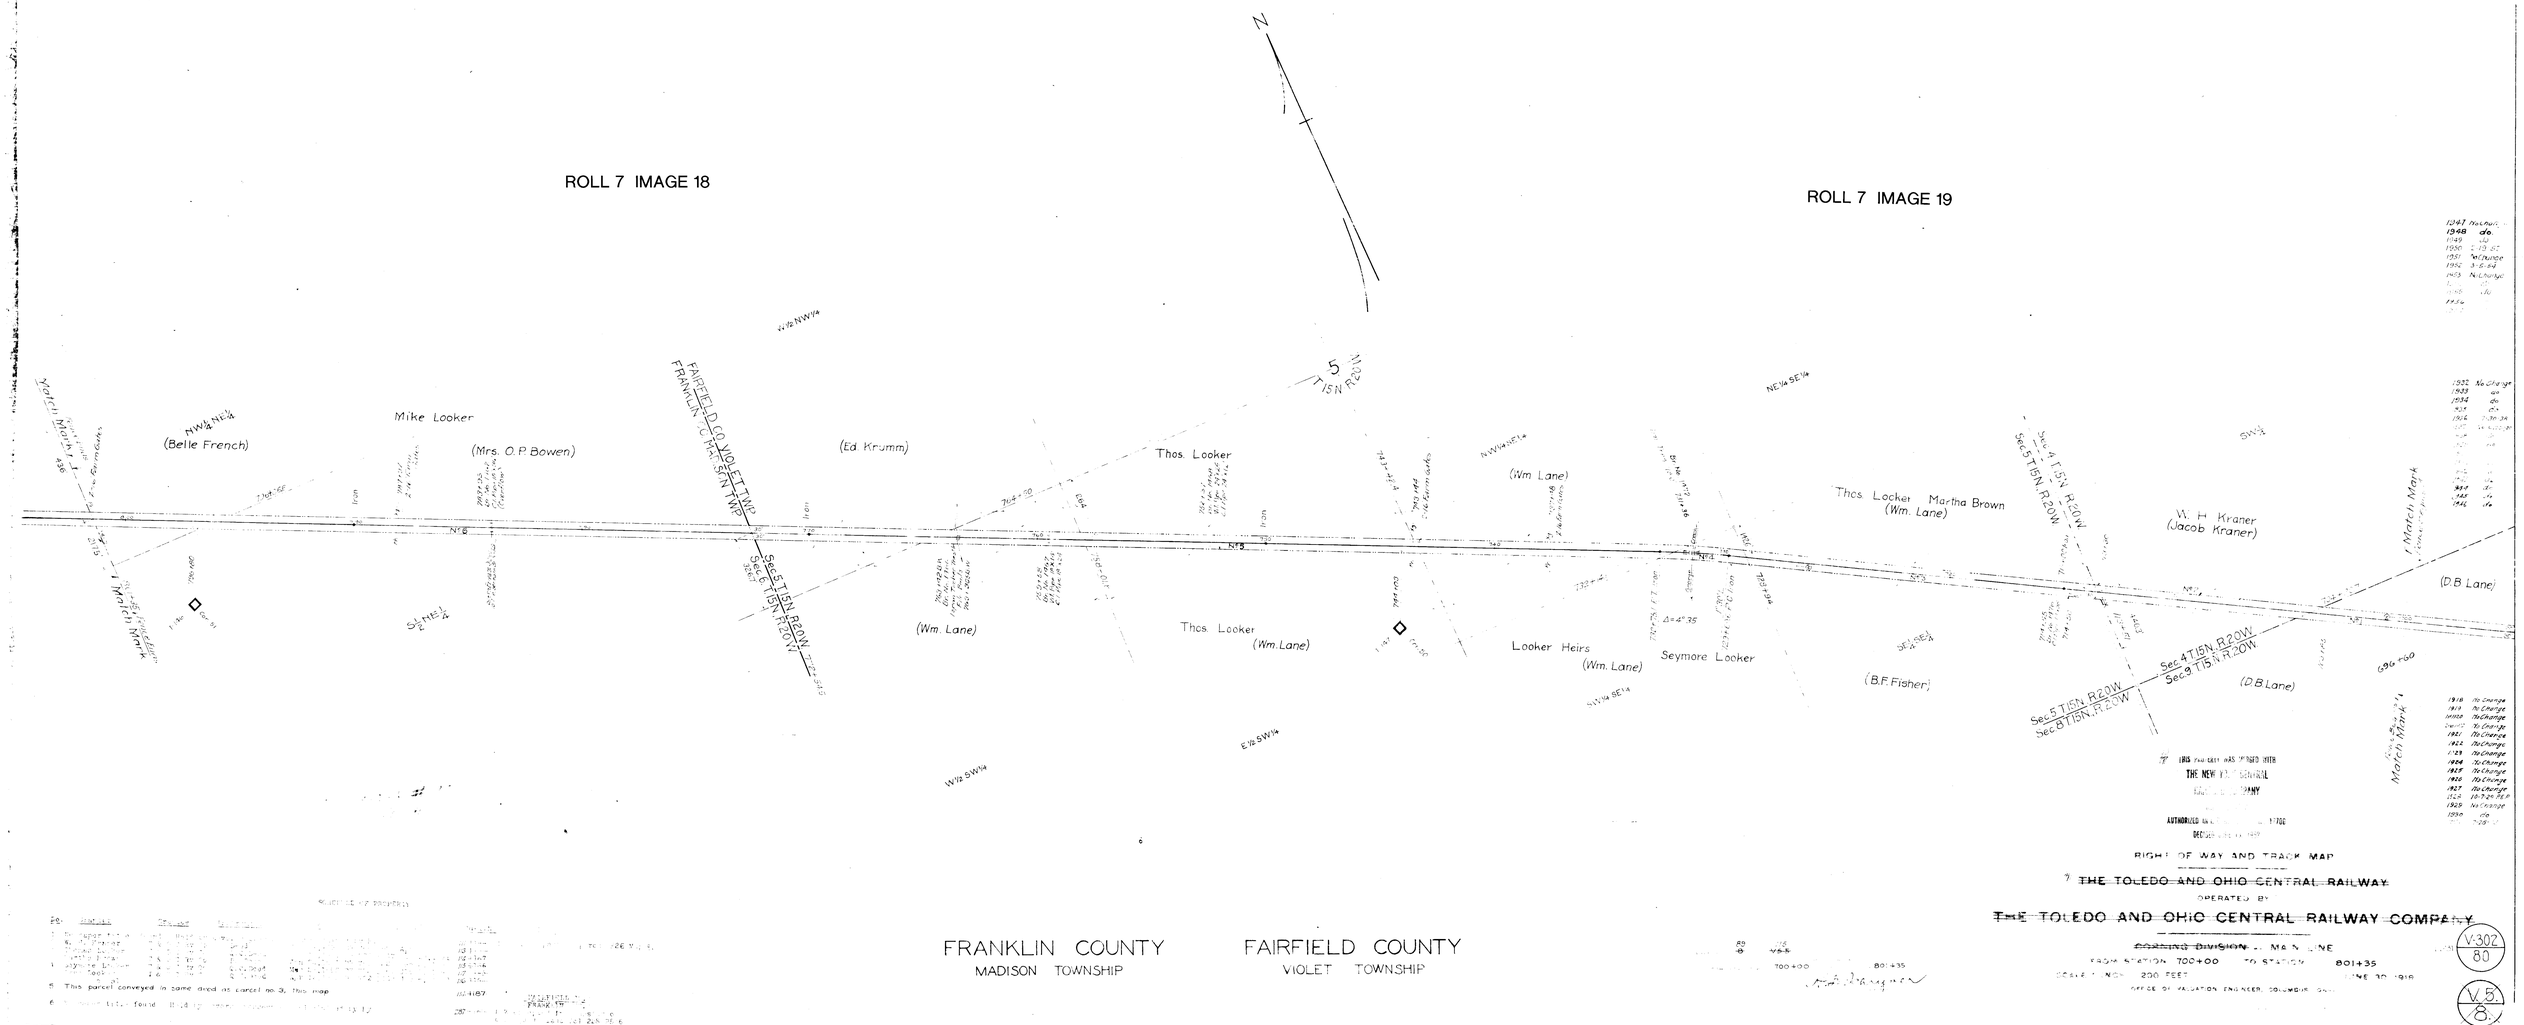

FRANKLIN COUNTY
MADISON TOWNSHIP

FAIRFIELD COUNTY
VIOLET TOWNSHIP

THE NEW YORK CENTRAL
COMPANY

AUTHORIZED
DECEMBER 31, 1959

RIGHT OF WAY AND TRACK MAP

THE TOLEDO AND OHIO CENTRAL RAILWAY

OPERATED BY

THE TOLEDO AND OHIO CENTRAL RAILWAY COMPANY


FROM STATION 700+00 TO STATION 801+35

SCALE 1 INCH = 200 FEET

OFFICE OF VALUATION ENGINEER, COLUMBUS, OHIO

JUNE 30, 1918

V-302
80

V.5.
8.

5-2-8
302.89

12