


ROLL 8 IMAGE 1

 

SCHEDULE OF PROPERTY

No.	Creator	Grantee	Instrument	Date	Reg.	Vol.	Page	Acres


MADISON COUNTY FRANKLIN COUNTY
 DARBY TOWNSHIP WASHINGTON TOWNSHIP

THIS PROPERTY WAS MERGED WITH THE NEW YORK CENTRAL RAILROAD COMPANY

Year	Change	Year	Change
1941	No Change	1932	No Change
1940	do	1931	do
1939	do	1930	do
1938	do	1929	do
1686	do	1677	do

ROLL 8 IMAGE 2

ROLL 8 IMAGE 3

 

SCHEDULE OF PROPERTIES

No.	Grantor	Grantee	Instrument	Date	Record	Dist. No.	Remarks
1	Joshua P. Frieszell	T & O C Ry Co	A. Deed	Apr 23, 1897	DB V245 P400	Apr 12, 1893	436-2 This is a part of parcel #12 map 61
2	Joshua P. Frieszell	T & O C Ry Co	Deed	Apr 23, 1897	DB V1293 P443	June 4, 1946	436-3
3	Joshua P. Frieszell	T & O C Ry Co	Deed	Apr 4, 1894	DB V1299 P444	June 4, 1946	436-4
4	No paper title found	Hold by adverse possession and title	Deed by Ry Co	Feb 8, 1896	DB V311 P408	Feb 11, 1895	436-5
5	Geo. Cosgray	T & O C Ry Co	A. Deed	Apr 7, 1895	DB V444 P436	Apr 11, 1893	436-7
6	Geo. Cosgray	T & O C Ry Co	A. Deed	Apr 7, 1895	DB V245 P400	Apr 11, 1893	436-8
7	Owen T. Cramer	T & O C Ry Co	W. Deed	Apr 12, 1914	DB V247 P443	Apr 18, 1906	436-19
8	This parcel conveyed in same deed as parcel #7						436-19
9	Henry Shriver	T & O C Ry Co	A. Deed	July 17, 1893	DB V245 P400	Apr 11, 1893	436-20
10	John W. Zimmer	T & O C Ry Co	Condemnation	June 24, 1892	DB V245 P400	Apr 11, 1893	436-21
11	J. G. Pendleton	T & O C Ry Co	Condemnation	June 24, 1892	DB V245 P400	Apr 11, 1893	436-21
12	Riley Houchard et al	T & O C Ry Co	W. Deed	Apr 12, 1893	DB V245 P400	Apr 11, 1893	436-22
13	W. J. Shriver and John W. Zimmer	T & O C Ry Co	Condemnation	June 24, 1892	DB V245 P400	Apr 11, 1893	436-23
14	Edith R. Finch et al	T & O C Ry Co	W. Deed	Dec 1, 1946	AFE 68233		436-24

FRANKLIN COUNTY
WASHINGTON TOWNSHIP

THIS PROPERTY WAS MERGED WITH THE NEW YORK CENTRAL RAILROAD COMPANY

DECEASED JUNE 18, 1952

AUTHORIZED IN I. C. C. DOCKET NO. 17700

DECEASED JUNE 18, 1952

RIGHT OF WAY AND TRACK MAP

1947	No Change				
1948	do				
1949	do	1932	No Change	1938	No Change
1950	2-15-52	1933	do	1939	1/1/29 L.D.D.
1951	No Change	1934	do	1940	1/1/29 L.D.D.
1952	3-6-54	1935	do	1941	No Change
1953	No Change	1936	do	1942	No Change
1954	do	1937	do	1943	No Change
1955	do	1938	do	1944	No Change
1956	do	1939	do	1945	No Change
1957	do	1940	do	1946	No Change
1958	1-19-50	1941	do	1947	No Change
1959	do	1942	do	1948	No Change
1960	do	1943	do	1949	No Change
1961	do	1944	do	1950	No Change
1962	do	1945	do	1951	No Change
1963	do	1946	do	1952	No Change
1964	3-16-48	1947	do	1953	No Change

THE TOLEDO AND OHIO CENTRAL RAILWAY
OPERATED BY
THE TOLEDO AND OHIO CENTRAL RAILWAY COMPANY

WESTERN DIVISION -- MAIN LINE

FROM STATION 6300+00 TO STATION 6402+60.6

SCALE 1 INCH = 200 FEET

JUNE 30, 1918


OFFICE OF VALUATION ENGINEER, COLUMBUS, OHIO

CONNECTION AS OF JAN 1 1918
OFFICE OF VALUATION ENGINEER, LEBANON, OHIO

V-302
62
V-2
62

ROLL 8 IMAGE 4

ROLL 8 IMAGE 5

 


Grantor	Grantee	Instrument	Date	Record	Dist. No.	Book	Page
Alexander Davidson	W. J. Shriver and John J. Stoddart	W. Deed	Apr 7 1893	DB 7445 P598	Apr 11 1893	248	24
Wm. J. Shriver and John J. Stoddart	W. Deed	Ordnance	June 24 1893	Probate Court Case	7799	241	25
Sylvester S. Vanschoyck	W. Deed	W. Deed	Apr 7 1893	DB 7188 P598	Sept 30 1893	245	26
James C. Spicer	W. Deed	W. Deed	Apr 12 1893	DB 7247 P446	Apr 16 1893	244	26
Geo. W. Vanschoyck	W. Deed	W. Deed	Apr 12 1893	DB 7247 P447	Apr 16 1893	245	27
Barbara Renner	W. Deed	W. Deed	May 21 1893	DB 7189 P598	Aug 7 1893	246	28
Edwin W. Warren	W. Deed	W. Deed	June 1 1893	DB 7252 P446	July 11 1893	244	29
Asbury Schofield	W. Deed	W. Deed	May 12 1893	DB 7252 P447	July 11 1893	245	30
Mae L. Weaver	W. Deed	W. Deed	Sept 16 1943	Complete Record	151	A.F.S. 62732	

FRANKLIN COUNTY
WASHINGTON TOWNSHIP
NORWICH TOWNSHIP

Year	Change	Year	Change	Year	Change
1947	No Change	1932	No Change	1918	No Change
1946	do	1931	do	1917	L.O.D.
1945	do	1930	do	1916	L.O.D.
1944	do	1929	do	1915	L.O.D.
1943	do	1928	do	1914	L.O.D.
1942	do	1927	do	1913	No Change
1941	do	1926	do	1912	No Change
1940	do	1925	do	1911	No Change
1759	do	1744	do	1730	No Change
1758	do	1743	do	1	

NO	GRANTOR	GRANTEE	SCHEDULE OF PROPERTY (CONT.)	DATE	RECORD	CUSTOMER	REMARKS
9	CHARLES E. VIDT	NYC.R.R.CO.	W DEED	JAN. 25, 1947	V. 240, P. 447		

ROLL 8 IMAGE 6

 

NO	OWNER	DATE	DESCRIPTION	RECORD	REMARKS

FRANKLIN COUNTY
NORWICH TOWNSHIP

THE PROPERTY WAS MERGED WITH
THE NEW YORK CENTRAL
RAILROAD COMPANY
JUNE 30, 1952

APPROVED IN L. C. DOCKET NO. 17700
RECORDED JUNE 10, 1952

RIGHT OF WAY AND TRACK MAP
THE TOLEDO AND OHIO CENTRAL RAILWAY

OPERATED BY
THE TOLEDO AND OHIO CENTRAL RAILWAY COMPANY



Year	Change	Year	Change	Year	Change
1947	No Change	1952	No Change	1958	No Change
1948	do	1953	do	1959	No Change
1949	do	1954	do	1960	No Change
1950	do	1955	do	1961	No Change
1951	do	1956	do	1962	No Change
1952	3-5-54	1957	do	1963	No Change
1953	No Change	1958	do	1964	No Change
1954	do	1959	do	1965	No Change
1955	do	1960	do	1966	No Change
1956	do	1961	do	1967	No Change
1989	do	1994	do	2000	No Change
1990	do	1995	do		

SHEET NO. 67 OF 115
BY THE TOLEDO AND OHIO CENTRAL RAILWAY
WESTERN DIVISION - MAIN LINE
FROM STATION 6500+00 TO STATION 6600+00
SCALE 1 INCH = 200 FEET
JUNE 30, 1918
OFFICE OF VALUATION ENGINEER COLUMBUS OHIO

V-302
64
11-31
V-302
64

ROLL 8 IMAGE 7

ROLL 8 IMAGE 8

 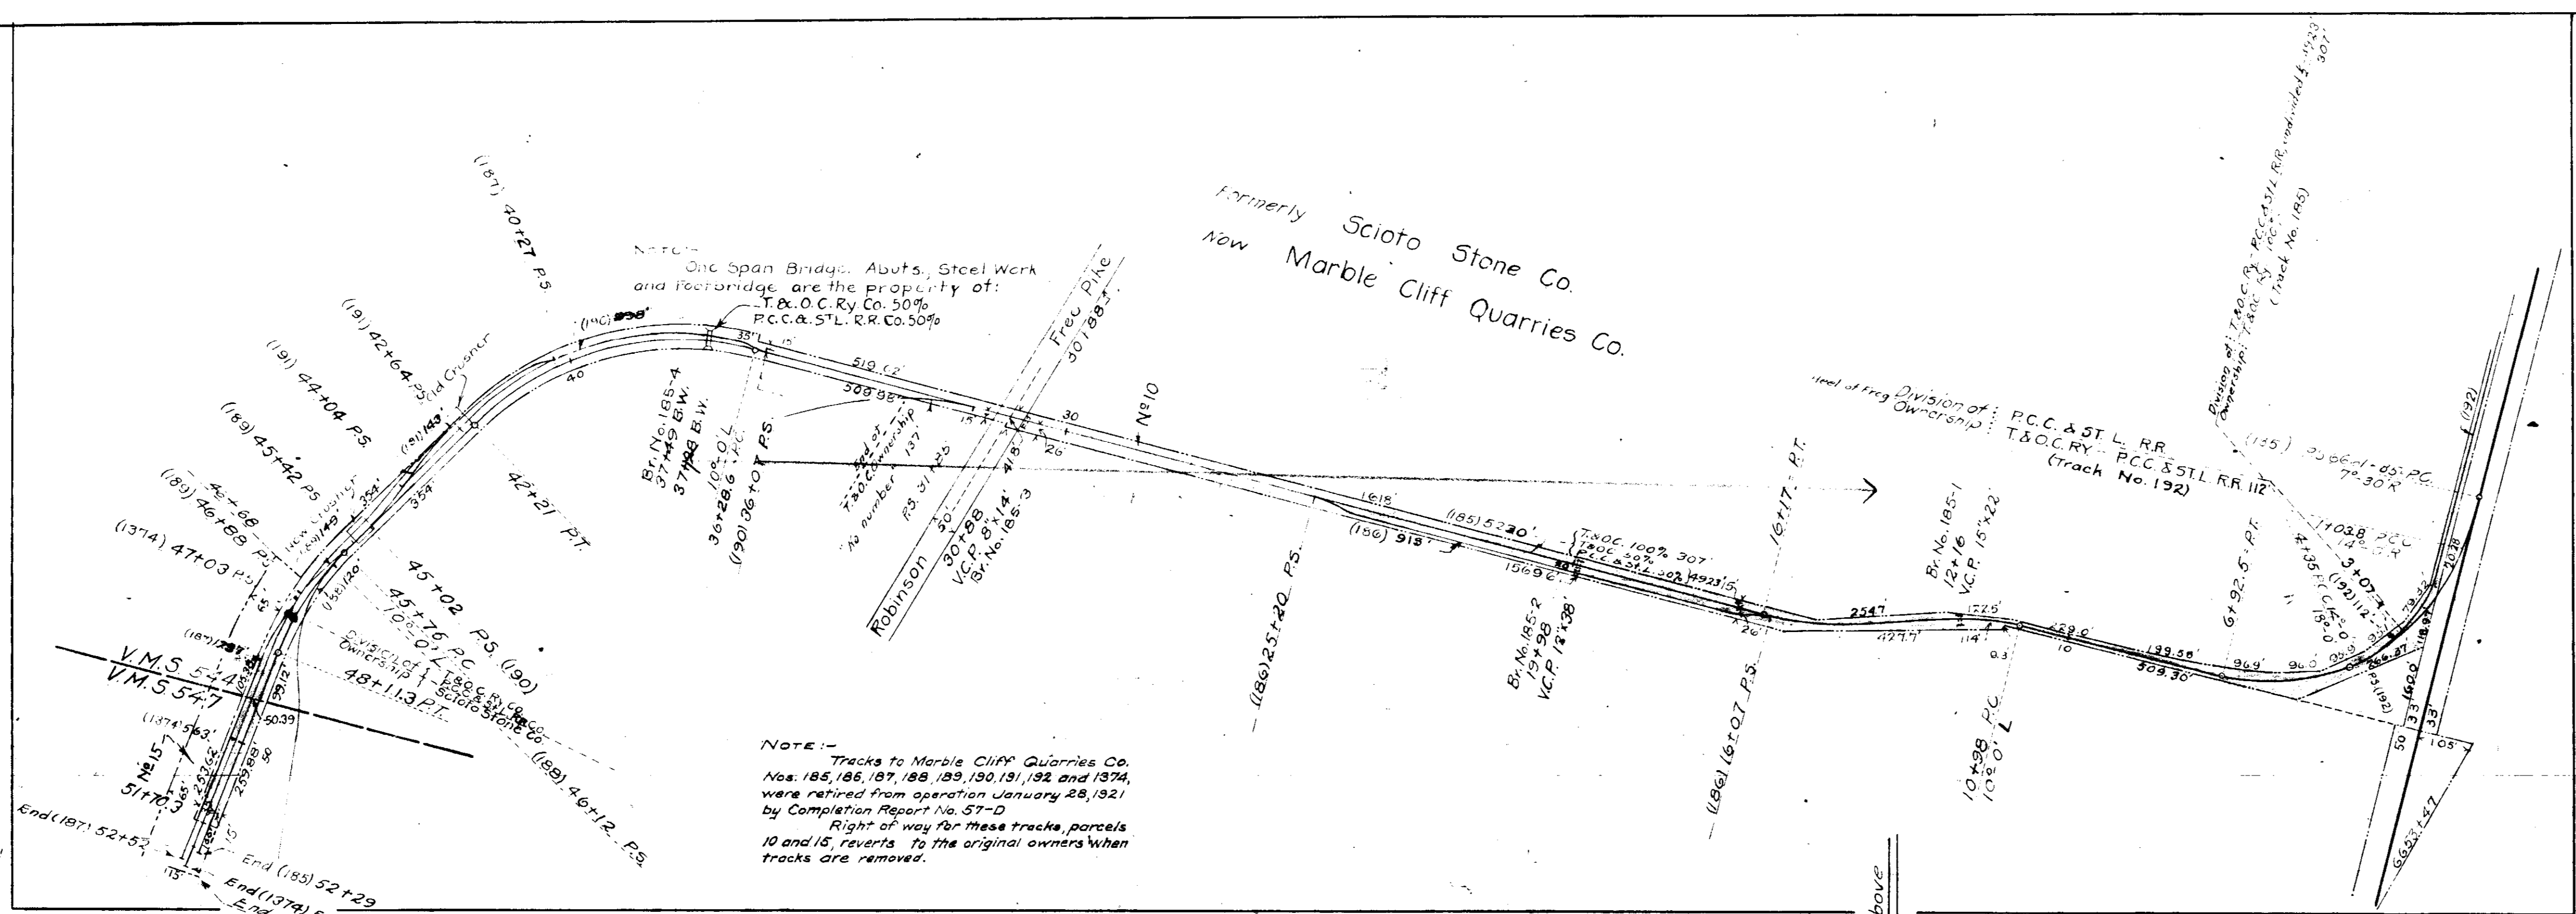

SCHEDULE OF PROPERTY

No.	Grantor	Grantor	Instrument	Date	Record	Cont. No.	Notes
1	Mary E. Lane	T & O C Ry Co	W. Deed	Apr 12, 1893	DB 7247 1411	Apr 18, 1893	46430 This is a part of parcel #1
2	Albert Scrimger, et al	T & O C Ry Co	Condemnation	July 15, 1893	Probate Court Case #7977 75839	Sept 5, 1893	and #8195 Complete
3	S. A. Williams	T & O C Ry Co	W. Deed	May 25, 1893	DB 7251 1171	June 5, 1893	76640
4	Wm. O. Van Houten	T & O C Ry Co	W. Deed	May 25, 1893	DB 7251 1171	June 5, 1893	76640
5	Clara Hoffman, et al	T & O C Ry Co	W. Deed	Mar 24, 1893	DB 7181 1111	June 11, 1893	76642
6	Clara Hoffman, et al	T & O C Ry Co	W. Deed	June 17, 1893	DB 7252 1124	July 11, 1893	76643
7	Wm. M. Armistead	T & O C Ry Co	W. Deed	Apr 15, 1893	DB 7045 1140	Apr 12, 1893	76644
8	John A. Rogers, et al	T & O C Ry Co	W. Deed	May 8, 1893	DB 7049 1117	June 8, 1893	76645
9	Jane E. Trafzer, et al	T & O C Ry Co	W. Deed	Apr 24, 1893	DB 7248 1114	June 11, 1893	76646
10	Scioto Stone Co	T & O C Ry Co & STL Ry Co	W. Deed	Apr 26, 1912	DB 7432 1130	June 11, 1912	76647 - See Note No. 1
11	Milton Rogers	T & O C Ry Co	W. Deed	June 4, 1913	DB 7440 1130	July 24, 1913	76648 - See Note No. 1
12	P. C. & S. L. Ry Co	T & O C Ry Co	Agreement	July 26, 1893	DB 7439 1124	Apr 29, 1893	76649 - See Note No. 1
13	John A. Renner	T & O C Ry Co	Condemnation	July 25, 1893	DB 7438 1124	July 25, 1893	76650 - See Note No. 1
14	Martin Rogers	T & O C Ry Co	Condemnation	July 25, 1893	Probate Court Case #1111	Complete Records - Vol. 1, 1880	76651 - See Note No. 1
15	The Scioto Stone Co. and The Ohio Portland Cement Co.	T & O C Ry Co	Agreement for R of W	Oct 1, 1903	Chief Engr's Agreement #42		See Note No. 1

Note - No. 1 - Parcels Nos. 10 and 15 revert to original owners when tracks are removed. Tracks removed Jan. 28, 1921.

THIS PROPERTY WAS MERGED WITH THE NEW YORK CENTRAL RAILROAD COMPANY

JUNE 30, 1952
AUTHORIZED IN L. C. P. DOCKET NO. 17700
DECEMBER 16, 1952

Year	Change	Year	Change
1947	No Change	1932	No Change
1948	do	1933	do
1949	do	1934	do
1950	do	1935	do
1951	do	1936	do
1952	3 5-54	1937	do
1953	No Change	1938	do
1954	do	1939	do
1955	do	1940	do
1956	do	1941	do
1957	do	1942	do
1958	do	1943	do
1959	do	1944	do
1960	do	1945	do
1961	do	1946	do

THE TOLEDO AND OHIO CENTRAL RAILWAY
OPERATED BY
THE TOLEDO AND OHIO CENTRAL RAILWAY COMPANY


FRANKLIN COUNTY
NORWICH TOWNSHIP

68 115
SHEET NO. 68 OF 115 OF THE TOLEDO AND OHIO CENTRAL RAILWAY
WESTERN DIVISION - MAIN LINE
FROM SURVEY STATION 6600+00 TO SURVEY STATION 6700+20
H. J. DeYoung
VALUATION ENGINEER

WESTERN DIVISION - MAIN LINE
FROM STATION 6600+00 TO STATION 6700+20
SCALE 1 INCH = 200 FEET
JUNE 30, 1918

OFFICE OF VALUATION ENGINEER, COLUMBUS, OHIO.
OPERATED BY THE TOLEDO AND OHIO CENTRAL RAILWAY COMPANY
COMPLETION REPORT TO DECEMBER 31, 1921
CORRECTED AS OF JAN. 1, 1922
OFFICE OF VALUATION ENGINEER, CLEVELAND, OHIO.

V-302
65
V-2
65

 

SCHEDULE OF PROPERTY

No.	Grantor	Grantee	Instrument	Record	Cust. No.	Remarks
1	Mary J. Harrison et al		1885	1885	7613	This is a part of p. e. 19
2	Edmund Harrison		1885	1885	7613	See Note No. 1
3	Stafford Phillips		1885	1885	7613	See Note No. 1

FRANKLIN COUNTY
FRANKLIN TOWNSHIP

1916 No Change
1919 No Change
1820 No Change
1821 No Change
THIS PROPERTY WAS MERGED WITH
THE NEW YORK CENTRAL RAILROAD COMPANY
JUNE 30, 1952
AUTHORIZED IN L. C. DOCKET NO. 17700
DECIDED JUNE 18, 1952


R 31, I

RIGHT OF WAY AND TRACK MAP
THE TOLEDO AND OHIO CENTRAL RAILWAY
OPERATED BY
THE TOLEDO AND OHIO CENTRAL RAILWAY COMPANY
WESTERN DIVISION -- MAIN LINE
FROM STATION 6800+00 TO STATION 6843+15
SCALE 1 INCH = 200 FEET
JUNE 30, 1918
OFFICE OF VALUATION ENGINEER, COLUMBUS, OHIO
SHORT STATION - Sta. 6839 + Sta. 6840 + 99.5
CORRECTED AS OF JAN. 1, 1901
OFFICE OF VALUATION ENGINEER, COLUMBUS, OHIO

ROLL 8 IMAGE 13


Item	A.F.E.	Completion Report
Div. 205-25' 6" Beam Rest. to Gr. Span	AF 1189	11/15/70
Const. Second Main Extend Bridges etc.	AF 1466	1/13/22
Ref. Tr. W. T. Const. Tr. # 805.231	AF 3727	1/13/22
1st. Main Extend. Const. of Columbus Ave.	721	1/21/23

NUMBER	GRANTOR	GRANTEE	INSTRUMENT	DATE	RECORD	CUSTODIAN NUMBER	V.31-A-9-3
1	Wm. J. Sullivan	OS&C RR.	Release	11/15/70	105/587	160	Franklin Co., Ohio.
2	NYC RR Co.	C.C.C. & St. L. Ry.	Lease	7/24/25		1696	
3				8/24/25		1697	
4				9/24/25		1698	
5				9/27/28		1699	
6			Possession			1650	
7						27	

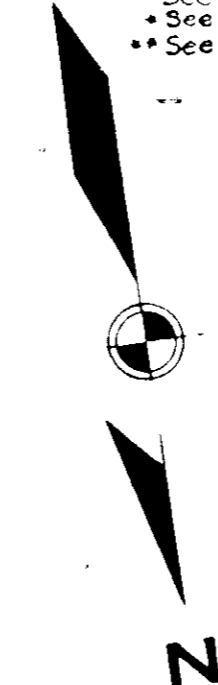

ROLL 8 IMAGE 14

COLUMBUS OHIO

 


- 1951 No Change
- 1952 " " "
- 1953 " " "
- 1954 10-3-57
- 1955 No Change
- 1956 7-17-58
- 1957 No Change
- 1960 6-5-26-67
- 1967 No Change

CORRECTED TO DECEMBER 31, 1950.
CORRECTED TO DECEMBER 31, 1954.
CORRECTED TO DECEMBER 31, 1958.
CORRECTED TO DECEMBER 31, 1960.
CORRECTED TO DECEMBER 31, 1967.


Sheet No. 5-3 of V.31-A of C.C.C. & ST. L. RY.
From Survey Station 7399+96 to 7452+76
Valuation Engineer

RIGHT-OF-WAY AND TRACK MAP
THE CLEVELAND, CINCINNATI, CHICAGO & ST. LOUIS RY.
Operated by
THE CLEVELAND, CINCINNATI, CHICAGO & ST. LOUIS RY. CO.
CINCINNATI DIVISION - MAIN LINE
Sta. 7399+96 To Sta. 7452+76
Scale 1 in. = 100 Ft. June 30th, 1915.
Office of Valuation Engineer, Cincinnati, O.

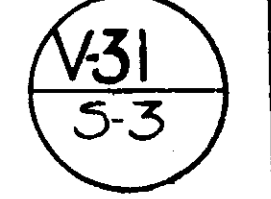

ROLL 8 IMAGE 15

PCL CONT. ON
V31 MAP 53
FORMER DIC 4

 

1953 3-15-55
1954 No Change
1955 5-14-57
1956 4-5-58
1957 No Change
1958 3-23-59
1959 8-8-60

REVISION	DATE	BY
1378	7-30-60	
1379	1-12-61	
1380	4-10-61	
1381	10-20-61	
1382	12-16-61	
1383	2-5-65	
1384	1-9-66	
1385	1-16-67	
1386	3-18-68	
1387	No Change	
1388	do.	
1389	12-12-90	
1390	2-12-92	
1391	4-14-93	
1392	3-3-94	

THIS MAP WAS PREPARED BY
THE NEW YORK CENTRAL
RAILROAD COMPANY
JUNE 26, 1962
APPROVED BY I. C. C. MARKET NO. 17900
ISSUED JUNE 26, 1962
RIGHT-OF-WAY AND TRACK MAP
THE TOLEDO AND OHIO CENTRAL RAILWAY

OPERATED BY
THE NEW YORK CENTRAL RAILROAD CO.
MAIN LINE
WEST COLUMBUS, O.

FRANKLIN COUNTY
FRANKLIN TOWNSHIP

I HEREBY CERTIFY THAT THIS IS A CORRECT
MAP PREPARED FROM THE RECORDS OF THE
NEW YORK CENTRAL RAILROAD COMPANY.
JUNE 6, 1964
James C. Groves
REGISTERED ENGINEER


FROM STA. 6843+15 TO STA. 6801+08
SCALE 1" = 100' AS OF JUNE 30, 1962
OFFICE OF VALUATION ENGINEER
CLEVELAND, OHIO

V302
68
REVISED

ROLL 8 IMAGE 16

ROLL 8 IMAGE 17

SOLD C-62762
9/1/72
4.757 AC

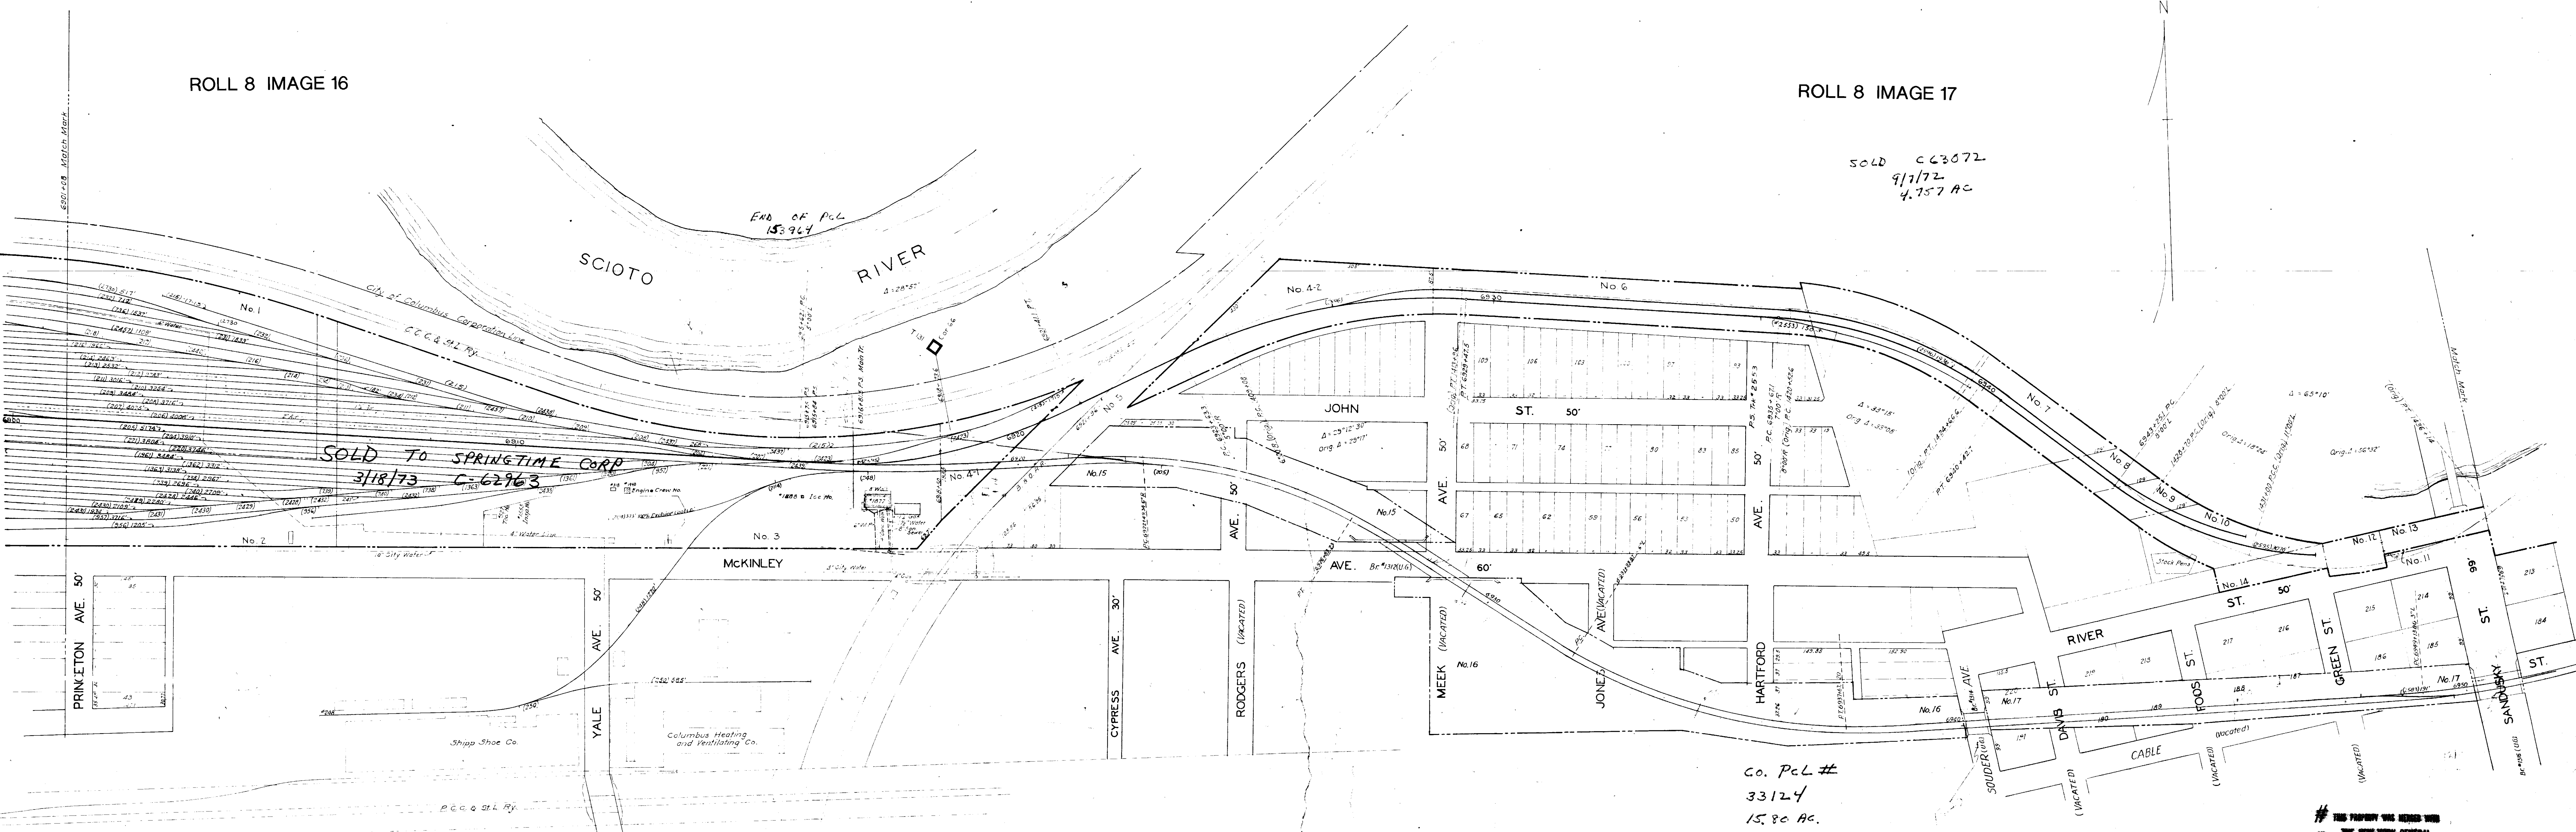

1953	3-21-55
1954	10-14-55
1955	NO CHANGE
1956	4-10-56
1957	NO CHANGE
1958	12-31-57

REVISIONS	
No.	Date Changed
1928	7-30-28
1929	NO CHANGE
1930	4-7-32
1941	NO CHANGE
1942	do
1943	do
1944	do
1945	do
1946	do
1922	7-29-49
1948	11-9-49
1952	NO CHANGE
1950	2-19-52
1951	NO CHANGE
1952	do

FRANKLIN COUNTY

I HEREBY CERTIFY THAT THIS IS A CORRECT MAP PREPARED FROM THE RECORDS OF THE NEW YORK CENTRAL RAILROAD COMPANY.
 JAMES C. GIBSON
 SURVEYOR ENGINEER
 DEC. 16, 1944

THIS PROPERTY WAS ACQUIRED BY
THE NEW YORK CENTRAL RAILROAD COMPANY
 JUNE 30, 1952
 AUTHORIZED BY L. C. C. ORDER NO. 1700
 ISSUED JUNE 14, 1952

RIGHT-OF-WAY AND TRACK MAP
THE TOLEDO AND OHIO CENTRAL RAILWAY
 OPERATED BY
THE NEW YORK CENTRAL RAILROAD CO.
 MAIN LINE
WEST COLUMBUS, O.


FROM STA. 6301+08 TO STA. 6351+10
 SCALE 1" = 800'
 AS OF JUNE 30, 1952
 OFFICE OF VALUATION ENGINEER
 CLEVELAND, OHIO

V-302
69



SCIOTO ROLL 8 IMAGE 18

ROLL 8 IMAGE 19

 

1922	3-3-54
1923	3-21-55
1924	2-2-56
1925	No Change
1926	4-10-53
1927	8-11-53
1928	1-2-70
1937	2-23-40
1938	5-10-41
1939	4-4-41
1940	4-17-42
1941	No Change
1942	do
1943	do
1944	1-9-46
1945	No Change
1946	do
1947	do
1948	11-9-49
1949	No Change
1950	do
1951	do

THIS PROPERTY WAS MERGED WITH
**THE NEW YORK CENTRAL
RAILROAD COMPANY**
JUNE 30, 1952
ANNOUNCED BY U.S. GOVERNMENT NO. 17700
DATED JUNE 18, 1952

TRACK AND STRUCTURE MAP
THE TOLEDO AND OHIO CENTRAL RAILWAY
OPERATED BY
THE NEW YORK CENTRAL RAILROAD CO.
MAIN LINE
COLUMBUS, O

FROM STA. 6881+10 TO STA. 7000+00
SCALE 1" = 100'
OFFICE OF VALUATION ENGINEER
CLEVELAND, OHIO

I HEREBY CERTIFY THAT THIS IS A CORRECT
MAP PREPARED FROM THE RECORDS OF THE
NEW YORK CENTRAL RAILROAD COMPANY.
JUN 14, 1954
J. J. ...
REGISTERED ENGINEER

V-302
70
V-4
3

FRANKLIN COUNTY

COLUMBUS OHIO