


 


SCHEDULE OF PROPERTY

Owner	Section	Instrument	Date	Acres	Cont. No.	Remarks
Samuel Thomas	1046+65.2	O.C. Deed	May 10, 1882	2.42	1146	This deed also conveys parcel #1, Map 75
W. T. Thompson	1046+65.2	O.C. Deed	Dec 4, 1885	2.42	1147	This deed also conveys parcel #2, Map 75 and parcel #3, Map 75

FRANKLIN COUNTY
TRURO TOWNSHIP

TRURO
OHIO

RIGHT OF WAY AND BACK MAP
THE TOLEDO AND OHIO CENTRAL RAILWAY
THE TOLEDO AND OHIO CENTRAL RAILWAY COMPANY
CORNING DIVISION
EAST COLUMBUS BRANCH - MAIN LINE
FROM STATION 1046+65.2 TO STATION 1110+69.8
SCALE 1 INCH = 200 FEET
JUNE 30, 1918
OFFICE OF VALUATION ENGINEER, COLUMBUS, OHIO

 

No.	Grantor	Grantee	Reference	Date	Record	Volume	Page
1	De paper title found.	Will by Charles Doney and claimed by Ry Co			1150		
10	Rachael Evans	T & O C Ry Co	W. Deed	Sep 18, 1889	DB V922	P184	Oct. 22, 1923
11	Southern Ohio Public Service Co.	T & O C Ry Co	W. Deed	Sep 16, 1923	DB V922	P184	Oct. 22, 1923
12	J. T. Michael	N.Y.C.R.R. Co.	Agreement	Oct. 14, 1924	V22 Misc.	P547	Jan. 30, 1925

A-15-1-14

FRANKLIN COUNTY
TRURO TOWNSHIP


RIGHT OF WAY AND TRACK MAP
THE TOLEDO AND OHIO CENTRAL RAILWAY
OPERATED BY
THE TOLEDO AND OHIO CENTRAL RAILWAY COMPANY

CORNING DIVISION
EAST COLUMBUS BRANCH - MAIN LINE
FROM STATION 1104+58.0 TO STATION 1211+67.7
SCALE 1 INCH = 200 FEET
JUNE 30, 1918
OFFICE OF VALUATION ENGINEER, COLUMBUS, OHIO

1918 11/4/22 L.D.D.
1919 12/4/22 L.D.D.
1920 No Change
1921 No Change
1922 No Change
1923 No Change
1924 12/29 L.D.D.
1925 No Change
1926 No Change
1927 12/29 L.D.D.
1928 No Change
1929 12/29 P.E.P.

V.4
14

No.	Grantor	Grantee	Instrument	Date	Record	Cost No.	Remarks
3A	The T.O.C. Ry. Co.	The P.C.C. & S.L. Ry. Co.	W. Deed	Nov. 15, 1921		2904	This deed also conveys Parcel No. 4, this map CR #75E.
4	This parcel conveyed in some deed as Parcel No. 3A, this map.						
5	The Granite Improvement Co.	T.O.C. Ry. Co.	W. Deed	Oct. 23, 1922	DB V769 P622 Jan. 7, 1925	2903	Completion Report No. 67E.
3B	The T.O.C. Ry. Co.	The P.C.C. & S.L. Ry. Co.	W. Deed	Oct. 21, 1924		2938	
6	The H.C. Griffith Lumber Co.	T.O.C. Ry. Co.	W. Deed	Sept. 10, 1929	DB V910 P238 Oct. 14, 1929	3024	
7	Chas. F. Johnson, Inc.	T.O.C. Ry. Co.	W. Deed	Oct. 10, 1929	DB V910 P259 Nov. 12, 1929	3023	

 


A-15-1-15

No.	Grantor	Grantee	Instrument	Date	Record	Cost No.	Remarks
1	Henry Krumm	T & O C Ry. Co.	R. Deed	Dec. 28, 1892 DB V246 P215 Jan. 25, 1893		1158	Broad St. Crossing
2	Sam'l Caldwell	S C V R R Co.	W. Deed	Aug. 14, 1879 DB V152 P518 Mar. 3, 1882		2756	
3	Sam'l Caldwell et al	T & O C Ry. Co.	W. Deed	Aug. 22, 1902 DB V357 P29 Aug. 27, 1902		1165	


SHEET NO. 15 OF VS 4 OF THE TOLEDO AND OHIO CENTRAL RAILWAY
CORNING DIVISION, EAST COLUMBUS BRANCH - MAIN LINE
FROM SURVEY STATION 1211+67.7 TO SURVEY STATION 1267+55.0

RIGHT OF WAY AND TRACK MAP
THE TOLEDO AND OHIO CENTRAL RAILWAY
OPERATED BY
THE TOLEDO AND OHIO CENTRAL RAILWAY COMPANY
CORNING DIVISION
EAST COLUMBUS BRANCH - MAIN LINE
FROM STATION 1211+67.7 TO STATION 1267+55.0
SCALE 1 INCH = 200 FEET
JUNE 30, 1918
OFFICE OF VALUATION ENGINEER, COLUMBUS, OHIO
★ OPERATED BY THE NEW YORK CENTRAL RAILROAD COMPANY, SUBSEQUENT TO DECEMBER 31, 1912

1918	1-28-29 L.D.D.
1919	1-28-29 L.D.D.
1920	No Change
1921	No Change
1922	No Change
1923	No Change
1924	No Change
1925	No Change
1926	No Change
1927	No Change
1928	No Change
1929	No Change

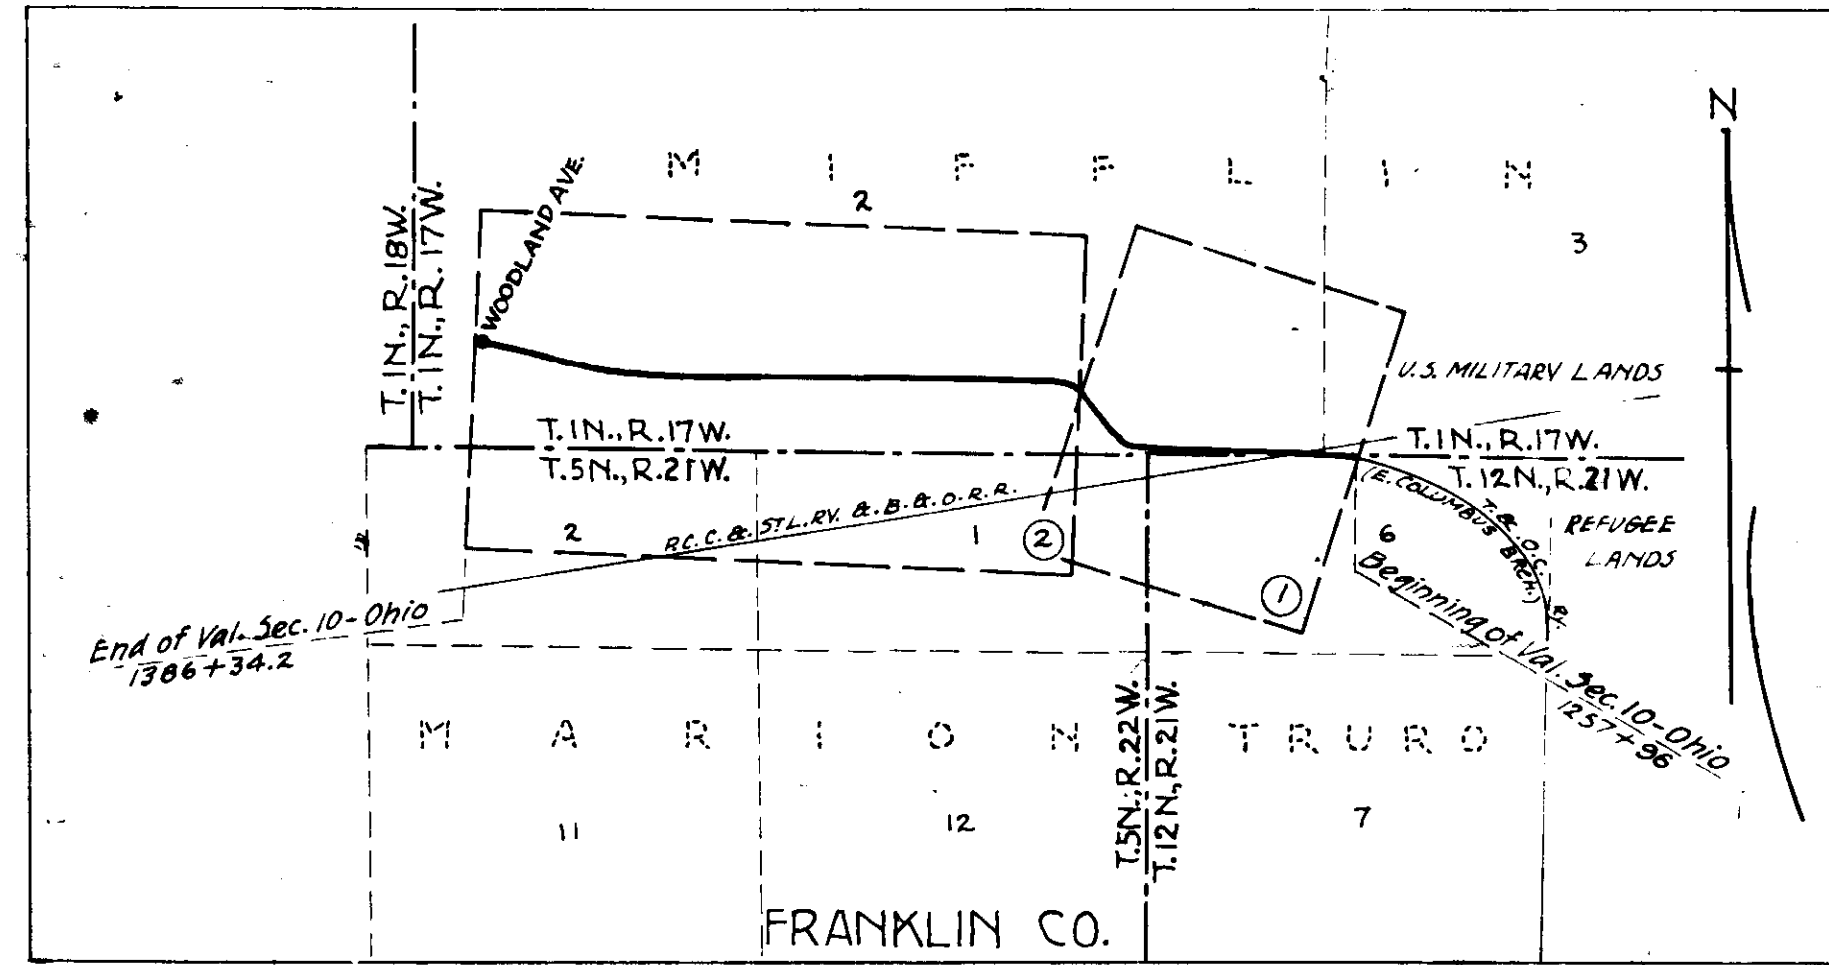

INDEX MAP
OF T. & O. C. VALUATION SECTION 10-CHIO
SCALE 1 INCH = 1 MILE

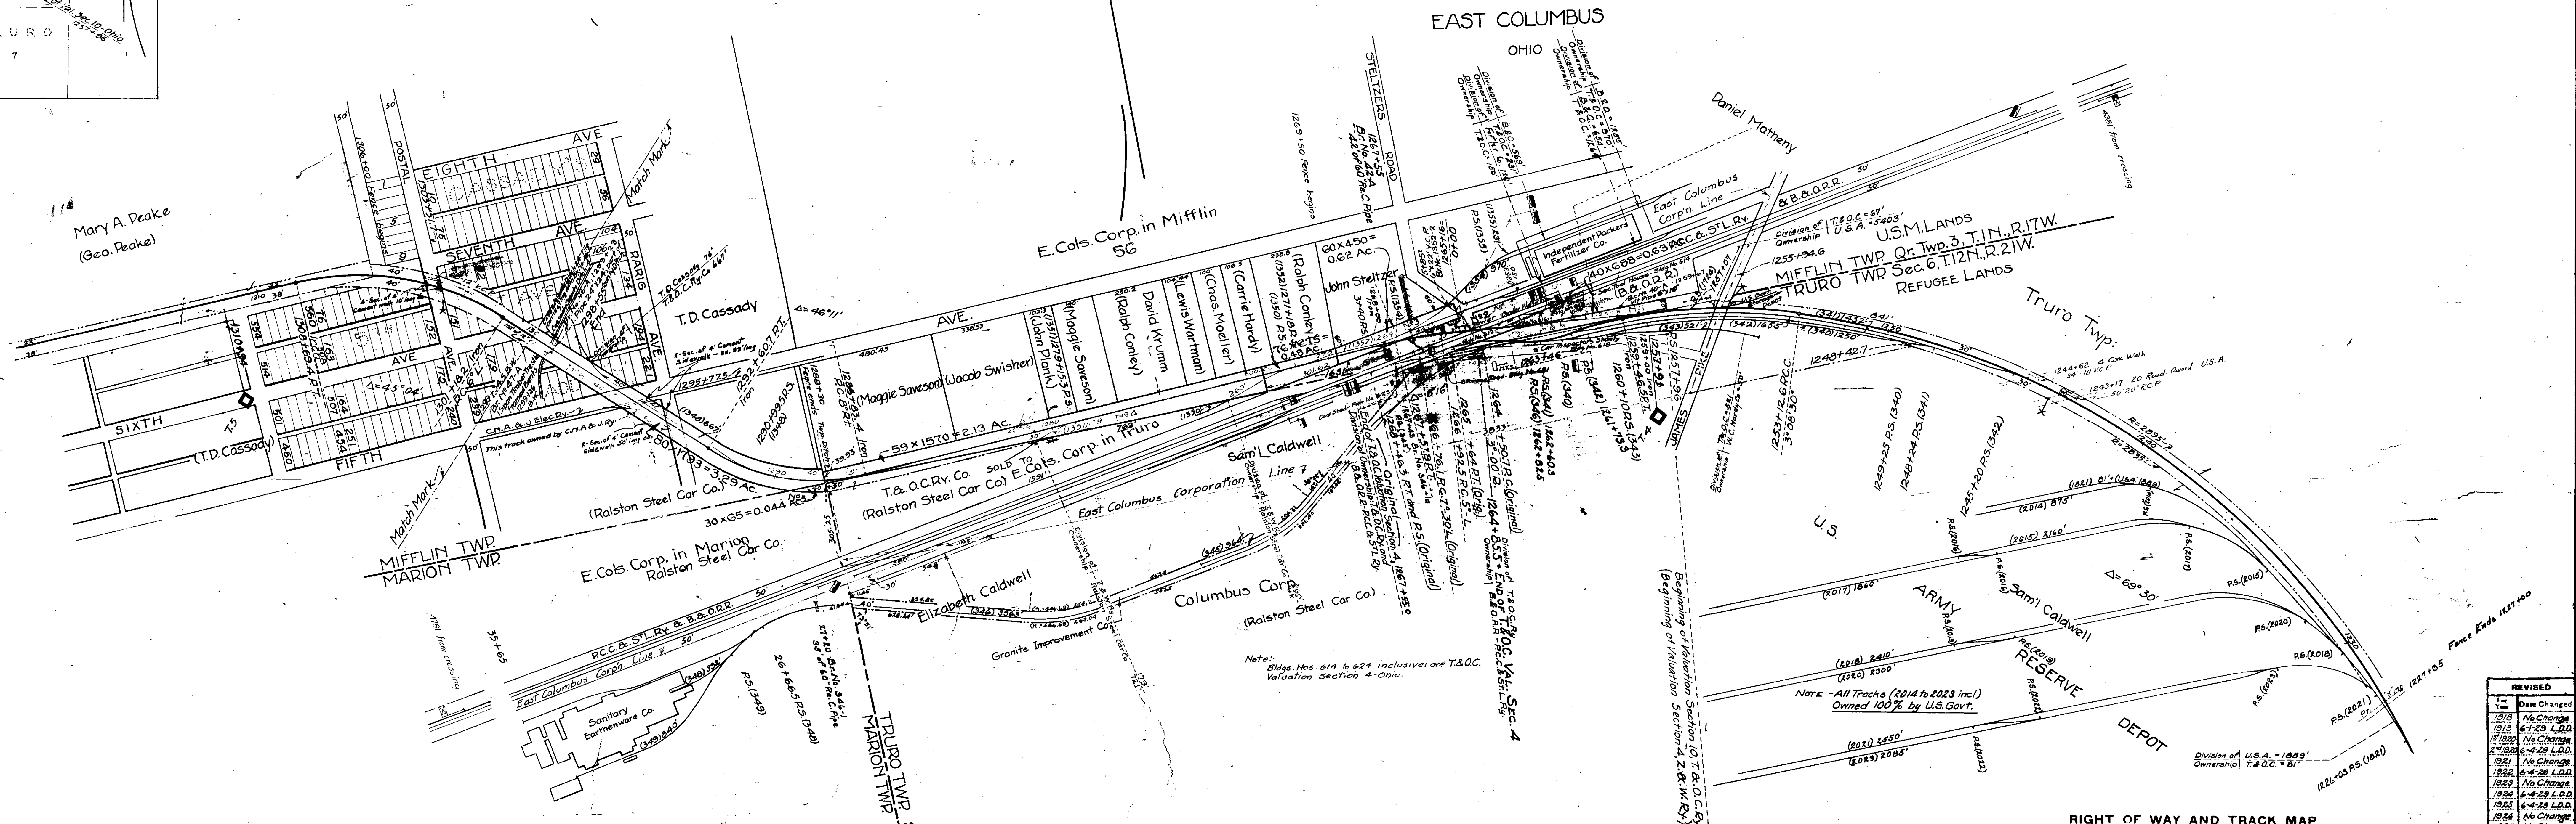

SCHEDULE OF PROPERTY

No	Grantor	Grantee	Instrument	Date	Record	Cust. No.	Remarks
1	Dan'l H. Metheny- Trustees of Marion Twp.	C & E R R Co	W. Deed	July 6 1889	1. V252 P40	July 5, 1893	1
2	B & O R R Co and P J Picard, P O C & St L Ry Co	Marion Twp.	Agreement	Oct 8 1886	Chief Engr's Agreement #456		Right to cross T & O R R and P O C & St L Ry
3	John Stelzer	C & E R R Co	W. Deed	Aug 20 1892	DB V252 P43	July 5, 1893	2
4	David Krumm	C & E R R Co	W. Deed	Nov 15 1886	DB V192 P50	Jan 19, 1889	4
5	The Ralston Steel Car Co	C & E R R Co	Q.C. Deed	Sep 29 1912	DB V335 P56	Nov 27, 1912	7
6	Thos. D. Cassidy	C & E R R Co	W. Deed	Sep 10 1887	DB V191 P22	Jan 27, 1888	8

This parcel continued as parcel #1, Map #12

FRANKLIN COUNTY
TRURO TOWNSHIP
MIFFLIN TOWNSHIP


STATE OF OHIO
COUNTY OF FRANKLIN
I, THE UNDERSIGNED, OFFICER OF THE TOLEDO AND OHIO CENTRAL RAILWAY COMPANY, DO HEREBY CERTIFY THAT THIS IS A CORRECT MAP IN A SERIES OF 2 SHEETS, OF THE ZANESVILLE AND WESTERN RAILWAY FROM SURVEY STATION 1257+00 TO SURVEY STATION 1300+00, EAST COLUMBUS TO WOODLAND AVENUE - MAIN LINE, STATE OF OHIO, PREPARED FROM THE RECORDS OF SAID COMPANY.
NOTARY PUBLIC IN AND FOR THE COUNTY OF FRANKLIN, STATE OF OHIO
SUBSCRIBED AND SWORN TO before me this 31st day of December, 1921
NOTARY PUBLIC IN AND FOR THE COUNTY OF FRANKLIN, STATE OF OHIO
BY COMMISSION EXPIRES Sept 12, 1924

RIGHT OF WAY AND TRACK MAP
THE ZANESVILLE AND WESTERN RAILWAY
T. & O. C. RY. CO. ESTATE FOR YEARS' Z & W. RY. CO. REVERSION
OPERATED BY
THE TOLEDO AND OHIO CENTRAL RAILWAY COMPANY

EAST COLUMBUS TO WOODLAND AVENUE -- MAIN LINE
FROM STATION 1257+96 TO STATION 1300+00
SCALE 1 INCH = 200 FEET
JUNE 30, 1918
OFFICE OF VALUATION ENGINEER, COLUMBUS, OHIO
* OPERATED BY THE NEW YORK CENTRAL RAILROAD COMPANY SUBSEQUENT TO DECEMBER 31, 1921

REVISED	Date Changed
1/18	No Change
1/19	6-1-23 L.D.
1/20	No Change
1/21	6-4-23 L.D.
1/22	No Change
1/23	6-4-23 L.D.
1/24	No Change
1/25	6-4-23 L.D.
1/26	No Change
1/27	No Change

V.4
I.
V.10
I.

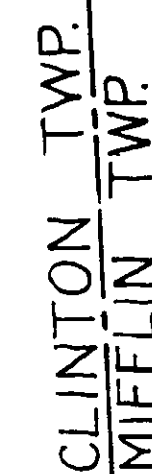


No.	Grantor	Grantee	Instrument	Date	Record	Cust. No.	Remarks
1	Theo. D. Cassidy	C & E R R Co	W. Deed	Sep. 10, 1896	DB 7191 P222 Jan 27, 1898	3	Inte's e part of parcel fr Man ^W
2	Mary Peake	C & E R R Co	W. Deed	Sep. 11, 1896	DB 7191 P221 Jan 27, 1898	10	
3	Theo. D. Cassidy	C & E R R Co	W. Deed	Sep. 12, 1896	DB 7192 P48 Jan 19, 1898	11	
4	W. Mm. Shepard	C & E R R Co	W. Deed	Sep. 13, 1896	DB 7193 P220 Jan 19, 1898	12	
5	Louise P. Jagger	See. Robinson, Recr. of The C S & R Ry Co	W. Deed	May 29, 1901	DB 7345 P600 Jan 17, 1902	14	
6	Geo. Earl	C S & R Ry Co	W. Deed	May 12, 1896	DB 7345 P606 Jan 18, 1902	15	
7	Mary R. Buttles	C & E R R Co	W. Deed	See 4, 1896	DB 7191 P219 Jan 27, 1898	16	
8	The Columbus and John. of The Turnpike Co	F. J. Picard, Recr. of The C & E R R Co	Agreement	Nov 9, 1886	Land and Tax Dept. File	18	Right to cross Turnpike
9	Mary R. Buttles	C & E R R Co	W. Deed	Aug 24, 1895	DB 7191 P217 Jan 27, 1898	19	
10	Theo. Bernard, Sr.	C & E R R Co	W. Deed	Oct 9, 1896	DB 7191 P215 Jan. 27, 1898	21	Nelson Ave. Crossing Leeds Ave. Crossing Brentnell Ave Crossing

FRANKLIN COUNTY
MIFFLIN TOWNSHIP

T. & O. C. Ry.
Estate for Year

1918	No Change
1919	5-31-29 R.B.
1 st 1920	No Change
2 nd 1920	No Change
1921	5-31-29 R.B.
1922	5-31-29 R.B.
1923	No Change
1924	5-31-29 R.B.
1925	No Change
1926	5-31-29 R.B.
1927	5-28-29 R.B.
1928	No Changes
1929	11-13-30 C.C.

 

SCHEDULE OF PROPERTY

No.	Owner	Grantee	Instrument	Date	Acres	Remarks
1	No paper title found. Held by adverse possession and claimed by Ry Co.					
2	W. H. Kraner	W. H. Kraner	Deed	July 21, 1890	2.60	This is a part of parcel #26, Map Y6.
3	Thos. Looker	Thos. Looker	Deed	July 16, 1891	2.70	
4	Martha Brown	Martha Brown	Deed	July 16, 1891	2.70	
5	Seymore Looker	Seymore Looker	Deed	Mar 24, 1892	2.70	
6	Thos. Looker	Thos. Looker	Deed	Apr 12, 1892	2.70	
7	This parcel conveyed in same deed as parcel no. 3, this map					
8	No paper title found. Held by adverse possession and claimed by Ry Co.					


FRANKLIN COUNTY
MADISON TOWNSHIP

FAIRFIELD COUNTY
VIOLET TOWNSHIP

RIGHT OF WAY AND TRACK MAP
THE TOLEDO AND OHIO CENTRAL RAILWAY
OPERATED BY
THE TOLEDO AND OHIO CENTRAL RAILWAY COMPANY

CORNING DIVISION -- MAIN LINE
FROM STATION 700+00 TO STATION 801+35
SCALE 1 INCH = 200 FEET
JUNE 30, 1918
OFFICE OF VALUATION ENGINEER, COLUMBUS, OHIO
OPERATED BY THE NEW YORK CENTRAL RAILROAD COMPANY SUBSEQUENT TO DECEMBER 31, 1921

V.5.
8.

 

SCHEDULE OF PROPERTY

No.	Grantor	Grantee	Instrument	Date	Record	Cost, No.	Remarks
1	No paper title found.	Held by adverse possession and claimed by Ry Co				1179	(FRANKLIN CO.) (FAIRFIELD CO.)
2	James Imbody	T & O C Ry Co	R. Deed	Apr 10, 1895	D9 778 P531 Apr 10, 1895	1178	(FAIRFIELD CO.) (FRANKLIN CO.)
3	No paper title found.	Held by adverse possession and claimed by Ry Co				1177	R/W expropriated in transfer of contiguous land Vol 494 P55
4	No paper title found.	Held by adverse possession and claimed by Ry Co				1176	R/W expropriated in transfer of contiguous land Vol 182 P203
5	No paper title found.	Held by adverse possession and claimed by Ry Co				1175	This parcel continued as parcel #1, Map 10
6	Jos. B. Powell	T & O C Ry Co	Condemnation	Jun 10, 1899	Vol 24 P42 Complete Records, Probate Court, Franklin Co., Ohio.	1174	
7	Jos. B. Powell	T & O C Ry Co	Condemnation	Jun 10, 1899	Vol 24 P42 Complete Records, Probate Court, Franklin Co., Ohio.	1173	

FRANKLIN COUNTY
MADISON TOWNSHIP
TRURO TOWNSHIP


FAIRFIELD COUNTY
VIOLET TOWNSHIP

RIGHT OF WAY AND TRACK MAP
THE TOLEDO AND OHIO CENTRAL RAILWAY
OPERATED BY
THE TOLEDO AND OHIO CENTRAL RAILWAY COMPANY

SHEET NO. 9 OF 25 OF THE TOLEDO AND OHIO CENTRAL RAILWAY
CORNER DIVISION - MAIN LINE
FROM SURVEY STATION 801+35 TO SURVEY STATION 900+00
H. J. Schaeffer
VALUATION ENGINEER

CORNER DIVISION -- MAIN LINE
FROM STATION 801+35 TO STATION 900+00
SCALE 1 INCH = 200 FEET
OFFICE OF VALUATION ENGINEER, COLUMBUS, OHIO.
JUNE 30, 1918
* OPERATED BY THE NEW YORK CENTRAL RAILROAD COMPANY, SUBSEQUENT TO DECEMBER 31, 1921

Year	Change
1918	No Change
1919	No Change
1920	No Change
1921	No Change
1922	No Change
1923	No Change
1924	No Change
1925	No Change
1926	No Change
1927	No Change
1928	No Change
1929	No Change

 

SCHEDULE OF PROPERTY					
No.	Grantor	Grantee	Instrument	Date	Remarks
1	No paper title found.	Held by adverse possession and claimed by Ry Co			1175 This is a part of parcel #8, Map 76
2	No paper title found.	Held by adverse possession and claimed by Ry Co			1171 3/4 accepted in transfer of certificate land Vol 218 P153
3	No paper title found.	Held by adverse possession and claimed by Ry Co			1170 3/4 accepted in transfer of certificate land Vol 479 P118 and Vol 37 P451
4	No paper title found.	Held by adverse possession and claimed by Ry Co			1169 3/4 accepted in transfer of certificate land Vol 411 P30
5	James M. Montgomery	T & O C Ry Co	W. Deed	Dec 12, 1902	DB W361 P436 Jan 14, 1903


FRANKLIN COUNTY
TRURO TOWNSHIP

SHEET NO. 10 OF 10
OF THE TOLEDO AND OHIO CENTRAL RAILWAY
CORNING DIVISION - MAIN LINE
FROM SURVEY STATION 900+00 TO SURVEY STATION 1001+86±

RIGHT OF WAY AND TRACK MAP
THE TOLEDO AND OHIO CENTRAL RAILWAY
OPERATED BY
THE TOLEDO AND OHIO CENTRAL RAILWAY COMPANY
CORNING DIVISION -- MAIN LINE
FROM STATION 900+00 TO STATION 1001+86±
SCALE 1 INCH = 200 FEET
JUNE 30, 1918
OFFICE OF VALUATION ENGINEER, COLUMBUS, OHIO.
★ OPERATED BY THE NEW YORK CENTRAL RAILROAD COMPANY SUBSEQUENT TO DECEMBER 31, 1921.

REVISED	
Date	Change
1918	No Change
1919	No Change
1920	No Change
1921	No Change
1922	No Change
1923	No Change
1924	No Change
1925	No Change
1926	No Change
1927	No Change
1928	No Change
1929	No Change

V.5.
10.

 


SCHEDULE OF PROPERTY

No.	Grantor	Grantee	Instrument	Date	Record	Dist. No.	Remarks
1	Catherine Zettler	NYS & T Co Tr	W. Deed	May 21, 1894	DB V231 P64	May 31, 1894	1143 This is a part of parcel #1, Map V4. See Map No 1
2	Geo. P. Schwartz	NYS & T Co Tr	W. Deed	May 21, 1894	DB V262 P105	June 15, 1894	1143 See Note No 1
3	Wm. T. Thompson	NYS & T Co Tr	W. Deed	June 26, 1894	DB V263 P153	July 21, 1894	1144 See Note No 1
4	Noah Davis	NYS & T Co Tr	W. Deed	May 9, 1894	DB V260 P450	May 19, 1894	1145 See Note No 1
5	M. F. Thompson	T & O C Ry Co	R. Deed	Dec 4, 1895	Land and Tax Dept File		1147 This deed also conveys parcel #2, Map V4 and parcel #2, Map V5

Note:-
No 1 - Conveyed to T & O C Ry Co by New York Security and Trust Co., Trustee, by Q.C. Deed, Aor 29, 1897
Recorded Vol 236 P338 May 21, 1897 and Vol 251 P463 Aug 20, 1900 Dist. No. 816.

FRANKLIN COUNTY
TRURO TOWNSHIP

RIGHT OF WAY AND TRACK MAP
THE TOLEDO AND OHIO CENTRAL RAILWAY
OPERATED BY
THE TOLEDO AND OHIO CENTRAL RAILWAY COMPANY
CORNING DIVISION -- MAIN LINE
FROM STATION 7400+00 TO STATION 7460+80.8
SCALE 1 INCH = 200 FEET
JUNE 30, 1915
OFFICE OF VALUATION ENGINEER, COLUMBUS, OHIO
OPERATED BY THE NEW YORK CENTRAL RAILROAD
COMPANY SUBSEQUENT TO DECEMBER 31, 1921

 

SCHEDULE OF PROPERTY

No.	Grantor	Grantee	Instrument	Date	Record	Dist. No.	Remarks
1	Maria Eberly, et al	T & O Ry Co	Cond. Surt	Sep 4, 1894	Complete Records, Probate Court Vol 21 2191	1129	
2	County Commissioners of Franklin Co., Ohio and Trustees of Marion Twp., Franklin Co., Ohio	T & O Ry Co	Construct	Oct 10, 1894	Land and Tax Deed File	1130	Right to cross Alton Creek Road
3	Joseph Rohr	NYS & T Co Tr	W. Deed	May 14, 1894	DB 7256 P287	May 26, 1894	1131 See Note No 1
4	Wilson B. Burkey et al	NYS & T Co Tr	W. Deed	July 31, 1894	DB 7262 P216	Aug 10, 1894	1132 See Note No 1
5	Malinda Rohr	NYS & T Co Tr	Q.C. Deed	Apr 27, 1894	DB 7263 P214	Aug 10, 1894	1133 See Note No 1
6	Wm. R. Gault	NYS & T Co Tr	W. Deed	May 29, 1894	DB 7266 P185	June 19, 1894	1134 See Note No 1
7	Wm. R. Gault	T & O Ry Co	W. Deed	Aug 24, 1894	DB 7265 P1	Sep 20, 1894	1135
8	Jas. McCloud	T & O Ry Co	W. Deed	Aug 24, 1894	DB 7265 P4	Sep 20, 1894	1136
9	This parcel conveyed in same deed as parcel #6, this map.			May 29, 1894	DB 7262 P204	June 27, 1894	1137 See Note No 2
10	Wm. R. Gault	Chas. G. Hickox	W. Deed	July 21, 1894	DB 7263 P297	Aug 9, 1894	1138 See Note No 1
11	Gilbert Barrett et al	NYS & T Co Tr	W. Deed	May 9, 1894	DB 7259 P477	May 19, 1894	1139 See Note No 1
12	John Heil	NYS & T Co Tr	W. Deed	May 11, 1894	DB 7260 P459	May 25, 1894	1140 See Note No 1
13	John Petzinger	NYS & T Co Tr	W. Deed	May 21, 1894	DB 7261 P04	May 31, 1894	1141 See Note No 1
14	Catherine Zettler	NYS & T Co Tr	W. Deed	May 21, 1894	DB 7261 P464	May 25, 1894	1142 See Note No 1
15	Isabelle Thompson	NYS & T Co Tr	W. Deed	May 11, 1894	DB 7260 P464	May 25, 1894	1143 See Note No 1
16	This parcel conveyed in same deed as parcel #14, this map.						This parcel continued as parcel #1, Map 12

Notes:-


No 1 - Conveyed to T & O Ry Co by New York Security and Trust Co., Trustee, by Q. C. Deed, Apr 29, 1897. Recorded Vol 295 P238 May 21, 1897 and Vol 331 P463 Aug 20, 1900 Dist. No. 816

No 2 - Conveyed to T & O Ry Co by Chas. G. Hickox by Q. C. Deed May 4, 1904. Recorded Vol 454 P223 July 23, 1907.

FRANKLIN COUNTY
MARION TOWNSHIP
TRURO TOWNSHIP

RIGHT OF WAY AND TRACK MAP
THE TOLEDO AND OHIO CENTRAL RAILWAY
OPERATED BY
THE TOLEDO AND OHIO CENTRAL RAILWAY COMPANY
CORNING DIVISION -- MAIN LINE
FROM STATION 7301+42.5 TO STATION 7400+00
SCALE 1 INCH = 200 FEET
JUNE 30, 1918
OFFICE OF VALUATION ENGINEER COLUMBUS, OHIO.
VALUATION ENGINEER
H. J. BAYNE

1918 No Change
1919 No Change
1920 No Change
1921 No Change
1922 No Change
1923 No Change
1924 No Change
1925 No Change
1926 No Change
1927 No Change
1928 No Change
1929 No Change

 


SCHEDULE OF PROPERTY						
No	Grantor	Grantee	Instrument	Date	Record	Remarks
1	Mary J. Obetz	T & O Ry Co	W. Deed	Nov 3, 1894	DB V267 P203 Dec 4, 1894	1104 This is a part of parcel #28, Map 1
2	Elijah Merion, Jr.	NYS & T Co Tr	W. Deed	May 26, 1894	DB V267 P17 June 8, 1894	1063 This is a part of parcel #19, Map 1
3	Sarah Young, et al	T & O Ry Co	W. Deed	Jan 19, 1895	DB V270 P23 Jan 28, 1895	1117 See Note No 1
4	Sarah Young	NYS & T Co Tr	W. Deed	May 17, 1894	DB V261 P11 May 20, 1894	1118 See Note No 1
5	John Gatterdam	NYS & T Co Tr	W. Deed	May 18, 1894	DB V260 P526 May 29, 1894	1120 See Note No 1
6	Samuel Welch	NYS & T Co Tr	W. Deed	May 16, 1894	DB V259 P623 May 26, 1894	1121 See Note No 1
7	Mary Voss	T & O Ry Co	Cond. Suit	Sep 4, 1894	Complete Records, Probate Court Vol 31 P191	1122
8	Louis Brenhisser	T & O Ry Co	Cond. Suit	Sep 4, 1894	Complete Records, Probate Court Vol 31 P191	1123
9	John H. Fetter	T & O Ry Co	W. Deed	Dec 12, 1894	DB V267 P412 Jan 2, 1895	1124
10	N & W Ry Co	T & O Ry Co	Agreement	Nov 30, 1894	Chief Engr's Agreement 1894	Right to cross N & W Ry
11	Wm. Arndt	T & O Ry Co	Cond. Suit	Nov 6, 1894	Complete Records, Probate Court Vol 31 P242	1125
12	Wm. Welch	NYS & T Co Tr	W. Deed	May 14, 1894	DB V259 P616 May 25, 1894	See Note No 1
13	Emma McClelland et al	NYS & T Co Tr	W. Deed	May 31, 1894	DB V262 P155 June 20, 1894	See Note No 1
14	Emma McClelland et al	Chas. G. Hickox	W. Deed	May 31, 1894	DB V262 P200 June 28, 1894	See Note No 2
15	Elipheh Gatterdam et al	T & O Ry Co	Agreement	Feb. 2, 1896	V26 Misc. P516 Mar 12, 1896	C.R. 34N. This agreement releases two private crossings, one of which is in Parcel No. 2, this map.

Note: No 1 - Conveyed to T & O Ry Co by New York Security and Trust Co., Trustees, by O.C. Deed, Apr. 29, 1897. Recorded Vol 295 P388 May 21, 1897 and Vol 331 P465 Aug 20, 1900 Cust. No. 616.
No 2 - Conveyed to T & O Ry Co by Chas. G. Hickox, by O.C. Deed, May 4, 1904. Recorded Vol 284 P223, July 23, 1907 Cust. No. 1091.

RIGHT OF WAY AND TRACK MAP
THE TOLEDO AND OHIO CENTRAL RAILWAY
OPERATED BY
THE TOLEDO AND OHIO CENTRAL RAILWAY COMPANY

CORNING DIVISION - MAIN LINE
FROM STATION 7200+00 TO STATION 7301+42.5
SCALE 1" = 40' JUNE 30, 1918
OFFICE OF VALUATION ENGINEER, COLUMBUS, OHIO

SHORT STATION - Sta. 7212 to Sta. 7220-7229
OPERATED BY THE NEW YORK CENTRAL RAILROAD
COMPANY SUBSEQUENT TO DECEMBER 31, 1913

 

SCHEDULE OF PROPERTY

No.	Owner	Source	Instrument	Date	Record	Cost No.	Remarks


FRANKLIN COUNTY
MARION TOWNSHIP

RIGHT OF WAY AND TRACK MAP
THE TOLEDO AND OHIO CENTRAL RAILWAY
OPERATED BY
THE TOLEDO AND OHIO CENTRAL RAILWAY COMPANY

CORNING DIVISION - EAST OF PARSONS AVE., S. COLUMBUS
"GLASS FACTORY LEAD" AND VARIOUS TRACKS CONNECTING THEREWITH
SCALE 1 INCH = 100 FEET
OFFICE OF THE ENGINEER, COLUMBUS, OHIO
JUNE 30, 1918
OPERATED BY THE NEW YORK CENTRAL RAILROAD COMPANY SUBSEQUENT TO DECEMBER 31, 1921

H. J. Schaeffer
VALUING ENGINEER



 

No.	Grantor	Grantee	Instrument	Date	Record	Chas. No.	Remarks
1	The H V Ry Co	T & O C Ry Co	Q.C.Deed	Oct 31, 1899	DB V224 P228	Jan 20, 1900	986 This is part of parcel #88, Map 14
1	The Central Trust Co of New York	T & O C Ry Co	Q.C.Deed	Dec 7, 1899	DB V224 P292	Jan 20, 1900	987
2	Mary L. Frisbie	T & O C Ry Co	W. Deed	Nov 2, 1894	DB V226 P251	Dec 7, 1894	1026
3	Gustavus S. Innis	NYS & T Co Tr	J. Deed	June 8, 1894	DB V223 P12	June 28, 1894	1026 See Note No 1
4	Gustavus S. Innis	NYS & T Co Tr	J. Deed	June 8, 1894	DB V223 P14	June 29, 1894	1027 See Note No 1
5	Henry M. Innis	T & O C Ry Co	W. Deed	Aug 15, 1894	DB V223 P278	Aug 24, 1894	1028
6	Archibald C. Davis	T & O C Ry Co	W. Deed	Aug 15, 1894	DB V223 P282	Aug 24, 1894	1029
7	Carl H. Michelson	T & O C Ry Co	W. Deed	Aug 15, 1894	DB V223 P282	Aug 24, 1894	1030
8	David Thomas	T & O C Ry Co	W. Deed	July 9, 1912	DB V224 P241	Aug 5, 1912	1030
9	Edwin Price, et al	T & O C Ry Co	W. Deed	July 18, 1912	DB V224 P244	Aug 5, 1912	1032
10	The National Starth Life Co.	Chas. G. Hickox	W. Deed	June 28, 1912	DB V224 P245	Aug 5, 1912	1032
11	The National Starth Life Co.	NYS & T Co Tr	W. Deed	Aug 4, 1894	DB V223 P229	Aug 28, 1894	1036
12	Starth Life Co.	NYS & T Co Tr	W. Deed	Aug 4, 1894	DB V223 P229	Aug 28, 1894	1036
13	The Columbus Rail-T & O C Ry Co	Ordinance	Oct 26, 1894	Ordinance #9199			843 Right to cross High St.
14	The Columbus Rail-T & O C Ry Co	Ordinance	Nov 12, 1912	DB V259 P42	Feb 4, 1914		1037
15	The Columbus Rail-T & O C Ry Co	Deed	Dec 11, 1913	DB V259 P47	Feb 4, 1914		1038
16	Rachel Lyons	T & O C Ry Co	W. Deed	Aug 17, 1894	DB V221 P236	Aug 29, 1894	1040
17	Andrew Compton	NYS & T Co Tr	W. Deed	Aug 7, 1894	DB V223 P490	Aug 29, 1894	1041
18	Alvan H. Lyons, et al	H. N. Speaks, Tr	Q.C.Deed	Aug 22, 1912	DB V256 P219	Sep 12, 1912	1045
19	Dr. John Galtner, H. N. Speaks, Tr	Executor's Deed	Sep 5, 1912	DB V256 P198	Sep 12, 1912		1044
20	The Columbus Chain Co.	T & O C Ry Co	Lease	Oct 10, 1900	LB V12 P235	June 12, 1901	1046

Note:
Alignment notes are on the Center line between tracks from Station 7113+55 to Station 7190+50.8

SOUTH COLUMBUS OHIO

REVISED	Date	Change
1918	1-31-18	No Change
1919	1-31-19	No Change

RIGHT OF WAY AND TRACK MAP
THE TOLEDO AND OHIO CENTRAL RAILWAY
OPERATED BY
THE TOLEDO AND OHIO CENTRAL RAILWAY COMPANY
CORNING DIVISION - MAIN LINE
FROM STATION 7059+73.2 TO STATION 7149+34.7
SCALE 1 INCH = 100 FEET
JUNE 30, 1918
OPERATED BY THE NEW YORK CENTRAL RAILROAD COMPANY SUBSEQUENT TO DECEMBER 1, 1918

SCHEDULE OF PROPERTY (continued)

No.	Grantor	Grantee	Instrument	Date	Record	Qust.No.	Remarks
1	L. H. Jones	T & O C Ry Co	Anditor's	Jun 2, 1902	DB 7247 P232 Jan 3, 1902	945	
2	Frederick Bernhardt	T & O C Ry Co	Cond. Suit	Apr 9, 1895	Complete Records, Probate	946	

No.	Grantor	Grantee	Instrument	Date	Record	Qust.No.	Remarks
15	Louis Sindel	NYS & T Co Tr	W. Deed	June 21, 1894DB V263 P123	July 16, 1894	960	See Note No 1
16	Elizabeth Kirschner	NYS & T Co Tr	W. Deed	May 31, 1894 DB V262 P101	June 15, 1894	962	See Note No 1
17	Elizabeth Kirschner	NYS & T Co Tr	W. Deed	May 31, 1894 DB V262 P101	June 15, 1894	962	See Note No 1
18	Elizabeth Kirschner	NYS & T Co Tr	W. Deed	May 31, 1894 DB V262 P101	June 15, 1894	962	See Note No 1
19	Chas. Greiner	NYS & T Co Tr	W. Deed	June 15, 1894DB V262 P324	July 17, 1894	964	See Note No 1
20	City of Columbus	T & O C Ry Co	Ordinance	Oct 26, 1894 Ordinance #9199		965	Right to cross Frederick St.
21	John Poppenhager	NYS & T Co Tr	W. Deed	June 28, 1894DB V263 P379	July 25, 1894	966	See Note No 1
22	Mary E. Burgett	NYS & T Co Tr	W. Deed	June 30, 1894DB V262 P407	July 27, 1894	970	See Note No 1
23	Philip Haag	NYS & T Co Tr	W. Deed	June 12, 1894DB V261 P222	July 14, 1894	972	See Note No 1
24	Jas. Mills	NYS & T Co Tr	W. Deed	June 11, 1894DB V263 P40	July 2, 1894	974	See Note No 1
25	John Stock	NYS & T Co Tr	W. Deed	June 15, 1894DB V261 P222	July 24, 1894	976	See Note No 1
26	Carl Braker	NYS & T Co Tr	W. Deed	Aug 9, 1894 DB V263 P558	Aug 22, 1894	978	See Note No 1
27	Harry Lang	NYS & T Co Tr	W. Deed	June 18, 1894DB V263 P116	July 16, 1894	979	See Note No 1
28	Jacob Strubinger	NYS & T Co Tr	W. Deed	June 15, 1894DB V263 P87	July 12, 1894	980	See Note No 1
29	Anna Collan	NYS & T Co Tr	W. Deed	May 22, 1894 DB V260 P651	June 6, 1894	981	See Note No 1
30	Anna Collan	NYS & T Co Tr	W. Deed	May 22, 1894 DB V260 P651	June 6, 1894	981	See Note No 1
31	John Bray, et al	T & O C Ry Co	Cond. Suit	Apr 2, 1895 Complete Records, Probate		983	
32	Alois Thurn	NYS & T Co Tr	W. Deed	June 6, 1894 DB V263 P235	July 28, 1894	984	See Note No 1
33	Barnhard Buehler	NYS & T Co Tr	W. Deed	June 26, 1894DB V263 P167	July 21, 1894	986	See Note No 1

SCHEDULE OF PROPERTY (continued)

No.	Grantor	Grantee	Instrument	Date	Record	Qust.No.	Remarks
34	This parcel conveyed in same deed as parcel #14, this map.						See Note No 3
35	Alois Thurn	NYS & T Co Tr	W. Deed	July 6, 1894 DB V263 P235	July 28, 1894	988	See Note No 1
36	J. W. Krouer, et al	T & O C Ry Co	W. Deed	Aug 29, 1894 DB V265 P2	Sept 20, 1894	990	See Note No 1
37	Frederick Bernhardt	NYS & T Co Tr	W. Deed	June 27, 1894DB V261 P300	July 24, 1894	992	See Note No 1
38	Frederick Bernhardt	NYS & T Co Tr	W. Deed	June 27, 1894DB V261 P300	July 24, 1894	992	See Note No 1
39	This parcel conveyed in same deed as parcel #9, this map.						See Note No 3
40	Frank Munkel	NYS & T Co Tr	W. Deed	June 15, 1894DB V263 P85	July 11, 1894	994	See Note No 1
41	City of Columbus	T & O C Ry Co	Ordinance	Oct 26, 1894 Ordinance #9199		996	Right to cross Humboldt St.
42	Edward M. Stanley	NYS & T Co Tr	W. Deed	July 27, 1894 DB V263 P855	Aug 15, 1894	996	See Note No 1
43	This parcel conveyed in same deed as parcel #14, this map.						See Note No 3
44	City of Columbus	T & O C Ry Co	Ordinance	Oct 26, 1894 Ordinance #9199		998	Right to cross Redund Alley
45	Frank Munkel	NYS & T Co Tr	W. Deed	June 15, 1894DB V263 P85	July 11, 1894	998	See Note No 1
46	Brace W. Beall	NYS & T Co Tr	W. Deed	May 28, 1894DB V261 P78	June 1, 1894	999	See Note No 1
47	T. J. Ry Co	T & O C Ry Co	Q.C. Deed	Oct 31, 1899DB V234 P288	Jan 20, 1900	996	See Note No 2
48	City of Columbus	T & O C Ry Co	Q.C. Deed	Dec 7, 1899 DB V234 P282	Jan 20, 1900	997	See Note No 2
49	Louis Linderman	NYS & T Co Tr	W. Deed	July 10, 1894 DB V263 P231	July 28, 1894	1001	Greenlaw Ave. Crossing
50	Geo. W. Sinks	NYS & T Co Tr	W. Deed	May 25, 1894 DB V262 P22	June 8, 1894	1002	See Note No 1
51	Geo. W. Sinks	NYS & T Co Tr	W. Deed	May 25, 1894 DB V262 P22	June 8, 1894	1002	See Note No 2
52	Anna Wirth	Chas. G. Hickox	W. Deed	May 31, 1894DB V262 P224	June 28, 1894	1004	See Note No 2

SCHEDULE OF PROPERTY (continued)

No.	Grantor	Grantee	Instrument	Date	Record	Qust.No.	Remarks
53	Anna Wirth	NYS & T Co Tr	W. Deed	May 31, 1894 DB V262 P141	June 19, 1894	1005	See Note No 1
54	This parcel conveyed in same deed as parcel #50, this map.						See Note No 2
55	This parcel conveyed in same deed as parcel #51, this map.						See Note No 2
56	This parcel conveyed in same deed as parcel #52, this map.						See Note No 2
57	This parcel conveyed in same deed as parcel #53, this map.						See Note No 2
58	Jos. P. Trogs	Chas. G. Hickox	W. Deed	Sep 4, 1894 DB V265 P131	Sep 28, 1894	1006	See Note No 2
59	Jos. P. Trogs	NYS & T Co Tr	W. Deed	Sep 4, 1894 DB V265 P77	Sep 24, 1894	1007	See Note No 1
60	This parcel conveyed in same deed as parcel #52, this map.						See Note No 2
61	This parcel conveyed in same deed as parcel #53, this map.						See Note No 2
62	This parcel conveyed in same deed as parcel #54, this map.						See Note No 2
63	Philip A. Schlapp	Chas. G. Hickox	W. Deed	May 22, 1894 DB V262 P19	June 8, 1894	1009	See Note No 2
64	Philip A. Schlapp	NYS & T Co Tr	W. Deed	May 22, 1894 DB V260 P423	June 6, 1894	1009	See Note No 2
65	This parcel number not used.						
66	John L. Hook	T & O C Ry Co	W. Deed	Dec 13, 1894 DB V269 P58	Jan 7, 1895	1010	
67	John L. Hook	T & O C Ry Co	W. Deed	July 5, 1894 DB V261 P339	Aug 1, 1894	1011	See Note No 1
68	Frederick Wacker	T & O C Ry Co	W. Deed	Sep 11, 1894 DB V265 P207	Oct 3, 1894	1012	
69	This parcel conveyed in same deed as parcel #47, this map.						
70	City of Columbus	T & O C Ry Co	Ordinance	Oct 26, 1894 Ordinance #9199			Right to cross alley
71	Allen H. Jones	NYS & T Co Tr	W. Deed	May 31, 1894 DB V262 P127	June 19, 1894	1013	See Note No 1
72	City of Columbus	T & O C Ry Co	Ordinance	Oct 26, 1894 Ordinance #9199			Right to cross Moler St.
73	Ed. McPherson	T & O C Ry Co	W. Deed	Sep 18, 1894 DB V264 P479	Oct 17, 1894	1014	
74	City of Columbus	T & O C Ry Co	Ordinance	Oct 26, 1894 Ordinance #9199			Right to cross alley
75	John L. Hook	T & O C Ry Co	W. Deed	June 28, 1894 DB V261 P339	July 24, 1894	1015	See Note No 2
76	John L. Hook	T & O C Ry Co	W. Deed	June 28, 1894 DB V263 P147	July 19, 1894	1016	See Note No 1
77	John L. Hook	T & O C Ry Co	W. Deed	Oct 26, 1894 Ordinance #9199			Right to cross alley
78	John L. Hook	T & O C Ry Co	W. Deed	Oct 26, 1894 Ordinance #9199			
79	City of Columbus	T & O C Ry Co	Ordinance	Oct 26, 1894 Ordinance #9199			



Notes: -

No 1 - Conveyed to T & O C Ry Co by New York Security and Trust Co. Trustees, by G. C. Deed, Apr 29, 1897. Recorded Vol 235 P335 May 31, 1897 and Vol 231 P453 Aug 20, 1900.

No 2 - Conveyed to T & O C Ry Co by Chas. G. Hickox, by G. C. Deed, May 4, 1904. Recorded Vol 231 P307 May 12, 1904.

No 3 - Parcels Nos 9, 12, 14, 16, 18, 34, 37, 39 & 45 conveyed to The Cleveland Trust Co. by H. E. Sparks, Trustee, by G. C. Deed dated Oct 3, 1927. Recorded Vol 278 P260 Nov 2, 1927. Cust. No. 2966.

49-A The Cleveland Trust Co. Rose Alenz G.C. Deed Marc
49-B Rose Alenz The Cleveland Trust Co. G.C. Deed Marc


Scale 1"=100' May 10, 1934

FRANKLIN COUNTY

RIGHT OF WAY AND TRACK MAP
THE TOLEDO AND OHIO CENTRAL RAILWAY
OPERATED BY
THE TOLEDO AND OHIO CENTRAL RAILWAY COMPANY

CORNING DIVISION -- MAIN LINE.
FROM STATION 1050+45.2 TO STATION 1099+73.2
SCALE 1 INCH = 100 FEET
JUNE 30, 1934
OFFICE OF VALUATION ENGINEERS, COLUMBUS, OHIO.

OPERATED BY THE NEW YORK CENTRAL RAILROAD COMPANY SUBSEQUENT TO DECEMBER 31, 1932.

 

No.	Owner	Deed	Instrument	Date	Record	Remarks
1	H. V. Ry. Co.	T. & O. C. Ry. Co.	Cond. Shit	1899	Vol. 10, Page 101	This is a part of parcel #72, Map 74
2	U. S. Reclamation	Trustees of Estate of Jonas M. McKinn	Q. C. Deed	1909	Vol. 10, Page 101	This is a part of parcel #71, Map 74
3	John G. Dasher	Chas. G. Hickox	J. Deed	1894	DB V261 P208	Scioto River Crossing
4	John G. Dasher	Chas. G. Hickox	J. Deed	1894	DB V261 P219	See Note No. 2
5	The Fish Stone Co.	Chas. G. Hickox	J. Deed	1894	DB V266 P206	See Note No. 1
6	Philip H. Bruck	Chas. G. Hickox	J. Deed	1894	DB V264 P278	See Note No. 4


Notes:-
No. 1 - Conveyed to T. & O. C. Ry. Co. by The New York Security and Trust Co., Trustee, by G. C. Deed, Apr. 29, 1897.
Recorded Vol. 10, Page 101.
No. 2 - Conveyed to T. & O. C. Ry. Co. by Chas. G. Hickox, by G. C. Deed, May 4, 1904.
Recorded Vol. 10, Page 101.
No. 3 - Parcel No. 66 conveyed to The Cleveland Trust Co. by H. C. Sparks, Trustee, by G. C. Deed dated Oct. 3, 1927.
Recorded Vol. 10, Page 101.


No.	Grantor	Grantee	Instrument	Page	Record	Dist.	Remarks
1	Carl W. Neat	T. & O. Ry. Co.	Deed	28	1000	De 1914	See Map No. 1
2	Carl W. Neat	T. & O. Ry. Co.	Deed	28	1000	De 1914	See Map No. 1
Notes:
 No. 1 - Parcel No. 5055, 56, 57 & 58 conveyed to The Cleveland Trust Co. by H.E. Speaks, Trustee, by Q.C. Deed dated Oct. 3, 1927.
 No. 2 - Conveyed to T. & O. Ry. Co. by Chas. G. Hickox, by Q.C. Deed, May 4, 1904.
 No. 3 - That portion of Parcel No. 59 lying easterly of the center line of Starling St. and northerly of the center line of Walnut St. conveyed to T.O.C. Ry. Co. by H.E. Speaks, Trustee, by Q.C. Deed, Oct. 3, 1927. Recorded Vol. 673 P.667 Nov. 3, 1927. Cust. No. 2876.

3A The T.O.C. Ry. Co.	The City of Columbus	W. Deed	Mar. 19, 1920	2931	C. 56B. This deed also conveys Parcels Nos. 3B, 3A, 3B, and 13C, this map.
3B This parcel conveyed in same deed as Parcel No. 3A, this map.					
3C This parcel conveyed in same deed as Parcel No. 3A, this map.					
FRANKLIN COUNTY
 The T.O.C. Ry. reserves the right to use this 30' strip adjoining property line.
 Ordinance No. 35534, Vacation of portions of River, Mill and Gift Streets.
 Ordinance No. 35534, Vacation of portions of River, Mill and Gift Streets.
 Ordinance No. 35534, Vacation of portions of River, Mill and Gift Streets.

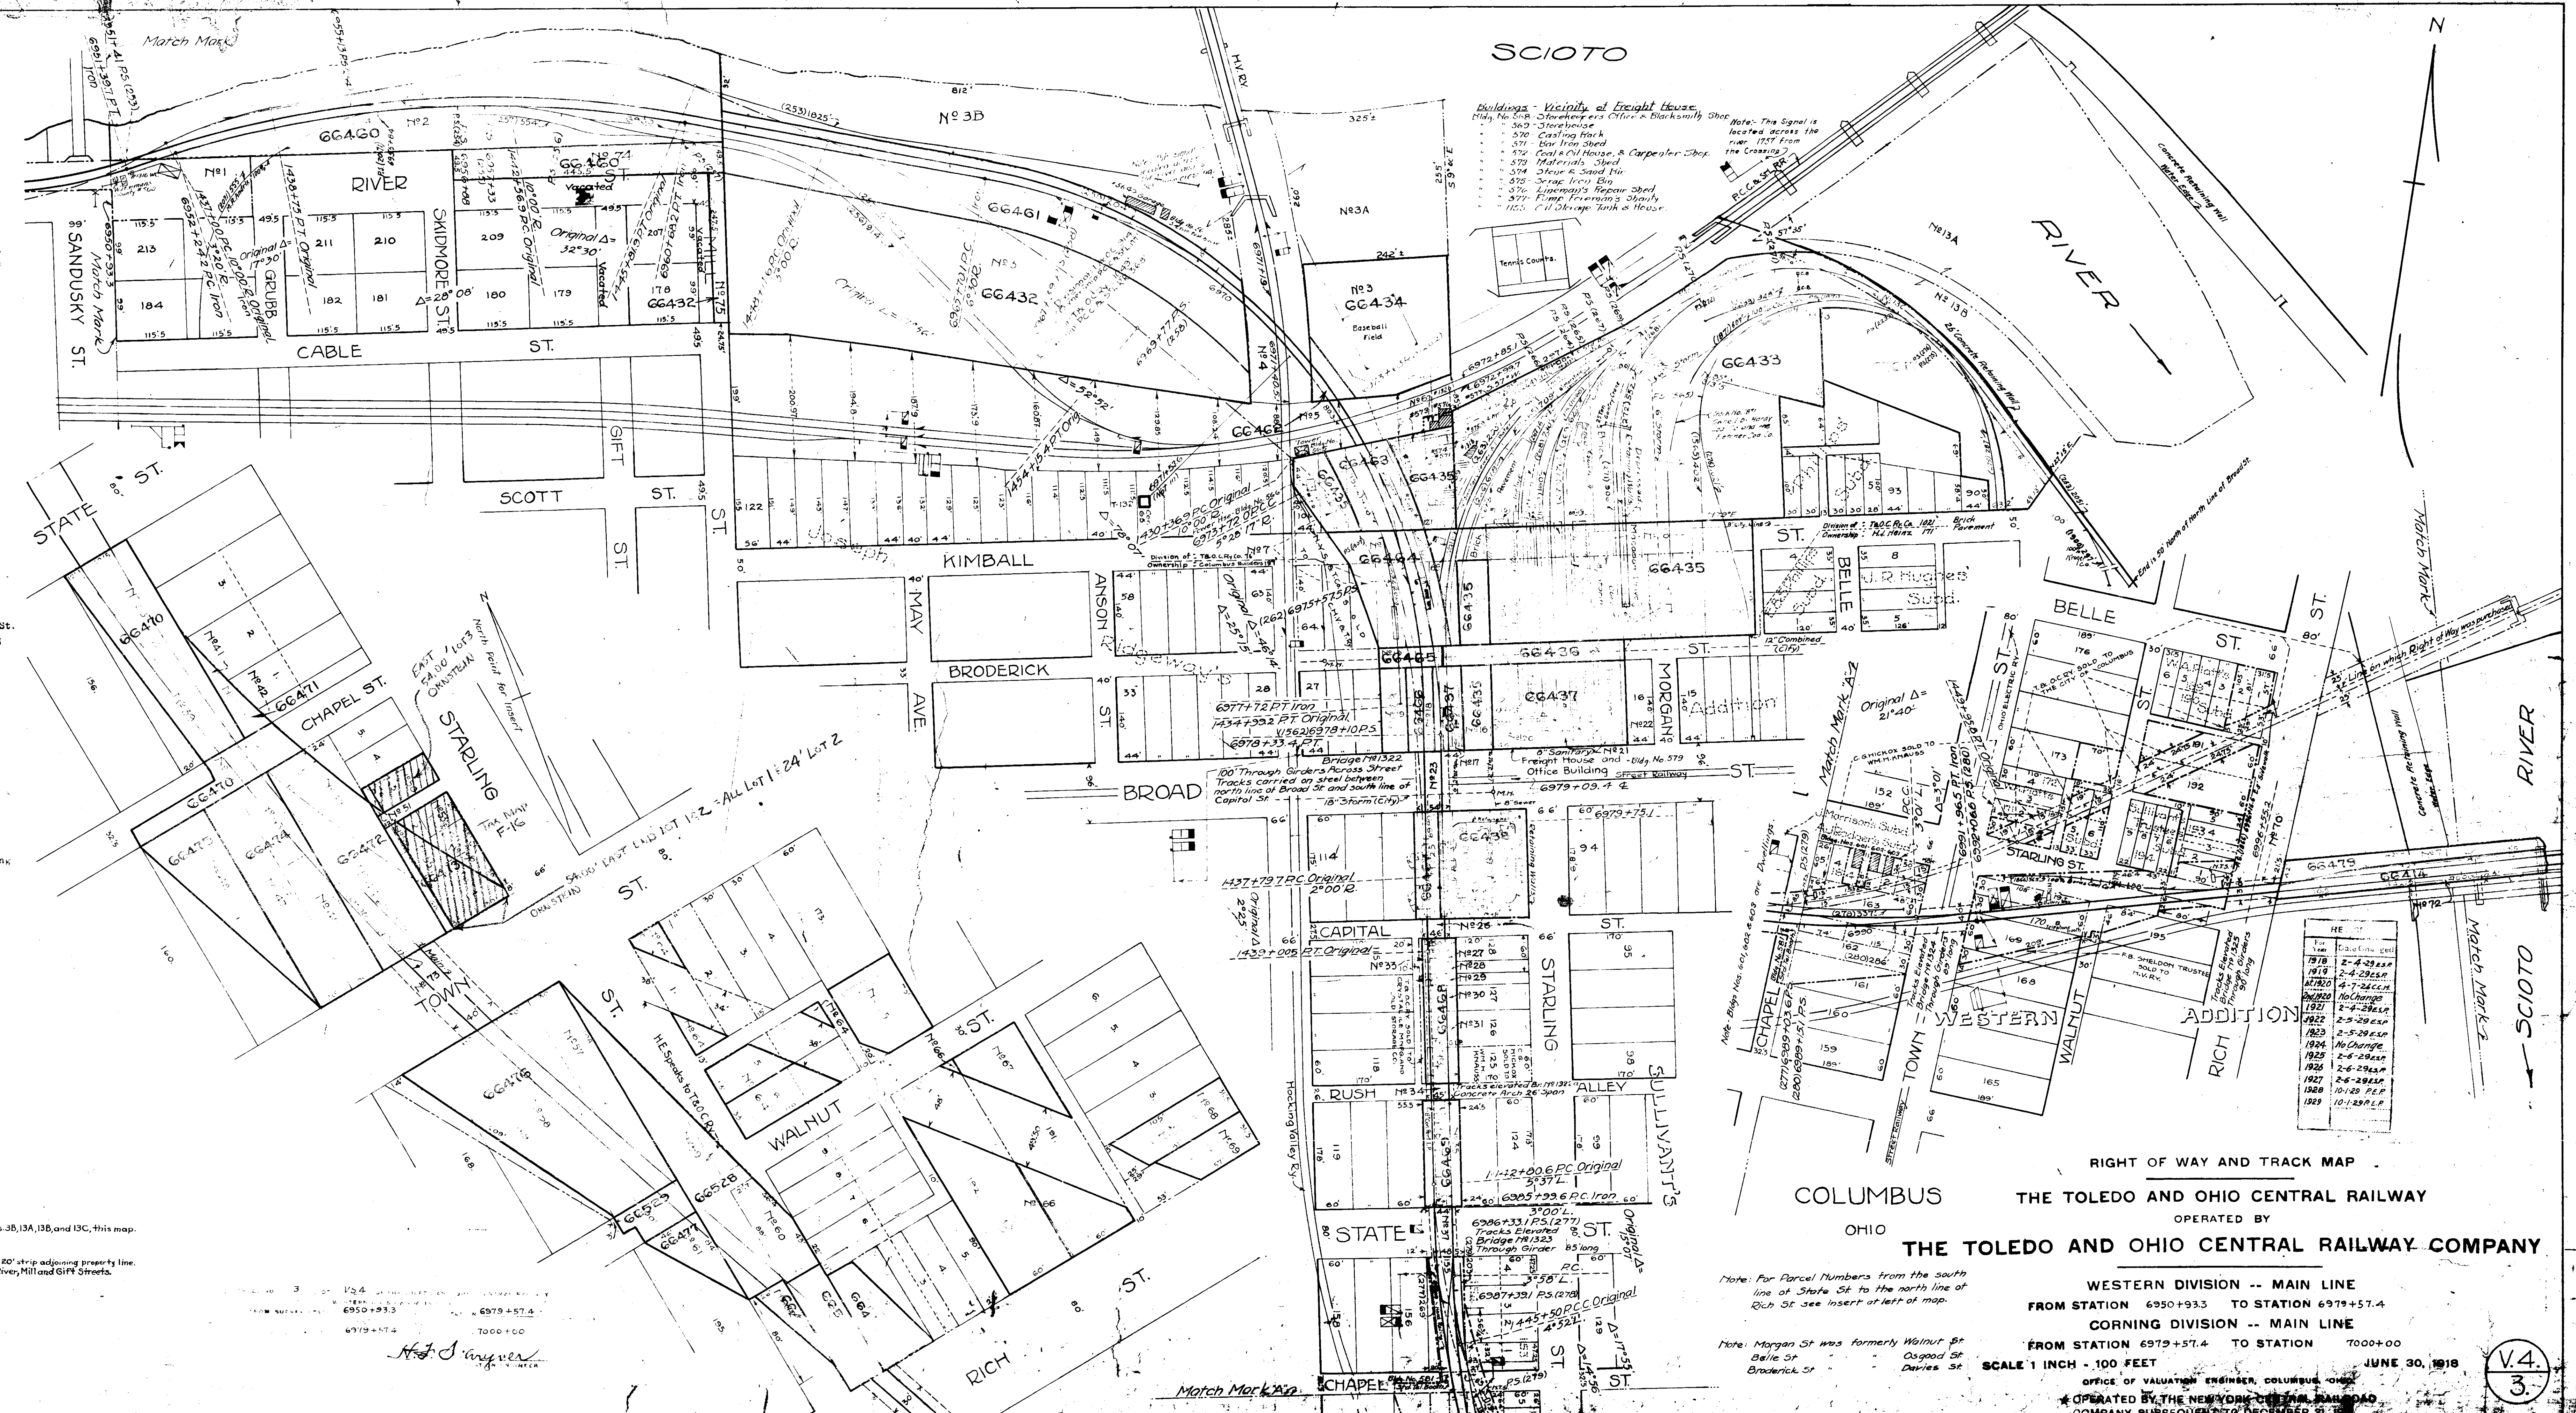


TRACK MAP
 CENTRAL
 BY
 TRAL RA
 -- MAIN LINE
 O STATION
 KER, COLUMBUS, OH
 RK CENTRAL RAIL
 DECEMBER 31, 19


WESTERN DIVISION -- MAIN LINE
FROM STATION 6201+08.2 TO STATION 6950+93.3
SCALE 1 INCH = 200 FEET JUNE 30, 1918
OFFICE OF VALUATION ENGINEER, COLUMBUS, OHIO.
★ OPERATED BY THE NEW YORK CENTRAL RAILROAD
COMPANY SUBSEQUENT TO DECEMBER 31, 1921

SHEET NO. 2 OF VS 4 CITY OF KANSAS AND OHIO CENTRAL RAILWAY
WESTERN DIVISION MAIN LINE
FROM SURVEY STATION 6901+08.2 TO SURVEY STATION 6950+93.3
N. J. Sawyer
VALUATION ENGINEER

A-15-1-2

Buildings - West Columbus Yards		Buildings - East Columbus Yards	
Blgd. No.		Blgd. No.	Water Tank
"		536	Shedhouse
"	515 Ice House	"	
"	516 Plant & Oil House	"	
"	517 Dope House	"	
"	518 Conveyer Shop	542	Shavings House
"	519 Hose House	"	
"	520 Office, Storeroom & Boiler Room	"	
"	521 Hose House	546	Heaters' Shop
"	522 Water Closet	"	
"	523 Coal Bin	"	
"	524 Electrician's Shop	"	
"	525 Lamp House	"	
"		"	
"	527 Section Tool House	550	Switchman's Shop
"	528 Ward Office	"	
"	529 Trainers' Shop	"	
"	530 Water Closet	"	

 

 

SCHEDULE OF PROPERTY					Cust. No.	Remarks
No.	Grantor	Grantee	Instrument	Date		
1	Mary J. Harrison, et al	T & O C Ry Co	Condemnation	Apr 5, 1893	Probate Court Case #8130 Complete Records-Vol. 29, 293	781 This is a part of parcel #9 Map 12
2	Emma S. Brown	Stevenson Burke	W. Deed	Apr 12, 1893	DB V248 P180 Apr 29, 1893	782 See Note No. 1
3	Theophilus P. Steele	Stevenson Burke	W. Deed	May 23, 1893	DB V248 P184 Apr 29, 1893	783 See Note No. 1
4	Augustus F. Loring	Stevenson Burke	W. Deed	May 12, 1893	DB V248 P187 Apr 29, 1893	784 See Note No. 1
5	Eliza C. Rogers	Stevenson Burke	W. Deed	Apr 5, 1893	DB V248 P175 Apr 29, 1893	785 See Note No. 1
6	Robert G. Sullivan	Stevenson Burke	W. Deed	Apr 1, 1893	DB V248 P183 Apr 29, 1893	786 See Note No. 1
7	Allen Sullivan	Stevenson Burke	W. Deed	Apr 1, 1893	DB V248 P184 Apr 29, 1893	787 See Note No. 1
8	Jacob S. Sullivan	Stevenson Burke	W. Deed	May 30, 1893	DB V248 P182 Apr 29, 1893	788 See Note No. 1
9	State of Ohio	T & O C Ry Co	Joint Resolution	Apr 25, 1893	Senate Joint Resolution	790

Note:--
No. 1 - Conveyed to T & O C Ry Co by Stevenson Burke, by Q.C. Deed, Aug 23, 1900
Recorded Vol. 388 P166, May 18, 1904. Cont. No. 789


FRANKLIN COUNTY
FRANKLIN TOWNSHIP

RIGHT OF WAY AND TRACK MAP
THE TOLEDO AND OHIO CENTRAL RAILWAY
OPERATED BY
THE TOLEDO AND OHIO CENTRAL RAILWAY COMPANY

WESTERN DIVISION -- MAIN LINE
FROM STATION 6800+00 TO STATION 6843+15
SCALE 1 INCH = 200 FEET
OFFICE OF VALUATION ENGINEER, COLUMBUS, OHIO
JUNE 30, 1918
SHORT STATION - Sta. 6839 to Sta. 6840 + 99.5'

SHEET NO. 67 OF V.S. 2 OF THE TOLEDO AND OHIO CENTRAL RAILWAY
WESTERN DIVISION - MAIN LINE
FROM SURVEY STATION 6800+00 TO SURVEY STATION 6843+15
VALUATION ENGINEER

1918	No Change
1919	No Change
1st 1920	No Change
2nd 1920	No Change
1921	No Change
1922	No Change
1923	No Change
1924	No Change
1925	No Change
1926	No Change
1927	No Change
1928	No Change
1929	No Change

 

No.	Grantor	Grantee	Instrument	Date	Record	Cost	Remarks
10	Edmund Harrison	H.E. Speaks, Trustee	W. Deed	Sept. 5, 1923	DB V 713 P285	Sept. 26, 1923 2851	See Note 2, Completion Report No. 46J
11	Fannie A. Harrison	H.E. Speaks, Trustee	W. Deed	Sept. 5, 1923	DB V 713 P284	Sept. 26, 1923 2852	See Note 2, Completion Report No. 46J
12	Shaford Phillips	H.E. Speaks, Trustee	W. Deed	Sept. 5, 1923	DB V 713 P283	Sept. 26, 1923 2853	See Note 2, Completion Report No. 46J
13	Lucy G. Trubee	H.E. Speaks, Trustee	W. Deed	Oct. 10, 1923	DB V 713 P492	Sept. 24, 1924 2855	See Note 2, Completion Report No. 46J
14	Stephen M. Renner	H.E. Speaks, Trustee	W. Deed	Oct. 11, 1923	DB V 713 P525	Jan. 24, 1924 2854	See Note 2, Completion Report No. 46J
15	This parcel conveyed in same deed as Parcel No. 15, this map	H.E. Speaks, Trustee	W. Deed	Dec. 28, 1923	DB V 747 P523	Jan. 24, 1924 2890	This deed also conveys Parcel No. 16, this map. See Note 1, C.R. #46J
16	J.H. & G.C. Galbraith	H.E. Speaks, Trustee	W. Deed	Jan. 3, 1924	DB V 767 P441	Jan. 5, 1924 2898	See Note 2, Completion Report No. 46J
17	Katherine Durban, et al	T. & O. C. Ry. Co.	6th Deed	Jan. 3, 1924	DB V 767 P423	Jan. 5, 1924 2899	See Note 2, Completion Report No. 46J
18	Edw. Jones, Guardian of Paul Durban Jones	T. & O. C. Ry. Co.	6th Deed	Jan. 3, 1924	DB V 767 P421	Jan. 5, 1924 2900	See Note 2, Completion Report No. 46J
19	John Durban, Guardian of Clara Durban	H.E. Speaks, Trustee	W. Deed	Jan. 30, 1924	DB V 770 P285	July 28, 1924 2837	See Note 2, Comp. Report No. 46J


Note: No. 1- Parcel No. 11 conveyed to T. & O. C. Ry. Co. by H.E. Speaks, Trustee, by Quit Claim Deed, Sept. 21, 1925. Recorded Vol. 608, Pg. 179, Oct. 16, 1925. Cust. No. 2897.
Note 2- These parcels conveyed to the Cleveland Trust Company by H.E. Speaks, Trustee, by Quit Claim Deed, July 21, 1927. Recorded Vol. 573, Pg. 271, Nov. 3, 1927. Cust. No. 2897.

No.	Grantor	Grantee	Instrument	Date	Record	Cost	Remarks
1	Jas. S. Britton	T. & O. C. Ry. Co.	W. Deed	July 11, 1893	DB V250 P455	Aug. 7, 1893 770	
2	Andrew Mc Ninch	T. & O. C. Ry. Co.	W. Deed	Apr. 26, 1893	DB V249 P207	Apr. 29, 1893 771	
3	Clos Shrum, et al	T. & O. C. Ry. Co.	W. Deed	May 12, 1893	DB V252 P157	July 11, 1893 772	
4	Jas. W. Barbee	T. & O. C. Ry. Co.	W. Deed	July 25, 1893	Probate Court Case #8095	773	Complete Records-Vol. 29, P. 400
5	Edw. Galbraith	T. & O. C. Ry. Co.	W. Deed	Apr. 26, 1893	DB V249 P210	Apr. 29, 1893 774	
6	Chas. C. Trubee	T. & O. C. Ry. Co.	W. Deed	Apr. 26, 1893	DB V249 P208	Apr. 29, 1893 775	
7	Barbara Renner	T. & O. C. Ry. Co.	W. Deed	July 1, 1893	DB V250 P480	Aug. 5, 1893 777	
8	Francis C. Phillips	T. & O. C. Ry. Co.	W. Deed	May 20, 1893	DB V252 P156	July 11, 1893 779	
9	Chas. C. Trubee	T. & O. C. Ry. Co.	Q. C. Deed	June 20, 1893	DB V252 P150	July 11, 1893 780	
10	Mary J. Harrison, et al	T. & O. C. Ry. Co.	Condemnation	Aug. 6, 1893	Probate Court Case #8120	781	This parcel continued as Parcel 11, Map 17, 2385


FRANKLIN COUNTY
NORWICH TOWNSHIP
FRANKLIN TOWNSHIP

RIGHT OF WAY AND TRACK MAP
THE TOLEDO AND OHIO CENTRAL RAILWAY
OPERATED BY
THE TOLEDO AND OHIO CENTRAL RAILWAY COMPANY
WESTERN DIVISION -- MAIN LINE
FROM STATION 6700+20 TO STATION 6800+00
SCALE 1 INCH = 200 FEET
JUNE 30, 1918
OFFICE OF VALUATION ENGINEER

No.	Change
1918	No Change
1919	No Change
1920	No Change
1921	No Change
1922	No Change
1923	No Change
1924	No Change
1925	No Change
1926	No Change
1927	No Change
1928	No Change
1929	No Change

 

SCHEDULE OF PROPERTY									
No.	Grantor	Grantee	Instrument	Date	Record	Cost	Remarks	Remarks	Remarks
1	Mary E. Lane	T & O Ry Co	W. Deed	Apr 15, 1895	DB 7277 143	Apr 18, 1895 765	Part of a part of Section 30		
2	Albert Scrimger, et al	T & O Ry Co	Condemnation	July 15, 1895	Probate Court Case 7977 787		Right to cross Fuller Mill Road		
3	Sam'l A. Williams	T & O Ry Co	W. Deed	May 15, 1895	DB 7281 171	June 8, 1895 785			
 

SCHEDULE OF PROPERTY

No.	Owner	Grantee	Instrument	Date	Record	Cost No.	Remarks
1	Davis Brown	T & O Ry Co	Condemnation	June 29, 1893	Probate Court Case #7977	749	This is a part of parcel #9
2	John E. Howard	T & O Ry Co	W. Deed	June 22, 1893	DB 7258	7123	July 11, 1893 750
3	John Hart	T & O Ry Co	W. Deed	Apr 12, 1893	DB 7267	7448	Apr 18, 1893 751
4	Margaret Hart et al	T & O Ry Co	W. Deed	May 12, 1893	DB 7268	7224	Aug 3, 1893 752
5	Joseph Connor	T & O Ry Co	W. Deed	Apr 23, 1893	DB 7261	7448	Apr 18, 1893 753
6	Sarah Smiley, et al	T & O Ry Co	W. Deed	Apr 12, 1893	DB 7250	7388	July 25, 1893 754
7	Margaret A. Merris	T & O Ry Co	Condemnation	July 19, 1893	Probate Court Case #7977	755	
8	Mary E. Lane	T & O Ry Co	W. Deed	Apr 13, 1893	DB 7267	7448	Apr 18, 1893 756

This parcel continued as parcel #1.


FRANKLIN COUNTY
NORWICH TOWNSHIP

RIGHT OF WAY AND TRACK MAP
THE TOLEDO AND OHIO CENTRAL RAILWAY
OPERATED BY
THE TOLEDO AND OHIO CENTRAL RAILWAY COMPANY
WESTERN DIVISION -- MAIN LINE
FROM STATION 6500+00 TO STATION 6600+00
SCALE 1 INCH = 200 FEET
JUNE 30, 1918
OFFICE OF VALUATION ENGINEER, COLUMBUS, OHIO.
* OPERATED BY THE NEW YORK CENTRAL RAILROAD COMPANY SUBSEQUENT TO DECEMBER 31, 1921.

REVISIONS

No.	Date	Description

Match Mark

 


SCHEDULE OF PROPERTY				
No.	Grantor	Grantee	Instrument	Date
1	Alexander Davidson	T & O C Ry Co	W. Deed	Apr 7, 1893
2	Wm. J. Shriver and John J. Stoddart	T & O C Ry Co	Condemnation	June 24, 1893
3	Sylvester S. Vanschoyck	T & O C Ry Co	W. Deed	Apr 12, 1893
4	James C. Spicer	T & O C Ry Co	W. Deed	Apr 12, 1893
5	Geo. W. Vanschoyck	T & O C Ry Co	W. Deed	May 31, 1893
6	Barbara Renner et al	T & O C Ry Co	W. Deed	June 7, 1893
7	Edwin W. Warren	T & O C Ry Co	W. Deed	May 12, 1893
8	Asbury Schofield	T & O C Ry Co	Condemnation	June 29, 1893
9	Davis Brown	T & O C Ry Co	Condemnation	June 29, 1893

FRANKLIN COUNTY
WASHINGTON TOWNSHIP
NORWICH TOWNSHIP

RIGHT OF WAY AND TRACK MAP
THE TOLEDO AND OHIO CENTRAL RAILWAY
OPERATED BY
THE TOLEDO AND OHIO CENTRAL RAILWAY COMPANY
WESTERN DIVISION -- MAIN LINE
FROM STATION 6402+60.6 TO STATION 6500+00
SCALE 1 INCH = 200 FEET
OFFICE OF VALUATION ENGINEER, COLUMBUS, OHIO.
OPERATED BY THE NEW YORK CENTRAL RAILROAD
COMPANY SUBSEQUENT TO DECEMBER 31, 1921.

REVISIONS	
1918	No Change
1919	No Change
1920	No Change
1921	No Change
1922	No Change
1923	No Change
1924	No Change
1925	No Change
1926	No Change
1927	No Change
1928	No Change
1929	No Change

 


SCHEDULE OF PROPERTY					
No.	Grantor	Grantee	Instrument	Date	Remarks
1	Joshua P. Frieszell	T & O C Ry Co	W. Deed	Apr 6, 1893 DB 7245	This is a part of parcel #12 Map 72
2	Joshua P. Frieszell	T & O C Ry Co	Deed	Apr 23, 1897 Land and Tax Dept File	To revert to grantor when no longer used for stock pens
3	Joshua P. Frieszell	T & O C Ry Co	Deed	Sept 4, 1894 Land and Tax Dept File	To revert to grantor when no longer used for railway business
4	No paper title found.	Held by adverse possession and claimed by Ry Co			
5	Geo. Cosgray	T & O C Ry Co	W. Deed	Feb 2, 1899 DB 7211	2458 Feb 10, 1899
6	Geo. Cosgray	T & O C Ry Co	W. Deed	Apr 7, 1893 DB 7245	2508 Apr 11, 1893
7	Owen T. Cramer	T & O C Ry Co	W. Deed	Apr 7, 1893 DB 7245	2508 Apr 11, 1893
8	This parcel conveyed in same deed as parcel #6, this map				
9	Henry Shriver	T & O C Ry Co	W. Deed	Apr 12, 1893 DB 7247	2441 Apr 18, 1893
10	John P. Zimmer	T & O C Ry Co	Condemnation	July 17, 1893 Case #7977-Probate Court	Complete Record Vol. 29, 2369
11	Jas. G. Pendleton	T & O C Ry Co	Condemnation	June 24, 1893 Case #7979-Probate Court	Complete Record Vol. 29, 2369
12	Riley Houchard, et al.	T & O C Ry Co	W. Deed	Apr 12, 1893 DB 7220	2287 July 26, 1893
13	Wm. J. Shriver and John J. Stoddart	T & O C Ry Co	Condemnation	June 24, 1893 Case #7979-Probate Court	Complete Record Vol. 29, 2369

FRANKLIN COUNTY
WASHINGTON TOWNSHIP

RIGHT OF WAY AND TRACK MAP
THE TOLEDO AND OHIO CENTRAL RAILWAY
OPERATED BY
THE TOLEDO AND OHIO CENTRAL RAILWAY COMPANY
WESTERN DIVISION -- MAIN LINE
FROM STATION 6300+00 TO STATION 6402+60.6
SCALE 1 INCH = 200 FEET
JUNE 30, 1918
OFFICE OF VALUATION ENGINEER, COLUMBUS, OHIO.
* OPERATED BY THE NEW YORK CENTRAL RAILROAD COMPANY SUB-LENT TO DECEMBER 31, 1921

REVISED	For	Date Change
1918	No Change	
1919	1/1/19 L.D.D.	
1920	No Change	
1921	No Change	
1922	1/1/23 L.D.D.	
1923	No Change	
1924	No Change	
1925	No Change	
1926	No Change	
1927	No Change	
1928	No Change	
1929	No Change	
1930	No Change	

 

SCHEDULE OF PROPERTY									
No.	Owner	Grantee	Instrument	Date	Record	Cont. No.	Remarks		
1	Andrew Carey	W. Deed	Apr 6, 1893	DB	V245 P695	Apr 11, 1893	719		
2	Mary C. Patch	W. Deed	Apr 7, 1893	DB	V245 P690	Apr 11, 1893	720		
3	Dan'l M. Slyh	W. Deed	Apr 13, 1893	DB	V247 P450	Apr 18, 1893	721		
4	Lewis Davis, G'd'm.	W. Deed	June 6, 1893	DB	V252 P122	July 11, 1893	722		
5	of Ella McCann	W. Deed	Apr 6, 1893	DB	V245 P698	Apr 11, 1893	723		
6	Rodney Carey	W. Deed	Apr 7, 1893	DB	V245 P694	Apr 11, 1893	724		
7	Barnet J. Cosgray	W. Deed	Apr 12, 1893	DB	V247 P444	Apr 18, 1893	725		
8	Geo. Cosgray	W. Deed	Apr 7, 1893	DB	V245 P697	Apr 11, 1893	726		
9	Martha J. Geary	W. Deed	Apr 6, 1893	DB	V245 P691	Apr 11, 1893	727		
10	Frederick A. Cramer	W. Deed	Apr 6, 1893	DB	V245 P696	Apr 11, 1893	728		
11	John C. Frieszell	W. Deed	Apr 6, 1893	DB	V245 P699	Apr 11, 1893	729		
12	John C. Frieszell	W. Deed	Apr 6, 1893	DB	V245 P690	Apr 11, 1893	730	This parcel continued as parcel #1. Map 72	

MADISON COUNTY
DARBY TOWNSHIP


FRANKLIN COUNTY
WASHINGTON TOWNSHIP

RIGHT OF WAY AND TRACK MAP
THE TOLEDO AND OHIO CENTRAL RAILWAY
OPERATED BY
THE TOLEDO AND OHIO CENTRAL RAILWAY COMPANY

WESTERN DIVISION -- MAIN LINE
FROM STATION 6203+04 TO STATION 6300+00
SCALE 1 INCH = 200 FEET
JUNE 30, 1918

OFFICE OF VALUATION ENGINEER, COLUMBUS, OHIO.
* OPERATED BY THE NEW YORK CENTRAL RAILROAD
COMPANY SUBSEQUENT TO DECEMBER 31, 1921.

REVISED	
1/18	No Change
1/19	No Change
1/20	No Change
1/21	No Change
1/22	No Change
1/23	No Change
1/24	No Change
1/25	No Change
1/26	No Change
1/27	No Change
1/28	No Change
1/29	No Change
1/30	No Change

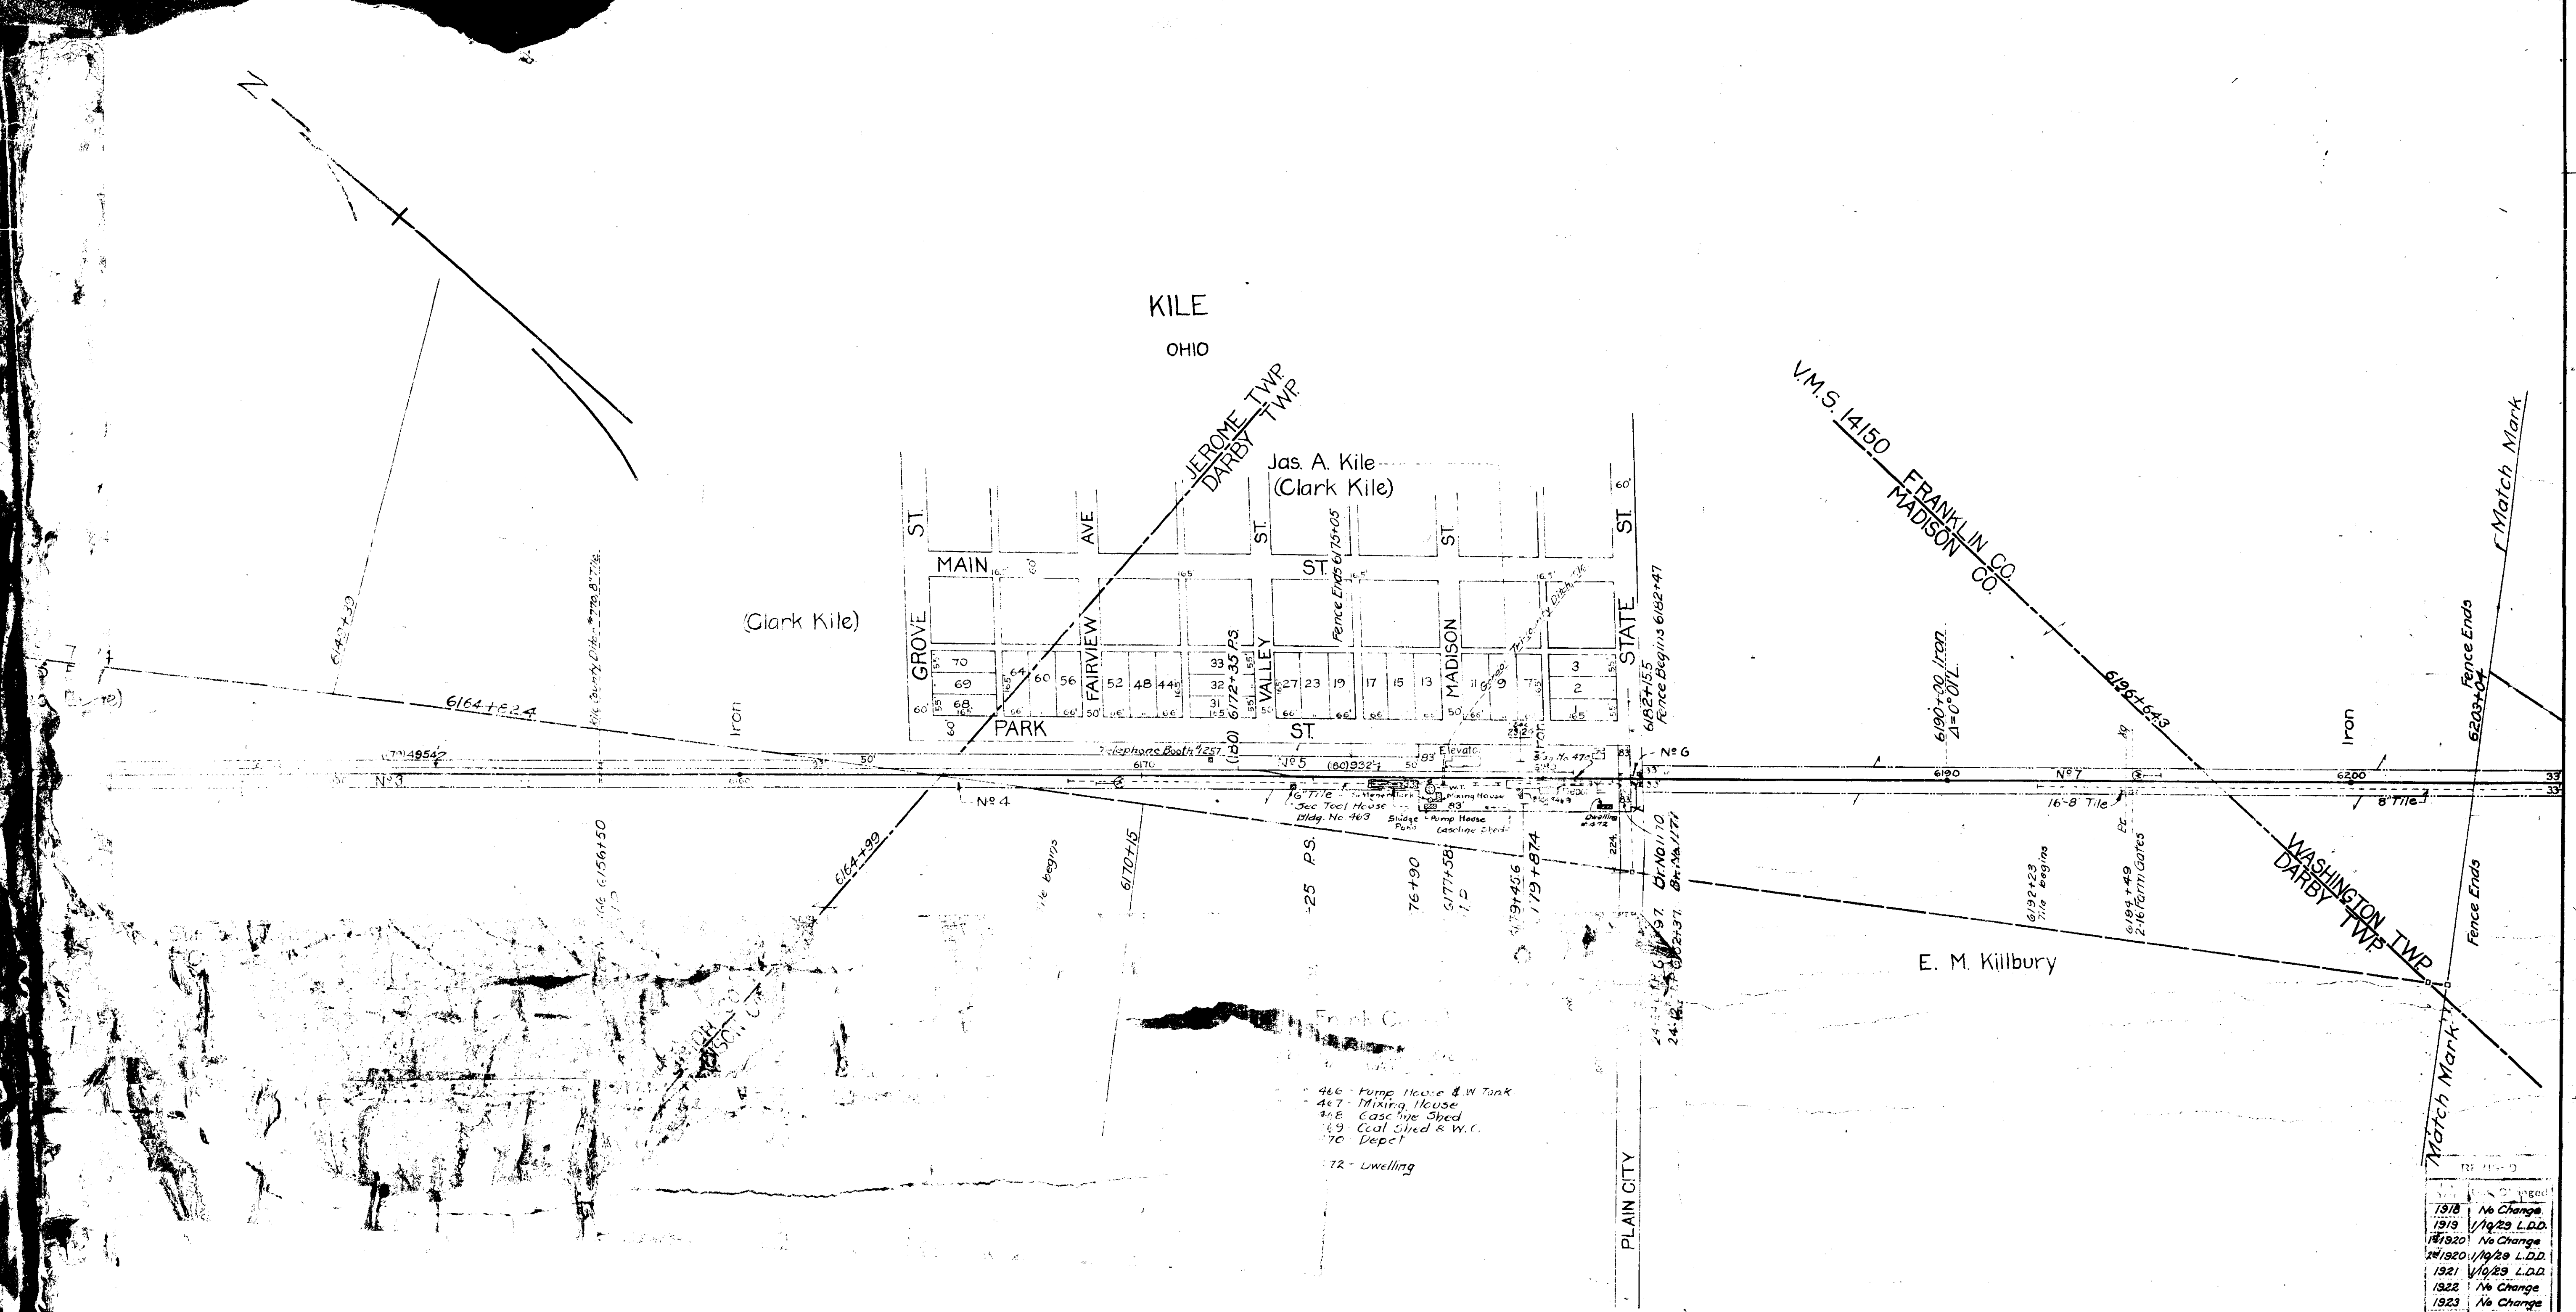

DARBY TOWNSHIP

FRANKLIN COUNTY
WASHINGTON TOWNSHIP

SHEET NO. 60 OF V.S. 2 OF THE TOLEDO AND OHIO CENTRAL RAILWAY
WESTERN DIVISION - MAIN LINE
FROM SURVEY STATION 6096+84 TO SURVEY STATION 6203+04

H. J. Schaeffer
VALUATION ENGINEER

RIGHT OF WAY AND TRACK MAP
THE TOLEDO AND OHIO CENTRAL RAILWAY
OPERATED BY
THE TOLEDO AND OHIO CENTRAL RAILWAY COMPANY

WESTERN DIVISION -- MAIN LINE
FROM STATION 6096+84 TO STATION 6203+04
SCALE 1 INCH = 100 FEET
JUNE 30, 1918

OFFICE OF VALUATION ENGINEER, COLUMBUS, OHIO
NEW YORK CENTRAL RAILWAY
JULY 1, 1918

V2

60

1918	No Change
1922	No Change
1923	No Change
1924	No Change
1925	1/1625 L.D.
1926	No Change
1927	1/1625 L.D.
1928	9-17-25 R.F.P.
1929	No Change