

ROLL 10 IMAGE 8

ROLL 10 IMAGE 7

FRANKLIN COUNTY, OHIO

CLINTON TOWNSHIP
FORMER MIFLIN TOWNSHIP

Former City of Columbus Corporation Line

Former City of Columbus Corporation Line

Former City of Columbus Corporation Line



CONNECTING RAILWAY
 FORMERLY
 RIGHT OF WAY AND TRACK MAP
 TOLEDO, COLUMBUS & OHIO RIVER R. R.

OPERATED BY THE
 PENNSYLVANIA COMPANY
 TOLEDO DIVISION - SANDUSKY BRANCH

STATION 17+71 TO STATION 67+55
 SCALE: 1" = 100 FT.
 OFFICE OF VALUATION ENGINEER
 PHILADELPHIA, PA.
 JUNE 26, 1919

Correct as of Dec. 31st, 1919. No Revision
 For revisions prior to 1919, see Map 23 in copy file.

00002071

VA
OHIO
SL/212

FORMERLY
18
18
SL/212



ROLL 10 IMAGE 6

4-2-80
S.S.S. 70570
PC

PC 70570
S.S.S. 70570
1-2-91




CONNECTING RAILWAY
FORMERLY
RIGHT OF WAY AND TRACK MAP
TOLEDO, COLUMBUS & OHIO RIVER R. R.
OPERATED BY THE
PENNSYLVANIA COMPANY
TOLEDO DIVISION - SANBUSHY BRANCH
STATION 47+35 TO STATION 40+45

180623
27178 AC

CLINTON TOWNSHIP

 

CONNECTING RAILWAY
 FORMERLY
 HEIGHT OF WAY AND TRACK MAP
 TOLEDO, COLUMBUS & OHIO RIVER R. R.
 OPERATED BY THE
PENNSYLVANIA COMPANY
 TOLEDO DIVISION - SANDUSKY BRANCH
 STATION 20+45 TO STATION 17+54
 SCALE: 1" = 100' June 20, 1950
 OFFICE OF VALUATION ENGINEER
 FRANKLIN COUNTY, OHIO
 CORRECTED 31st DEC. 31st 1950 MAP REVISION
 For revisions prior to 1950 see Map 2





ROLL 10 IMAGE 2

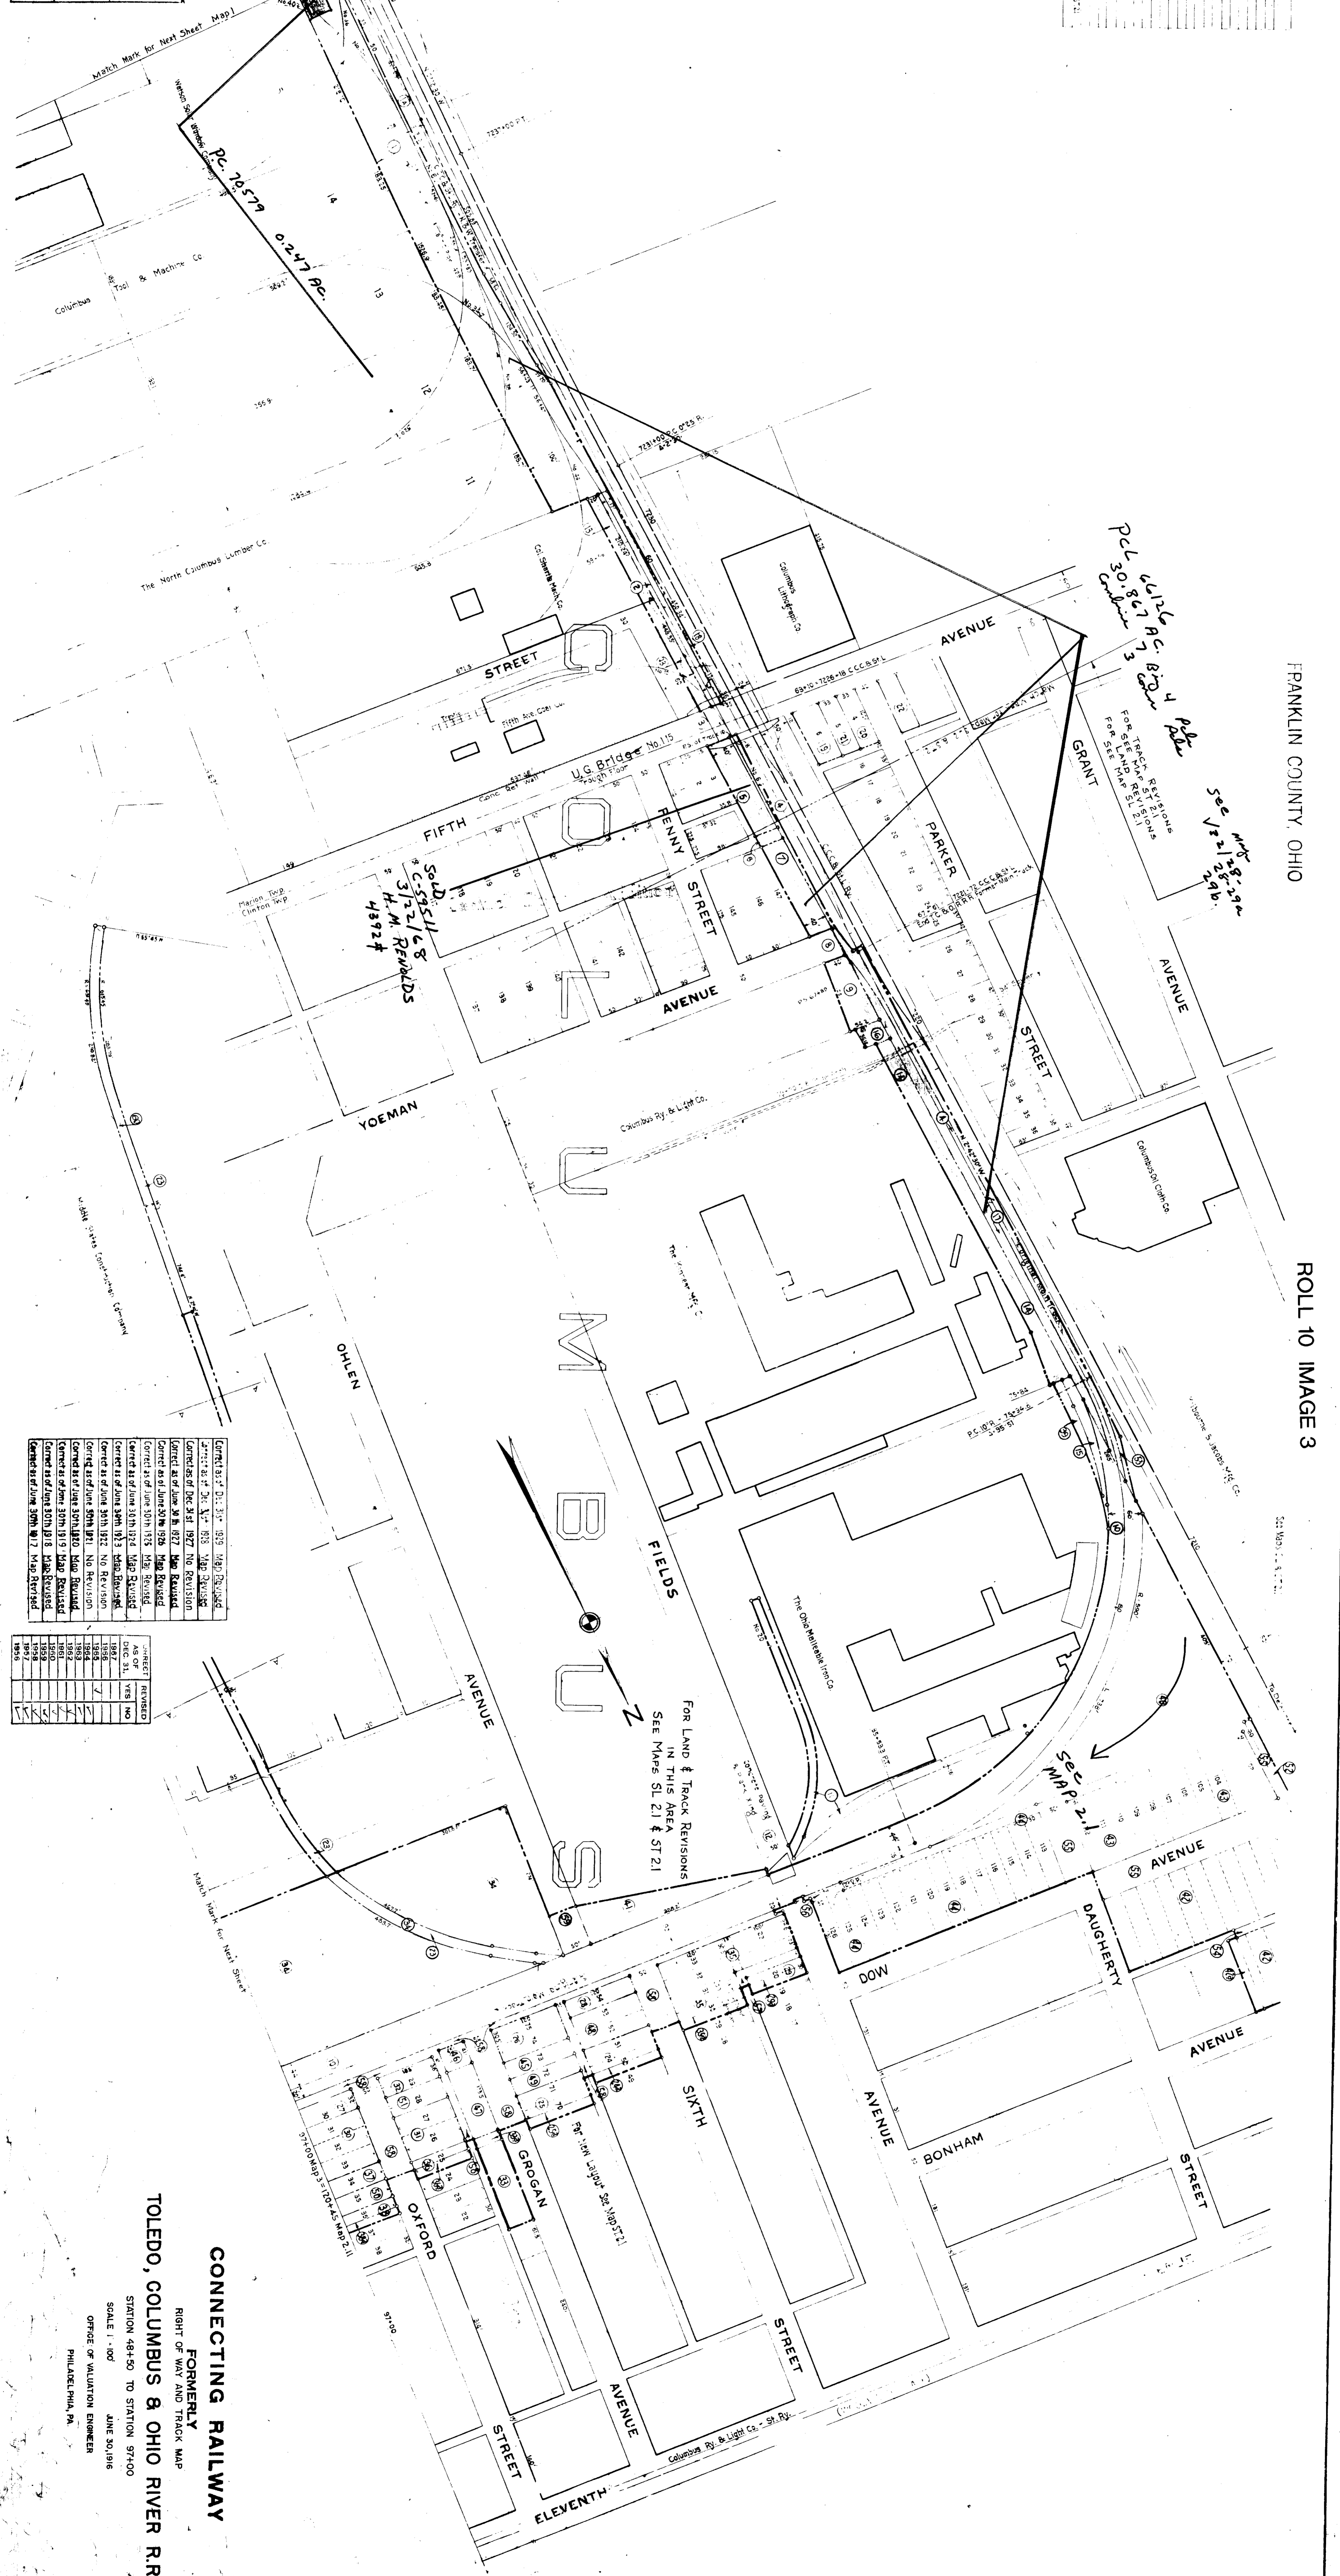

CONNECTING RAILWAY
 FORMERLY
TOLEDO, COLUMBUS & OHIO RIVER R.R.
 RIGHT OF WAY AND TRACK MAP
 STATION 48+50 TO STATION 97+00
 SCALE 1" = 100'
 JUNE 30, 1916
 OFFICE OF VALUATION ENGINEER
 PHILADELPHIA, PA.

