


COLUMBUS, OHIO.

 

STATION MAP
THE COLUMBUS AND NEWARK DIVISION
 OWNED AND OPERATED JOINTLY BY
THE BALTIMORE AND OHIO RAILROAD COMPANY
 AND
THE PITTSBURGH, CINCINNATI, CHICAGO AND ST. LOUIS RAILWAY COMPANY
 NEWARK DIVISION OF THE B. & O. R.
 PITTSBURGH DIVISION OF THE P. C. & ST. L. R.
 STATION 1608+00 TO STATION 1660+80
 Scale: 1 in = 100 ft June 30, 1916
 Office of Valuation Engineer
 The Baltimore and Ohio Railroad Co
 Baltimore, Md.


Sheet No 5-16 of 17 primary and 13 supplemental sheets of
 V. Columbus and Newark Division
 from survey station 1608+00 to survey station 1660+80
 Pilot Engineer

ROLL 12 IMAGE 2

ROLL 12 IMAGE 3

COLUMBUS, OHIO.

FRANKLIN COUNTY JHO
MARION TWP

 



STATION MAP
 THE COLUMBUS AND NEWARK DIVISION
 OWNED AND OPERATED JOINTLY BY
THE BALTIMORE AND OHIO RAILROAD COMPANY
 AND
THE PITTSBURGH, CINCINNATI, CHICAGO AND ST. LOUIS RAILWAY COMPANY
 NEWARK DIVISION OF THE B. & O. R. R.
 PITTSBURGH DIVISION OF THE P. C. C. & ST. L. R.
 STATION 1660-80 TO STATION 1713-160
 Scale 1" = 100ft June 30 1916
 Office of Valuation Engineer
 The Baltimore and Ohio Railroad Co.
 Baltimore, Md.

Sheet No 5-1617 of 17 primary and 13 supplemental sheets of
 Columbus and Newark Division
 from Survey Station 1660-80 to Survey Station 1713-160
 Pilot Engineer

5-1617
 OHIO
 5-1617

ROLL 12 IMAGE 1

COLUMBUS, OHIO.

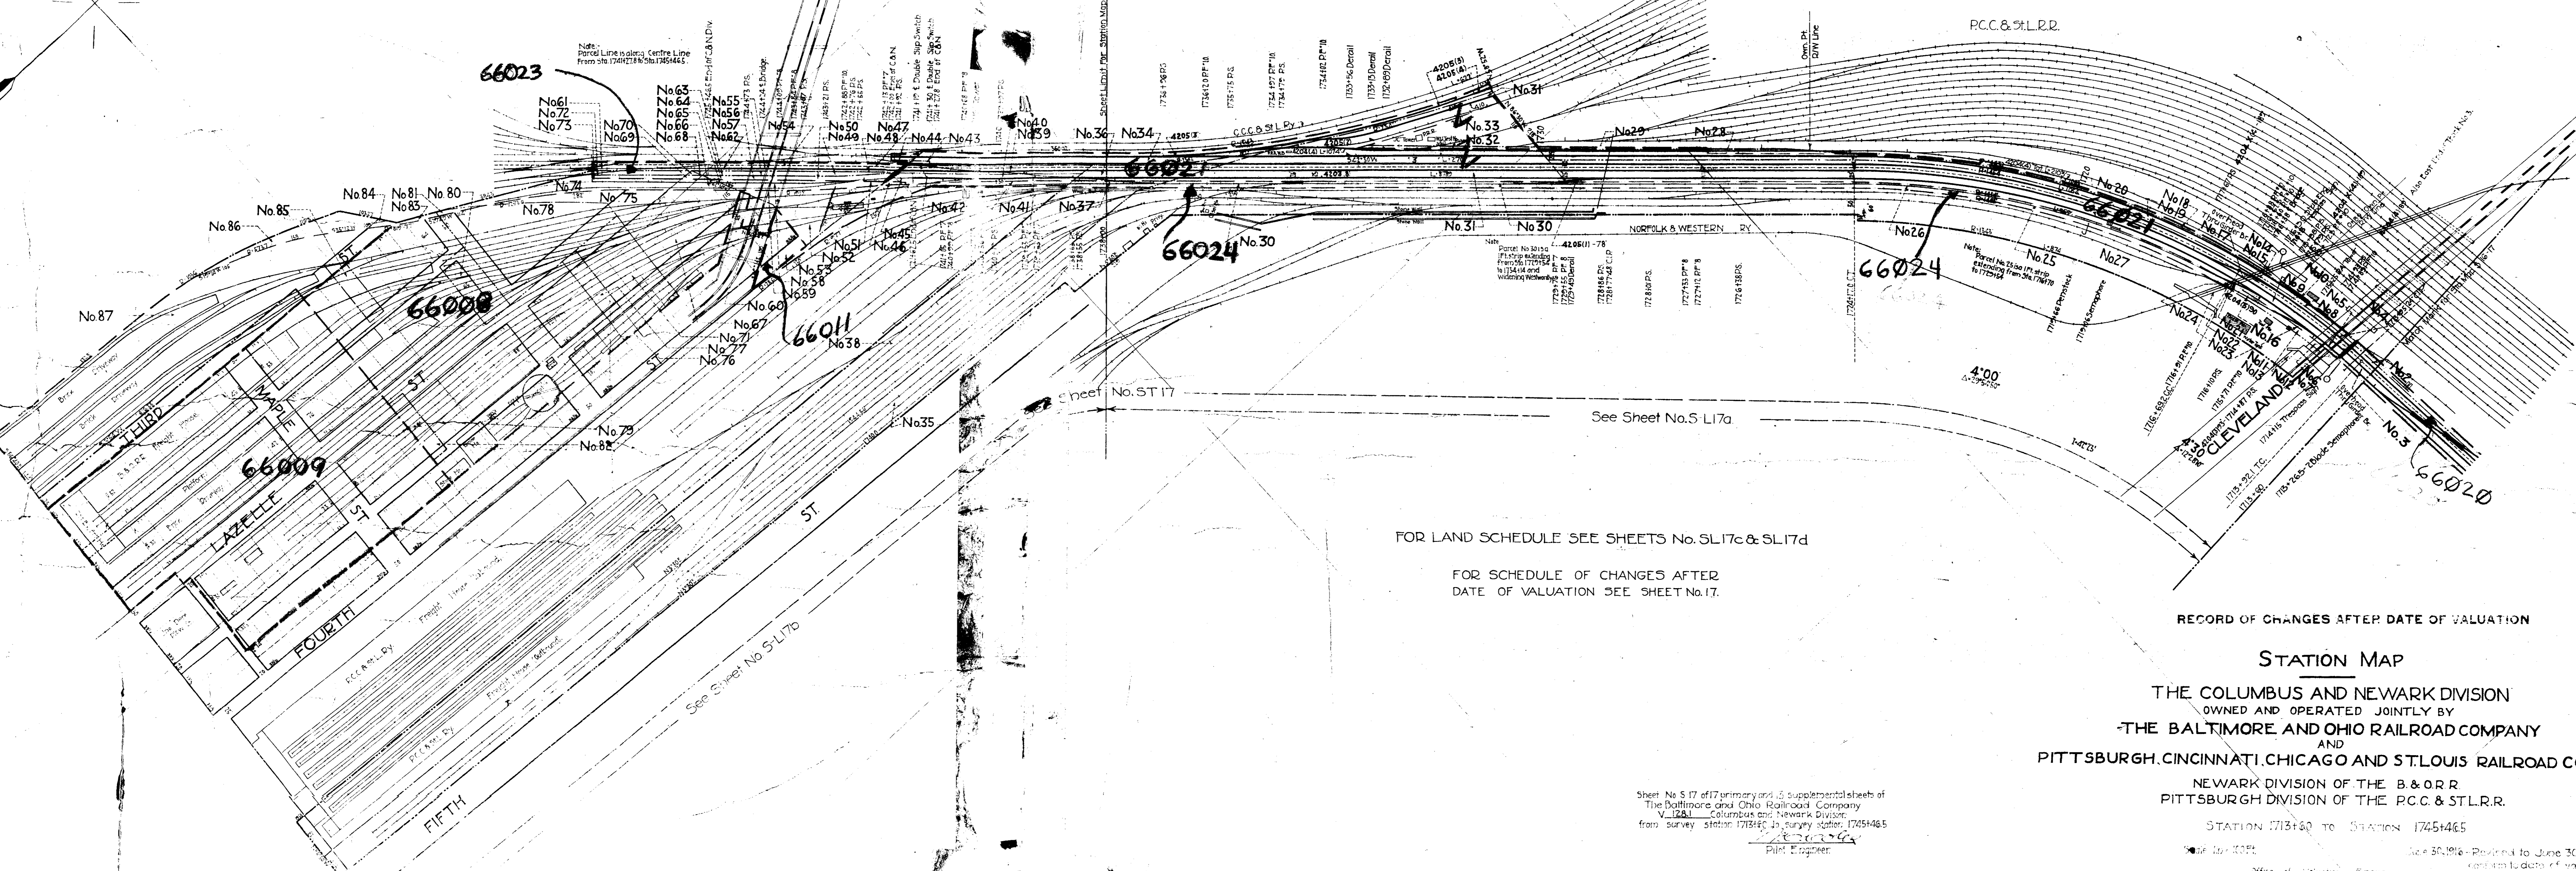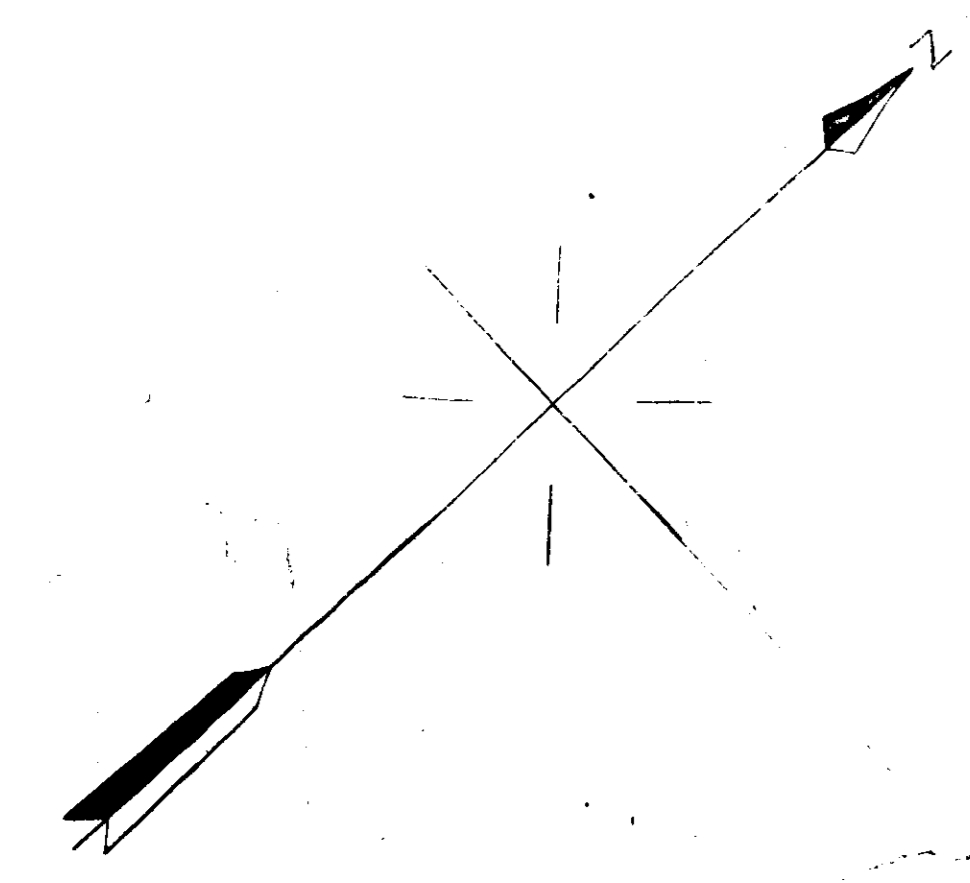

FOR LAND SCHEDULE SEE SHEETS No. SL17c & SL17d

FOR SCHEDULE OF CHANGES AFTER
DATE OF VALUATION SEE SHEET No. 17.

RECORD OF CHANGES AFTER DATE OF VALUATION

STATION MAP
THE COLUMBUS AND NEWARK DIVISION
OWNED AND OPERATED JOINTLY BY
THE BALTIMORE AND OHIO RAILROAD COMPANY
AND
PITTSBURGH, CINCINNATI, CHICAGO AND ST. LOUIS RAILROAD COMPANY
NEWARK DIVISION OF THE B. & O. R. R.
PITTSBURGH DIVISION OF THE P. C. C. & ST. L. R. R.

Sheet No. S 17 of 17 primary and 13 supplemental sheets of
The Baltimore and Ohio Railroad Company
V. 1281 - Columbus and Newark Division
from survey station 1713460 to survey station 17451465
Printed by
P. E. G. & Co.
Print Engineer


STATION 1713460 TO STATION 17451465

See 30, 1916 - Revised to June 30, 1916, 1917
Office of Voluntary Engineer
The Baltimore and Ohio Railroad Co.
Baltimore, Md.
The Baltimore and Ohio Railroad Company
The Baltimore and Ohio Railroad Company




ROLL 12 IMAGE 15

ROLL 12 IMAGE 16

 


Sheet No. 11 of 17 primary and 13 supplemental sheets of
 V. 2 Columbus and Newark Division
 from survey station 1056+00 to survey station 1161+60
 Pilot Engineer

RIGHT-OF-WAY AND TRACK MAP
 THE COLUMBUS AND NEWARK DIVISION
 OWNED AND OPERATED JOINTLY BY
 THE BALTIMORE AND OHIO RAILROAD COMPANY
 AND
 THE PITTSBURGH, CINCINNATI, CHICAGO AND ST. LOUIS RAILWAY COMPANY
 NEWARK DIVISION OF THE B. O. R. R.
 PITTSBURGH DIVISION OF THE P. C. & S. L. R.
 STATION 1056+00 TO STATION 1161+60
 Scale: 1 in = 200 ft. June 30, 1916
 Office of Valuation Engineer
 The Baltimore and Ohio Railroad Co.
 Baltimore, Md.

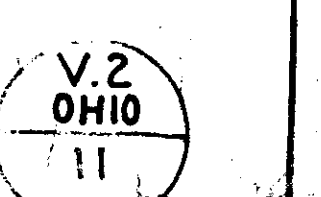

ROLL 12 IMAGE 13

ROLL 12 IMAGE 14

 


PARCEL NO.	CUSTOMER NO.	KIND OF INSTRUMENT	DATE OF INSTRUMENT	GRANTOR	GRANTEE	RECORDED			AREA ACRES	REMARKS
						BOOK	PAGE	DATE		
1										Some as Parcel No. 15 Map No. 11.
2	850	Deed	Oct. 14, 1906	Mary Evans et al	CORR & PCC & ST LRY	459	295	Nov. 12, 1906	17414	Some as Parcel No. 17 Map No. 11.
3	852	Deed	Sept. 15, 1906	S. R. Armstrong	CORR & PCC & ST LRY	441	18	Oct. 24, 1906	3156	Some instrument as Par. No. 16 Map No. 11.
4										Total Area - 3156 Ac. last inch Par. No. 9
5	855	Deed	Jan. 3, 1907	L. G. Thomas et al	CORR & PCC & ST LRY	450	86	Jan. 31, 1907	21000	
6	851	Release	Mar. 10, 1851	Wm. Armstrong	C. O. R. R.	315	7	Feb. 3, 1899	12424	
7										Total Area - 3395 Ac. last inch Par. No. 8
8										See Parcel No. 7 High St.
9										See Parcel No. 4 High St.
10	854	Release	Mar. 10, 1851	Wm. A. Smith	C. O. R. R.	315	16	Feb. 4, 1899	600	Total Area - 4048 Ac. High of last inch Par. No. 11
11										See Parcel No. 10
12	855	Deed	Oct. 7, 1886	Ezek. Compton et al	B. & O. R. R.	179	626	Oct. 23, 1886	399	
13	855	Deed	Oct. 24, 1888	B. & O. R. R.	C. O. R. R.	198	492	Oct. 24, 1888	385	
14	861	Deed	Nov. 8, 1861	Simon Stone	C. O. R. R.	315	6	Feb. 3, 1899	1232	
15	857	Release	Nov. 30, 1906	Geo. W. Bink et al	C. O. R. R. & PCC & ST LRY	450	75	Jan. 23, 1907	31799	
16	862	Deed	Nov. 30, 1906	John A. Denner et al	C. O. R. R. & PCC & ST LRY	450	78	Jan. 23, 1907	1234	
17	865	Deed	Sept. 14, 1906	David C. Miller	C. O. R. R. & PCC & ST LRY	441	33	Oct. 15, 1906	28993	
18	864	Deed	Oct. 25, 1906	J. C. Morrison et al	C. O. R. R. & PCC & ST LRY	439	296	Nov. 12, 1906	104	Some as Parcel No. 12 Map No. 13.
19	860	Agmt.	May 30, 1851	David Taylor	C. O. R. R.	315	11	Feb. 3, 1899	1280	Some as Parcel No. 11 Map No. 15. Instrument also includes Par. Nos. 6, 11, 13, 20, 26 Map No. 15, and Par. Nos. 1, 2, 3, 100. Total Area - 3218 Ac. of which 1937 Ac. is also included in Parcel No. 11 Map No. 15.

Sheet No. 12 of 17 primary and 13 supplemental sheets of
 V. _____ Columbus and Newark Division
 from Survey Station 116160 to Survey Station 126720
 Pilot Engineer


RIGHT-OF-WAY AND TRACK MAP
 THE COLUMBUS AND NEWARK DIVISION
 OWNED AND OPERATED JOINTLY BY
 THE BALTIMORE AND OHIO RAILROAD COMPANY
 AND
 THE PITTSBURGH, CINCINNATI, CHICAGO AND ST. LOUIS RAILWAY COMPANY
 NEWARK DIVISION OF THE B & O R. R.
 PITTSBURGH DIVISION OF THE PCC & ST LRY

STATION 116160 TO STATION 126720
 Scale: 1 in = 200 ft. June 30, 1916
 Office of Valuation Engineer
 The Baltimore and Ohio Railroad Co.
 Baltimore, Md.

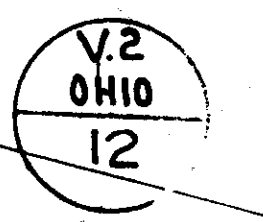

ROLL 12 IMAGE 12

PARCEL NO.	DIAN'S NO.	KIND OF INSTRUMENT	DATE OF INSTRUMENT	GRANTOR	GRANTEE	RECORDED		AREA ACRES	REMARKS
						BOOK	PAGE		
1									Same as Parcel No. 18 Map No. 12
2									Same as Parcel No. 17 Map No. 12
3	860	Agmt	May 3, 1885	David Taylor	CORR.	315	11	Feb. 3, 1899	Same as Parcel No. 18 Map No. 12, inst. in bk. Par. Nos. 6, 9, 12, 13, 16, 18 County Road.
4	866	Agmt	Nov 3, 1888	Comrs of Franklin Co	CORR & P.C.C. & S.L.R.Y.	421	20	Oct 30, 1906	Total Area 4.64 Ac. of which 2.95 Ac. is returned to County Road.
5	870	Deed	Aug 2, 1889	David Taylor	CORR & P.C.C. & S.L.R.Y.	190	111	Nov 30, 1887	Total Area of Par. No. 18 Map No. 12, inst. in bk. Par. No. 421. See Parcel Nos 3 & 5
6	867	Deed	Sept 14, 1906	A.T. Miller et al	CORR & P.C.C. & S.L.R.Y.	441	26	Oct 24, 1906	Total Area 5.21 Ac. inst. in bk. Par. No. 421. See Parcel No. 7
7	868	D.C. Deed	Sept 14, 1906	Lucinda A Miller	CORR & P.C.C. & S.L.R.Y.	441	25	Oct 26, 1906	See Parcel Nos 5 & 5 County Road.
8	865	Deed	Apr 14, 1885	David Taylor	CORR.	315	10	Feb 5, 1899	
9	877	Deed	Nov 30, 1906	W.M. Clark et al.	CORR & P.C.C. & S.L.R.Y.	447	174	Jan 29, 1907	
10									
11									
12									
13									
14	874	Deed	July 19, 1887	Anno Mc Nutty	CORR & P.C.C. & S.L.R.Y.	187	381	July 24, 1887	
15	875	Deed	Sept 14, 1906	Columbus Clay Mfg. Co.	CORR & P.C.C. & S.L.R.Y.	450	75	Jan 29, 1907	Total Area 2.26 Ac. inst. in bk. Par. Nos. 18 & 22.
16	877	Deed	Sept 14, 1906	Henry Schwalk et al.	CORR & P.C.C. & S.L.R.Y.	450	85	Jan 29, 1907	Total Area 8.71 Ac. inst. in bk. Par. Nos. 18 & 22. See Parcel No. 16 Agreement covers change in location of County Road. inst. in bk. Par. Nos. 18 & 22.
17	878	Deed	Nov 25, 1907	Andrew Morris et al.	CORR & P.C.C. & S.L.R.Y.	460	395	Dec 16, 1907	See Parcel No. 16 Agreement covers change in location of County Road. inst. in bk. Par. Nos. 18 & 22.
18	879	Agmt	Dec 8, 1906	Comrs of Franklin Co	B.O.R.R.				See Parcel Nos 3 & 8 County Road.
19									
20									
21									
22									
23									
24									
25	881	D.C. Deed	Aug 7, 1887	Michael Pott	B.O.R.R.	183	155	Dec 27, 1886	
26		Deed	June 21, 1887	Michael Pott	B.O.R.R.	198	491		

 

TAYLOR, OHIO.
1508 + 1517 E STATION.


RIGHT-OF-WAY AND TRACK MAP
THE COLUMBUS AND NEWARK DIVISION
OWNED AND OPERATED JOINTLY BY
THE BALTIMORE AND OHIO RAILROAD COMPANY
AND
THE PITTSBURGH, CINCINNATI, CHICAGO AND ST. LOUIS RAILWAY COMPANY

Sheet No 13 of 17 primary and 13 supplemental sheets of
V. Columbus and Newark Division
from survey station 1267+20 to Survey Station 1572+80
Pilot Engineer

NEWARK DIVISION OF THE B & O R R
PITTSBURGH DIVISION OF THE P.C.C. & S.L.R.Y.

STATION 1267+20 TO STATION 1572+80
Scale: 1 in = 200 ft June 30, 1916

Office of Valuation Engineer
The Baltimore and Ohio Railroad Co.
Baltimore, Md.

 


PARCEL NO	OWNER'S NO	KIND OF INSTRUMENT	DATE OF INSTRUMENT	GRANTOR	GRANTEE	RECORDED			AREA		REMARKS
						BOOK	PAGE	DATE	ACRES	SQUARE FEET	
1	871	Agmt.	Nov 3, 1898	Comm. of Franklin Co. R.R. & N. Co.	C.O.R.R.	315	17	Feb 4, 1899	5416	2020	Same as Parcel No. 10 Map No. 15. See Parcel No. 10. Total Area - 3.88 Ac. See Parcel No. 10. See Parcel No. 3.
3	884	Deed	Mar 6, 1891	Simon Pearson	C.O.R.R.	315	8	Feb 3, 1899	5975	3691	Total Area - 9.506 Ac. Includes Parcel No. 67. See Parcel No. 5. Public Road. See Parcel No. 5.
4	885	Deed	Mar 6, 1891	James Price	C.O.R.R.	315	18	Feb 4, 1899	3827	396	
5	886	Deed	Dec 10, 1893	Henry Luft et al.	C.O.R.R.	52	465	Dec 30, 1893	146		
6	887	Deed	Dec 10, 1893	Joseph Rodentfels	C.O.R.R.	52	463	Dec 30, 1893	146		
7	887	Deed	Dec 10, 1893	Joseph Rodentfels	C.O.R.R.	52	463	Dec 30, 1893	146		
8	888	Deed	Dec 13, 1893	Martin Krummelt	C.O.R.R.	52	466	Dec 30, 1893	146		Total Area - 3.88 Ac. Same as Parcel No. 10 Map No. 15. Instrument also includes Parcel No. 28 31 34 35 36 

Sheet No 14 of 17 primary and 13 supplemental sheets of
 V. Columbus and Newark Division
 from Survey station 1372+80 to survey station 1478+40
 Pilot Engineer

THE COLUMBUS AND NEWARK DIVISION
 OWNED AND OPERATED JOINTLY
 THE BALTIMORE AND OHIO RAILROAD COMPANY
 AND
 THE PITTSBURGH, CINCINNATI, CHICAGO AND ST. LOUIS RAILWAY COMPANY

NEWARK DIVISION OF THE B & O R.R.
 PITTSBURGH DIVISION OF THE P.C.C. & ST. L.R.
 STATION 1372+80 TO STATION 1478+40
 Scale: 1 in = 200 ft June 30 1916

Office of Valuation Engineer
 The Baltimore and Ohio Railroad Co
 Baltimore, Md.

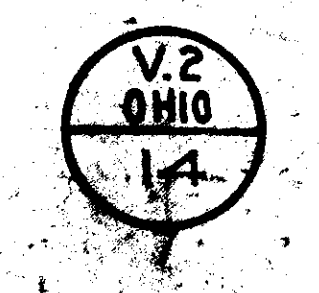

ROLL 12 IMAGE 8

ROLL 12 IMAGE 9



See P.C.C. & St. L.R.R. Map 15

SCHEDULE OF SIDINGS AND CROSSOVERS


Siding Number	Location	Class	Length	Private	Total	Remarks
8	East Columbus		158'		158'	
10			173'		173'	
12			609'		609'	
14			605'		605'	
16			167'		167'	

Correct as of Dec. 31st 1927. No Revision.
 Correct as of June 30th 1927. No Revision.
 Correct as of June 30th 1926. No Revision.
 Correct as of June 30th 1925. No Revision.
 Correct as of June 30th 1924. No Revision.
 Correct as of June 30th 1923. Map Revised.
 Correct as of June 30th 1922. Map Revised.
 Correct as of June 30th 1921. No Revision.
 Correct as of June 30th 1920. No Revision.
 Stock Yards and Facilities placed in service 4-26-19

RIGHT OF WAY AND TRACK MAP
 PITTSBURGH, CINCINNATI, CHICAGO & ST. LOUIS RY.
 PITTSBURGH DIVISION
 STATION TO STATION
 SCALE: 1" = 100 FT. JUNE 30, 1916
 OFFICE OF VALUATION ENGINEER
 PITTSBURGH, PA.



ROLL 12 IMAGE 7

 

92812
6.795 AC

41277
6.872 AC

71426
3.363 AC

96145
4.396 AC

PARCEL NO.	DATE OF INSTRUMENT	KIND OF INSTRUMENT	DATE OF INSTRUMENT	GRANTOR	GRANTEE	RECORDED		AREA	REMARKS
						BOOK	PAGE		
1									
2	1888	Deed	Dec 15, 1855	Martin Krammetz	CORR	51	486	Dec 30, 1855	3530
3									18260
4	1888	Deed	Nov 2, 1855	Ind. P. & O. Co.	CORR & P.C.C. & S.R.	95	15	Nov 3, 1854	14550
5									17950
6	1889	Deed	July 17, 1854	Jacob Schmeitzel	C.O.P.R.	95	15	Nov 3, 1854	8400
7	1892	Agmt	Oct 8, 1856	Col. & Exm. Co.	C.O.P.R. & P.C.C. & S.R.	95	15	Nov 3, 1854	1600
8									21600
9									525
10	1921	Agmt	Feb 18, 1907	Ralston Steel Car Co.	C.O.P.R. & P.C.C. & S.R.	190	209	Nov 30, 1887	750
11	1921	Agmt	Feb 18, 1907	Ralston Steel Car Co.	C.O.P.R. & P.C.C. & S.R.	190	209	Nov 30, 1887	750
12	1896	Deed	Sept 24, 1887	Lewis Frey	C.O.P.R. & P.C.C. & S.R.	190	209	Nov 30, 1887	750
13									156
14	1898	Release	June 12, 1851	Lewis Frey	C.O.P.R.	315	14	Feb 4, 1899	608
15	1899	Release	Mar 6, 1851	Isadore Frey	C.O.P.R.	315	14	Feb 4, 1899	32888
16									5000
17									5500
18	1900	Release	Mar 6, 1851	Ermine Case	C.O.P.R.	315	14	Feb 4, 1899	1771
19									5500
20									2,485
21	1881	Deed	Jan 31, 1851	Ermine Case	C.O.P.R.	48	238		9710

Sheet No. 16 of 17 primary and 13 supplemental sheets of
Columbus and Newark Division
from survey station 1478+40 to survey station 1584+00
R. E. Engineer

RIGHT-OF-WAY AND TRACK MAP
THE COLUMBUS AND NEWARK DIVISION
OWNED AND OPERATED JOINTLY BY
THE BALTIMORE AND OHIO RAILROAD COMPANY
AND
THE PITTSBURGH, CINCINNATI, CHICAGO AND ST. LOUIS RAILWAY COMPANY
NEWARK DIVISION OF THE B. & O. R. R.
PITTSBURGH DIVISION OF THE P. C. & S. T. L. R. Y.


STATION 1478+40 TO STATION 1584+00

Scale 1 in = 200 ft June 30, 1916

Office of Valuation Engineer
The Baltimore and Ohio Railroad Co.
Baltimore, Md.

COLUMBUS, OHIO.

PARCEL NO.	CUSTOMER'S NO.	KIND OF INSTRUMENT	DATE OF INSTRUMENT	GRANTOR	GRANTEE	RECORDED			AREA ACRES	SQUARE FEET	REMARKS.
						BOOK	PAGE	DATE			
1											Same as Par No 21, Map No 15.
2											Same as Par No 19, Map No 15.
3											Same as Par No 12, Map No 15.
4	501	Deed	Aug 31, 1851	Ermine Case, John Deas	C. O. R. R.	48	238		4.196	18800	Total Area acquired under this inst. 4.459 Ac. 191504 sq. ft. Total Area acquired under this inst. 5.454 Ac. 186470 sq. ft. inst. includes Par No. 7, 5, 12, 14.
5	502	Agmt	Mar 14, 1851	John Deas	C. O. R. R.	216	276	Feb 23, 1870			7.10 Ac. acquired under this inst. 6.651 Ac. 189735 sq. ft. Derelict of Bridge, Johnstown Rd. now Sunbury Ave. Construction of Overhead Bridge. See Par No. 5, Sunbury Ave. Sunbury Ave. 750

 

SHEET No. S. 16-17.

SHEET No. S. 16.

RIGHT-OF-WAY AND TRACK MAP
THE COLUMBUS AND NEWARK DIVISION
OWNED AND OPERATED JOINTLY BY
THE BALTIMORE AND OHIO RAILROAD COMPANY
AND
THE PITTSBURGH, CINCINNATI, CHICAGO AND ST. LOUIS RAILWAY COMPANY
NEWARK DIVISION OF THE B. & O. R. R.
PITTSBURGH DIVISION OF THE P. C. C. & S. T. R. R.

Sheet No. 16 of 17 primary and 3 supplemental sheets of
V Columbus and Newark Division
from survey station 1584+00 to survey station 1689+60
Pilot Engineer

STATION 1584+00 TO STATION 1689+60
Scale in 200 ft June 30, 1916
Office of Valuation Engineer
The Baltimore and Ohio Railroad Co.
Baltimore, Md.

