ROAD RECORD NO. 7

ROAD RECORD NO. 7 | PAGE NO. 247

Noe-Bixby Road - alteration from E Main Street north to the north line of Truro Township

ROW = 60' by law

COUNTY ROAD

BY JONATHAN C. NOE & OTHERS

To the Hon. the Commissioners of Franklin County.

The undersigned freeholders and residents of Said County most respectfully Represent that they believe the public interest and convenience require the establishment of a County Road to Commence in the centre of the National Road in the Town of Hibernia in Truro township, from thence up, the east side of Big Walnut Creek to Jonathan Noe's Saw Mill, thence northwardly to the S. W. Corner of Jacob Wolfs land thence North on the line dividing the lands of Jacob Wolf and Richard Rhodes to Said Wolfs N. W. Corner in the north line of Truro Township and your petitioners therefore pray that the proper and legal steps may be taken to authorize the location and establishment of said road, and your petitioners as in duty bound will ever Pray----- Gilbert Green, Jonathan C. Noe, Richard Rhoads, Wm S. Hughes, George Hughes, John H. Alspack, Samuel Robb, Henry Morrers, Noah F. Banister, Nat. Hudson, Silas Edgar, Wm Stutson, J. B. Sprague, McKee Thompson, Levi E. Wilson, Daniel Whitsel, F. N. Sprague, David Pugh, David Pugh Jun.

On the eptition of Jonathan C. Noe and others for a new County Road, to Commence in the Centre of the National Road in the town of Hibernia in Truro township, from thence up the east side of Big Walnut Creek, to Jonathan Noe's Saw Mill, thence northwardly to the S. W. Corner of Jacob Wolfs land, thence North on the line dividing the lands of Jacob Wolf and Richard Rhodes to Said Wolfs N. W. Corner in the north line of Truro Township.

Whereupon the Commissioners of Franklin County appointed Jonathan McComb, James Carson, and Zachariah Paul Viewers, and James OKane Surveyor, and that they meet at the Office of Sylvanus Baldwin Esq. in Truro Township on the 26, day of June 1841, or within five days thereafter, and after being duly qualified according to law proceed to View, Survey, Mark and locate Said Road as the law directs and a true plat and Survey thereof along with their report return to this Office on Or before the first Monday in the month of December 1841.

Attest
F. Cole Auditor of
Franklin County

The State of Ohio Franklin County

Personally came before me S. Baldwin a Justice of the Peace for Said County, the above named Jonathan McComb, James Carson, Zachariah Paul and James OKane and were duly sworn to faithfully perform the duties assigned them in the above order.

June 26, 1841

S. Baldwin J. P.

Field Notes of a Survey of a Road made on the 26th day of June A. D. 1841, Commencing at a Stake on the North Side of National Road in Hibernia west of the house where Noah Banister lives, Thence North 14 rods to a Stake, thence N. 18 W. 34 rods to a Stake, thence N. 20 E. 16 rods to a Stake on gravel bank, thence N. 6 W. 24 rods to centre old road, thence N. 25 W. 82 rods to a Stake 14 links N. 4 E. of a White Oak, thence N. 2 W. 30 rods to a Stake, thence N. 18 W. 30 rods to a Stake, thence N. 37 W. 50 rods to a Stake, thence N. 48 W. 14 rods to a Stake, thence N. 12½ E. 4 rods run 24 rods post and One mile on the bluff, thence N. 4 E. 68 rods and 16 links to J. Wolf's S. W. Corner, thence North 166 rods to J. Wolf's N. W. corner Making 1 Mile and a half and 74 Rods.

James OKane Surveyor

I hereby Certify the within to be a Correct Survey & Plat of the road surveyed on the 26, day of June 1841 under the direction of Messrs Jonathan McComb Zachariah Paul and James Carson

James O'Kane Surveyor

In obedience to the within order we the undersigned after being duly sworn proceeded to view and locate said road, Commencing on the National Road as directed by said order and running thence northwardly agreeable to plat of survey by J. P. O'Kane Surveyor herewith forwarded and we are of opinion that good road can be made on said route and that the prayer of the petitioners is reasonable and ought to be granted

Given under our hands this 29th day of June A. D. 1841.

Jonathan McComb)
Zachariah Paul)Viewers
James Carson)

Expenses

Jonathan McComb	Viewers	1 day	$1.00
Zachariah Paul	"	1 "	1.00
James Carson	"	1 "	1.00
Paul Johnson	Mkr.	1 "	.75
Stephen Green	C. C.	1 "	.75
Noah Banister	C. C.	1 "	.75
James O'Kane	Surveyor	1 2/3"	2.50
			$7.75

No objections appearing it is ordered by the Commissioners of Franklin County that the foregoing road be henceforth of record and that the same be opened and made in all respects according to Law, and that notice of this Order be given to the Trustees of the Township through which the same passes.

Commissioners Office
City of Columbus
March 9th 1842

James Bryden)
Wm W. Kile) Commissioners
Samuel S. Davis) of Franklin County

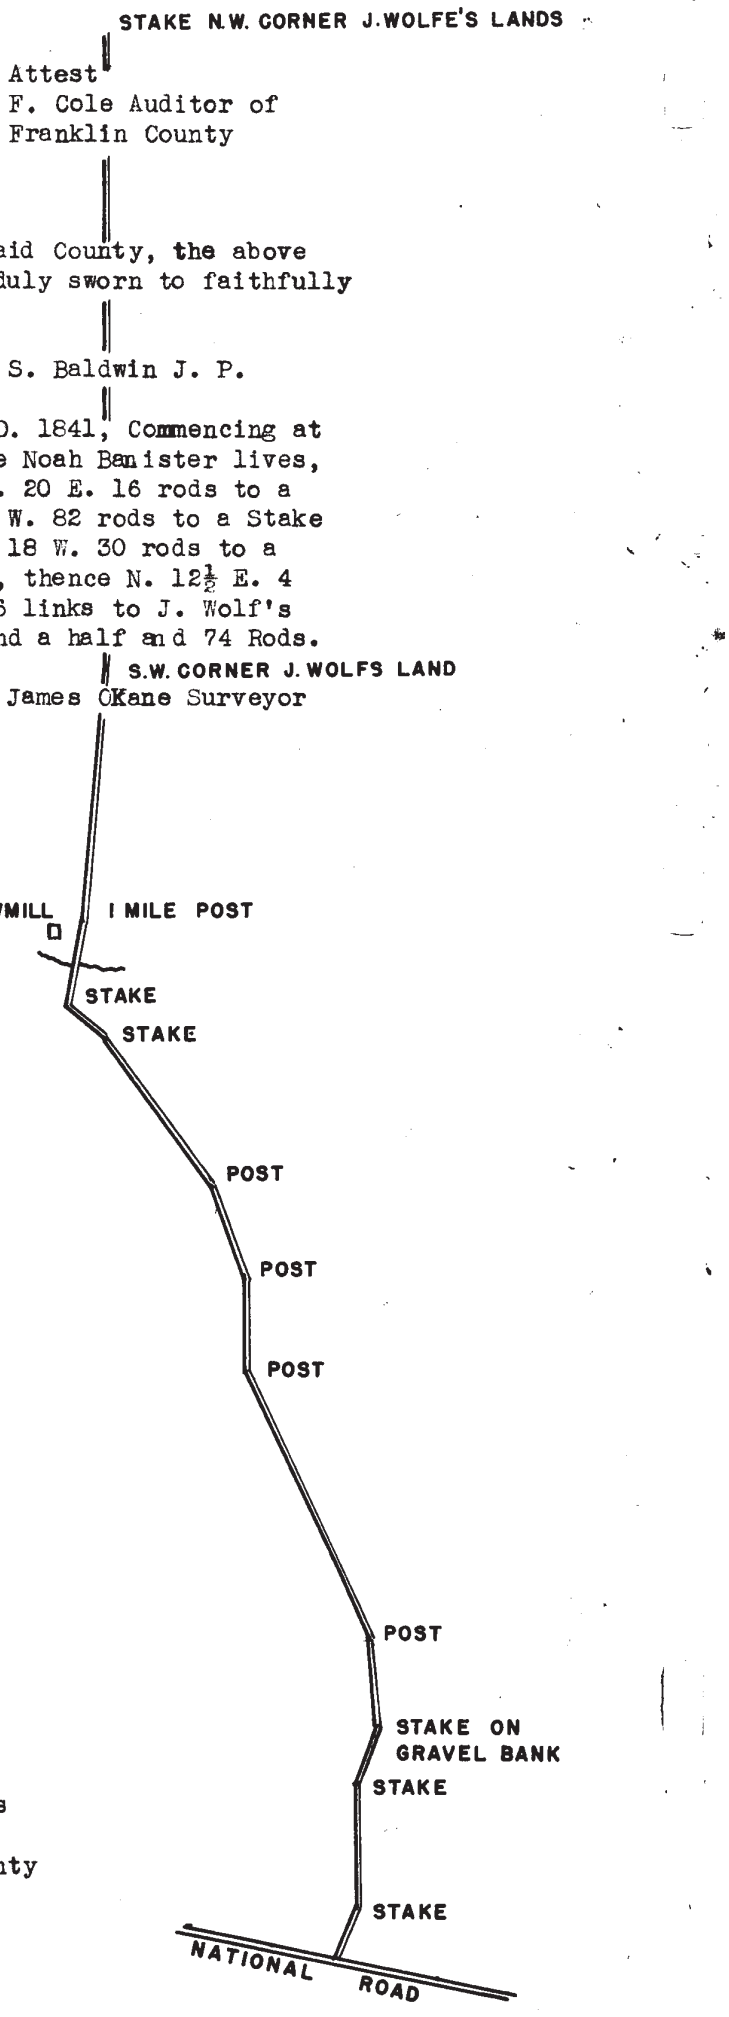

Road Record 1 003 2870