



3180 0031 Road Record 7

Reed Road - from Fishinger Road to Henderson Road

ROW = 60' by law

North Star Road - from Northwest Boulevard to just south of Ridgeview Road

ROAD RECORD NO. 7

ROAD RECORD NO. 7

PAGE NO. 254

COUNTY ROAD

BY ROBERT WALCUTT & OTHERS

To the Hon. the Commissioners of Franklin County,

The undersigned petitioners freeholders and residents in said County beg leave to represent to your honorable body, the necessity of a new County road, to commence at a point on the County road leading from Shattucksburgh to the Scioto River at or near a large white elm tree, thence in a south course to the mouth of James Bickets lane east of his Barn, thence to the mouth of Robert Walcutts lane, thence along said lane to Thomas Leggs house, thence a S. E. course to Robt. Fergusons building place, thence a S. E. course to a point three perch east of John Legg's house, thence striking the township line east of Daniel Maughts house, thence along said Township line, to the County Road leading from the Whetstone road to Renicks Mill. Your petitioners therefore pray your honorable body to appoint suitable men to view, Survey, Mark and locate said road, and a true plat and survey along with their report return to your honorable body in conformity with the statute in such case made and provided and in duty bound will pray Nov. 1, 1841. Robert Walcutt, James Bicket, Thomas Legg, Robert Ferguson, John Legg, Pleasant Litchford, Daniel Maught, Amaziah Hutchinson, Lewis T. Lane, William Lane, James Mitchell, James Adams, John Swisher, James McCoy, Allen Bowers, Hiram Richards, John Bicket, Edmund Johnston, James Walcutt, Eli Legg, James Legg.

On the Petition of Robert Walcutt and others for a new County Road to commence at a point on the county road leading from Shattucksburgh to the Scioto River at or near a large white Elm tree thence in a south course to James Bickets lane east of his barn, thence to the mouth of Robert Walcutts lane, thence along said lane to Thomas Legg's house, thence a southeast course to Robert Fergusons building place, thence a southeast course to a point 3 perches east of John Legg's house, thence striking the township line east of Daniel Maughts house, thence along said township line to the county road leading from the Whetstone road to Renicks Mill.

Whereupon the Commissioners of Franklin County appointed Thompson Bull, Samuel Kinnear, and John Smith as viewers, and Uriah Lathrop as Surveyor, and that they meet at the office of Samuel Kinnear Esq. in Clinton Township on the 14th day of December 1841, or within five days thereafter, and after being duly qualified according to Law proceed to view, Survey, mark and locate said road and a true plat and survey along with their report return to this Office on or before the first Monday in the Month of March 1842.

Commissioners office
City of Columbus

Attest
F. Cole Clerk to
Commissioners

(Continued on next Page)

The State of Ohio Franklin County S S
 Before me the subscriber a justice of the peace, personally appeared Samuel Kinnear who was duly sworn according to law to faithfully and impartially discharge the duties of viewers agreeably to the tenor and prayer of the within Order-
 Sworn to and subscribed to this 14th day of December 1841.


John Swisher J. P.

The State of Ohio Franklin County S S
 Before me the subscriber a Justice of the Peace, personally appeared John Smith and Thompson Bull, who were duly affirmen according to law to faithfully and impartially discharge their duties as Viewers agreeably to the tenor and prayer of the within order Dec. 14, 1841

Samuel Kinnear J. P.

In pursuance with the annexed order, I proceeded to survey and mark a County Road, Beginning at a State in the Shattucksburgh road and run S. E. 3 E. 236 poles to J. Becketts lane, 320 poles to the first mile tree or Stake; Continued along Walcutts & Leggs lane 184 poles to a Stake in front of T. Legg's house; thence S. 52 E. passing Ferguson's building place at 95 poles (270) 320 poles to the second mile Post; thence continued 100 poles to a State 3 poles East of John Leggs house; thence S. 30 10' E. passing Wetherells corner at 124 (224) Poles continued 320 poles to three mile Post; Continued same Course 72 poles to a Stake in the east line of Ferry Township; east of Maughts house, thence S. 0 30' W. along the Township line (288) 320 poles to the fourth mile Stake; thence continued same course 100 poles to the centre of the Road leading from Whetstone to Renicks Mill, according to the annexed Plat which a correct protraction of the same

U. Lathrop Surveyor.

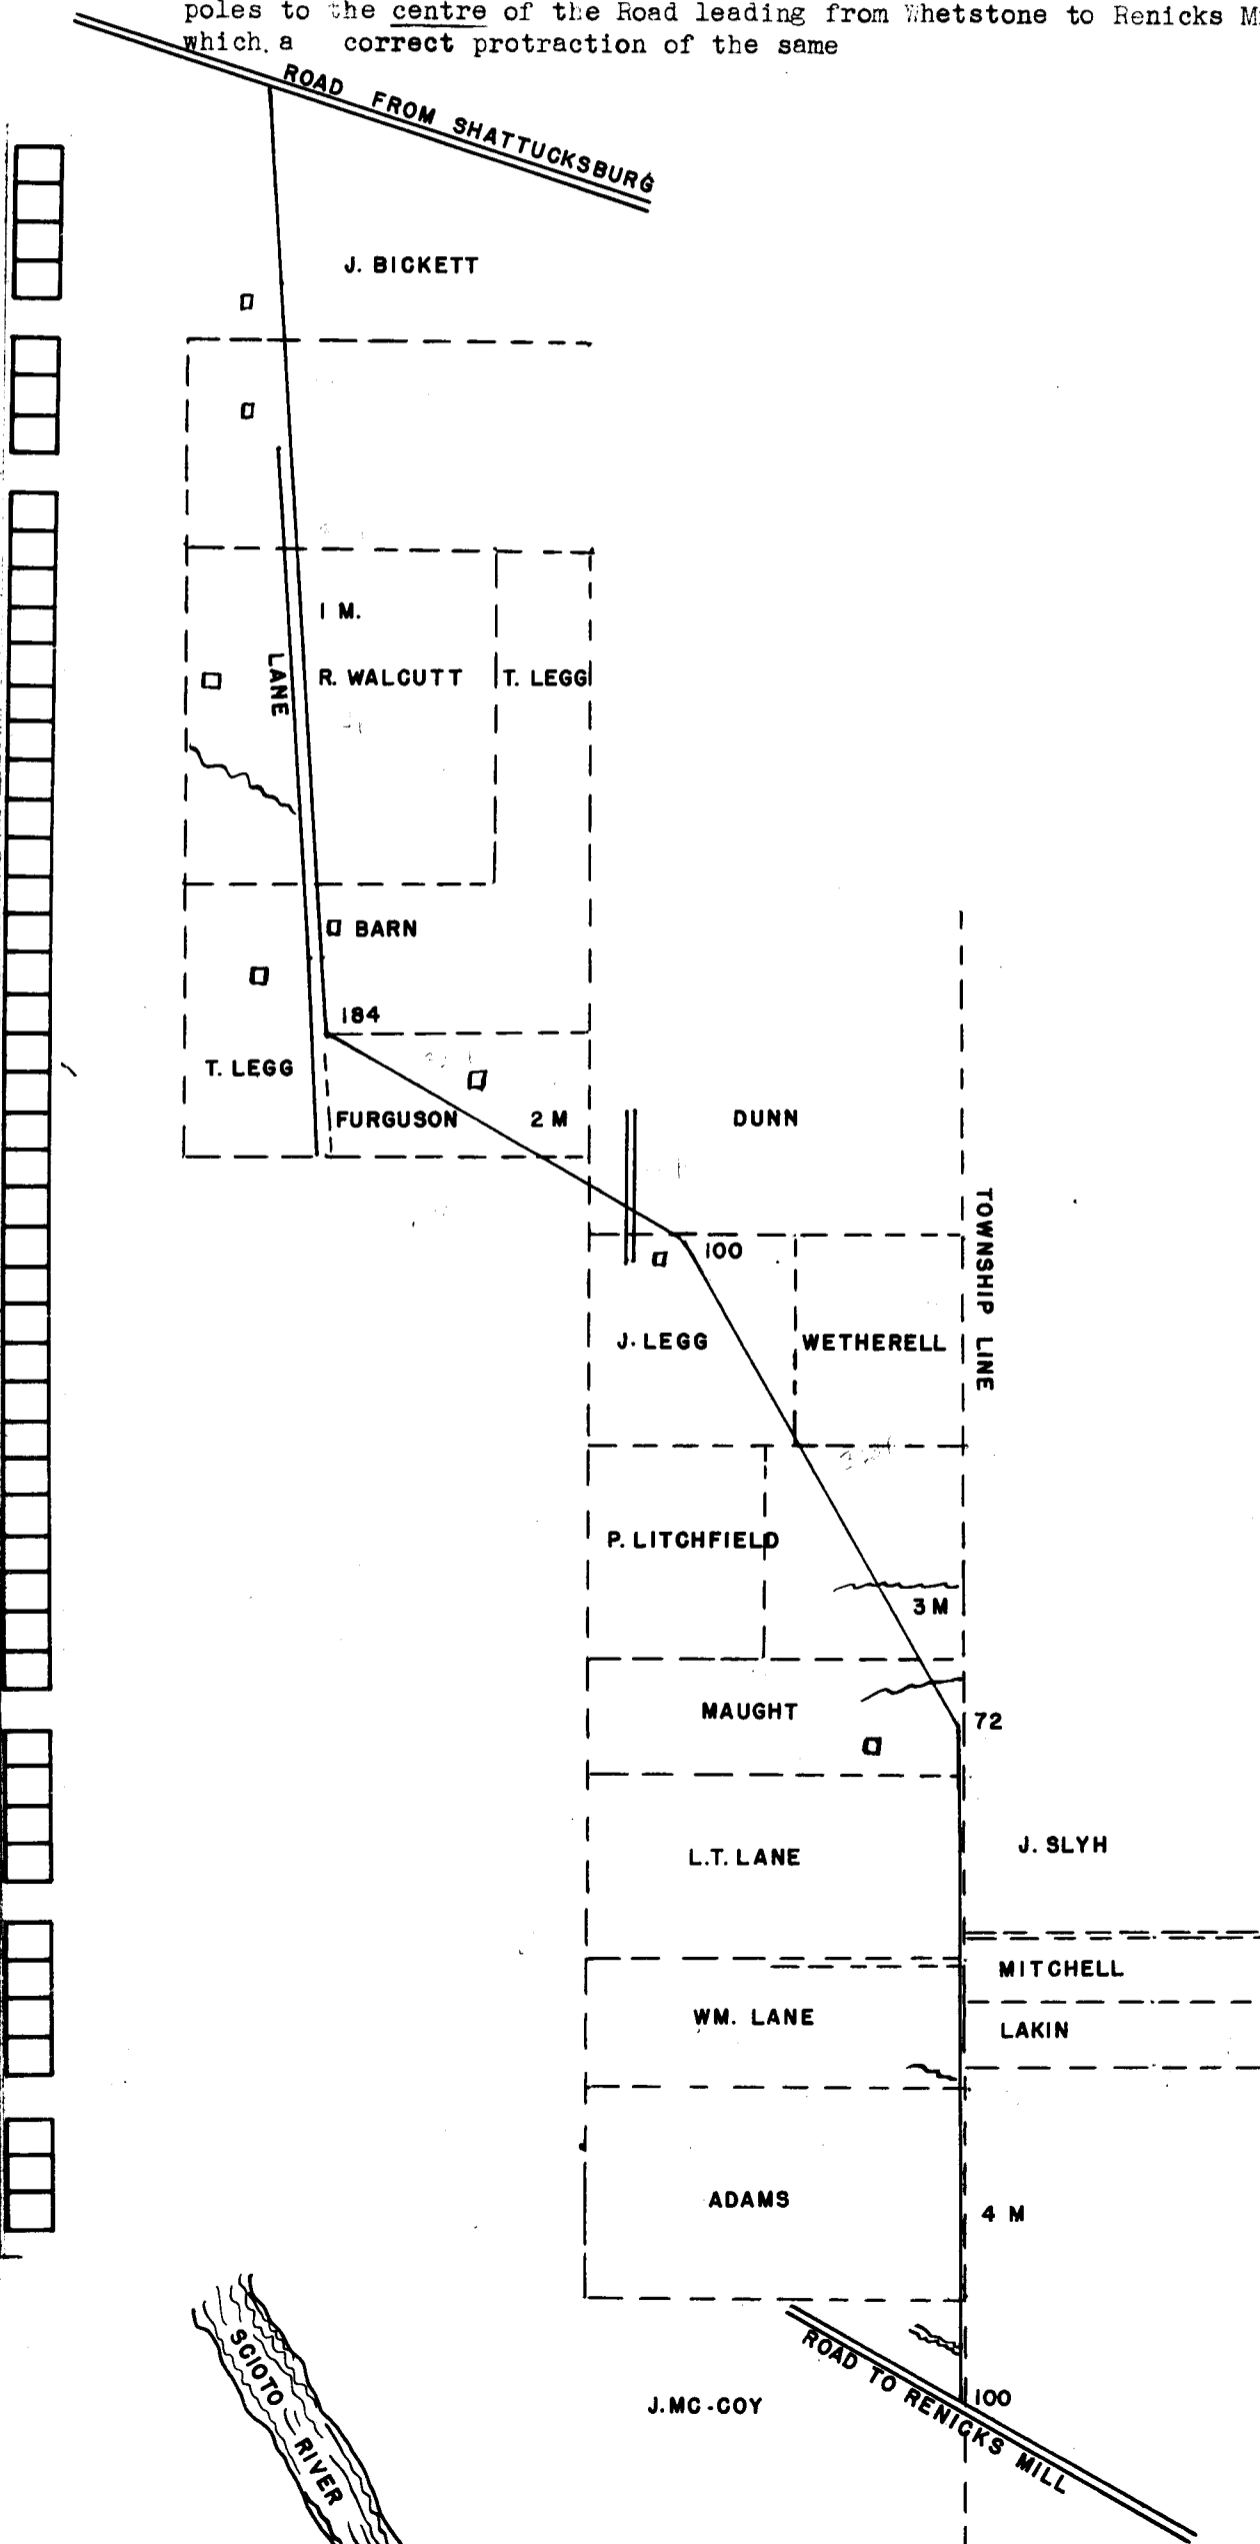

Pursuant to an Order to us directed by the commissioners of Franklin County Ohio, bearing date 1841, for the purpose of viewing a new County road, We the undersigned viewers all three met at the house of Robert Walcutt in Perry Township in said County on the 14 day of December 1841, and after being duly sworn and affirmed according to law. We began at a point on the County road leading from Shattocksburgh to the Scioto River, East and near a large white elm tree; from thence running S. 3 East along the lane of James Bicket and east of his barn, and along the lane of Robert Walcutt and to a point S. E. of Thomas Leggs house, the whole line being five hundred and four poles distance; from thence running S. 52 E. by Robert Ferguson's building place, to a point 3 perches east of John Legg's house being four hundred and twenty poles distance; from thence running S. 30 10' E. to a point in the township line east of Daniel Maughts house, being two hundred and ninety two poles distance; from thence running with said township line S. 0 30' E. to a point in the centre of the county road leading from the Whetstone road to Renicks Mill, being four hundred and forty eight poles distance, and after viewing and reviewing said lines and premises paying due regard to the advantages and disadvantages arising to the lands and premises said road passes through, we are of Opinion that the general route of said road is on a good ground and if confirmed will be of public utility and generally useful.

Reference to the surveyors plat and survey hereunto annexed for said road more particular location, given under our hands this 16th day of December A. D. 1841.

Samuel Kinnear)
Thompson Bull)Viewers
John Smith)

Expenses			
U. Lathrop	Surveyor	4 days	\$6.00
S. Kinnear	Viewers	3 do	3.00
J. Smith	do	3 do	3.00
T. Bull	do	3 do	3.00
John Legg	C. C.	2 do	1.50
Wm Lane	do	2 do	1.50
Henry Walcutt	Mkr.	2 do	1.50
			<hr/>
			\$19.50

And afterwards to wit.

On the 28th day of Feby. 1842. Jacob Slyh filed the following petition of damages.

To the Honorable the Commissioners of Franklin County, Gentlemen,

The undersigned would represent to your honors that he feels himself agrieved and damaged by the laying out of a new county Road petitioned for by Robert Walcutt and others, Commencing on the road leading from Shattocksburgh to scioto River, pray your honors to appoint three disinterested freeholders of said county to examine said road and estimate the damage as in their Opinion the complainant has or will sustain by the establishment of Said Road.

February 28, 1842

Jacob Slyh

On the petition of Jacob Slyh for damage on a new county road petitioned for by Robert Walcutt and others.

Whereupon, The Commissioners of Franklin County appointed Daniel Wright, Asa Davis and John Graham as Viewers of damage, and that they meet at the office of W. T. Martin Esq. in Montgomery township on the 16th day of May 1842 or within five days thereafter and after being duly qualified according to law, Proceed to view so much of said road as passes through the premises of said petitioner, and estimate the damage if any that said petitioner has or will sustain by the establishment of said road, and make report thereon to this board On or before the first monday in the month of June 1842.

Commissioners Office
City of Columbus
March 9, 1842.

Attest
F. Cole Clk to
Commissioners

D. Wright and Asa Davis were duly sworn by me this 9th of May 1842

W. T. Martin Jus Peace

John Graham was duly sworn by me this 16th day of May 1842

John Eberly Jus. Peace

We the undersigned called upon to appraise the damage of Jacob Slyh on a county road petitioned for by Robert Walcutt and others, after being duly qualified according to Law, do allow the said Jacob Slyh Twenty seven dollars fifty cents damage, witness our hand and Seal this 16, day of May 1842.

Daniel Wright)
John Graham)1 day Each
Asa Davis)

The aforesaid damage having been paid by the petitioners and every legal objection being removed, we do declare the aforesaid road a public highway and order the same to be opened and in all respects made according to law, and that notice of this order be given to the Trustees of the Townships through which the same passes

Commissioners Office
City of Columbus
June 10th 1842

Wm W. Kile)Commissioners
Samuel S. Davis) of
John Greenwood)Franklin County

010
0036
1842
254-257
P99c
7
Receiv
003
3180