

COUNTY ROAD ALTERATION OF

ROW = 60' by law

Hayden Run Road - alteration between Dublin Road and Shannon Heights Boulevard

BY ANSON DAVIS & OTHERS

To the Honorable Commissioners of Franklin County,

We the undersigned your petitioners of Franklin County pray for an alteration of a part of the County road from Shattucksburgh westwardly to the County line, Said alteration to commence at the foot of the hill west of Norris Corbins Saw Mill, thence to run Westwardly crossing the run and up the south side on the most suitable ground to intersect said road where it first crosses the run West of O. Bronson's; on granting the above Petition you will much accommodate the Public and your Petitioners and for which your petitioners will ever pray. Oct. 27, 1841. Anson Davis, Robert Armistead, Orange Davis, Saml Davis Jr. Wm Sells, Giles Weaver Benjamin Sells, John Britton, N. F. Britton, Benjamin Britton, George Davis, Samuel Davis, Nathan Wilcox, Pelatia Avery, James Davis, Charles Judson, W. Armistead.

On the petition of Anson Davis and others for an alteration of a part of the County Road from Shattucksburgh westwardly to the County line, Said alteration to commence at the foot of the hill west of Norris Corbin's Saw mill; thence to run westwardly crossing the run and up the south side of the most suitable ground to intersect said road where it crosses the run west of O. Bronsons.

Whereupon the Commissioners of Franklin County appointed Henry McCracken, Warren Frazell, and Cornelius Crum as Viewers, and Uriah Lathrop as Surveyor and that they meet at the Office of Miskel Saunders Esq. in Norwich township on the 19th day of February 1842, or within five days thereafter, and after being duly qualified according to law proceed to view, Survey, mark and locate said road and a true Plat and Survey thereof along with their report return to this Office on or before the first Monday in the month of March 1842

Commissioners Office
City of Columbus
Dec. 8, 1841.


Attest.
F. Cole
Clk. to Commissioners

State of Ohio Franklin County S S

This day the 19, Feby. 1842 came Henry McCracken, Warren Frazell and Cornelius Crum Viewers, in the above order and were qualified in due form of Law. Given under my hand and seal the day and year aforesaid

Miskell Saunders
Justice of the Peace

In accordance with the annexed Order I proceeded on the 19th day of February 1842, to Survey and mark an alteration of the County road leading from Shattucksburgh west to the County line, Beginning at a Stake near the foot of the hill west of Norris Corbin's Saw Mill on Hayden's Run so called in the present road, and run with the present travelled road S. 81 W. 10 poles to a White Walnut Stump; thence S. 53-1/2 W. 26 poles crossing Hayden's run at 4 poles to a beech; thence S. 73-1/4 W. 52 poles to a Stake on the brow of the hill, thence S. 71-1/2 W. 38 poles to the centre of the run and the present road as previously located, Whole distance 126 poles as represented on the annexed plat by the red lines the course of the black lines represents the old road as near as could be determined by the marks yet remaining The whole distance of the Old line being 126 poles 7 links

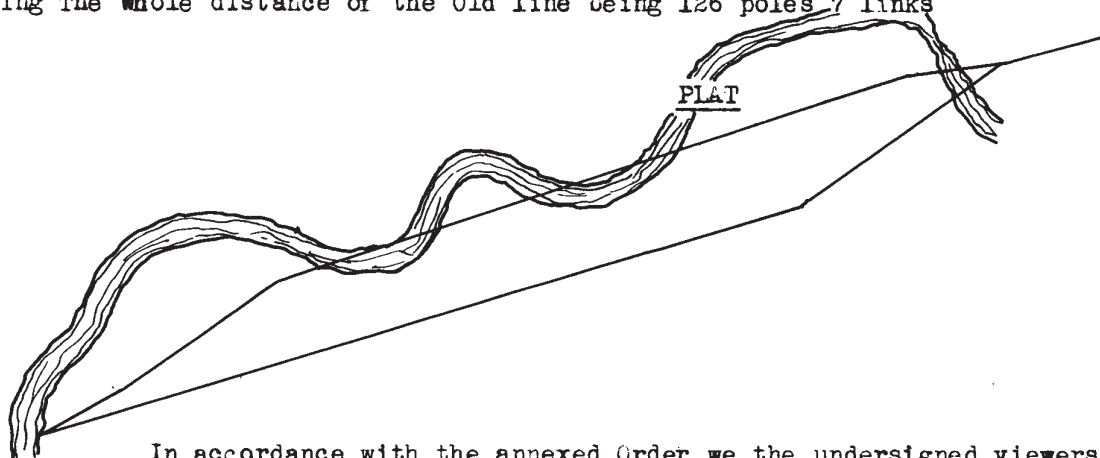

In accordance with the annexed Order we the undersigned viewers therein named, having been duly qualified according to law, proceeded on the 19th day of February 1842 to run and locate an alteration of the County road from Shattucksburgh to the County line, Commencing at or near the foot of the hill west of Norris Corbin's Saw Mill on Hayden's Run so called, in the centre of the present travelled road, thence S 81 W 10 poles with the present road, thence S. 53-1/2 W. 26 poles crossing Run at 4 poles, thence S. 73-1/4 W. 52 poles; thence S. 71-1/2 W. 38 poles to the intersection of Haydens Run and the present county road, And also having viewed the ground on which the present road is located from the commencement to the termination of the above alteration as will more fully appear by reference to the field notes and Plat of the Surveyor which are herewith returned, and after having Considered the advantages and disadvantages likely to result from such alteration, are of the Opinion that it would Conduce to the Public Convenience to alter said road and also that the ground of the new road is such as will admit of the construction of a good road or much better than the Old one, We therefore report in favor of said alteration, Given under our hands this 19th day of Feby. 1842.

Henry McCracken)
Warren Frazell)Viewers
Cornelius Crum)

Expenses

Henry McCracken	Viewers	2 days	\$2.00
Warren Frazell	do	2 "	2.00
Cornelius Crum	do	2 "	2.00
U. Lathrop	Surveyor	2 "	3.00
Anson Davis	C. C.	2 "	1.50
Robert Armistead	C. C.	2 "	1.50
George McCracken	Mkr.	2 "	1.50
			<u>\$13.50</u>

No objections appearing it is ordered by the Commissioners of Franklin County that the foregoing alteration be henceforth of record, that the same be opened and made in all respects according to law, and that notice of this order be given to the Trustees of the Township through which the same Passes.

Commissioners Office
City of Columbus
June 10th 1842.

Wm W. Kile)
Samuel S. Davis)Commiss-
John Greenwood)ioners of
County Franklin
County

010
0010
1842
262-263
Page
Road Record
7
003
1850