

Alkire Road - from Harrisburg Pike to Norton Road South (now vacated)

COUNTY ROAD.
BY
CHARLES HARRISON & OTHERS

ROW = 60' by law

To the Hon. the Commissioners of Franklin County, Gentlemen,

We the undersigned Citizens and residents of said County, respectfully represent that we believe the Public interest and convenience requires the location of a new County road. Beginning at or near Emanuel Alkires dwelling house in Franklin township, thence running West along said Alkires' fence to Patrick Easter's land, thence to Thomas Hammer's dwelling house, thence to the North east corner of Gilmores survey, thence on the line of said survey to the Georgesville road, and your Petitioners as in duty bound will ever Pray ect. Charles Harrison, Jonah Corson, Geo. W. Alkire, John Alkire, Jesse Alkire, James Alkire, John W. Alkire, Edwd. McMechen, John Harper, Thomas Hammer, Edward Marsh, George W. Chambers, Jacob Neff, G. Demorest, Richard Haines, Mahlon Peters, James Haines, Michael Reinhard, Benjamin Holt, Aaron Peters, Eli Peters, Francis Harper, Thomas Frizzell, Peter Putman, Alexander White, W. P. Mench, E. Gares, Moses Marsh, Claton Harper, Patrick Easter.

On the petition of Charles Harrison and others for a new County Road, To commence at or near Emanuel Alkire's dwelling house in Franklin township, thence running West from along said Alkire's fence to Patrick Easter's land, thence to Thomas Hammer's dwelling house, thence to the Northeast corner of Gilmore's Survey, thence on the line of Said Survey to the Georgesville Road.

Whereupon the Commissioners of Franklin County appointed William Miller, George Hoover and William White Viewers, and Uriah Lathrop Surveyor, and that they meet at the Office of Adam Alkire Esq. in Franklin township on the 29th day of March 1842 Or within five days thereafter and after being duly qualified according to law, proceed to view, survey, mark and locate said road as the law directs, and a true plat and survey thereof along with their report return to this Office on or before the first Monday in June 1842.

Commissioners Office
City of Columbus
March 9th 1842.

Att.
F. Cole Clk to Commissioners

State of Ohio Franklin County,

This day came William White and George Hoover and were duly qualified according to law.

April the 1st 1842.

A. Alkire J. P.

In accordance with the annexed order, I proceeded under the direction of George Hoover and William White to survey and mark a County Road, Beginning at an Ash Stump, South of Emanuel Alkire's house at the present road, and run N. 40 W. 17 poles, thence along said Alkire's fence S. 66 W. 48 poles, S. 62 W. 54 poles, S. 83 W. 29 poles, N. 82 W. 44 poles to two White Oaks, Corner to G. W. & E. Alkires and in the line of Patrick Easter's land, thence N. 70 W. 74 poles to George Wittaman's N. E. Corner, in the East line of Kirkpatrick's survey thence along Said Wittamans line- West 52 poles to 1 Mile Stake, thence continued West 28 poles to his N. W. Corner, thence S. 63 W. 264 poles to a Stone planted as Gregory Z. McKin corner in T. Hammers East line, thence West 28 poles to 2 Mile Post, thence continued West passing Hammer's dwelling at 30 poles 40 poles to a small Jack Oak, thence S. 45 W. 51 poles to a stake at Gilmore's corner, thence West along Gilmore's line 227 poles to a Cotton Wood

PLAT.


3 Mile Station, Continue West 192 poles.

GILMORES CORNERS
poles to the Georgesville Road, Whole distance 3 Miles and 192 poles.

April 4th 1842.

T. HAMMER □

U. Lathrop Surveyor.

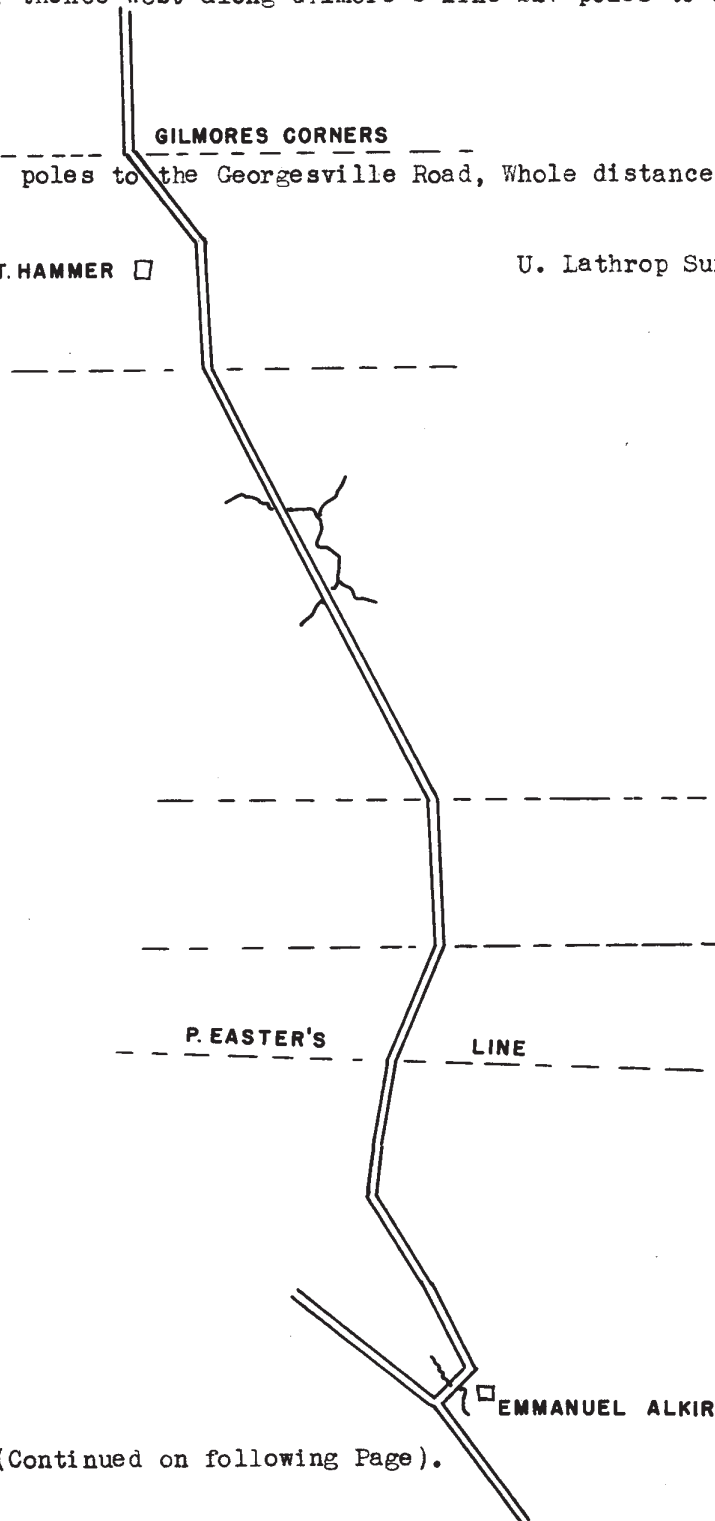

(Continued on following Page).

Continued from preceding page.

In accordance with the annexed order we the undersigned, two of the Viewers therein named, having been duly qualified according to law, proceeded to view, Survey and mark a County road as therein directed, Beginning at a point in front of Emanuel Alkires dwelling house, in the present travelled Road, and running N. 40 W. 17 poles to a point West of said Alkire's, thence along the fence Westward according to the Order to Said Alkires S. W. Corner and in the line of Patrick Easter, thence N. 70 W. 74 poles to George Wittamans N. E. Corner, thence West with his line 52 poles to 1 Mile Post, thence continued West, 28 poles to said Wittaman's N. W. Corner, thence S. 63 W. 264 poles to a Stone planted as a Corner to Gregory McKinn in T. Hammer's East line, thence West 28 poles to 2 Mile post, thence continued West 40 poles to a small Jack Oak passing T. Hammers dwelling house at 30 poles, thence S. 45 W. 57 poles to Gilmores N. E. Corner in the West line of Kirkpatrick's survey, thence West 229 poles to a Cotton Wood 3 Mile tree, thence continued West One hundred and ninety two Poles to the Georgesville Road, Making the whole distance of three miles and One hundred and ninety two Poles, as is represented by the field notes and Plat of the survey which is herewith returned.

After having Considered all of the advantages and disadvantages likely to result from the location of said road, we are of the opinion that it would add greatly to the convenience of all those owning land through which said road passes, and that the ground is such as will admit of the construction of a good and permanent road, We therefore beg leave to report in favor of said road.

George Hoover) Viewers
William White)

Expenses.

George Hoover	Viewers	3 days	\$3.00
Wm. White	do	2 do	2.00
U. Lathrop	Surveyor	4 do	6.00
E. Alkire	Marker	2 do	1.50
W. Burton	C. C.	2 do	1.50
Geo. Alkire	C. C.	2 do	1.50
			<u>\$15.50</u>

No legal objections having been made, it is ordered by the Commissioners of Franklin County that the foregoing road be henceforth of Record and that the same be opened and made in all respects according to law, and that notice of this order be given to the trustees of the township through which the same Passes.

Commissioners Office
City of Columbus,
Dec. 7th 1842.

Wm. W. Kile) Commiss-
Samuel S. Davis) ioners of
John Greenwood) Franklin
County.

010

0020

1842

872-268

269-271

1842

0010

010