

287 West line Franklin Township, Resurvey of

To the Honorable the Commissioners of Franklin County,  
Gentlemen,

We the undersigned would respectfully represent that the line dividing the townships of Franklin and Prairie from the lapse of time it was run has become so obscure that it cannot be found, and we would further represent, that from an alteration in the South line of of Norwich Township the N.W. Corner of Franklin which should be in said line is entirely cut off, and we would further say that amongst other difficulties resulting from said line not being known it creates a great deal of difficulty in the road districts binding on said line, the Supervisors not knowing the boundaries of their respective districts, we therefore pray that you will order a resurvey of the line aforesaid, and we will as in duty bound ever pray &c.

Dec. 11. 1842.

Jacob Keller, John Blankner, Ezekiel Keller, John Steiner,  
John Grumbarger, Matthew Scorspar, Andrew Blankner, George M'Lane,  
Peter Blue, William Wilcox, Hiram Keller, James Graham,  
S. D. Clarke.

Alphabetic


In pursuance to an Order of the Commissioners of Franklin County, made at their March Session A. D. 1843. I proceeded on the 27<sup>th</sup> day of May 1843. to Resurvey and mark the line dividing the townships of Franklin and Prairie, as follows: Beginning at the Northwest corner of Jackson township in the East line of John Foster's Survey N<sup>o</sup>. 1462 at a post from which an ash 10 inches in diameter bears west 10 links and an elm 8 inches in diameter bears N. 60° W. 8 links, and a hickory 10 inches in diameter bears N. 61° E. 37 links, and run thence with the east line of said Survey N. 1° 24' W. passing run at 78, corner of Survey N<sup>o</sup>. 1389 at 87. run at 128, following Georgesville Road from 140 to 184, run at 202, at 218, at 256, and northeast corner to said Foster's Survey at 256 1/2, 320 poles to 1 Mile Stake in Jacob Neff's field; continued same course crossing Scioto big run at 10, 320 poles to an ash 2 mile tree, continued same course crossing old State Road at 7, National Road at 120, about 1 pole east of the 6 mile stone on said road, run at 137, 320 poles to a white Oak 3 mile tree, thence continued same course crossing large run at 97, at 156, north line of Survey N<sup>o</sup>. 1482, at 191, South line of Survey N<sup>o</sup>. 3316 at 208, and run at 272, 320 poles to a hickory 4 mile tree, thence continued same course crossing run at 20, at 117, at 168, 196 poles to the South line of Norwich township, where I planted a stone, from which a beech marked F. T. bears S. 17° distant 69 links, and a beech marked P. T. bears S. 67° W. distant 53 links, and a beech marked N. T. bears S. 89° W. distant 28 links which point is 110 poles S. 75° W. from the Southwest corner of Survey N<sup>o</sup>. 544.

May 29<sup>th</sup> 1843.

John Graham Surveyor &c.

Corner to  
N<sup>o</sup> 544


Norwich Township Line

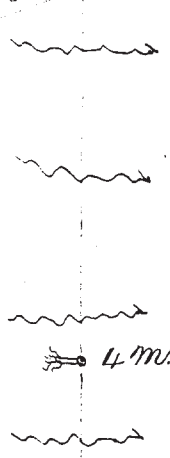

4 m. d.

South line N<sup>o</sup> 3316

North line N<sup>o</sup> 1482

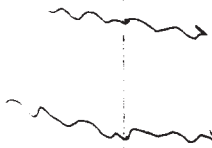

3 m. d.

National Road

Old State Road  
2 m. d.

Jacob Neffs  
Imm

1 m. d.

corner of N<sup>o</sup> 1462



Georgetown

Corner N<sup>o</sup> 1389

Franklin & P. line