

Cleveland Avenue - from Ferris Road to Hanawalt Road
Hanawalt Road - from Cleveland Avenue to the County line

COUNTY ROAD
by
SAMUEL BURWELL AND OTHERS.

ROW = 60' by law

To the Honorable the Commissioners of Franklin County Ohio. Gent.

The petition of the undersigned freeholders of said Franklin County humbly share with, that it will greatly subserve the public interest and Convenience to lay out and establish a County road in said County as follows, to Wit. Beginning On the line between the township of Mifflin and Clinton in Said County about eighty rods from the dwelling of Mr. Samuel Burwell in Mifflin Township, thence North on Said line to the Corner of Mifflin, Clinton, Sharon and Blendon townships, thence On the line (as nearly as practicable) between Sharon and Blendon townships, to Allum Creek. Thence On the west bank of Allum Creek to the County line of Delaware and Franklin Counties.

We therefore respectfully but earnestly solicit your Honorable body at your next session to appoint a Surveyor and viewers to lay out and establish said road according to the prayer of your Said petitioners as in duty bound will ever pray. March 28th 1842. Samuel Burwell, William Simmons, Walter Field, Wm. A. Morse, Peter Hickman, Lester Case, Frederick Raner, John Baker, David Carpenter, Samuel Hickman, James Hickman, John Field, John A. Ladd, George Hoover, William Westervelt Jrnr. Wm. Westervelt, Alexander Conklon. Peter P. Lawson, James Lawson, Gilbert B. Jaycock, A. S. Jaycock, Thomas Gill, Samuel Parks, Artemas Cutler, J. W. Copeland, Elisha Holt Jun. David Goodwin, James R. Tucker, Levi Thompson, Conrad Bears, D. W. Deshler, Robert Innis, Cornelius Sharp, J. Pegg, John Baker, Moses Beers, John D. Coe, Christopher Robins, Henry Innis, Harvey Coe, Zenus Jackson, A. J. Field, Sylvanus Budd, Jonathan Park, C. E. Burr, Potter Wright,

On the petition of Samuel Burwell and others for a new County Road, Commencing on the line between the townships of Mifflin and Clinton about eighty rods from the dwelling of Samuel Burwell, in Mifflin Township, thence North on said line to the corner of Mifflin, Clinton, Sharon and Blendon Townships, thence on the line as nearly as practicable between the townships of Sharon and Blendon to Allum Creek, thence On the West Bank of Allum Creek to the County line of Delaware and Franklin Counties.

Whereupon the Commissioners of Franklin County appointed William Sells, Daniel Wright and Elisha Hays as viewers, and Uriah Lathrop as surveyor, and that they meet at the Office of Joseph Pegg Esq. in the township of Clinton On the 5th day of September 1842. or within five days thereafter, and after being duly qualified according to Law, proceed to view, survey, mark and locate said road, and a true plat and survey thereof along with their report return to this Office On or before the first Monday in the Month of December 1842.

Commissioners Office,
City of Columbus,
June 14th 1842

Att. DELAWARE CO. LINE
F. Cole Clerk to
Commissioners.

Franklin County State of Ohio S. S.

Personally appeared before me Joseph Pegg a Justice of the Peace of said County Daniel Wright, Elisha Hays, and William Sells, and were duly sworn to perform the duties of the within Order- and Gilbert Morris and Alexander J. Gear were also sworn as Chain Carriers, and Wm. A. Morse were sworn as Marker. September 5th 1842.

J. Pegg J. P.

In accordance with an Order from the Commissioners of Franklin County, hereunto attached, I proceeded on the fifth day of Sept. 1842 to Survey and mark a County Road therein named.

Beginning at a Stake in the East line of Clinton township and in the center of the old Harbour road so called and run North 320 poles to 1st mile stake at a beech, crossing branch at 20.90 and 100 p. the corner of Clinton, Mifflin, Blendon and Sharon at 222 poles, On 2nd mile crossing branch at 76 poles 320 p. to 2nd Mile Stake at a White Ash, On 3rd Mile crossing Worthington and Granville road at 164 poles 320 poles to 3rd Mile Stake, at a Marked beech, On 4th Mile 270 poles to a Beech, Thence N. 45 1/2 W. 10. 32 poles, N. 60 W. 7. 32, N. 38 W. 6. 50, N. 13 E. 6. N. 85 E. 12, N. 21 E. 8 poles to 4 mile stake, thence N. 21 E. 4 poles to a stake in township line, thence North Crossing County road at 92 poles, run at 238 320 poles 5 Mile Stake, On the 6th mile come into old road at 20 poles, thence with the old road North 128 poles to a stake in the levy bank near Allum Creek, thence N. 25 W. 55 poles N. 34 1/2 W. 26 1/2 poles N. 27 W. 20 poles N. 22 W. 43 poles to a stake in Delaware County line at two Lym, whole distance five miles and 272 1/2 poles as represented by the annexed plat which is a correct protraction of the same--

FLAT.

ROAD TO GRANVILLE


Sept 8th 1842.

U. Lathrop S. F. C.

FEEES AND EXPENSES.

William Sells	Viewers	2 days	\$ 2.00
Daniel Wright	do	" do	2.00
Elisha Hays	do	" do	2.00
Uriah Lathrop	Surveyor	4 do	6.00
Alex. J. Gear	C. C.	2 do	1.50
Gilbert Morse	C. C.	" do	1.50
W. A. Morse	Marker	" do	1.50
			<u>\$16.50</u>

In accordance with the annexed order from the Commissioners of Franklin County, We the undersigned viewers therein named, after having been duly qualified according to law, proceeded On the 5th day of Sept. 1842 to view survey and mark a County Road therein named, Beginning at a stake in the east line of Clinton township and in the

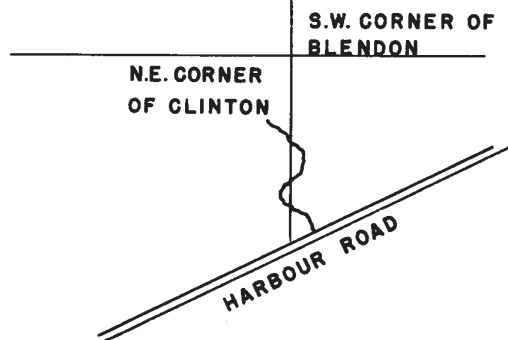

010
0010
1843
294-297
Page
Road Record
7
0031
0070

Continued from preceeding page.

center of the Old Harbour Road so called, and run North with the township line three miles and two hundred and seventy poles to a point On the high bank On the south of a large revene, and run then westwardly and along the best ground the high bluff and intersecting the township line again north of the run and thence with the township line- Five miles and one hundred and twenty eight poles, passing west of Mr. Baldwin's barn to a stake in the levy bank near Allum Creek, thence N. 25 W. 55 p. thence N 34 1/2 W. along the bank of the Creek 26 1/2 poles, thence N. 27 W. 20 p. thence N. 22 W. 43 poles to a stake at two Lyms in the line of Delaware County, as is more fully represented by the plat and field notes of the surveyor which is herewith returned and made a part of this Report. And we do further report, that after Considering all the advantages and disadvantages likely to result from the establishing said road as surveyed, we are of the Opinion that all them owning land on the line of the road as well as the public at large would be materially benefited while it would operate to the serious disadvantage of no One We therefore report in favor of said Road.

Daniel Wright)
Elisha Hays)Viewers
Wm. Sells)

To the Commissioners of Franklin County, Gentlemen,

Your petitioner represents that he feels himself aggrieved by the location of a County road as surveyed on the petition of Saml. Burwell and Others, he therefore prays your honorable body to appoint men to assess the damage if any he may sustain by the establishment of said road, and your petitioner as in duty bound will ever pray-

March 6th 1843.

Peter Westervelt.

On the petition of Peter Westervelt for damages on a New County Road as petitioned for by Samuel Burwell and Others, Whereupon, The Commissioners of Franklin County appointed Samuel Barr Senr. David Nelson, and Dennis Ferris as viewers of Damage and that they meet at the Office of H. M. Phelps Esq. in the township of Blendon On the 25th day of May A. D. 1843 or within five days thereafter, and after being duly qualified according to law, proceed to view so much of said road as passes through the premises of said petitioner and estimate the damage if any he may sustain by the establishment of said road and make report thereof to this Office on Or before the first Monday in the month of June A. D. 1843.

Commissioners Office
City of Columbus
March 7. 1843

Att.
F. Cole Clerk to
Commissioners

This is to Certify that Samuel Barr Senr. David Nelson and Dennis Ferris were severally sworn according to law by me before they proceeded to their duties as above directed.

H. M. Phelps Justice Peace.

To the Commissioners of Franklin County. Gentlemen,

Agreeably to your Order to us directed on a petition of Peter Westervelt for damage On a new County road as petitioned for by Samuel Burwell and others, We proceeded on the 25th day of May 1843 to view so much of said road as passes through the premises of said petitioner, and we now report that in our Opinion the said Peter Westervelt will sustain a damage of Twenty five dollars by the opening of said Road.

Fees

Samuel Barr	2 days	\$2.00	Samuel Barr)Viewers
David Nelson	do	2.00	David Nelson) of
Dennis Ferris	do	2.00	Dennis Ferris)Damage

In Consequence of the foregoing assessment of damage having been paid by the petitioners, and no other Objection appearing, it is ordered by the Commissioners of Franklin County that the foregoing road be henceforth of record, and that the same be opened and made in all respects according to Law, and that notice of this Order be given to the Trustees of the Townships through which the same may pass.

Commissioners Office
Columbus
Dec 6th 1843.

Wm. W. Kile)Commissioners
John Greenwood) of
Samuel S. Davis)Franklin County

010
0020
1843
294-297
Page
7
Record
0100
010