

01110
003
Road Record
7
Page 307-308
1844
0020
0565

ROAD RECORD NO. 7

ROAD RECORD NO. 7

PAGE NO. 309

Tuttle Road - from Wilcox Road to Dublin Road

COUNTY ROAD
by
AZOR TUTTLE & OTHERS

ROW is not stated

On the petition of Azor Tuttle and others for a new County Road Commencing at the road on the west side of the Scioto River in Washington Township on the line between Hanford Seymour and Beriah Davis, thence with their line Westwardly and with the south line of E Sells, Azor Tuttle, Lawson Dulin, Charles Judson, and to intersect the County road that leads from the post road to the Hayden Run Road.

Whereupon, the Commissioners of Franklin County appointed William Sells, Mathew Rose, and Henry Coffman as Viewers, and Uriah Lathrop as surveyor, and that they meet at the Office of Henry Coffman Esq. in Washington Township on the 10th day of August 1843 or within five days thereafter, and after being duly qualified according to law, proceed to view, survey, mark and locate said road according to law and a true plat thereof along with their Report return to this Office on or before the first Monday

(Continued on next Page)

Continued from preceding page.

in the month of December 1843.

Commissioners Office
City of Columbus
June 5th 1843.

Attest.
F. Cole Clerk to
Commissioners

Washington Township Franklin County Ohio S. S.

Personally appeared before me John Eberly a Justice of the Peace in and for said Township the within named Viewers and surveyor and were duly sworn faithfully to discharge their duties as view-ers and surveyor according to law and the and the best of their ability- Dublin August 10th 1843


John Eberly J. P.

To the Hon. the Commissioners of Franklin County Gentlemen,

The undersigned petitioners freeholders and residents of Franklin County respectfully represent, that the interest and convenience of the Public require the establishment of a new County Road. To commence at the road on the West side of the Scioto River in Washington Township On the line between Hanford Seymour and Beriah Davis thence with their line Westwardly and with the south line of E Sells, Azor Tuttle, Lawson Dulin, Charles Judson and to intersect the County road that leads from the post to the Hayden run road, Your petitioners therefore pray your Honorable body to take the proper and legal steps to cause the establishment of said road, and as in duty bound will ever pray ect. Azor Tuttle, Lawson Dulin, Charles Judson, Ira Babcock, Zephaniah Rogers, John Kellar, Moses Davis, Noah Smith, Asa Wilcox, pr. order John Watts, James Sandy, James Davis, Samuel Davis Junr. Henry T. Seymour, Beriah Davis.

In accordance with the annexed Order I proceeded on the 10th day of August 1843 to survey and mark a County Road therein named. Beginning at the Columbus and Dublin road and Run S. 77 15' W. passing corners of Seymour, Sells, Tuttle and Dulin 320 poles to first mile post. thence Continued Same Course 160 poles to a Maple and Beech and Oak (oak down) thence S. 69 W. 123 poles to the Hayden Run Road at 4 hickories, Making the whole distance One mile and One hundred and twenty three poles as represented by the annexed plat of survey- August 12th 1843.

U. Lathrop Surveyor

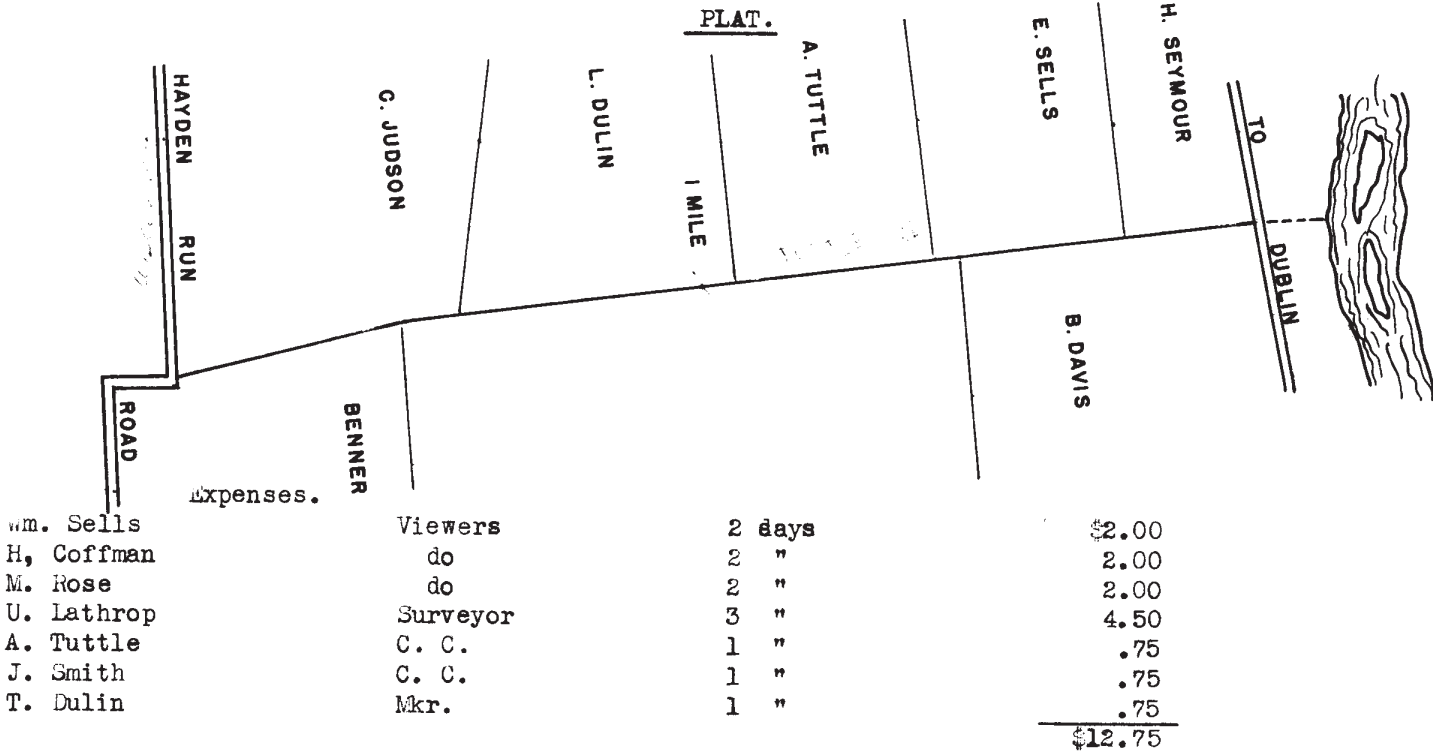

In accordance with the annexed order we the undersigned Viewers therein named after having been duly sworn proceeded on the 10th day of August to view survey mark and locate a County road therein named, Beginning at the center of the Columbus and Dublin road on the line between Hanford Seymour and Beriah Davis and thence S. 77 1/4 W. along said line and the line of E. Sells and A. Tuttle 320 poles to 1st Mile Stake, thence Continued same Course 160 poles to an Oak, Maple, and beech Corner to Benner's survey, thence S. 69 W. 123 poles to three Hickorys and a box Elder corner to Gilliams Survey No. 3011. to the County road running to Hayden run, and after having considered all the advantages and disadvantages likely to result from the location of said road, we are of the opinion that no one would be in any way injured but that it would be of great benefit to all those Owning land on the line of said road and to the public at large, we do therefore report in favor of said road as represented by the Plat of the surveyor herewith returned. dated Augt. 11. 1843

Wm. Sells)
Mathew Rose)Viewers
Henry Coffman)

No objections appearing, it is ordered by the Commissioners that the foregoing Road be henceforth a public highway, that the same be opened and made in all respects according to Law, and that notice of this order be given to the Trustees of the Township through which it passes-

Commissioners Office
Columbus
March 6. 1844

Wm. W. Kile)Commissioners
Samuel S. Davis)of Franklin
John Greenwood) County