



Continued from preceeding page.

Agreeably to an Order of the Commissioners of Franklin County, upon the petition of Orlando Case and others for a new County road. Chauncey Cook, Samuel Kinnear and William Skeels were appointed viewers to locate said road, and Homer Tuller Surveyor, Levi Pinney and Hiram Andrus were taken as Chain Carriers and William Smiley as Marker. After being duly Sworn by One of the viewers, we proceeded to run and mark said road according to the direction of the viewers. Beginning at a Stake at the point where the County road running from George Snoffer's to Humphrey's Settlement Crosses the north line of Orlando Case's land in Perry township, and running S. 88 50' E. on the said Case's north line and the north line of land owned by E. Hard One mile to a Stake, making 1 Mile, and continued the same course 27 1/2 poles to an angle post, thence S. 59 E. 18 1/2 poles to a Stake, thence S. 88 E. 37 poles to a Stake thence N. 87 30' E. 70 poles to the county road east of J. N. Case's house, thence South along said County road 10 poles thence S 83 E. 12 poles to the Clantange River, the whole distance being One mile and one hundred and seventy five poles.

I annex herewith a plat of Said Road. February 15th 1845.

Homer Tuller Surveyor.

expenses.

Chauncey Cook	Viewer	2 days	\$ 2.00
Samuel Kinnear	do	2 do	2.00
William Skeels	do	2 do	2.00
Homer Tuller	Surveyor	2 do	3.00
Levi Pinney	C. C.	1 do	.75
Hiram Andrus	do do	1 do	.75
William Smiley	Mkr.	1 do	.75
			<hr/> \$11.25


Pursuant to an Order to us directed by the Commissioners of Franklin County, We all three met on the 15th day of February A. D. 1845, at a point where the County road running from George Snoffer's to Humphrey's Settlement crosses the north line of Orlando Cases land in Perry township in Said County agreeable to the prayer of the above order, and after being duly sworn according to law, we proceeded to view, review and examine the rout of a certain road as prayed for in the above order, and we took to our assistance Homer Tuller as surveyor, Levi Pinney and Hiram Andrus as Chain Carriers, and William Smiley as marker, who was also duly sworn, and after viewing and examining said rout, paying due regard to lands premises and individual's through and by which said road passes, as run, Consider it to be practicable and on good ground and in our Opinion if confirmed will be of public utility, and we are of opinion that fifty feet would be as wide as necessary for Said road, Reference to the courses, distance, Mile trees, location and whole distance, beginning and termination- we refer you to the plat of said road as surveyed protracted and hereunto annexed by said Surveyor.

Chauncey Cook )  
 Samuel Kinnear )Viewers  
 William H. Skeels)

No objections having been made, and being satisfied that the foregoing road will be of public utility, we the Commissioners of Franklin County do establish the same a public highway, and order the said road to be opened fifty feet wide, and made in all respects according to law, and that notice of this Order be given to the trustees of the proper Townships.

Commissioners Office  
 Columbus,  
 June 4th 1845

John Greenwood )Commissioners  
 Wm. W. Kile )of Franklin  
 Samuel S. Davis ) County

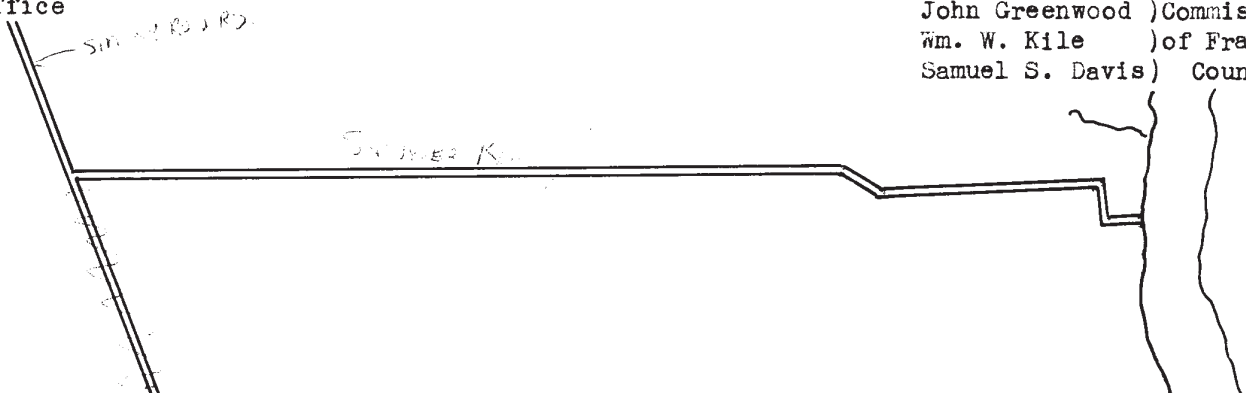

3660

003

ROAD RECEIVED

PAGE 325-327

RECEIVED 1845