

010  
0020  
1845  
328-329  
P992  
332-336  
5  
0010  
010

ROAD RECORD NO. 7

ROAD RECORD NO. 7

PAGE NO. 332

Feder Road - from Amity Road to Hilliard & Rome Road East  
Fisher Road - from Hilliard & Rome Road East to McKinley Avenue  
Includes Old Fisher Road

COUNTY ROAD  
by  
ISRAEL BROWN AND OTHERS.

ROW - 40'

To the Commissioners of Franklin County. Gentlemen.

We the undersigned Citizens of Franklin County do respectfully petition your Honorable body for the location of a County Road as follows. Beginning in the road leading from Columbus to Dublin at the division line between the leases of King and Layman on the Trabue tract, and running thence on a direct line as near as practicable to the County Road leading from Georgesville to Renicks Mill near George Skidmores house, thence with Said Georgesville road to the west line of Wm. Wilsons Survey No. 875, thence with the west line of said Wilsons Survey Northwardly to the Southeast Corner of James Galloways Survey No. 7325, thence with the South line of Said Survey and with the North line of A. Singletons Survey No. 1484 to the Northwest corner thereof, thence with the west line of Said Survey No. 1484 South to the line dividing the lands of Thomas O Harra and Ezekial Kellar, thence with said line and Continuing the Course thereof to the east line of G. Galloways Survey No. 6636, thence on a direct line or as near so as practicable to the mouth of Wm. Browns lane, thence following the rout of a County Road petitioned for by Wm. Brown and others Westwardly to the South east Corner of Wm. Darks Survey No. 1046, thence with the Course ( or nearly So ) of the last mentioned line to the Amity Road. Israel Brown, Joseph O Harra, T. W. Crabb, D. G. Vanschoyck, William Walker, Daniel Teters, Josia Carter, Samuel Clover, H. A. Riggs, Wm. W. Richards, Evan Jones, David Edwards, James Huggett, S. G. Rowland, Gabriel Postle, Edmond Jones, Henry Clover, Joseph Gray, Willis Widner, Wm. Brown, Wm. Clover, Reuben Golliday, Alexander Hopper, Franklin Foss, Jno. E. Wane, M. B. Stiarwalt, Samuel Callagher, Wm. Kain, Geo. Wilcox, Thomas T. Kain, Jacob Kellar, Isaac Spindler, Solomon Blinker, John Koerner, John Brown, Ezekial Kellar, Thomas Deems, James M. Skidmore, John N. Starr, George Skidmore, William Wilson, Isaac Zellar, John C. Sperry--

Continued from preceding page.

On the petition of Israel Brown and others for a new County Road. Beginning in the County Road leading from Columbus to Dublin at the division line between the leases of King and Layman on the Trabue Tract, and running thence on a direct line as near as practicable to a point near George Skidmores house in the road leading from Georgesville to Renicks Mill, thence with said road to the West line of Wm. Wilsons Survey No. 875, thence with the west line of Said Wilson's Survey Northwardly to the S. E. Corner of James Galloways Survey No. 7325, thence with the South line of said Survey and with the North line of A. Singletons Survey No. 1484 to the N. W. Corner thereof, thence with the west line of Said Survey No. 1484 South to the line dividing the lands of Thomas O harra and Ezekial Kellar, thence with said line and Continuing the Course thereof to the east line of G. Galloways Survey No. 6636, thence on a direct line or as near as practicable to the mouth of William Browns lane, thence following the rout of a County road petitioned for by Wm. Brown and Others westwardly to the S. E. Corner of Wm. Darks Survey No. 1046, thence with the Course or nearly so of the last Mentioned line to the Amity Road.

Whereupon, the Commissioners appointed Henry McCracken, Arnold Clapp and Abraham Sells viewers, and John Graham Surveyor of Said Road, and that they meet at the Office of Miskell Saunders Esq. in Norwich township on the 13th day of January A. D. 1845. or within five days thereafter, and after being duly qualified according to law, proceed to view, Survey, mark and locate said Road and a true plat along with your report, and whether Said road ought to be Sixty feet wide, you return to this Office on or before the first Monday in the month of March A. D. 1845.

Commissioners Office  
Columbus  
Dec. 3rd 1844

F. Cole  
Auditor of  
Franklin County.

State of Ohio, Franklin County S. S.

Henry McCracken, Arnold Clapp and Abram Sells Commissioners appointed by the Commissioners of said County to Carry into effect the within Order, have met at my Office and have been duly Sworn according to law, Given under my hand this 13th day of January 1845

Miskell Saunders  
Justice of the Peace.

State of Ohio, Franklin County S. S.

John Graham Surveyor within mentioned, appeared and took the necessary Oath according to law. Given under my hand this 13th day of January 1845.

Miskell Saunders  
Justice of the Peace.

To the Commissioners of Franklin County. Gentlemen,

We the undersigned pursuant to the within Order, met at the Office of Miskell Saunders Esq. on the 13th day of January 1845. and after being duly sworn according to law, we proceeded with John Graham Surveyor and two Chainmen and a Marker, to view, survey, and mark Said road as described in Said Order and more fully described in Said Survey as platvand notes herewith returned and after having viewed said Road & caused a survey of the same to be made as aforesaid, we are of the opinion that said Road is much needed, that it is upon suitable ground for the construction of a road, and that it would be of great use and advantage to the neighborhood through which it passes, and we are further of the opinion that 40 feet would be a Sufficient width for said road. January 20. 1845.

Viewers Fees.


A. Clapp	2 days	\$2.00
H. McCracken	2 do	2.00
A. Sells	2 do	2.00

H. McCracken)  
Arnold Clapp)Viewers  
Abram Sells )

Pursuant to the accompanying Order, I proceeded on the 13th day of January A. D. 1845 after being duly Sworn with Nelson Brown and William Brown as Chainmen and John Brown as Marker, under the direction of the Viewers named in Said Order, to Survey and mark the rout of Said Road as follows, to Wit. Beginning in the centre of the Road leading from Columbus to Dublin near the division line between the leases of King and Layman on the Trabues Survey, from which the N. W. Corner of a log house bears N. 53 E. 73 links, thence S 70 W. 256 poles to an angle post, thence S. 88 1/2 W. 64 poles 1 mile post in a Run from which the west chimney in Geo. Skidmores house bears N. 11 W. and being in the centre of the county road leading from Georgesville to Renicks Mill, thence with Said road S. 43 W. 108 poles, thence S. 57 W. 102 poles to a point in Said road near the west line of Wm. Wilsons Survey No. 875. thence N. 55 W. 18 poles to the S. E. Corner of James Galloways Survey No. 7325. thence with the South line of Said Survey N. 79 W. 96 poles to 2 mile post, thence same Course Continued Crossing Run at 140 poles, 320 poles to a Sugar tree 3 Mile tree, Same Course Continued passing the N. E. Corner of A. Singletons Survey No. 1484 Crossing run 3 times from 124 to 140 poles, 320 poles a White Oak 4 Mile tree, Same Course Continued 135 poles to the N. W. corner of Said Survey No. 1484, thence S. 11 W. 50 poles to the line dividing the lands of E. Kellar and Thomas O Harra, thence with Said line N. 88 1/2 W. passing Kellars S. W. Corner at 92 poles, 135 poles to a bur Oak 5 Mile tree, Same Course Continued 65 poles to a point near John Browns house, thence S. 15 W. 26 1/2 poles, thence N. 85 1/2 W. 45 poles to the East line of George Galloways Survey No. 6636, thence N. 89 40' W. 183 1/2 poles to a Sugar 6 Mile tree, Same Course Continued Crossing Riggs Road at 23 poles, large run at 60 poles, 165 poles to the east line of Thomas Birds Survey No. 3445, thence N. 88 W. Crossing large run at 90 poles, 143 poles to the mouth of William Browns lane, thence S. 89 10' W. 12 poles to a Walnut 7 Mile tree, Same Course Continued 123 poles to Thomas T. Crabbs Southeast Corner, thence N. 88 1/2 W. 66 1/2 poles to the Southeasterly Corner of Wm. Darks Survey No. 1046. Thence S. 80 1/2 W. 136 1/2 poles to a beech 8 mile tree, Same Course Continued 48 1/2 poles to the Amity Road, the place of termination, whole distance 8 Miles and 48 1/2 poles.

Jany 21. 1845.

John Graham Surveyor

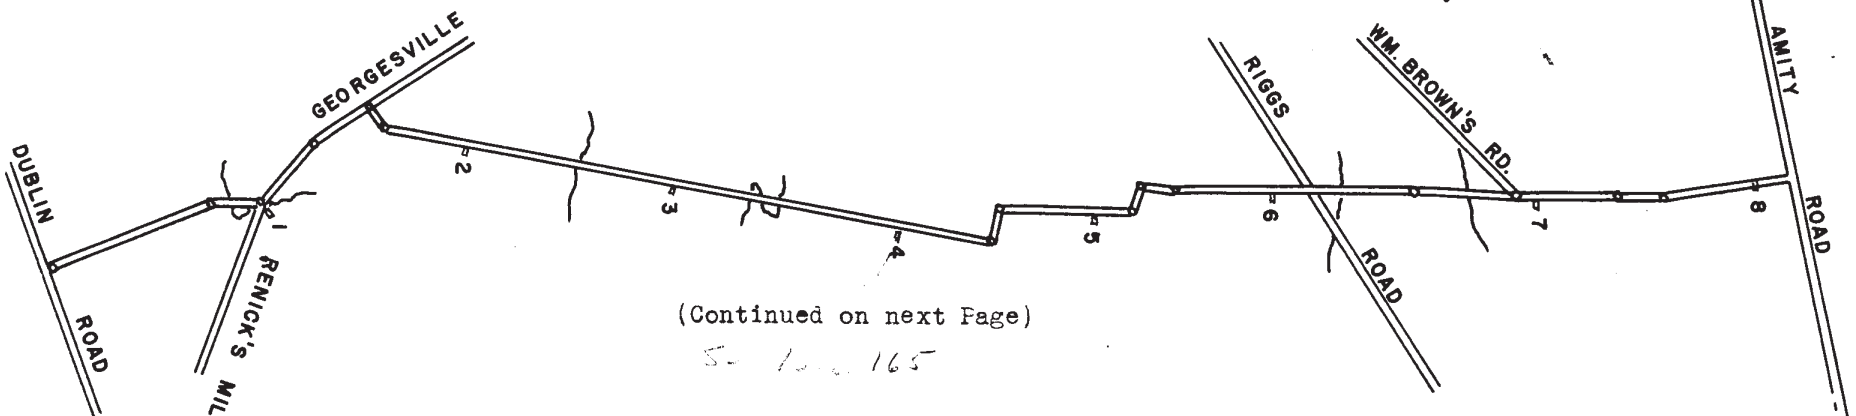

(Continued on next Page)

5-165

1390  
003  
Road Record  
Received  
Page  
332-336  
1845  
0020  
010

Continued from preceeding page.

fees			
Nelson Brown	C. C.	2 days	\$ 1.50
Wm. Brown	C. C.	2 do	1.50
John Brown	Mkr	2 do	1.50
John Graham	Surveyor	4 do	6.00
			<u>\$10.50</u>

To the Commissioners of Franklin County Ohio.

The undersigned are owners of a tract of land about three hundred and seventy acres through which the County Road petitioned for by Israel Brown and others. Beginning ect. at a road leading from Columbus to Dublin at the division line between the leases of King and Layman on the Trabue tract and terminated at Amity County Road on Wm. Darks Survey No., 1046, was laid out, and the undersigned represent that they feel injured by the location of said Road, believing that their said land has been injured and rendered less valuable by the location of the said Road, They therefore make complaint to the Board of County Commissioners and ask that Such proceedings may be had in the premises as the Statute authorizes in such cases.

May 24, 1845

Levis Brown  
Samuel Lucas

To the Hon. the Commissioners of Franklin County, Gentlemen,

The undersigned petitioner, a freeholder and resident of Franklin County feeling himself agrieved by the location of a County Road as petitioned for by Israel Brown and others, prays that you appoint men to view said location So far as it passes through his premises, to estimate the damage if any he may sustain by the establishment of said road and your petitioner as in duty bound will ever pray.

Thomas O Harra

On the petition of Thomas O Harra Levis Brown and Samuel Lucas for damage on a new County Road petitioned for by Israel Brown and Others, Whereupon the Commissioners of Franklin County appointed William Sells, William Armstead, and John Britton as viewers, and that they meet at the Office of Miskell Saunders Esq. in Norwich township on the 12th day of September of September 1845 Or within five days thereafter, and after being duly qualified according to law, proceed to View So much of said road as passes through the premises of said petitioners and estimate the damage if any they may sustain and report the same to this Office On or before the first Monday in the Month of December 1845.

Commissioners Office.  
City of Columbus  
June 4th 1845

Attest  
F. Cole Auditor of  
Franklin County.

State of Ohio, Franklin County S. S.

This day Wm. Sells, Wm. Armstead John Britton viewers to view and examine the Damages upon the land according to the above, and report according to law, have been duly sworn according to law. Given under my hand and seal this 12th day of Sept. 1845.

Miskell Saunders  
Justice of the Peace.

We the undersigned viewers to assess damages on a road as described and directed by the within Order, after being duly sworn and upon actual view of the premises of the petitioners, do award to Levis Brown and Samuel Lucas fifty dollars each, and to Thomas O Harra we award no damage, We claim for the two days each.

Wm. Armstead )  
Wm. Sells )Viewers  
John T. Britton)

In consequence of the damages assessed on the foregoing Road having been paid by the petitioners for the road, and being satisfied said road will be of public utility, We the Commissioners of Franklin County do declare the same a public highway, and we do order the said road to be opened forty feet wide and in all respects according to law, and that notice of this Order be given to the Trustees of the townships through which said Road passes.

Commissioners Office  
December 3rd 1845

Wm. W. Kile )Commissioners  
Samuel S. Davis)of Franklin  
John Clark ) County

1390  
003  
Road  
Recor  
7  
Page  
332-336

1

003

0140