

Central College Road - from Johnstown Road to the County line

COUNTY ROAD IN PLAIN TP.

ROW = 40'


on  
PETITION OF JACOB KITTMILLER & OTHERS

To the Commissioners of the County of Franklin and State of Ohio, The petition of the undersigned respectfully represents that their interests and convenience require the location of a County Road Commencing at the County line of Franklin and Licking in Plain Township at the N. E. Corner of James Evans Land to run thence due west on the line between said Evans Land and Jacob Kittsmillers and thence so as to intersect the road leading from the State road that runs from Johnstown to Columbus to Lees mill at or near the School house in a place called Smiths settlement and your petitioners therefore pray that the proper and legal steps may be taken to authorize the location and establishment of said road and will ever pray.

Dated this fourteenth day of September in the year of Our Lord one thousand eight hundred & forty eight Jacob Kittsmiller Roland Evans John Darly Jr Lewis Ward Henry Smith George Clouse Jonathan Webb Frederick Cole Saml. Evans Daniel Rhoads Joseph Huffman Geo Wagner Samuel Horlocker James Wagner Nicholas Benedict John Daily Peter Hoover James Evans Samuel Smith David Smith Walter Goodrich Lewis Beach Hercules Campbell D Zum T. B. Butcher Samuel Hoover Geo. Smith

Plat and survey of a County Road petitioned for by Jacob Kittsmiller & others

PLAT.

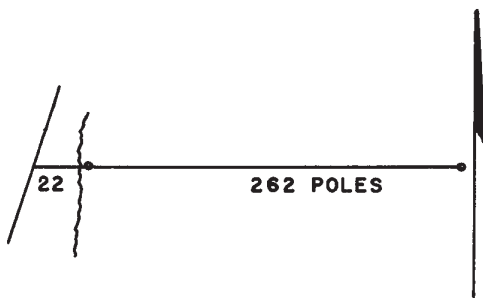

Pursuant to an order from the Commissioners of Franklin County after being qualified according to Law I proceeded on the 26th of May under the direction of Daniel Swickard Nicholas Neiswander and Sammel Baughman as viewers therein named to make a survey of the ground for a Road petitioned for by Jacob Kittsmiller and others as follows, viz. Commencing at county line of Franklin and Licking Counties in Plain Township at the N. E. corner of James Evans land and run thence west on the line between said Evans and Kittsmiller Crossing Blacklick at 262 poles from thence 22 poles to the place of termination intersecting the Road leading to Lees mill

Total distance 284 poles

I certify the above plat and survey to be correct May 26th 1849

Archibald Smith Surveyor

Pursuant to an order from the Commissioners of Franklin County Dated the 26th day of May 1849 we have examined the ground for a Road petitioned for by Jacob Kittsmiller & others and do believe that if said Road be opened it will be of public utility

We further say that the said road is to be 40 feet in width Dated May 26th 1849

Expenses

Daniel Swickard		1 day	\$1.00)
Sammel Baughman		1 "	1.00)
Archibald Smith	Surveyor	1 day	1.50
Abraham Stagg	Chainmen	1 "	0.75
Charles Hand	"	1 "	.75

010

0010

1849

420-421

420-421

1849

7

1849





