

Continued from preceeding page.

The undersigned viewers named in the annexed order having met at the time and place named in said order proceeded to view the ground along the route as set forth in the annexed survey and plot, and unanimously report in favor of establishing a county road along said line for the following reasons first the ground along said route is such that a good road may be made at a reasonable expense- secondly the viewers are of opinion that it will be conducive to great public benefit and thirdly it will be of great convenience to the citizens who reside in the vicinity of said road and think forty feet a proper width for said Road

John Bishop)Viewers
S. R. Sammis)

Franklin County S. S. March 26th 1849.

I certify that Selah Sammis and G. W. Hart, were duly sworn by me to perform the duties of their appointment as required by the within order

R. R. Arnold J. P.

Franklin County S. S. March 26th 1849.

I certify that John Bishop one of the viewers named in the within order was duly sworn by me to perform the duties of his appointment


G. W. Hart. Surveyor

Pursuant to the above order the undersigned met John Bishop & Selah Sammis two of the viewers named in said order and after being duly qualified as appears upon the back of said order and taking Abner Park & Edward Jacox as chain carriers and David Park as marker, commenced on the East line of Sharon township at the line dividing the lots of D. W. Deshler and the lot formerly owned by Artemus Cutler and running thence westerly along said line 320 poles to the first mile tree thence the Same Course of said line 198 poles to the county road from Worthington to Galena placing monuments at the commencement and termination agreeable to the requisitions of the Statute, which survey was made under the direction of the viewers on the 26th day of March 1849

G. W. Hart surveyor

Fees			
John Bishop	one day viewer-		\$1.00
Selah Sammis	" " "	-	1.00
Abner Park	" " C. Carrier		0.75
Edward Jacox	" " "		0.75
G. W. Hart	two " Surveyor		3.00
David Park	one " Marker		0.75

PLAT.

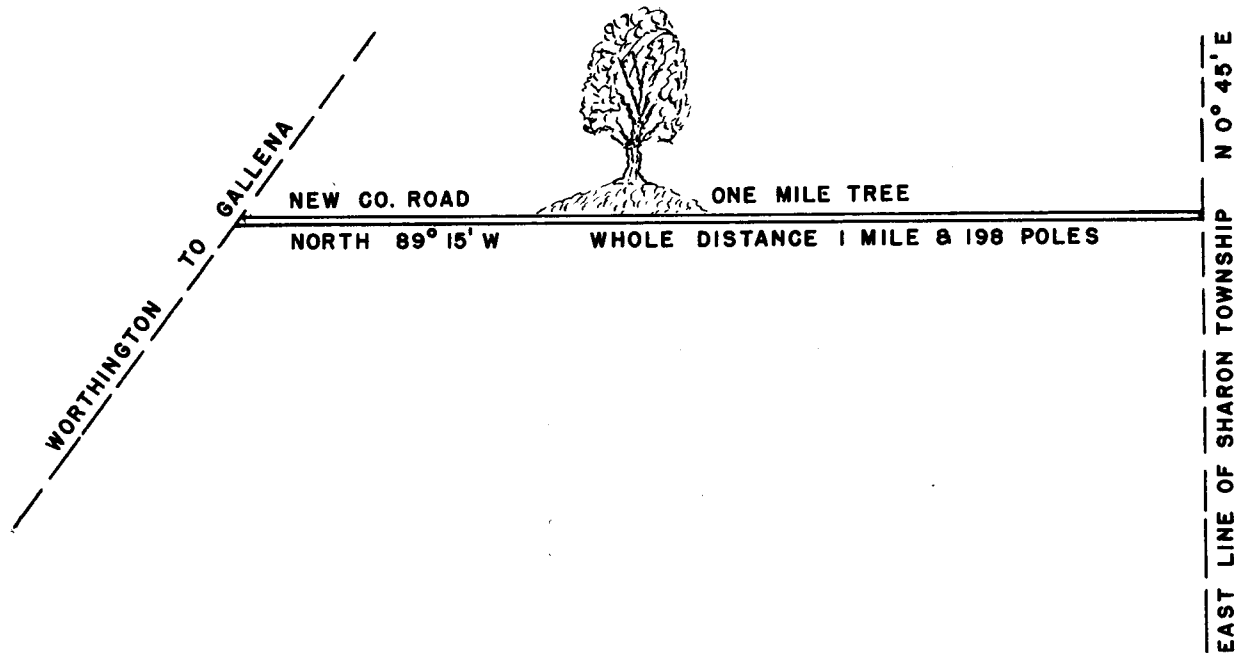

I certify the above to be correct

G. W. Hart surveyor

010
0020
1849
Page 425-426
7
Record

010