3230

0

ROAD RECORD NO. 7

ROAD RECORD NO. 7

PAGE NO. 440

Alteration to Alum Creek Drive from Livingston Avenue south 2120'

GEORGE WHITES ROAD

ROW = 40'

To the Commissioners of Franklin County, Gentlemen,

the undersigned Freeholders and residents of said County, respectfully represent that the public interest requires an alteration of the road running up the West side of Allum Creek, to commence where said road crosses George Whites east line, thence North with said line to intersect the Livingston road- Your petitioners therefore pray your Hon: body to take such measures as the Law requires in such cases made as in duty bound will ever pray, (Names) George White, Littleton R. Gray, Edward Livingston, Eli Miller, E. Cryder, Saml. Gares, Martin Kufa, Thomas Hamilton, David Handley, Robert N. Livingston, John Bullen, Alex. Mooberry, Stephen S. Edwards,

County Auditor Office May 18th A. D. 1850-

To John Courtright)
Daniel Rickard & Viewers
Thomas Needles)
and William Johnson, Surveyor- Gentlemen,

You have been appointed to view and survey an alteration in the road running up the West side of Allum Creek- To commence where said road crosses George Whites East line, Thence North with said line to intersect the Livingston road,

You will therefore meet for the above purpose at the house of George White on the 25th day of May inst. and proceed according to the law annexed hereto, By order of the County Commissioners

H. Crary Clerk of the Board,

The State of Ohio, Franklin County S. S.

I do hereby certify that the above named William Johnston was by me duly sworn according to the within requirements and according to Law-

May 27th 1850

J. P. Bruck J. P.

Pursuant to the annexed order I proceeded on the 27th day of May 1850 under the direction of John Courtright, Daniel Rickard and Thomas Needles, Viewers to make a survey and location of an alteration in a county road petitioned for by George White and others as follows, viz- Beginning at a stake in Allum Creek road running up the West side of said Creek where said road crosses George Whites east line, Thence on said line North 128½ poles to a stone in the Livingston road, Thence with said Livingston road west 52 poles to a stone in the Allum Creek road, whole distance 180½ poles course and distance of the old road N 40 W. 78 poles, North 73 poles whole distance of old road 151 poles- I certify the above field notes to be correct as taken by me on the ground and that the plat is a true protraction of the same,

PLAT.

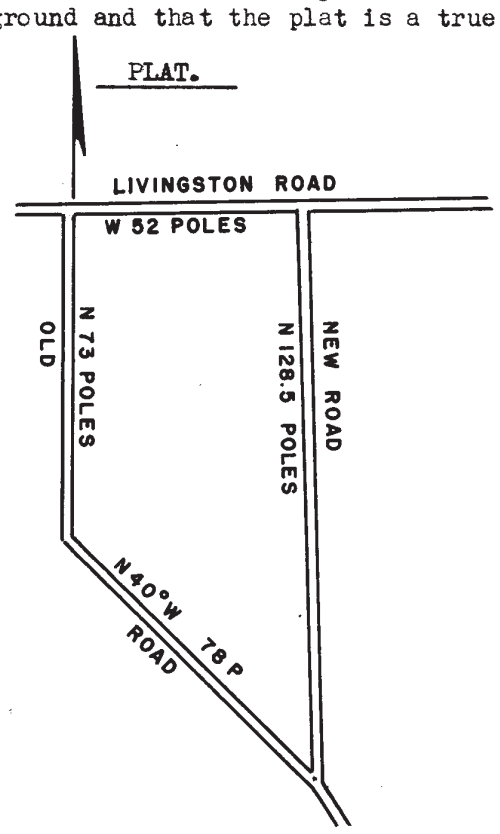

Wm. Johnston, Surveyor

To the Honorable Commissioners of Franklin County, Ohio,
Agreeable to an order to us directed from your Honorable body in answer to a petition of George White and others for an alteration in a County road - We have examined the ground and caused a location of the road as designated by the annexed plat and survey and are of the opinion that the said road if established would be of public utility and that forty feet will be sufficient width for said road,

John Courtright)
Daniel Rickard)Viewers
Thomas Needles)

May 27th 1850
Bill of Costs-

William Johnston	Surveyor	$2.00
John Courtright)		1.00
Daniel Rickard)	Viewers	1.00
Thomas Needles)		1.00
Littleton Gray)	C. C.	.75
Robert Livingston)		.75
Lorinzo Jenkins	Marker	.75
		$7.25

3 / Road Record 7 Page 440-447

0030

0660