

RELOCATION OF COUNTY ROAD IN MADISON TOWNSHIP
Petitioned for by David Taylor, et al.


Be it remembered that heretofore to wit: at the December Session A.D. 1861, and on the second day of said Session of the County Commissioners of Franklin County, Ohio, among other matters then (and-) ~~(there)~~ had were the following.

To John Cox; Moses Seymour & Jesse Seymour, Trustees of Madison Township, Franklin County, Ohio:

The undersigned petitioners respectfully represent, That portion of the road (opened on the petition of David Taylor and others in said township) lying between the East side of Alum Creek, where said road leaves the North line of N.W.Q. of Sect. 17 and the west side of said Creek where the said road strike the North line of N.E.Q. of Sect. 18 has been destroyed in part by the washing of said Creek, and your petitioners respectfully ask the Trustees of said Township to view said road and re-locate the same in such place as their discretion may deem preferable. June 12th, 1861.

JACOB ROHR, JOHN B. EDWARDS, JOHN SPANGLER, EDWARDS G. BEHM, ABNER BEHM, ADAM HELSEL, ALEXANDER H. VEHEMS, F. HAREY, PHILIP HELSEL, SAMUEL R. HELSEL.

PLAT - of the survey of the alteration of a County Road Petitioned for by David Taylor and others, and being washed away by Alum Creek; on petition of Jacob Rohr and others to the Trustees of Madison Township.

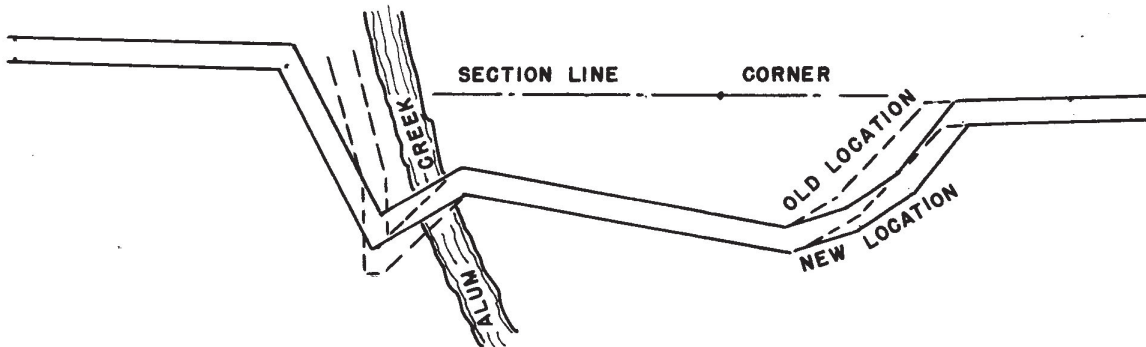

In obedience to said to said petition we the undersigned Trustees of Madison Township made the alteration as follows: Viz: Commencing in the road in the south line of section 8 in Township 11 of Range 21, 5 chains & 78 links East of the S.W. cor., of said section; thence S. 37° - W. 2.66 chains; Thence S. 57° - W. 1.50 chains; thence S. 75-1/2° W. 1.50 chains; thence N. 83° - West 5.50 chains; thence N. 80° - W. 4.90 chains; thence S. 41° - W 3 chains; thence N. 36° - W. 5.05 chains to the Road on the Section line. Sept. 7th, 1861.

FEES-
Surveyor John Cox 1 day 2.00
Chainmen (Moses Seymour) " 1.00
(Jno.G.Edwards) " 1.00

JOHN COX)
JOHN SEYMOUR) Trustees.
MOSES SEYMOUR)

PAGE 369.

And we the Trustees do estimate the Damage that will accure to C.R.Stevens if the road be opened at fifty Dollars. Sept. 7, 1861.

JOHN COX)
JM. SEYMOUR) Trustees.
JESSE SEYMOUR)

I, C.R.Stevens, do claim the sum of five hundred (500) dollars damages suffered me from the re- location of a portion of the road petitioned for by David Taylor and others on or near the north line of Section 17 & 18 in Madison township, Franklin County. Sept. 7th, 1861.

C.R.STEVENS.

And afterwards, to wit: on the said day of said session of the County Commissioners of Franklin County, Ohio, the following proceedings were had.

Ordered that the road petitioned for by Jacob Rohr and others be established, an the petitioners paying the damages (50\$) into County Treasury, within 30 days from this date.

4170
3001
Road Record
8
Page
368
1861
0710
0110