

3420  
3001  
ROAD RECORD  
8  
PAGE 436-440  
1866  
0010  
0110

Sawmill Road - from Henderson Road to West Case Road (going west)

ROW not stated;  
per Ohio Roads law is between 30' and 60'

ROAD RECORD NO. 8

ROAD RECORD NO. 8

PAGE NO. 436

J. M. THOMAS AND OTHERS ROAD IN PERRY TOWNSHIP

NOTICE OF PETITION

Notice is hereby given that there will be presented to the Commissioners of Franklin County Ohio, on the first Monday in June A. D. 1866 a petition for a Public Road of which the following is a description. Beginning at the South termination of a public road which commences at the boundry line between Franklin and Delaware Counties Ohio and running thence south on the East side of section line, range (19) nineteen on the west side of Perry Tp. Franklin Co. O. thence South on East side of said section line across the premises of Z. Everett a distance of 41 Rods thence south on the East side of said section line across the West end of the premises of Jno. Matthews a distance of 101 Rods said section line being the partition line between Jno. Matthews & Z. Everett, thence South on the East side of said section line & across the West end of Jno. S. Hendersons premises a distance of 90 rods said section line being the partition line between Jno. S. Henderson Mary Hutchison and W. Mateer intersecting with a public road leading from the Scioto river to the Shattuckburgh and Olentangy river road and other public roads leading to Columbus, said public road being a distance in length of 232 rods your petitioners represent that said would be of great public benefit and convenience & expediency to travelers and therefore pray that their petition may be granted J. M. Thomas and many others.

State of Ohio Franklin Co. S. S.

Chas. S. Gelnn makes solemn oath that he is one of the publishers of the Columbus Gazette a newspaper printed in said county that the notice of which the annexed is a true copy was for four consecutive p weeks published in said newspaper beginning on the 4th day of May A. D. 1866

C. S. Gelnn

Sworn to and subscribed before me this 4th day of June A. D. 1866

J. W. Davis J. P.

and be it remembered that on the 6th day of June A. D. 1866 the petitioners in accordance with the foregoing notices presented the Commissioners of Franklin County with the following

PETITION.

To the Honorable Commissioners of Franklin County Gentlemen,

The petition of the subscribed respectfully represent that they are residents freeholders of Perry Township Franklin Co. O. that they are desirous of having a public road opened from points herein designated and along section line herein specified, Beginning at the South termination of a public road which commences at the boundry line between Franklin and Delaware counties Ohio and running thence S. on the East side of said section line range (19) nineteen on the West side of Perry Tp. Franklin County Ohio thence South on the East side of said section line across the premises of Z. Everett a distance of 41 rods, thence South on the East side of said section line across the West end of the premises of Jno. Matthews a distance of 101 rods said section line being the partition line between Jno. Matthews and Z. Everett thence S. on the East side of said section line across the west end of Jno. S. Hendersons premises a distance of 90 rods said section line being the partition line between Jno. S. Henderson Mary Hutchison & W. Mateer intersecting with a public road leading from the Scioto river road to the Shattuckburgh and Olentangy River road and other public roads leading to Columbus. Said proposed being a distance in length of 232 rods your petitioners represent that said road would be of great public benefit and convenience and expediency to travellers and therefore pray that their petition be granted. J. M. Thomas, Chas. Davis, Jo Henderson, D. W. Thomas, H. Need, Jno. Snouffer, Wm. Delashunt, J. E. Davis George Snouffer, J. K. Thomas, James Jamison, J. L. Andrews, V. K. Pheneger, D. Snouffer, J. Thompson, J. C. Thompson, Jno. Friend, Jas. Davis, T. B. Samees, Jno. Clark, Jno. Starrett, August Smith, Symay Smith, E. Hard, H. A. Armstrong, Amos Brelsford.

On the presentation of the aforesaid petition J. W. Thomas came forth and gave the following Bond.

Know all men by these presents that we J. M. Thomas Chas. Davis and J. E. Davis are held firmly bound unto the Commissioners of Franklin County Ohio in the sum of One Hundred Dollars, signed and sealed with our seal this 4th day of June A. D. 1866.

The conditions of the foregoing obligation is such that there has been presented to the Commissioners of said County a petition for a public road across the premises of Z. Everett, Jno. Matthews and Jno. S. Henderson in Perry Tp. Franklin County (being full described in the petition) Now if the said Commissioners shall grant a view of said premises the viewers view and survey said premises and report "No Road" then this obligation shall be in full force so far as the expenses that will occur

Continued from preceeding page.

to the County in these premises, otherwise the obligation to be null and void.

-----  
- 25 -  
-Revenue -  
- Stamp -  
-----

J. M. Thomas (Seal)  
Charles Davis (Seal)  
Jacob E. Davis (Seal)

In accordance with the above petition the Commissioners of Franklin County did on the 6th day of June A. D. 1866 appoint Jacob Slyh, Thomas Deems, and Alexander Shattuck viewers & Josiah Kinnear surveyor and they were notified on the 11th day of June 66. of such appointment and also to meet on the proposed route on the 22nd day of June A. D. 1866.

VIEWERS REPORT.

To the Board of Commissioners of Franklin County Ohio.

The undersigned Jacob Slyh Thomas Deems and Alex. Shattuck appointed viewers by your order of June 11th 1866, to view and survey and assess the compensation or damages by reason of establishing a certain County Road to wit, commencing on the premises of Z. Everett in Perry Tp. and running thence in a southerly direction 252 rods across the premises of said Z. Everett Jno. Mateer and Jno. S. Henderson, make the following separate report in regard to the award of compensation or damages by them awarded in consequence of opening said road to wit. To Z. Everett for the amount of property appropriated for said road \$250.00 To Jno. S. Henderson \$50.00 Jno. Mateer nothing, and we do further more favor the establishment of said road as laid in the surveyors report, The Said assessments are made under the written application for compensation and damages filed with us by said Parties on the 22nd day of June A. D. 1866.


Jacob Slyh, Thos. Deems, Alex. Shattuck) Viewers.

SURVEYORS REPORT.

To the Board of Commissioners of Franklin County Ohio.

The undersigned Josiah Kinnear in obedience to your order dated June 11th 1866 and directed to Jacob Slyh Thomas Deem and Alex Shattuck viewers and myself surveyor proceeded in company with and under the direction of said viewers having first been sworn according to law, and taken to my assistance Geo. Brelsford and Milton Smiley as Chainmen and Thomas Deems as Marker and administered to them the proper oath proceeded to survey and mark the road as directed by said viewers as follows to wit: Beginning at the South termination of a public road which commences at the boundry line between Franklin and Delaware Counties Ohio, thence South 2 1/4 W. 41 poles on the East side of the section line of Range 19, on the West side of Perry Tp. Franklin County Ohio thence S. 2 1/4 f. W. on the East side of said section line 101 poles to a stone in a County road thence South 1/2 E. 90 poles to a stake in a county the point of termination as will more fully appear by reference to the plat and field notes below, and I certify that said plat is a correct representation as taken by survey on the ground June 22nd 1866. Respectfully Submitted

Josiah Kinnear.

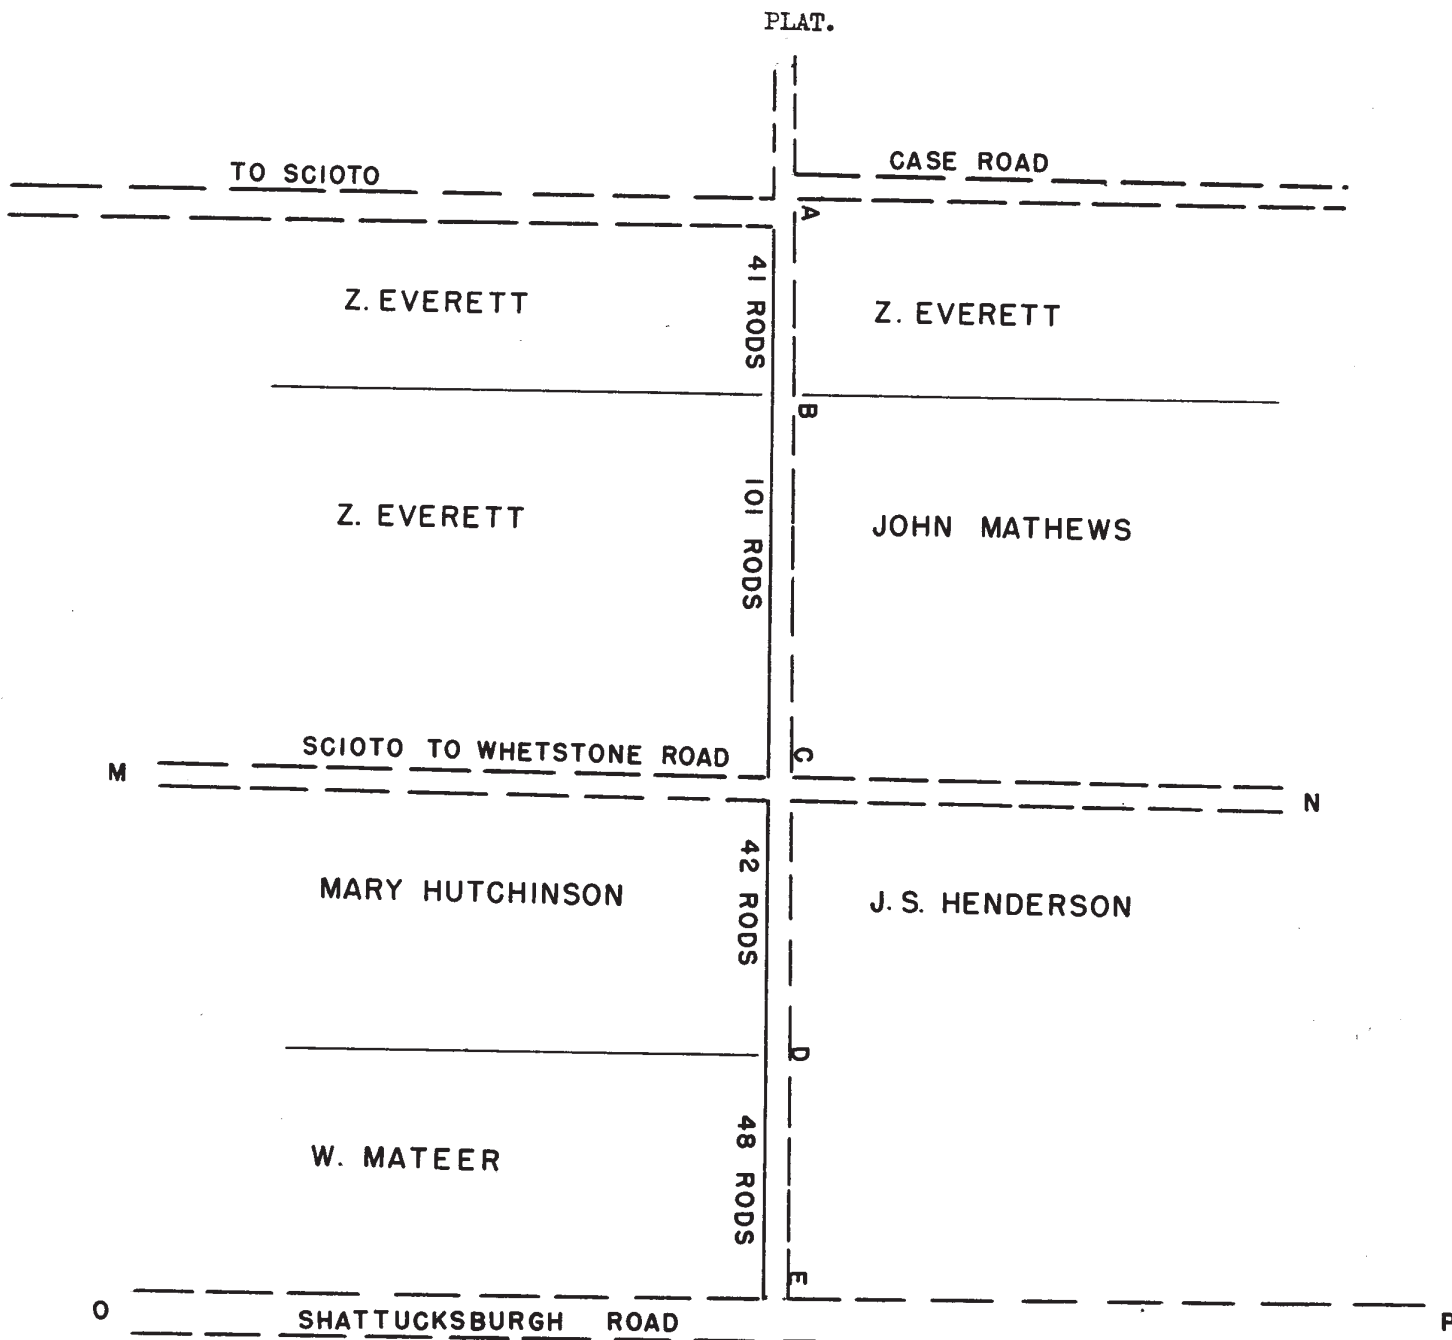

(Continued on next Page)

3420 300 ROAD RECORD 8 PAGE 436-440 1866 0020 070

Continued from preceeding page.

And be it remembered that on the 3rd day of September 1866 it being the first day of the regular session of the Commissioners the foregoing reports were publicly read for the first time.

And afterwards to Wit on the 4th day of September A. D. 1866 the reports were read the second time.

And afterwards to Wit. on the 5th day of September A. D. 1866 said reports were read the 3rd time and the road was established according to plat and Survey & viewers report. Damages were assessed to the amount of 300\$ of which amount 125\$ is hereby ordered to be paid out of the County, the remaining 175\$ to be paid by the petitioners.

The Auditor was furthermore ordered to notify said Trustees to open said road, which order was duly complied with by said Auditor. and in said order to the Trustees, there appeared a correct description of said road and in every respect in perfect compliance with law.