

Road, to-wit: Commencing at the point of intersection of the Columbus and Delaware Road with the Delaware and Franklin County line. Thence with said line S 88° 30' E 199.32 Tp S 3° 45' E 26 poles to a line in a County road near the C.C. and C.R.R. Culvert make the following separate report in regard to the award of compensation or damages by them awarded in consequence of opening said road, to-wit: To A.H. Carter, the sum of Eighty (80\$) Dollars and to Ozem Gardner the sum of Seventy Five (75\$) Dollars. The foregoing amounts the undersigned assess and determine to be the compensation to be paid in money for the property of the several persons, which is sought to be appropriated, without deduction for benefit to any property of the said Viewers, and they also assess and determine that the lands and premises from which such appropriation will be taken will not be rendered less valuable by the opening and construction of said road. The said assessments are made under the written application for compensation and damages filed with us by said parties on the 25th day of March 1869, which are hereto attached with their proof of notice, under which the same were filed. We further state that we have located said road fifty feet wide.

James H. Hess)
Geo. S. Demming) VIEWERS.

Viewers (James H. Hess 2 days.
 (G. S. Demming 2 days

Marker James Hess 1 day
Chain Carrier G. S. Demming 1 day

Surveyor Josiah Kinnear 6 days

SURVEYOR'S REPORT.

SURVEYOR'S OFFICE, FRANKLIN CO.
COLUMBUS, May 20th. 1869.

TO THE BOARD OF COMMISSIONERS OF FRANKLIN COUNTY, OHIO:

The undersigned, Josiah Kinnear in obedience to your order dated March 2nd 1869, and directed to James Hess and G. S. Demming of Franklin County and C. W. Smith and W. T. James of Delaware Co. as Viewers and myself as Surveyor proceeded in Company with and under the direction of said Viewers taking to my assistance G. S. Demming & M. T. James as Chain Carriers and James Hess and C. W. Smith as Markers and Administered to them the proper oath, I proceeded to survey and mark the road as directed by said Viewers, as follows, to-wit; Beginning in the center of the Columbus and Delaware Road at the point of intersection of said road with the Delaware and Franklin Co. line. Thence with said County line S 88° 30' E 199.32 poles to a stake west of the west line of the C. C. and C. Rail Road. Thence parallel with said Rail Road to a stone in the County Road S 3° 45' E 20 P., terminus of said road. Reference to the plat will more fully show and at large appear.

J. Kinnear Surveyor.

C. W. Smith)
James Hess) Marker

G. S. Demming)
M. T. James) Chain Carriers.

(SEE PLAT AT END OF RECORD)

Page 27

AND BE IT REMEMBERED, That on the 7th day of June A. D. 1869, it being the first day of their regular session, the Commissioners read the foregoing Viewers and Surveyor's Report for the first time.

And afterwards, to-wit; One the 8th day of June 1869, it being the second day of their regular session the said reports were taken up and read the second time.

AND BE IT REMEMBERED; That on the 9th day of June, A. D. 1869 it being the 3rd day of their regular session, the Commissioners of Franklin having read the said reports the third time, and being satisfied that the laws have been complied with in all reports, ordered said road established on condition that the petitioners pay Eighty Dollars to A. H. Carter, as damages so assessed by the Viewers, within thirty days date thereby from date hereof.

Samuel E. Kile
Clerk to Commissioners and Auditor.

ROAD RECORD NO. 9

ROAD RECORD NO. 9

PAGE NO. 27

SAMUEL PAULUS ALTERATION

NOTICE FOR A CHANGE OF ROAD.

NOTICE IS HEREBY GIVEN, That there will be a petition before the Commissioners of the County of Franklin, Ohio, for a change of the location of that part of the Scioto River Road lying between the town of Dublin and the South Boundary line of Charles Mitchell's farm.

Samuel Paulus

TIME EMPLOYED.

Viewers	2 days each	-----	\$ 3.00
Surveyor	3 " "	-----	15.00
C. Carriers	1 " "	-----	.75
Flagman	1 " "	-----	.75
Marker	1 " "	-----	.75


G.S. Innis)
 Wm. Merion) VIEWERS.
 J.H. Earhart)

Page 30

They further report that there was no claims presented to them for damages by reason of opening said road.

G.S. Innis)
 Wm. Merion) VIEWERS.
 J.H. Earhart)

PLAT OF ALTERATION OF ROAD.

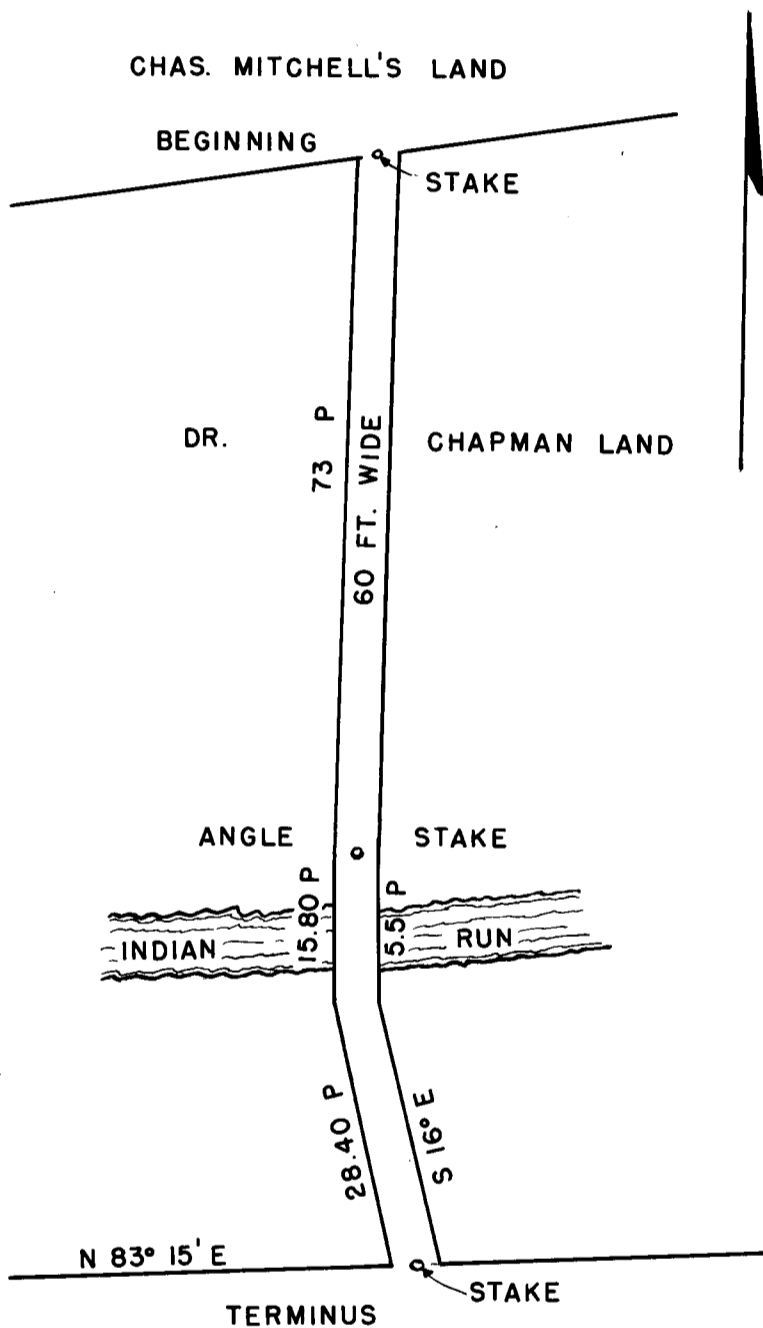

Plat and survey of a County road petitioned for by Sam'l Paulus et al made under the direction of the Viewers of said road.

Beginning at a stake the point of intersection of the Scioto River road and the South side of Chas Mitchell's land & Dr.Chapman's land. Thence S.24 1/4° E 73 poles to the center of Indian run,same course continued 6.80 poles to a point on the south bank of said run. Thence S 16° E 24.40 poles to a stake,the terminus of the proposed road,

I CERTIFY that the foregoing is a correct plat and return of the survey of said road as I verily believe.

Josiah Kinnear Surveyor of Road.

And afterwards,to-wit;at the September session,A.D.1870,of the County Commissioners of Franklin County,Ohio,said report was taken up on the first day and read the first time.

And afterwards,to-wit; on the second day of said session,said report was taken up and read the second time.

And afterwards,to-wit; on the Third day of said session,said report was taken up and read the third time and laid over till the regular session in September.

ROAD RECORD NO.9

ROAD RECORD NO.9

PAGE NO.31

W.W.WILLIAMS ROAD.

NOTICE.

NOTICE IS HEREBY GIVEN,that a petition will be presented to the Commissioners of Franklin County, at their next session to be held on the first Monday of March,A.D.1870,praying for the Alteration of the County road leading from the Georgesville road in said County to the said Kellar road in said County as follows:

Beginning at the north east corner of the land owned by the heirs of John O.Sperry deceased and south east corner of the land owned by Frederick Summers. Thence running north on said line and the land owned by the heirs of John Trabue; thence extending along said line between Wesley and Elisha Wilson,Smith Britton,James Barbee,Sam'l Shrum's heirs and Andrew McNinch's land so as to intersect the road running east and west on the line of Franklin and Norwich Townships in said County.

Dated this 1st day of January,A.D.1870

W.W.Williams and Others.

PETITION.

TO THE HON.BOARD OF FRANKLIN COUNTY COMMISSIONERS:

Your petitioners residents fresholders of said County respectfully represent that the public convenience requires the alteration of the County road leading from the Georgesville road in said County to what is commonly called the Keller road in said County,as follows:

Beginning at the north east corner of the land owned by the heirs of John O.Sperry deceased and south east corner of the land of Frederick Summers. Thence running north on said line and land owned by the heirs of John Trabue. Thence extending along said line between Wesley and Elisha Wilson,Smith Britton, James Barbee,Sam'l Shrum's heirs and Andrew McNich's land so as to intersect the road running east and west on the line of Franklin and Norwich Townships known as the Keller road.

Your petitioners ask that said road may be established upon such alteration of the width of forty feet also that such proceedings may be had as are necessary to establish alterations according to law.

W.W.Williams
William H.Shrum
D.C.Sperry
James Tippin
Andrew Planck
Stephen Deems
B.F.Daymude

William Warner
Cloe Shrum
Catherine Sperry
Isaac Zellers
Nicholas Eink
Frederick Summers
Martin Rogers

B.O.Warner
John L.Shrum
J.A.Tom
Thomas Deems
Elias Zellers
J.S.Cromwell
Wesley Wilson

BOND.

KNOW ALL MEN BY THESE PRESENTS.

That we,W.W.Williams and J.S.Cromwell are held and firmly bound unto the State of Ohio for the use of Franklin County,in the just and full sum of One Hundred dollars,the payment of which,well and duly to be