
VIEWERS REPORT.

TO THE BOARD OF COMMISSIONERS OF FRANKLIN COUNTY, OHIO:

In obedience to your order issued at your March Session, A.D. 1871, we the undersigned, Viewers, appointed under said order met with Josiah Kinnear Surveyor, at Andrew McNich on the 6th day of April, A.D. 1871. And were severally sworn to discharge, faithfully and impartially the duties required of us in said order. William Reed and William Randolph were selected as Chain Carriers, and were also duly sworn.

We then proceeded to view said proposed Daugherty road on the line described in your order and caused the same to be surveyed as prayed for in the petition or as near the same as in our opinion a good road can be made at a reasonable expense, taking into consideration the utility, convenience, and inconvenience and expense which will result to individuals, as well as the public, by the change of width of said road, as follows:

Beginning at a stone common corner to John Robertsons & John Kinnear's Lands. Thence South 75° E 52 poles to a stone corner. Thence S. 8¼° E 25.20 poles to a stake corner to Robert Horch and others. Thence 77° E 248 poles to a stone corner to B. Daugherty Booseiver & Jacob Walley. Thence N 76¾° E 297 poles to a stake passing over a stone corner to Jacob Kenitz land, said stake bears from the S.E. Corner of said Kenitz House S 13¾° W. 7.28 poles. Thence N 78½° E 52.80 poles to a lime stone corner. Common to Adam Renner & T.H. Howsend land. Thence N 80° E 65 poles to Britton's S.W. Corner of land. Thence N 64¾° E 488 poles with said Britton's South line of land; to the center of Columbus & Dublin Road. It being the terminus of said road above described.

We would respectfully report that the change ought to be made, we also determine, that the public convenience requires that such road shall be established forty feet in width. All of which is respectfully submitted.

May, 25th 1871

John Stimmel)
J.M. Briggs) VIEWERS.

FEES.

John Stimmel	Viewer	3 do	4.50
J.M. Briggs	"	3 "	4.50
J. Thomas	"	3 "	4.50
Wm. Read	Chainman	2 do	1.50
Wm. Randleaf	"	2 "	1.50
Josiah Kinnear	Surveyor	4 days,	\$20.00

AND BE IT REMEMBERED, That on the 5th day of June, A.D. 1871, it being the 1st day of their regular session the Commissioners of Franklin County, took up and read the foregoing Surveyor's & Viewers Report.

AND on the day following June 6th the second day of their regular Session it was taken up and read the second time.

AND BE IT REMEMBERED, That on the 7th day of June, A.D. 1871, it being the 3rd day of their Regular Session, the Commissioners of Franklin County, O., having read for the third time the Surveyor's & Viewers Report as above, and being satisfied the laws had been all complied with, it was ordered that the alteration be made, provided the petitioners pay all expenses of Viewers & Surveyor, and the same to be paid.

Within 30" days from and after passing of the order.

S.E. Kile Auditor &
Clerk to Board.

ROAD RECORD NO. 9

ROAD RECORD NO. 9

PAGE NO. 63

JOHN CHANEY ALTERATION ROAD.

(CHANEY ROAD IN MADISON TP.)

ROAD NOTICE.

NOTICE IS HEREBY GIVEN, That a petition will be presented to the Commissioners of Franklin County, in the State of Ohio, at their Regular Session to commence on the first Monday of June, A.D. 1871, to reduce the width of the County road known and described in the road Record's of said County as the John Chaney Road, from forty (40) feet to thirty (30) feet by vacating 10 feet off the north side of said road, its full length. Said Road commences at the State Road leading from Winchester to Columbus, road on the south bank of the Ohio Canal, near Rodenfels Mill (formerly Chaney's Mill) in Madison Township, in the said County, and ends near Chaney's woolen factory in said Township.

Many Petitioners.

PETITION.

TO THE COMMISSIONERS OF FRANKLIN COUNTY:

The undersigned citizens and land owners in Madison Township, Franklin County, Ohio, aforesaid resid-

ing in the immediate vicinity of the following described road, respectfully ask your Honorable Board to proceed as the law directs and provides to reduce the width of the County Road, known and described in the road Record's of said County as the John Chaney Road, from forty (40) feet wide to thirty feet by vacating 10 feet off the north side of said road, and we assign as our reasons, why said road should and ought to be reduced from said 40 feet in width to said 30 feet in width, by taking ten (10) feet off the north side, 1st about one half of the full length of the said road runs along on top of the bank made by the dirt thrown from the Mill race of the mill built by Chaney & Son, which bank is not to exceed 25 feet in width immediately south along said road, is the mill race, and near the north side and along said road, the ground is unsuitable for a road without any filling.

Second: About one half of the remainder of road runs along on the Berme Bank of the Canal, and said bank makes a good road and needs but little if any filling.

Third: If narrowed, the road will amply accomodate all the traveling public it is reduced to 30 feet in width. And your petitioners will ever pray. Said road commences at the State Road leading from Winchester to Columbus road on the south bank of the Ohio Canal near Rodenfels Mill (formerly Chaney's) in Madison Tp. And ends near Chaney's Woolen Factory.

John Chaney	John Rodenfels	Samuel Wheeler
Adam Smith	Adam Shaner	D.B. Decker
P.C. Harris	John Rager	Joshua Shaner
E.K. Chaney	G.T. Wheeler	A. Wilson
Jos. Rodenfel	O.P. Chaney	John S. Lehman
Rob't (his X Mark) Rush	Peter Brown	

BOND.

KNOW ALL MEN BY THESE PRESENTS:

That we John Chaney, Milton Cummins are held and firmly bound unto the State of Ohio for the use of Franklin County, in the just and full sum of One Hundred Dollars, the payment of which, well and truly to be made, we bind ourselves, our heirs etc etc jointly and severally, firmly by these presents.

Witness our hands and seals, this 5th day of June, A.D. 1871

THE CONDITION OF THIS OBLIGATION IS SUCH, That Whereas the above bound John Chaney has this day petitioned the County Commissioners of Franklin County for alterations of the width of the road in Madison Township, known as John Chaney's road running along the north side of the Canal.

Now, if the said John Chaney shall succeed in his petition, then this obligation to be void and of no effect; otherwise to remain in full force in Law.

June 5th A.D. 1871

John Chaney (SEAL)
Milton Cummins (SEAL)

VIEWERS AND SURVEYOR APPOINTED.

BE IT KNOWN, That on the 28th day of June A.D. 1871. The Com's of Franklin County appointed Kalita Salee, David Whitsell, Frederick Swisher Viewers and John Cox Surveyor. To view the said road in accordance with said petition, and that said Viewers and Surveyor meet at the Mill of Rodenfels on June 29th 1871, or within five days after and make their report in writing and in accordance with law in such case made and provided, by order County Commissioners.

VIEWERS REPORT.

TO THE HONORABLE BOARD OF COMMISSIONERS FRANKLIN COUNTY, OHIO:

Agreeably from an order from you to make an alteration of a road commencing at the State Road leading from Winchester to Groveport, on the south Bank of the Canal near Rodenfels Mill in Madison Township, and ends near Chaney's Woolen Factory.

After having been duly sworn according to view said road and there being no compensation or damages claimed we are of the opinion that thirty feet is sufficient width for said road, it being most along, and mill race, and thrown up and but little travel on the road.

K. Salee)
David Whitsell) VIEWERS.
Frederick Swisher]


FEES

John Cox	Surveyor	5.00	Viewers	4.50
Peter Brown	Chainman	1.00		
A.L. Timmons	"	1.00		
H. Long	Notary Public	.25c		
	Total	11.75		

SURVEYOR'S REPORT.

Notes of the survey of the alteration of the above described County Road, Agreeably to the order of the Commissioners and under the directions of the aforesaid Viewers. Commencing at a post in the Groveport and Winchester Turnpike near Rodenfels mill, and running thence N. 12 poles crossing the canal at a post at 2. Thence N 85° W 40 poles to a post at 3. Thence S 77° W 16 poles and 20 links to a post at 4. Thence N 86° W. 50 poles to County Road; same course 28 poles to a post 5. Thence N 81° W 15 poles to a post at 6. Thence 77° W. 15 poles to a post 7. Thence N. 85° W 41 poles to a post 8. Thence 63° W. 20 poles to a post at 9. Thence N 89° W 22 poles to a post at the termination near Chaney's Woolen Mill, Whole length 253 poles & twenty links.

PLAT OF JNO.CHANEY'S ALTERATION ROAD
MADISON TOWNSHIP.

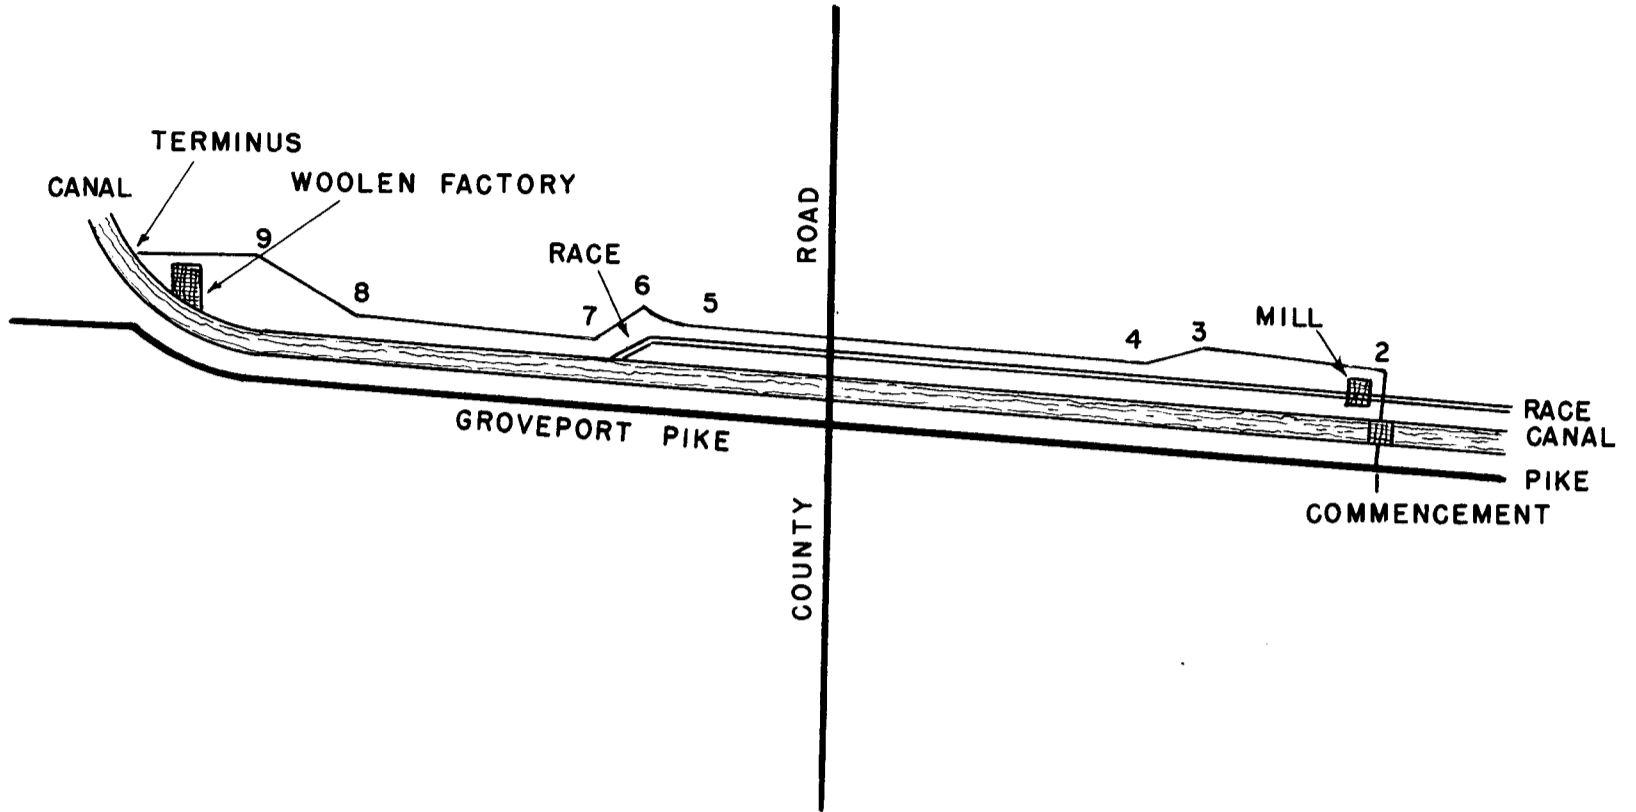

I HEREBY CERTIFY the foregoing notes to-gether with the plat to be correct.

John Cox Surveyor
for Chaney Alteration of Road.

AND BE IT REMEMBERED, That on the 4th day of September, A.D. 1871. It being the regular session of the Commissioners of Franklin Co. they took up and read the foregoing Surveyor's & Viewers Report for the 1st time.

AND that on the 5th day of September the same reports were read for the second time.

AND BE IT REMEMBERED, That on the 6th day of September, A.D. 1871, at their Regular Sept. Session, the Commissioners of Franklin Co., read for the 3rd time the above Viewers and Surveyor's report and being satisfied the Laws had been complied with in every respect. It was ordered that the alteration be made by the petitioners paying all expenses of same.

Auditor's Office, Franklin Co. O.
September, 6th. 1871

Sam'l E. Kile Auditor
and Clerk of Board.

ROAD RECORD NO. 9

ROAD RECORD NO. 9

PAGE NO. 66

J. H. MILLER ROAD.

(S. LINE CLINTON TP. TO THE S.W. CORNER THEREOF
W. ON THE S. LINE OF PERRY TP. TO THE CENTER OF
COL. & DUBLIN TPK.)

ROAD NOTICE.

NOTICE IS HEREBY GIVEN, That a petition will be presented to the Commissioners of Franklin County, Ohio, at their next session to be held on the first Monday of December, A.D. 1870, praying for the establishment of a County road sixty feet wide along the following described route in said County, to-wit: Beginning at a point in the center of the State Road leading from Franklinton to Delaware and in the south line of Clinton