

ROAD RECORD NO.9

ROAD RECORD NO.9

PAGE NO.104

JOHN LANDES. ALTERATION OF ROAD.

PLEASANT TP.

#####

ROAD NOTICE.

NOTICE IS HEREBY GIVEN, That a petition, will be presented to the Commissioners of Franklin County, O., at their regular session on the 1st Monday of March next, A.D. 1873, praying for the alteration or straightening of a County road, known as John S. Young Road" Beginning at the county line between the Counties of Franklin and Pickaway, at the South East corner of Pleasant Township; in the east line of Survey IO19 and terminating at the Shadesville Pike, at the Northwest corner of Jno. Linebaugh's land as was the true interest of the first petition for the establishment of said road.

Petitioners, Columbus, O., January, 30, A.D. 1873:

#####

STATE OF OHIO,) I, Robert H. Thompson being duly sworn, depose and say, that the notice of which a true Franklin County, ss.) copy is hereunto annexed, was published for four (4) weeks, in the Ohio State Journal, a newspaper printed in said County of Franklin, State of Ohio, and of general circulation there-in.

R.H. Thompson,

Sworn to before me, and signed in my presence, this 3rd day of March, A.D. 1873.

E. Clay Briggs, Notary Public.

#####

PETITION.

TO THE HONORABLE BOARD OF COUNTY COMMISSIONERS, FRANKLIN COUNTY, OHIO:

We, the undersigned residents, freeholders and Citizens of Pleasant and Jackson Townships in Franklin County, State of Ohio; being in the vicinity of the so called John S. Young road, respectfully represent to you that it was the true intent of the 1st petitioners for the establishment of said road and of the Viewers and Authorities establishing the same to place the center of said road on the survey line between Pleasant & Jackson Townships, which was also supposed to be the survey line between the different tracts of land adjacent to said road, and that there were some uncertainty at the time of the first view of said road, where said line actually were, and that the same uncertainty still exists now we, your petitioners, and part of us petitioners for the establishments of said road, in the first place respectfully pray your honorable board for a review and a re-survey of the entire route of said road beginning at the county line between the Counties of Pickaway and Franklin, at the South-east corner of Pleasant township and in the east line of Survey Number IO19. And terminating on the Shadesville Pike at the Northwest corner of John Linebaugh's land. Your petitioners ask that such proceedings may be had to establish said road as may be authorized and directed by Law.

(signed) John Landes, J.W. Woolman, L. Haines, and 16 others.

#####

BOND:

Page 105

KNOW ALL MEN BY THESE PRESENTS:

THAT WE, John Landes, John Linebaugh are held and firmly bound unto the State of Ohio, for the use of Franklin County, in the just and full sum of One Hundred Dollars, the payment of which, well and truly be made, we bind ourselves, our heirs, and etc jointly and severally, firmly by these presents.

Witness our Hands and Seals, this 3rd day of March, A.D. 1873.

THE CONDITION OF THIS OBLIGATION IS SUCH, That Whereas, the above bound John Landes, has petitioned the County Commissioners of Franklin County, O., for the alteration or straitning of a County road, known as the John Young Road, "for a full discription in petition"

Now, if the said John Landes, shall succeed in his said petition, then this obligation to be void and of no effect; otherwise to be in full force in law.

John Landes (SEAL) John Linebaugh (SEAL)

#####

VIEWERS AND SURVEYOR APPOINTED.

COMMISSIONERS OFFICE, FRANKLIN COUNTY, O. March, 5" 1873.

Commissioners Record, Page 74.

The Commissioners of Franklin County, after reading Road Petition, of John Landes et al, hereby appoint, John Rathmell, Christopher Strader & John Cummins and Josiah Kinnear Surveyor, to meet at the residence of John Landes on Monday, 21" day of April, 1873, at 10 o'clock A.M.

page 105

Samuel E. Kile; Auditor, Clerk of Board.

#####

VIEWERS REPORT.

TO THE COMMISSIONERS OF FRANKLIN COUNTY, O.

In obedience to your order issued at your March session, A.D. 1873, we the undersigned Viewers, appointed under said order, met with Josiah Kinnear Surveyor at John Landes on the 21st day of April, A.D. 1873, and were severally sworn to discharge faithfully and impartially the duties required of us in said order.

B.F. Timmons and Felix Fisher were selected by us as chain carriers and George Timmons as a Marker, who were also duly sworn:

We then proceeded to view said proposed Alteration on the line described in your order, and caused the same to be surveyed, as prayed for in the petition, or as near the same as in our opinion a good road can be made at a reasonable expense, taking into consideration the utility, convenience, and inconvenience, and expense, which will result to individuals, as well as the public, by the alteration of said road, as follows:

Page 106

Beginning at a stake in the line of Pickaway and Franklin Counties; thence with the survey line of Survey No. 1019, N. 3 $\frac{3}{4}$ ^o E 301 Poles to a stone corner common to survey No. 1294, 1019, 6178 & 1365 of the Virginia Military District; thence with the survey line of Surveys Number 6178 & 1365 N. 3^o 40' E. 427 Poles. Thence N. 7 $\frac{3}{4}$ ^o W. 4160 poles to a stone in the Lockbourne Road. Whole distance being 728 poles.

We would respectfully report that the said alteration ought to be made, for the following reasons: That the general convenience and appearance of the road, and farms, in general would be improved by the change of said road:

We have also determined that the public convenience requires that such road shall be established forty (40) feet in width.

All of which is respectfully submitted:
 May, 21st 1873

John Rathmell)
 C. Strader) VIEWERS.
 John Cummins)

#####

FEEES.

John Rathmell	3 ds.	4.50
John Cummins	3 days	4.50
C. Strader	3 days	4.50
B.F. Timmons, Chainman,	2 ds.	2.00
Felix Fisher	2 days	2.00
Geo. Timmons	2 ds.	2.00
Josiah Kinnear	4 days @	5.00 -- \$20.00
G. Tomerson, Flagman	2 ds.	2.00
Chas. Schneider	2 days	\$2.00

#####

SEPARATE REPORT OF VIEWERS.

TO THE COMMISSIONERS OF FRANKLIN COUNTY, OHIO:

We, the undersigned Viewers, on the Landes Road petitioned for by John Landes et al, make the following separate report of the compensation and damages assessed and awarded by them to persons entitled there-to. The parties named below have filed their written applications for the said allowance, according to law, and the same are hereto appended and returned with this report.

Compensation for Land taken for said road has been awarded in the following sums:

Peter Kingery	\$ 10.00
George Francis	\$ 12.00
Stanford Smith	\$ 18.00
L.W. Sifrit	\$ 5.00

Each of the above sums have been assessed without deduction for benefits to any property of the owners, which would accrue by the opening of said road:


The following sums are allowed as damages, to be paid to claimants, whose premises will be rendered less valuable by the opening and construction of said road through the same:

Peter Kingery	\$ 60.00
Stanford Smith	\$ 25.00 DOLLARS;

May, 21st 1873.

John Rathmell) VIEWERS AND
 C. Strader) JURORS TO
 John Cummins) AWARD DAMAGES.

SEE PLAT ON NEXT PAGE

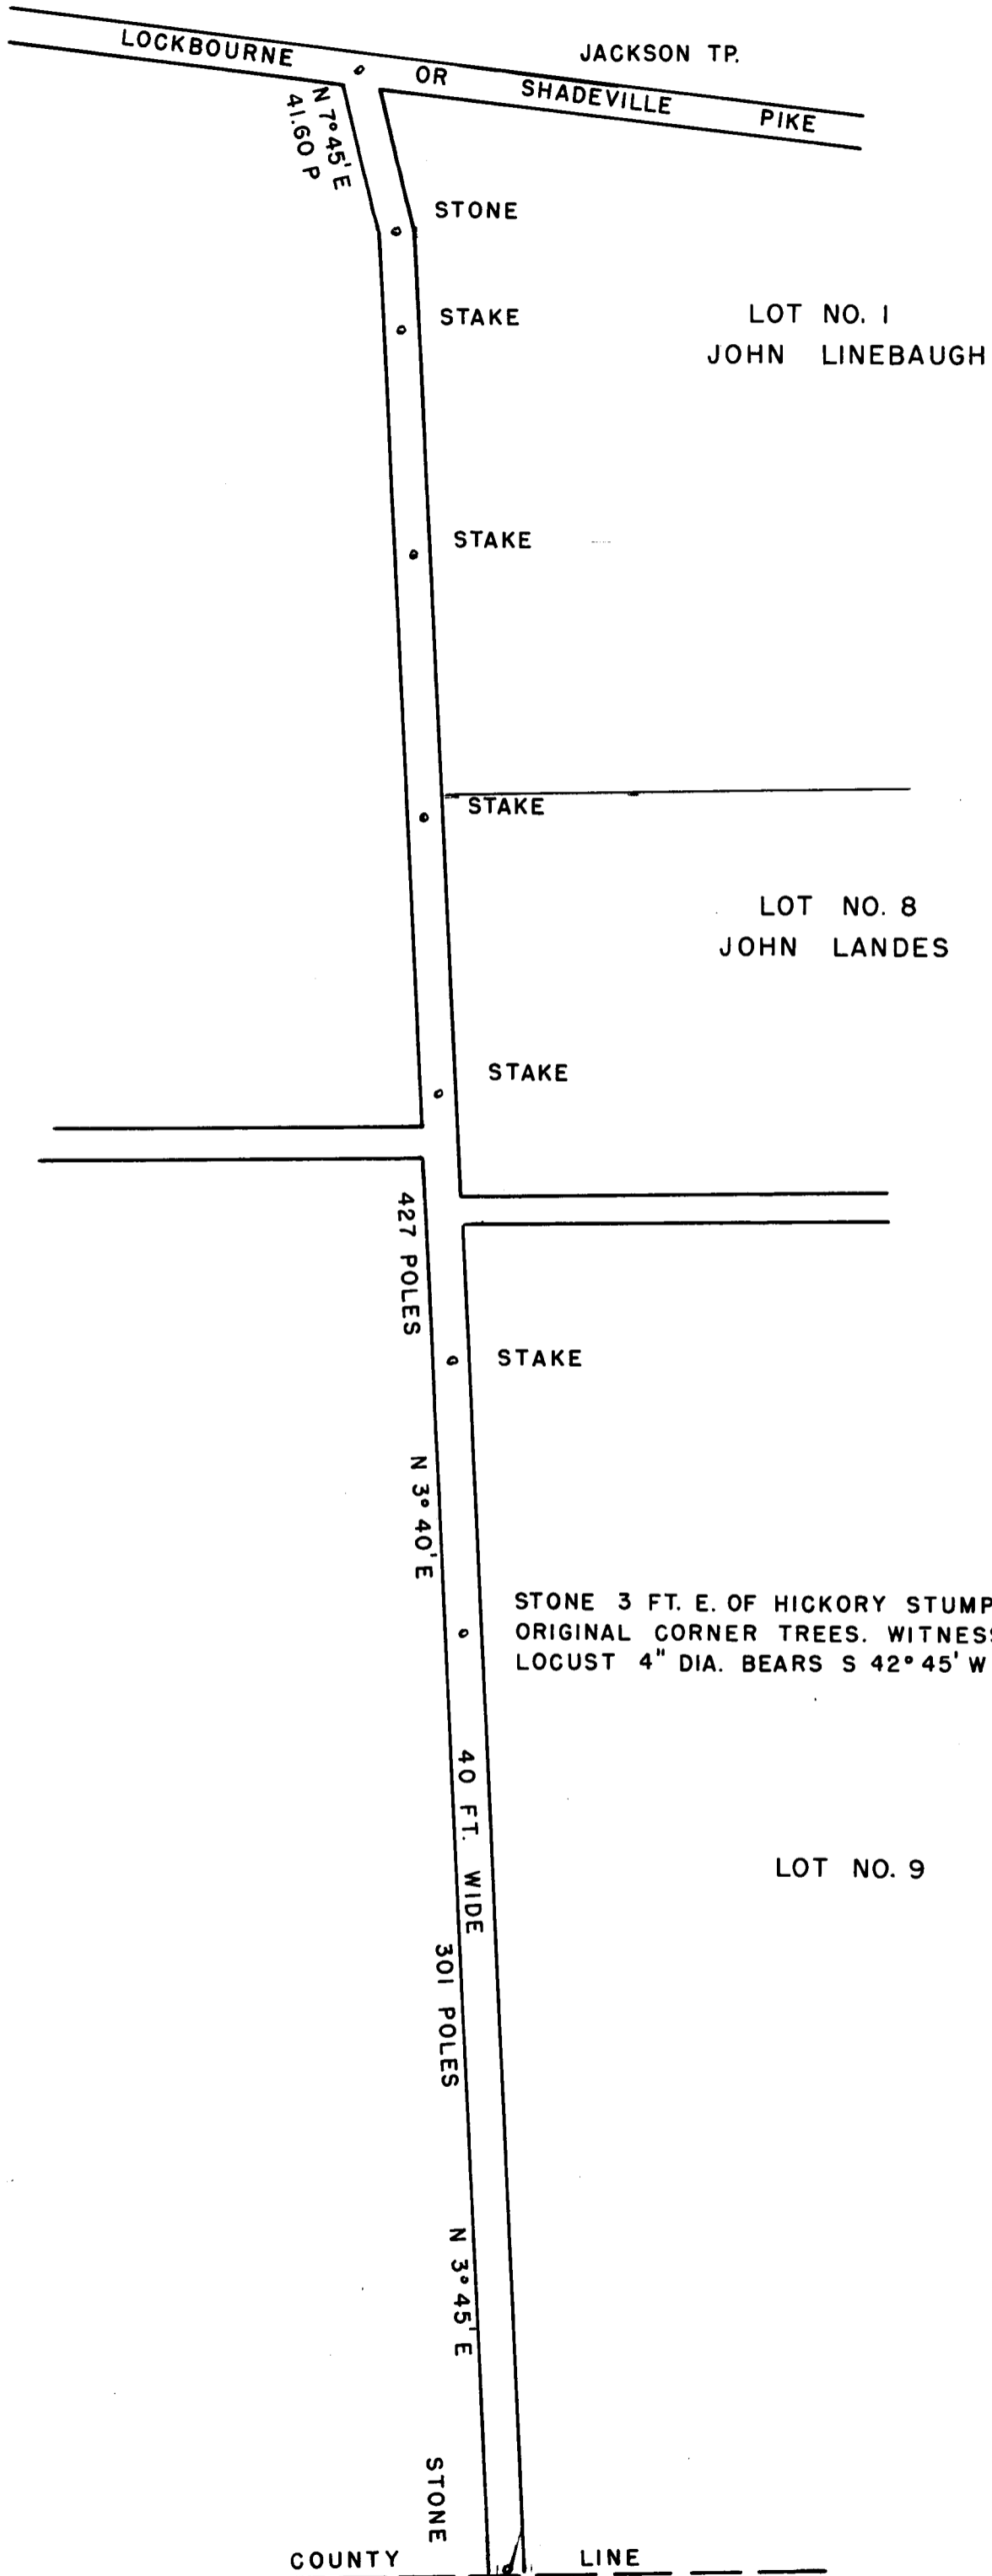

#####

COMMISSIONERS OFFICE,
Franklin County, O., June 2nd. 1873

Page 108

The petition of John Landes and others for the alteration of a road in Pleasant and Jackson Tp., was taken up and read the 1st. time:

Com's. Record P. 95.

###

COMMISSIONERS OFFICE,
Franklin County, O., June 3rd 1873,

The petition of John Landes and others, for the alteration of a road in Pleasant and Jackson Townships, was taken up and read the Second time:

Com's. Record P. 96.

###

COMMISSIONERS OFFICE,
Franklin County, O., June 4th. 1873,

The Viewers report on road petitioned for by John Landes and others, was taken up and read the third time.

When on motion of Com's Bruck to adopt the report and order the establishment of the road, on condition that the petitioners pay all compensation and damages on or before the 1st day of September next. Com's Hibbs called for a division of the questions, which was granted. The establishment of the road was then passed by a unanimous vote, and on the passage as to paying compensation and damages by the petitioners the vote was Bruck and Cooper, 1ea and Hibbs no. There-upon the chain men declared the ingential motion passed and adopted:

Commissioners Record Page 97.

Samuel E. Kile, Auditor,
Clerk of Board.

#####

#####

ROAD RECORD NO. 9

ROAD RECORD NO. 9

PAGE NO. 109

PETER JOHNSON, ROAD:

PLEASANT TP.

#####

ROAD NOTICE.

NOTICE IS HEREBY GIVEN, That a petition will be presented to the Commissioners of Franklin County, at their next session to be held on the 1st Monday of December, A.D. 1872, praying for the establishment of a County road along the following described route in said County, to-wit:

Beginning on the Township line between Pleasant & Prairie Townships in the center of Opposum Run Road, and thence in a westerly course with said line, along the line of Henry Lavelly and D. Peters land to Peter Johnson's land, and in the road already in use; thence same course along the lines of G. Suver, W. Ray, A. Mang, G. W. Ray, A. Smith, Charles Rable and William Scott's land to the center of a county road leading to the Georgesville Road, in Pleasant Tp., near Wm. Scotts residence;

Oct. 14, 1872

#####

STATE OF OHIO,) I, S.M. Smith Jr. being duly sworn, depose and say, that the notice of which a true Franklin Co. O. ss.) copy is hereto attached, was published for six weeks in the Ohio State Journal, a newspaper printed in said County of Franklin, State of Ohio, and of general circulation therein.

S.M. Smith, Jr.

Sworn to before me, and signed in my presence, this 2nd day of December, 1872.

E. Clay Briggs, Notary Public.

#####

PETITION.

TO THE HONORABLE BOARD OF COUNTY COMMISSIONERS, FRANKLIN COUNTY, O:

Your petitioners resident freeholders of said County, respectfully represent, that the public convenience requires a county road along the following described route, to-wit:

Beginning on the Township line between Pleasant & Prairie Townships in the center of the Opposum Run Road. Thence in a westerly course with said line, along the line of Henry Lavelly and David Peters land to Peter Johnson's land; thence through said Johnson's land, and on a road already in use. Thence in same