

ROAD RECORD NO.9

ROAD RECORD NO.9

PAGE NO.II8

A.J.O'HARRA.ROAD.

PRAIRIE TP.

TO THE COMMISSIONERS OF FRANKLIN COUNTY,OHIO:

YOUR PETITIONERS,freeholders,respectfully petition your honorable body to lay out and establish,a County road; Commencing in the town of Galloway in said County and State,on Main Street,at a point north of the Columbus and Springfield and Cin. Rail Road; running thence,west through the lands of Rosaline Smith,97 Rods and America Davis 18 Rods to the S.E.Corner of lands of J.W.Young, (known as the Bennett Survey,) Thence west with the line of J.W.Young and America Davis 228 Rods to the Alton and Harrisburg road.

Galloway,O., April,1<sup>st</sup> 1873

( May 3-4 times.)

## ## ##

STATE OF OHIO, ) I,W.H.Moore being duly sworn,depose and say that the notice of which a true copy is here-  
Franklin Co.ss.) unto attached,was published for four consecutive weeks in the Ohio State Journal,a newspaper printed in said County of Franklin,State of Ohio,and of general circulation therein.

W.H.Moore,

Sworn to and signed in my presence,this 2nd day of June 1873.

L.E.Wilson, Notary Public.

Printers Fees \$ 3.00  
Affidavit .40¢

#####

BOND.

KNOW ALL MEN BY THESE PRESENTS:

That we,A.J.O'Harra,Rosaline Smith and Franklin Postle,are held and firmly bound unto the State of Ohio, for the use of Franklin County in the just and full sum of One Hundred Dollars,the payment of which,well and truly be made,we bind ourselves,our heirs etc etc jointly and severally,firmly,by these presents.

Witness our Hand and Seals,this 2nd day of June,A.D.1873.

THE CONDITION OF THIS OBLIGATION IS SUCH, That Whereas the above bound A.J.O'Harra,R.Smith & F.Postle, has this day petitioned the County Commissioners of Franklin County for a Road, "Described fully in Petition."

Now,if the said A.J.O'Harra shall succeed in his said petition,then this obligation to be void and of no effect; otherwise to remain in full force in law.

A.J.O'Harra (SEAL)  
Rosaline Smith (SEAL)  
Franklin Postle (SEAL)

### ### ### ###

VIEWERS APPOINTED.

Page II9

The petition of A.J.O'Harra,and others,for the establishment of a County Road in Prairie Tp.,was taken up and the following persons were appointed Viewers,viz:

James K.Lowe,Jesse Alkire and J.M.Briggs,Josiah Kinnear,Surveyor,to meet at Galloway Station,on Tuesday July 22nd next.

Commissioners Record,Page,96-97

Wm. Cooper, )  
J.P.Bruck. ) Co. Com's.

#####

PETITION.

TO THE COMMISSIONERS OF FRANKLIN COUNTY,OHIO:

Your petitioners,freeholders,respectfully petition your honorable body to lay out and establish a County road.

Commencing in the town of Galloway,in said County and State,at Main Street,at a point north of the Columbus,Springfield and Cincinnati Rail Road; running thence west through the lands of Rosaline Smith,97 Rods and America Davis 18 Rods to the South east Corner of lands of J.W.Young, (known as the Bennett Survey) Thence west with the line of J.W.Young and America Davis 228 Rods to the Alton and Harrisburg Road.

A.J.O'Harra John Lavelly, Geo.W.Ray, Milton Demorest,  
Martin Suver, W.J.Brooks, Walter Burton, J.W.Young,  
W.H.Neer, America Davis, Henry Lavelly, Rosaline Smith,  
Clinton Davis, A. Wade.

#####

REPORT OF VIEWERS.

TO THE COMMISSIONERS OF FRANKLIN COUNTY ,OHIO:

In obedience to your order issued at your June session, A.D. 1873, we, the undersigned, Viewers, appointed under said order, met with Josiah Kinnear Surveyor, at Galloway Station, on the 22nd day of July, 1873 and were severally sworn to discharge, faithfully and impartially, the duties required of us in said order, J.M. Briggs, one of the Viewers appointed by your body being unable to attend, we selected David S. Stranahan to fill the vacancy, Jesse Alkire and David Stranahan were selected by us, as chain carriers, and J.K. Lowe, as a marker, who were also duly sworn.

We then proceeded to view said proposed County Road, on the line described in your order and caused the same to be surveyed as prayed for in the petition, or as near the same as in our opinion, a good road can be made, at a reasonable expense, taking into consideration the utility, convenience, and inconvenience, and expense which will result to individuals as well as the public, by the establishment of said road as follows:

Beginning at the center of the Alton Road. Thence south  $87\frac{3}{4}$ ° E. along the line of Wheeler Young & Davis Heirs land, at 194 poles, crossing Darby Big Run at 225 poles, passed corner, common to Davis Heirss east line. Thence South 89° E. 7130 poles, through Rosline Smith's land, to the west line of Galloway. Thence parallel with the lot of Galloway and through the center of lot number to a street 30 feet wide, the whole distance being 326.80 poles to terminus.

Page 120

We would respectfully report, that the said County road, ought to be established, for the following reasons:


The public require the same as a highway, to and from the R.R. Station.

We have also determined that the public convenience requires that such County road, shall be established forty feet in width. All of which is respectfully submitted.

J.K. Lowe )  
 Jesse Alkire ) VIEWERS.  
 David Stranahan )

# ##### #

PLAT OF A.J.O'HARRA ROAD.

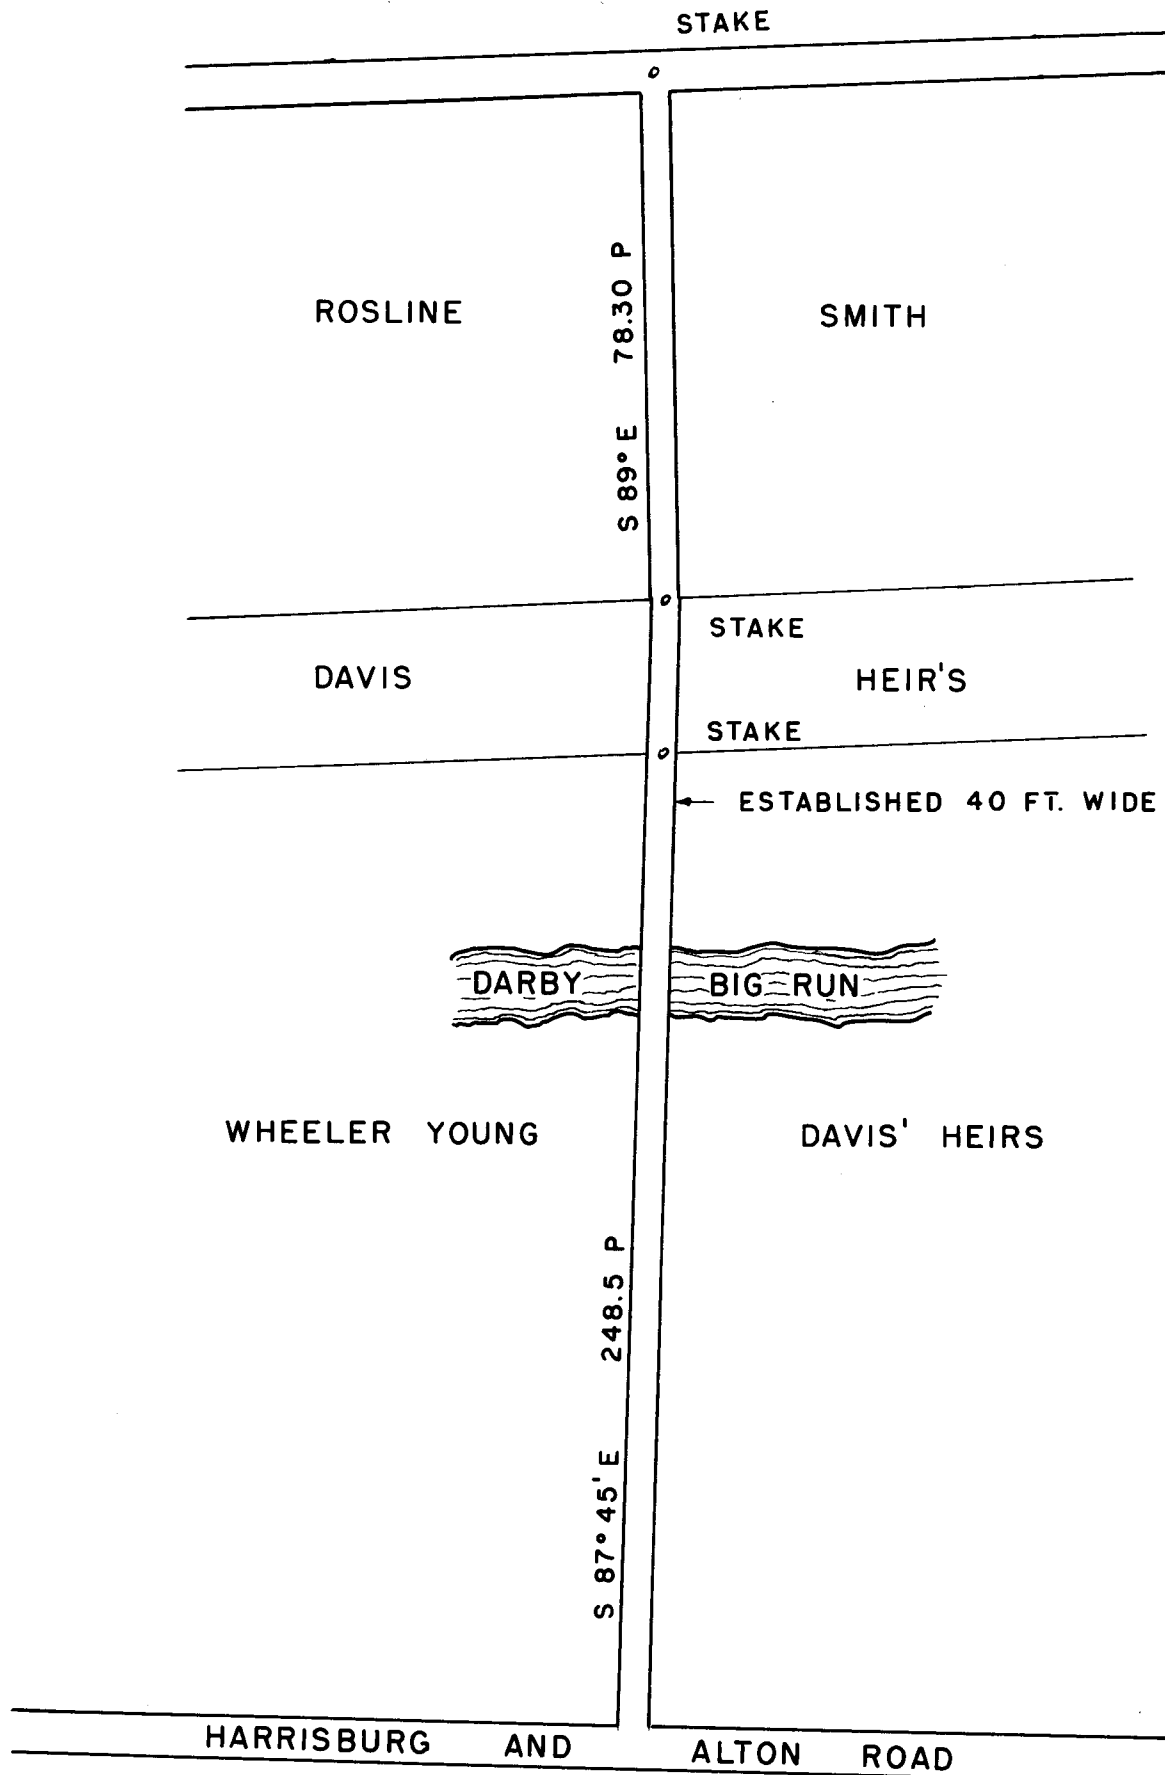

TO THE COMMISSIONERS OF FRANKLIN COUNTY, O:

The undersigned in obedience to your order dated June 1873, proceeded on the 22nd day July to survey and mark the County road described in said order, under the direction of Viewers therein named, and respectfully submits the following return of survey"

Josiah Kinnear, Surveyor of said road.

#####

COMMISSIONERS MINUTES, REGULAR SEPT. SESSION.  
PAGE 120

The Viewers report of a road petitioned for by A.J.O'Harra et al, was taken up and read the 1st time.

Wm. Cooper )  
J.P.Bruck.. ) Co. Com's.

#####

COMMISSIONERS RECORD, PAGE 121. SEPT. REGULAR SESSION

The Viewers report of a road petitioned for by A.J.O'Harra and others, was taken up and read the 2nd time.

Wm. Cooper )  
J.P.Bruck )

#####

COMMISSIONERS RECORD, PAGE 123, SEPT. REGULAR SESSION.

The Viewers report on the road petitioned for by A.J.O'Harra and others, was taken up and read the 3rd time. There being no remonstrance, or objection against the location of said road, the same was ordered to be established by a unanimous vote of the Board. And the Auditor was ordered to notify the Trustees of Prairie Tp., to cause said road to be opened.

Wm. Cooper )  
J.P.Bruck ) Co. Com's.

####

####

ROAD RECORD NO.9

ROAD RECORD NO.9

PAGE NO.122

JOSIAH KINNEAR, ROAD.

CLINTON TP.

#####

ROAD NOTICE.

NOTICE IS HEREBY GIVEN, That a petition will be presented to the Commissioners of Franklin County, at their next regular session June 1873, praying for the location of a County road, on the following line, to-wit:

Beginning at a stone in a County road running along the line between the lands of Chas.W.Hess & Jeremiah O.Lisle, also southwest corner of said J.O.Lisle Home Farm. Thence in a southerly direction in a straight line with a road running north from said point to intersect the south line of Elizabeth Lisle's land, also north line of land of E.M.Lisle's Hrs. Thence from said point in an easterly course with the line between the lands of Elizabeth Lisle and E.M.Lisle's Heirs, to a stone in the Columbus and Delaware Road, on the west side of the Olentangy River, said stone being the common corner to lands owned by E.M.Lisle's Heirs, Josiah Kinnear, Edward Delashmutt, and John Walsh, also from the point of intersection with said proposed line above mentioned in a westwardly course with Elizabeth Lisle's south line to a stone in the east line of Daniel Lakin's Home Farm.

April, 28<sup>th</sup> A.D. 1873

30-Law-4 W.

#####

STATE OF OHIO, ) William Trevitt, Jr., being duly sworn, deposes and sayeth, that the Notice of which a true Franklin Co. ss.) copy is hereunto attached was published in the DISPATCH a newspaper printed and in general circulation in said County for four consecutive weeks from and after the 29<sup>th</sup> day of April 1873.

William Trevitt, Jr.

Sworn to and subscribed before me, this 2nd day of June 1873, as witness my Hand and Seal of Office.

Printers Fee \$ 4.00  
Affidavit .25¢

A.J.Martin J.P.  
in and for Franklin Co.O.

#####

PETITION.

TO THE HONORABLE BOARD OF COMMISSIONERS, FRANKLIN COUNTY, OHIO.  
Clinton Tp., Franklin Co.O.  
April, 7<sup>th</sup> 1873

Gentlemen: We, the undersigned resident, freeholders, of said township, ask your honorable body for the location of a County road; Beginning at a stone in a County road running along the line between the lands of