

ROAD RECORD NO.10

ROAD RECORD NO.10

PAGE NO.505

LEWIS EACHIN(ROAD)

IN THE MATTER OF THE FINDING OF THE LINE OF EACHIN'S
ROAD PETITIONED FOR BY TRUSTEES JACKSON TP. AND OTHERS
IN JACKSON FRANKLIN COUNTY, OHIO.

Hoover Road - resurvey to put the road back on the original
survey line from the County line to London-Groveport Road

ROW = 50'

ROAD PETITION.

FOR THE FINDING OF LINE OF EACHIN'S ROAD IN JACKSON TOWNSHIP.

TO THE BOARD OF COMMISSIONERS OF FRANKLIN COUNTY, OHIO:

The undersigned petitioners, resident freeholders of said County, respectfully represent that the public convenience requires the finding of line of a County road on the line hereinafter described; and pray that your body will institute and order the proper proceedings in the premises to find and establish line of such road, to-wit: Between the Pickaway County line and the northwest corner of Madison Ford's line is uncertain by reason of the removal and decay of the monuments and marks by which it was originally designated.

Wherefore your petitioners ask your Hon. Board that such proceedings may be had to find and mark said road as are provided by law.

(Sec. 4654)
Revised Statutes.
Filed this 23d August A.D.1890

PETITIONERS' NAMES.
James Harper

PETITIONERS' NAMES.

PETITIONERS' NAMES.
E.Ed.Miller
A.Borrer, Jr.

Albert S.Miller Supervisor of District No.2

TRUSTEES) Jacob Hayden
) W.L.Seeds.

Which bond is accepted and approved. And it appearing that the foregoing petitioners have fully complied with the law in regard to the said petition, it is ordered that Benjamin L. Rees, Joseph M. Briggs and Adam Yearling three disinterested freeholders of Franklin County, Ohio, be and they are hereby appointed Viewers, and John J. Dun Surveyor of said road and that they meet at _____ on the _____ day of _____ at ten o'clock A.M., and after being duly sworn, proceed to the discharge of the duties of their several appointments, according to law. It is further ordered, that the County Auditor issue the necessary order to the said Viewers and Surveyor, and that said Viewers and Surveyor report their proceedings in the premises to this Board, at its next regular session.

Whereupon the County Auditor issued to said Viewers and Surveyor the following order, viz:

AUDITOR'S OFFICE, FRANKLIN COUNTY, OHIO.
COLUMBUS, Aug't. 27th. 1890

Benj. L. Rees)
Joseph M. Briggs) VIEWERS.
Adam Yearling)

John J. Dun SURVEYOR.

Gentlemen: You were appointed by the County Commissioners of Franklin County, Ohio, to view and lay out a proposed finding of true course of Eachin Road on the following route, as petitioned for by Trustees of Jackson Tp. et al.

You will therefore meet on the 9th day of Sept. 1890 at the place designated as the beginning of said road or alteration, and after taking an oath or affirmation, faithfully and impartially to discharge the duties of your appointments respectively, you shall take to your assistance two suitable persons as Chain Carriers, and one Marker, and proceed to view, survey and lay out said road, or alteration, as prayed for in the above petition, or as near the same as in your opinion a good road can be made at a reasonable expense; taking into consideration the utility, convenience and inconvenience, and expense which will result to individuals, as well as to the public. And said Viewers shall, in addition to their duties as Viewers, also at the same time assess and determine the compensation to be made to the owners of the land across which the road is to be located, and the damages sustained by any person or persons through whose premises the road is proposed to be established; and the said Viewers shall make and sign a report in writing, stating their opinion in favor of or against the establishment or alteration of said road, or any part thereof, and set forth the reasons of the same; which report, together with the plan and survey of said road or alteration, shall be delivered to the County Auditor by one of the Viewers on or before the first day of our session in _____ next. Said Viewer shall also determine the width of said road, which cannot be more than 60 feet wide.

AND FURTHER, it shall be the duty of the Viewers aforesaid, at the same time at which they are required to make their report of the view, to make a separate report in writing, stating the amount of the compensation to be made to the owners of the land across which the road is to be located, and the damages, (if any,) and to whom, which by them have been assessed, and be further governed under this order by the provisions of the statute in such case made and provided.

By Order of the Commissioners,

F. J. Reinhard County Auditor.
Harmon Dpy.

CERTIFICATE OF MAKING OATH.

THE STATE OF OHIO,) BE IT REMEMBERED, That on this 2d day of October 1890 A.D. 1890, personally appeared Franklin County, ss.) ared before me, a Notary Public in and for said County. G.S. Innis Surveyor appointed by the Commissioners of Franklin County, Ohio to survey and mark the true course of the Lewis Eachin Road in Jackson township said County petitioned for by James Harper and others, and were by me duly sworn to the faithful and impartial performance of their respective duties.

Nebjamin Monett
Notary Public Franklin County, Ohio

SURVEYOR'S REPORT.

TO THE BOARD OF COMMISSIONERS OF FRANKLIN COUNTY, OHIO:

The undersigned in obedience to your order dated August 27th 1890, proceeded, on the 3d and 22d days of October 1890 to survey and mark the center line of the _____ County road described in said order, under the direction of the Viewers therein named, and respectfully submits the following return of said survey:

(SE PLAT AT END OF RECORD.)

REPORT OF VIEWERS.

TO THE BOARD OF COMMISSIONERS OF FRANKLIN COUNTY, OHIO:

In obedience to your order, issued at your Aug't. 27/90 session, A.D. 1890, we, the undersigned, Viewers appointed under said order, met with G.S. Innis Surveyor, at James Harper's on October 3d/90 and were severally sworn to discharge, faithfully and impartially, the duties required of us in said order.

Adam Yearling failing to appear, Levi Bauingartner was appointed to fill the vacancy as provided by statute.

Taylor Braskett and Charles Donaldson were selected by us as chain-carriers and Moses Timens and Fred Shover as Helpers, who were also duly sworn.

We then proceeded to find and mark said road as provided by law and on the line described in your order, and caused the same to be surveyed, as prayed for in the petition, as follows:

Beginning at a point in the Franklin and Pickaway County line and at an old stone in which point we set a dressed or cut limestone and drilled a hole in its center and placed broken glass ware and queenswan under it. We then ran the route of the said Lewis Eachin's road as follows: Thence N 5° 29' E. 15.46 chains and set another cut limestone similar to the stone above described with like material under it, near

the graveyard; thence N 40-10' E. and ran 36.89 chains, and set a cut lime stone and marked it in all particulars like the stone first set by us, said stone being in line with a stone set by B.F. Bowen County Surveyor of Franklin County, Ohio, and continued same course running 60.42 chains from the East angle at the stone near the graveyard to a point 0.48 poles west of a stone set by Josiah Kinnear County Surveyor, as the north east corner of the Morgan Survey No. 1294 of the V.M.D and there set another cut limestone and marked in all particulars, like said first stone set by us. Thence N 1 45' E 37.43 chains to a stake in the north west corner of J. Madison Ford's land, and same course 19.35 chains from said stake and set a cut lime stone and marked it and put material under it, just like the said first stone set by us in the said County line, said last mentioned stone being in the center of the Hoover road.

We would respectfully report that the said road ought to be fifty feet wide as originally established, which we believe to be sufficient for the public convenience.

All of which is respectfully submitted,
Oct. 25th. 1890)

Jos.M.Briggs)
Ben L.Rees)VIEWERS.
Levi Bauingartner)

FEEES.

G.M.Briggs (Paid) Viewer, 8 days, \$ 12.00
B.L.Rees " " 8 " \$ 12.00
Levi Bauingartner Pd " 8 " \$ 12.00
5 cut limestones 1.00-5.00
Mare Horse and wagon
delivering same. 4.00
\$ 9.00

Taylor Braskett Chainman, Pd 1 days, \$ 1.00
Chas. Donaldson " pd 1 " \$ 1.00
Al Linton ass't. -----Pd. 2 " \$ 3.00
Cook-----"----- pd 1 " \$ 1.00
Moses Timens Pd Marker. Pd. I " \$ 1.00
Fred Shover " Pd I " \$ 1.00
J.M.Briggs Chainman Pd I " \$ 1.00
B.L.Rees " Pd I " \$ 1.00

G.S. Innis Pd. Surveyor, 5 days, \$ 25.00

John J. Dun Expenses.
Severcis as Engineer 5 days \$ 25.00
" " Asst. " 1.50 Pd.

COLUMBUS, OHIO, Dec. 1st 1890

The Commissioners met in regular session, and the report of the Surveyor and Viewers appointed to survey and view the road, as described in the foregoing petition, was read the first time.

ATTEST:
F.J. Reinhard)
County Auditor.
by B.H. Harmon Dpy.

COLUMBUS, OHIO, Dec. 2^d. 1890

The Commissioners met in regular session, and the report of the Surveyor and Viewers appointed to survey and view the road, as described in the foregoing petition, was read the second time.

ATTEST:
F.J. Reinhard)
County Auditor.
by B.H. Harmon Dpy.

COLUMBUS, OHIO, Dec. 3^d. 1890

The Commissioners met in regular session, in the matter of the petition of the Trustees of Jackson township, et, al, for the finding of the true course of the Lewis Eachin's County road in Jackson township.


The Viewers having reported in favor of the establishment etc of said road, said report was this day publicly read for the third time, and it appearing that the distance of said road will not be increased to the injury of the public by the change in the same proposed by the petitioners, that said alteration will not place said road on worse ground than it at present occupies, and that in their opinion said alteration ought to be granted, and the Board Concurring in said opinion. It is ordered that said road be established in all respects as originally laid out and reported by the viewers, that the proceedings had in the premises with the report of the viewers, and the plat and survey, of said alteration be recorded.

Ordered that the Auditor notify the Trustees of Jackson township of the action of this.

ATTEST:
Frank J. Reinhard, County Auditor.
by B.H. Harmon Dpy. Aud't.

) County Comm'rs.
) of
) Franklin County, Ohio.

PLAT OF CHANGE OF ROAD.

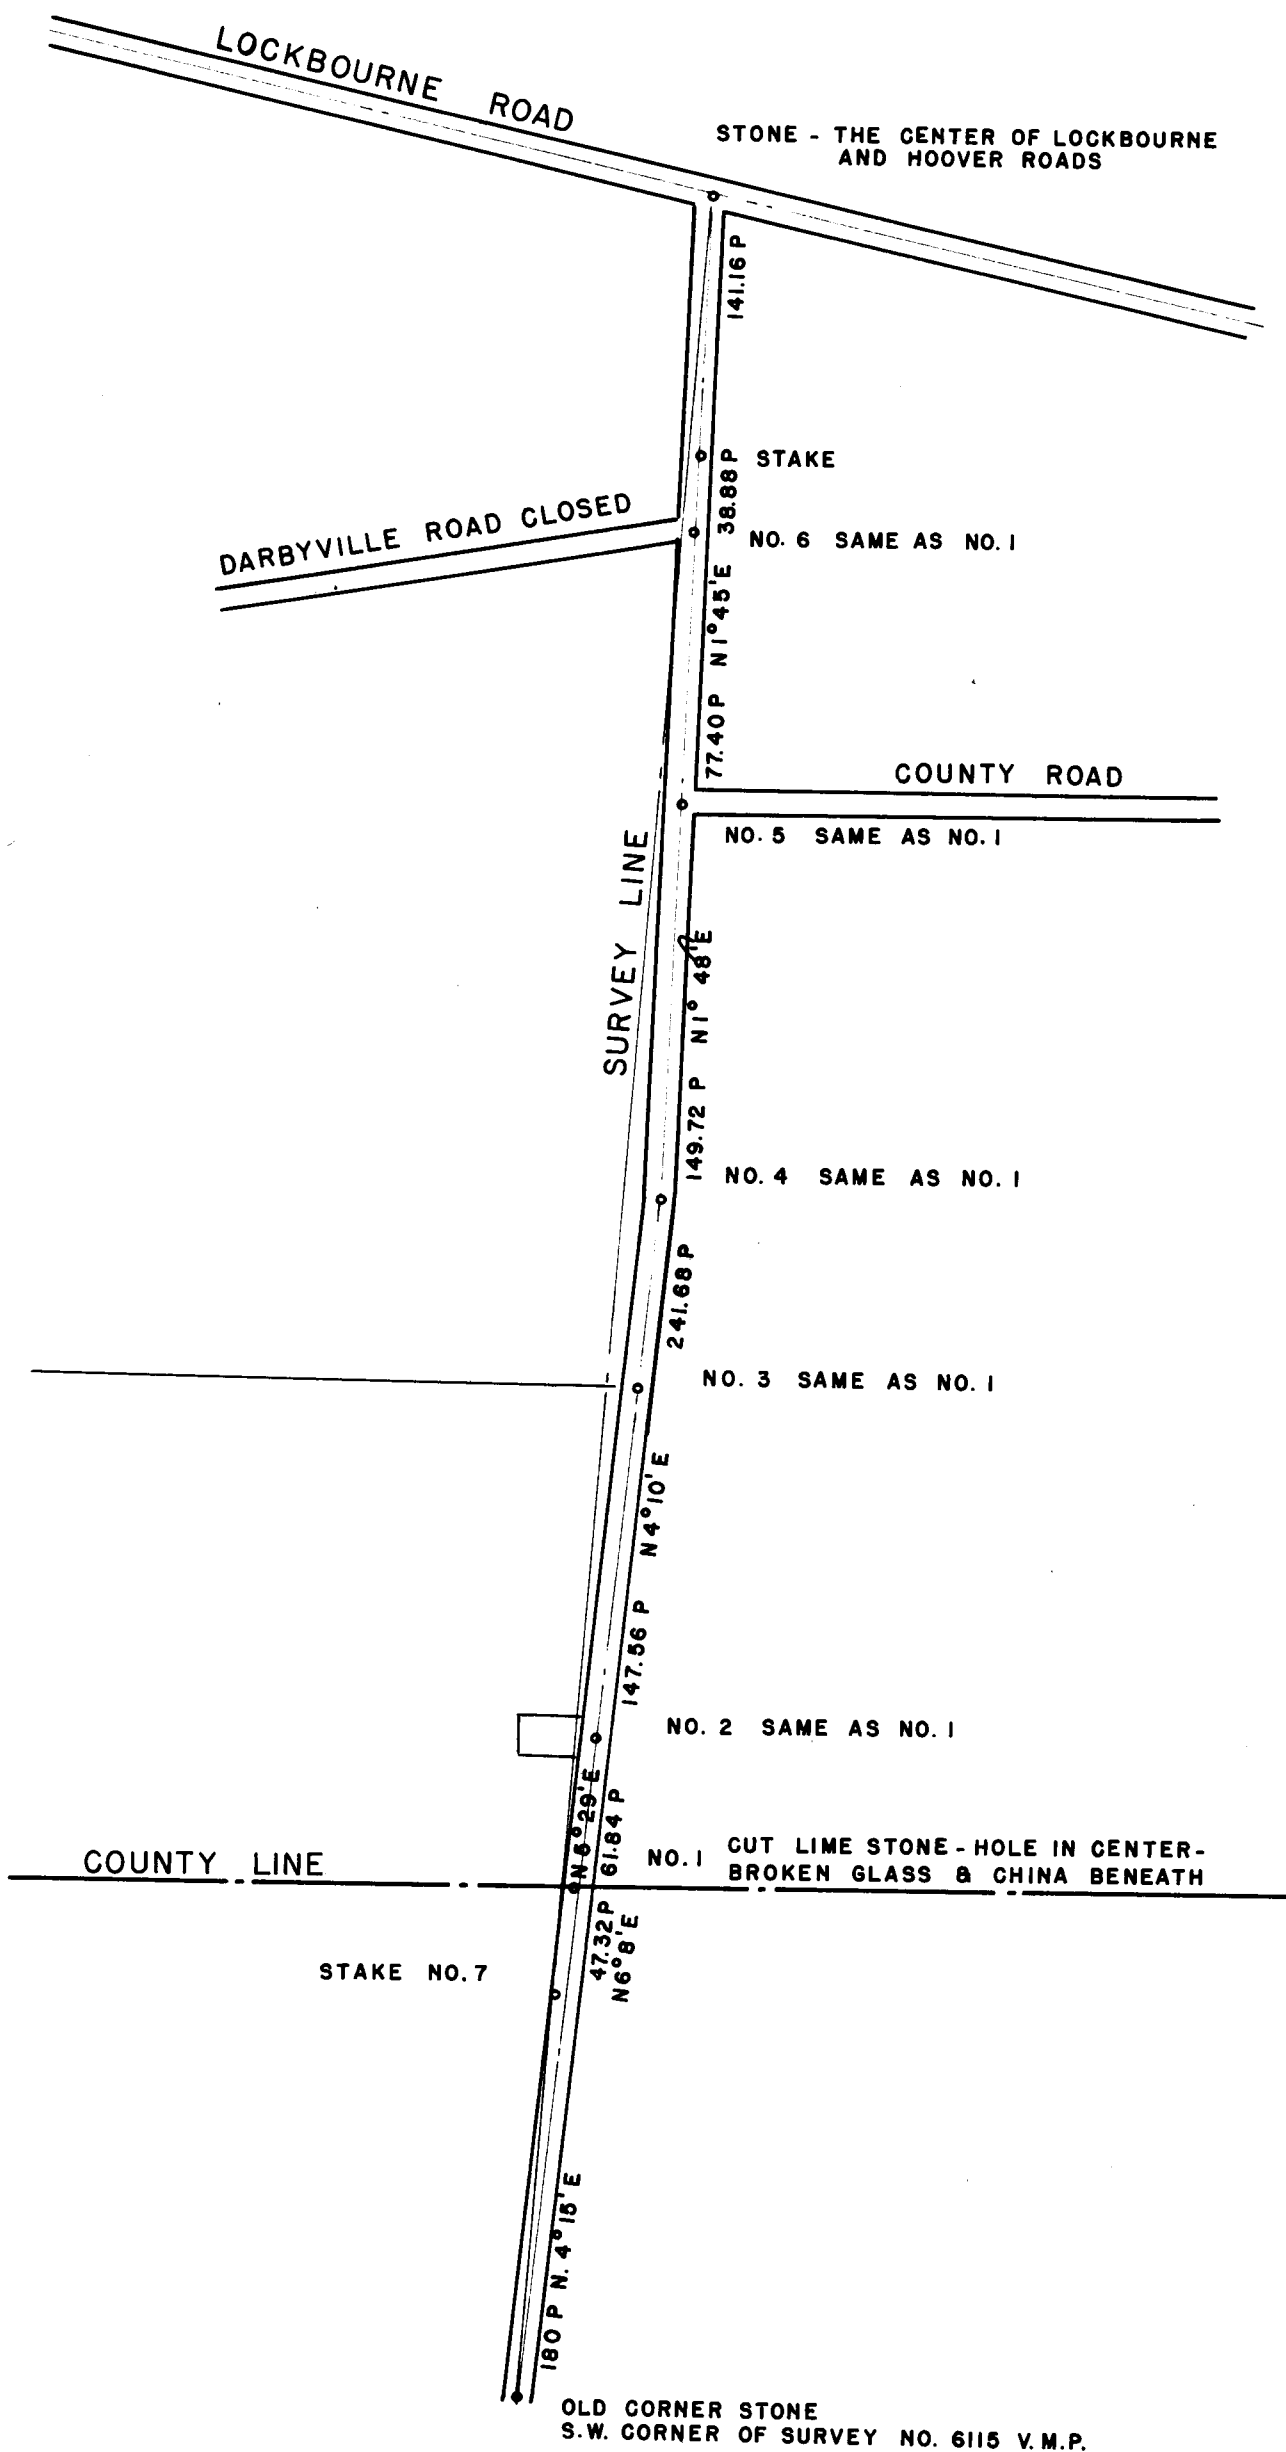

I CERTIFY that the above is a correct plat and return of the survey of the Louis Eachns County Road named above.

G.S. Innis Surveyor of said County Road.