

ROAD RECORD NO. II

ROAD RECORD NO. II

PAGE NO. 185

IN THE MATTER OF THE COUNTY ROAD PETITIONED FOR BY
S. MANN AND OTHERS IN JEFFERSON TOWNSHIP, FRANKLIN
COUNTY, OHIO.

Mann Road - from Havens Road to Clark State Road

ROW = 30'

ROAD NOTICE.

NOTICE IS HEREBY GIVEN, That a petition will be presented to the Commissioners of Franklin County, at the next session, Friday, October, 27th A.D. 1893, praying for the Establishment of a County Road on the following line, to-wit: Beginning at and in the center of a County road and at the present terminus of the Shuah Mann road so called and at the four corners of land owned by Abraham Staggs heir's, northwest corner and the Southwest corner of land owned by W.F. Havens heir's, the northwest corner of land owned by Shuah Mann and the southwest corner of Marcus Mann's land and running from thence north from said center of said four corners One hundred rods, more or less on the line of lands owned by W.F. Havens heirs and Marcus A. Mann to the corner of the Columbus and Jersey road and being the road leading from Gahanna to Headley's Corners, said road petitioned for is in Jefferson Twp., Franklin Co. O. And is a continuation of the said Shuah Mann road.

S. Mann

September, 20th A.D. 1893

AFFIDAVIT THAT COPIES OF THE ABOVE NOTICE WERE DULY POSTED UP.

THE STATE OF OHIO,) Shuah Mann having been first duly sworn states that on the 20th day of September
 Franklin County, ss.) 1893, and at least thirty days before Oct. 27, 1893, he set up copies of the foregoing
 notice at the Auditor's Office, in said County, and at three public places in the township of Jefferson in
 which said road is proposed to be laid out and established.

(signed) Shuah Mann

Sworn to and subscribed before me, this 27 day of October, A.D. 1893

B.H. Harmon, Dpty. Co. Aud'r.

AFFIDAVIT OF PRINTER.

THE STATE OF OHIO,) I, F.M. Lippitt being duly sworn, depose and say, that the foregoing notice was
 Franklin County, ss.) published one time a week for four consecutive weeks, prior to the 27th Oct. A.D.
 1893, in Daily Press a newspaper printed in said County of Franklin, State of Ohio, and of general circula-
 tion therein, and that the first publication was made Sept. 22, 29 Oct. 6, 12, A.D. 1893

F.M. Lippitt.

Sworn to before me, and signed in my presence, this 27th day of October, A.D. 1893

Daniel H. Sowers, Notary Public.

ROAD PETITION.

FOR A COUNTY ROAD IN JEFFERSON TOWNSHIP.

TO THE BOARD OF COMMISSIONERS OF FRANKLIN COUNTY, OHIO:

The undersigned petitioners, resident freeholders of said County, respectfully represent that the public convenience requires the Establishment of a County road on the line hereinafter described; and pray that your body will institute and order the proper proceedings in the premises to locate, establish and open such road, to-wit: Beginning at and in the center of a County road and at the present terminus of the Shuah Mann Road so called and at the four corners of land owned by Abraham Staggs heirs W corner and the S.W. corner of lands owned by the heirs of W.F. Havens de'cd. The N.E. corner of lands owned by Shuah Mann and the S.E. corner of Marcus A. Mann's land and running from thence north from said four corners One Hundred rods, more or less on the line of lands owned by the heirs of W.F. Havens and Marcus A. Mann to the center of the Columbus and Jersey road and being the road leading from Gahanna to Headley's Corners, said road petitioned for is in Jefferson township, Franklin County, Ohio and is a continuation of the Shuah Mann Road.

Dated _____ A.D. 1893

PETITIONERS' NAMES.

Shuah Mann
 David Headley
 Serenns S. Souder
 Aaron Ogden

PETITIONERS' NAMES.

C.W. Ogden
 Daniel Headley
 Martin Peine

PETITIONERS' NAMES.

G.M. Stagg
 George M. Mann
 James Keeler

PETITIONERS' NAMES.

Leroy Havens
 D.S. Stagg
 A.O. Kitzmiller.

COLUMBUS, OHIO, October, 27th 1893

The Commissioners met in regular session at the Auditor's Office, and the following proceedings were had, to-wit:

Now comes Shuah Mann one of the signers of the foregoing petition, and files his bond which is in the words and figures following to-wit:

KNOW ALL MEN BY THESE PRESENTS:

That we Shuah Mann and K.S.Mann are held and firmly bound unto the State of Ohio,for the use of Franklin County,in the penal sum of One Hundred Dollars,for the true and faithful payment of which,well and truly to be made,we bind ourselves jointly and severally,our heirs,executors and administrators,by these presents.

Sealed with our seals,and dated at Columbus this 27th day of Oct.1893

THE CONDITIONS OF THE ABOVE OBLIGATION ARE SUCH, That whereas application has been made to the Board of Commissioners of said Franklin County for the Establishment etc of a County road on the following line,towit:

Beginning at and in the center of a County road and at the present terminus of the Shuah Mann road, so called and at the four corners of the land owned by Abraham Staggs' heirs; N.W.corner and the S.W. corner of land owned by the heirs of W.F.Havens dec'd. The N.E.corner of land owned by Shuah Mann and the S.E.corner of Marcus A.Mann's land and running from thence north from said center of said four corners One Hundred rods more or less on the line of lands owned by the heirs of W.F.Havens dec'd and Marcus A.Mann to the center of the Columbus and Jersey road and being the road leading from Gahanna to Headley's Corners,said road petitioned for is in Jefferson Township,Franklin County,Ohio,and is a continuation of the said Shuah Mann road.

Now,if the said applicant shall pay into the treasury of the said county the amount of all costs and expenses accruing thereon,in case the prayer of said petitioners shall not be granted,or when the proceedings had in pursuance thereof shall not be finally confirmed and established,then this obligation to be void; otherwise to be in full force in law.

ATTEST:
B.H.Harmon)
Depty County Auditor.)

Shuah Mann (SEAL)
K.S.Mann (SEAL)

Which bond is accepted and approved. And it appearing that the foregoing petitioners have fully complied with the law in regard to said petition,it is ordered that A.C.Park,Wm.Earl and Edward Roberts three disinterested freeholders of Franklin County,Ohio,be and they are hereby appointed Viewers,and John J.Dun Surveyor of said Road and that they meet at Gahanna on the 9th day of November at ten o'clock A.M.,and after being duly sworn,proceed to the discharge of the duties of their several appointments,according to law. It is further ordered that the County Auditor issue the necessary order to the said Viewers and Surveyor,and that said Viewers and Surveyor report their proceedings in the premises to this board at its next regular session.

Whereupon the County Auditor issued to said Viewers and Surveyor the following order,viz:

AUDITOR'S OFFICE,FRANKLIN COUNTY,OHIO.
Columbus, October,31st 1893.

A.C.Parks)
William Earl) VIEWERS.
Edward Roberts)

John J.Dun SURVEYOR.

Gentlemen: You were appointed by the County Commissioners of Franklin County,Ohio,to view and lay out a proposed County Road on the following route,as petitioned for by Shuah Mann.

Beginning at and in the center of a County road and at the present terminus of the Shuah Mann road so called and at the four corners of land owned by Abraham Staggs heirs. N.W. corner and the S.W.cor.corner of land owned by the heirs of W.F.Havens dec'd. The N.E.Corner of land owned owned by Shuah Mann and the S.E. Corner of Marcus A.Mann's land running from thence north from said center of said four corners One Hundred rods more or less on the line of lands owned by the heirs of W.F.Havens dec'd. and Marcus A.Mann to the center of the Columbus and Jersey road and being the road leading from Gahanna to Headley's Corners said road petitioned for is in Jefferson township,Franklin County,Ohio,and is continuation of the said Shuah Mann Road.

You will therefore meet on the 9th of Nov.at the place designated as the beginning of said road,or alteration,and after taking an oath or affirmation,faithfully and impartially to discharge the duties of your appointments respectively,you shall take to your assistance two suitable persons as Chain Carriers,and one Marker,and proceed to view,survey and lay out said road,or alteration,as prayed for in the above petition,or as near the same as in your opinion a good road can be made at a reasonable expense; taking into consideration the utility,convenience and inconvenience,and expense which will result to individuals,as well as to the public. And said Viewers shall,in addition to their duties as Viewers,also at the same time assess and determine the compensation to be made to the owners of the land across which the road is to be located,and the damages sustained by any person or persons through whose premises the road is proposed to be established; and the said Viewers shall make and sign a report in writing,stating their opinion in favor of or against the establishment, or alteration of said road,or any part thereof,and set forth the reasons of the same; which report,together with the plan and survey of said road,or alteration,shall be delivered to the County Auditor by one of the Viewers on or before the first day of our session in _____ next. Said Viewers shall also determine the width of said road,which cannot be more than 60 feet wide.

AND FURTHER,it shall be the duty of the Viewers aforesaid,at the same time at which they are required to make their report of the View,to make a separate report in writing,stating the amount of the compensation to be made to the owners of the land across which the road is to be located,and the damages,(if any,)and to whom,which by them have been assessed,and be further governed in their proceedings under this order by the provisions of the statute in such case made and provided.

By Order of the Commissioners,
Henry J.Caren County Auditor.

NOTICE TO LAND OWNERS OF THE TIME AND PLACE OF HOLDING VIEW.

TO W.F.Havens heirs and Marcus A.Mann

You are hereby notified that the Viewers and Surveyor appointed by the Commissioners of Franklin County,Ohio,in their order of Oct.31st 1893,to lay out and survey the Co.Road petitioned for by the undersigned and others,will meet at Gahanna Village on the 9th day of November 1893,for the purpose set forth in said order.

Dated this 31st day of October,A.D.1893

Shuah Mann Principal Petitioner.

PROOF OF SERVICE.

THE STATE OF OHIO,) Shuah Mann having been first duly sworn,states,that on the 2d day of November 1893,
Franklin County,ss.) (being not less than six days before the time appointed for the meeting of said Viewers
and Surveyor,) he served a copy of the foregoing notice upon W.F.Havens hr's and M.AMann land owners and John

J.Dun Engineer and A.C.Park, William Earl and Edward Roberts Viewers.

(signed) Shuah Mann

Sworn to and subscribed before me, this 4th day of November, A.D. 1893

B.H. Harmon Dpty. Co. Aud'r.

CERTIFICATE OF MAKING OATH.

THE STATE OF OHIO,) BE IT REMEMBERED, That on this 9th day of November, A.D. 1893, personally appeared Franklin County, ss.) before me, Chas. W. Borland a Deputy County Surveyor in and for said County, A.C. Park, Wm. Earl and Edward Roberts Viewers, of a County Road petitioned for by Shuah Mann and others, and were by me duly sworn to the faithful and impartial performance of their respective duties.

Chas. W. Borland Deputy Co. Surveyor.


THE STATE OF OHIO,) BE IT REMEMBERED, That on this 9th day of November, A.D. 1893, personally appeared Franklin County, ss.) before me, Chas. W. Borland a Deputy County Surveyor in and for said County petitioned for by Shuah Mann and others, and were by me duly sworn to the faithful and impartial performance of their respective duties.

SURVEYOR'S REPORT.

TO THE BOARD OF COMMISSIONERS OF FRANKLIN COUNTY, OHIO:

The undersigned, in obedience to your order dated Oct. 31st. 1893, proceeded, on the 9th day of November to survey and mark the County Road described in said order, under the direction of the Viewers therein named, and respectfully submits the following return of said survey:

PLAT OF MANN ROAD

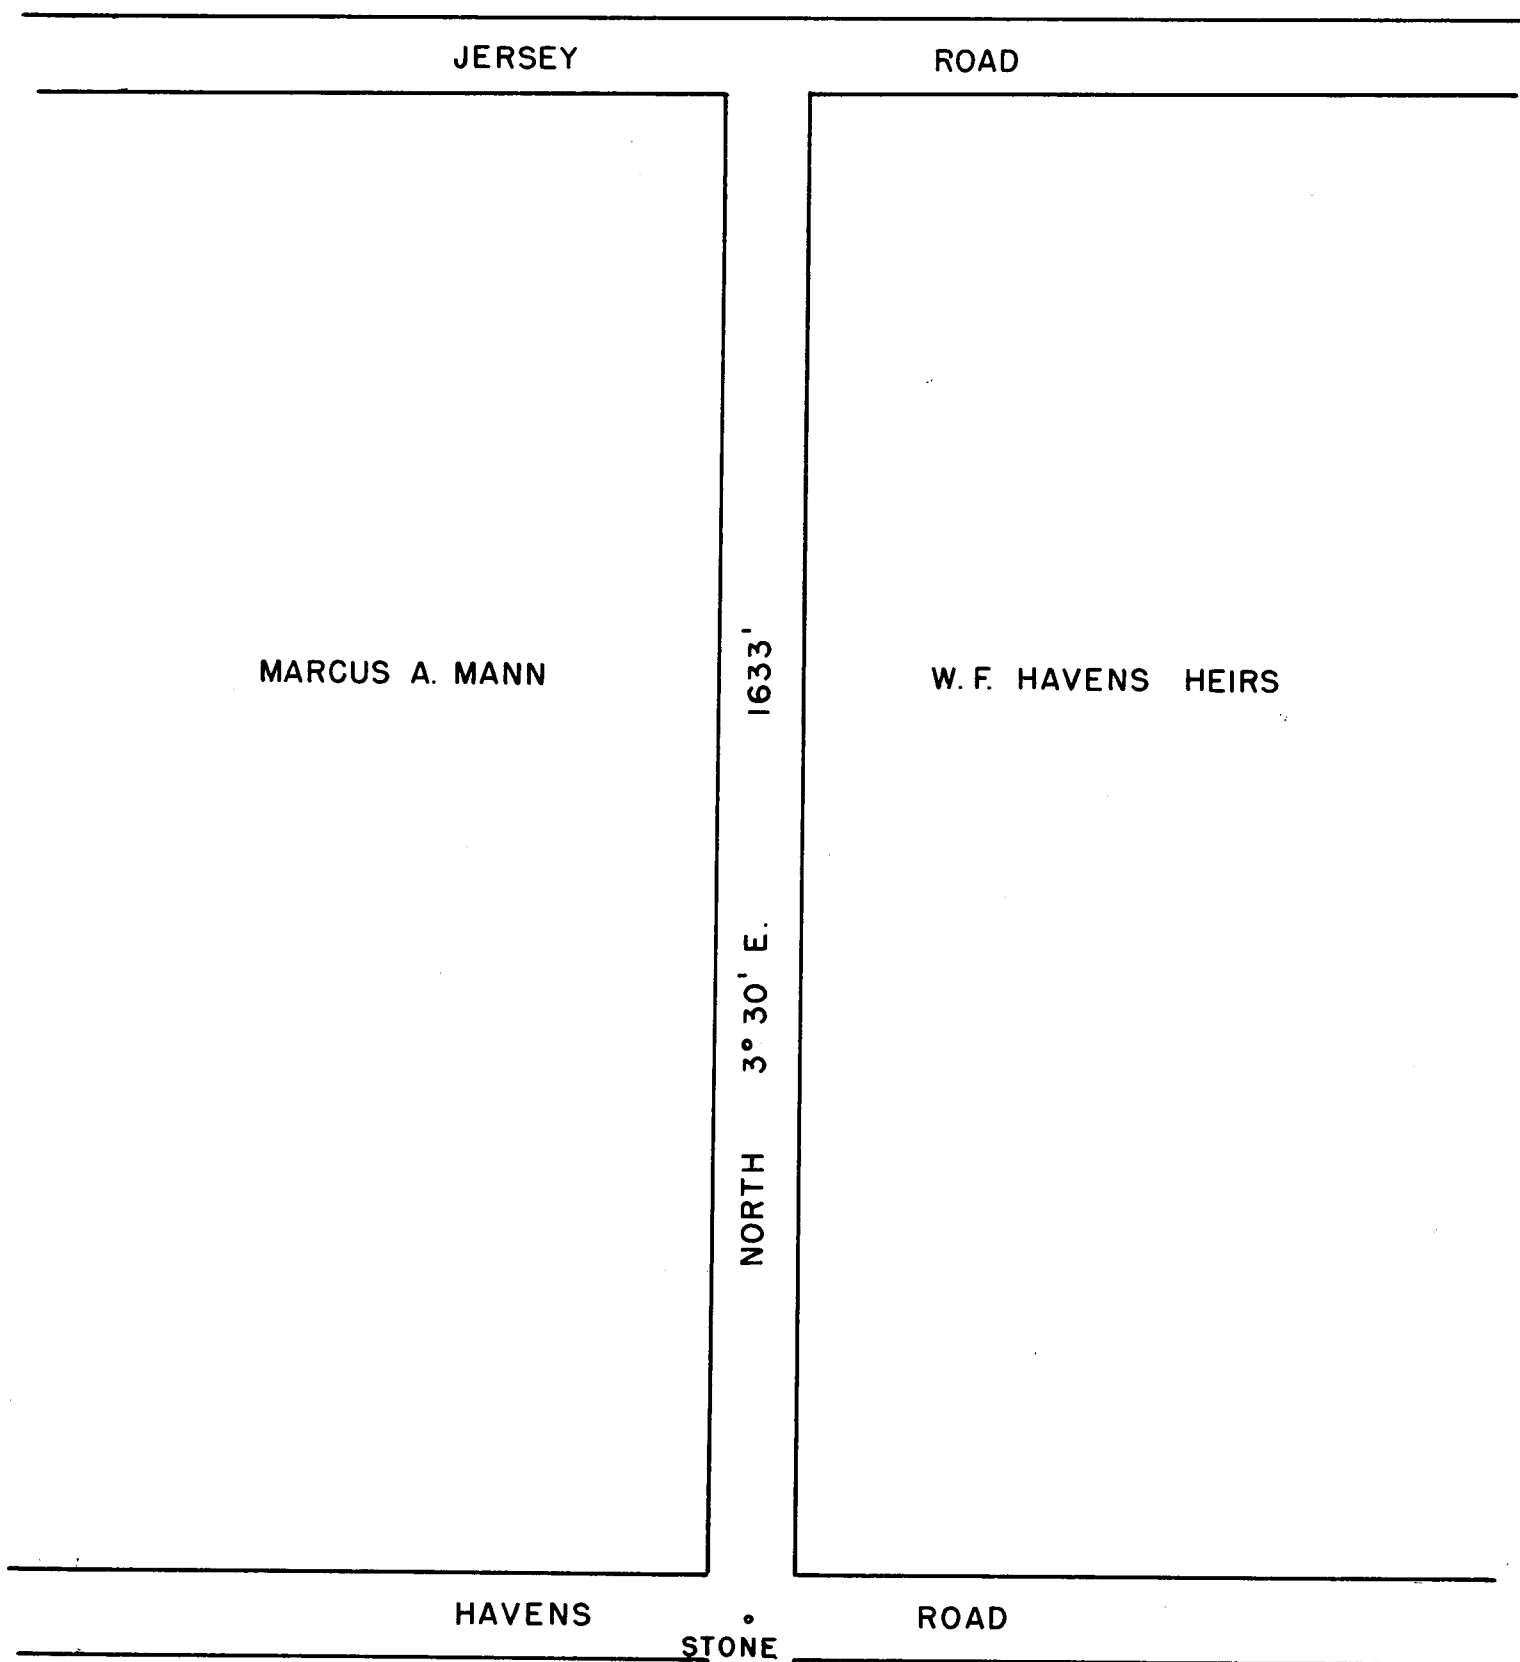

I CERTIFY that the above is a correct plat and return of the survey of the County Road named above.

Chas. W. Borland Surveyor of said Co. Road.

REPORT OF VIEWERS.

TO THE BOARD OF COMMISSIONERS OF FRANKLIN COUNTY, OHIO:

In obedience to your order, issued at your Oct. 31st session, A.D. 1893, we, the undersigned, Viewers, appointed under said order, met with Chas. W. Borland Surveyor, at Gahanna on November 9th and were severally sworn to discharge, faithfully and impartially, the duties required of us in said order.

William Miller and Herman Borland were selected by us as chain-carriers, and _____ as marker, who were also duly sworn.

We then proceeded to view said proposed Road on the line described in your order, and caused the same to be surveyed, "as prayed for in the petition, or as near the same as in our opinion a good road can be made at a reasonable expense, taking into consideration the utility, convenience, and inconvenience, and expense which will result to individuals as well as the public," by the Establishment of said road, as follows:

Beginning at a stone in the center of the Havens County Road and continuation of the Shuah Mann Road in Jefferson township, Franklin County, Ohio. Thence N 3 1/2° E through the lands of the heirs of W.F. Havens on the east and Marcus A. Mann on the west Sixteen hundred and thirty three feet (1633 ft) to the intersection of the Jersey road or road leading from Gahanna to Jersey and there to terminate.

We would respectfully report that the said Road ought to be established for the following reasons: The road in its present condition is entirely too narrow and will be a great importance to the public.

We have also determined that the public convenience requires that such road shall be established 30 feet in width.

All of which is respectfully submitted,)	A.C. Park)	
November, 11 th 1893)	William Earl) VIEWERS.	
	G.E. Roberts)	

FEEES.

A.C. Park	Viewer,	2	days,	\$ 3.00	Wm. Miller	Chainman,	_____	days,	\$ 1.00
William Earl	"	2	"	\$ 3.00					
Edward Roberts	"	2	"	\$ 3.00					

SEPARATE REPORT OF VIEWERS.

TO THE BOARD OF COMMISSIONERS OF FRANKLIN COUNTY, OHIO:

The undersigned Viewers of the County Road petitioned for by Shuah Mann and others, make the following separate report of the compensation and damages assessed and awarded by them to persons entitled thereto. The parties name below have filed their written applications for the said allowances, according to law, and the same are hereto appended and returned with this report.

Compensation for Land taken for said road has been awarded in the following sums:

TO W.F. Havens Heirs. Twelve (\$12.00) DOLLARS;

We recommend that the County pay the above compensation.

Each of the above sums has been assessed without deduction for benefits to any property of the owner, which would accrue by the opening of said road."

A.C. Park)	VIEWERS AND
William Earl)	JURORS TO
G.E. Roberts)	AWARD DAMAGES.

November, 11th 1893

COLUMBUS, OHIO, December, 4, 1893

The Commissioners met in regular session, and the report of the Surveyor and Viewers appointed to survey and view the road, as described in the foregoing petition, was read the first time.

ATTEST:		
Henry J. Caren)	T.D. Cassady)	
County Auditor.	S.B. Biggert)	COMMISSIONERS.

COLUMBUS, OHIO, December, 5th 1893

The Commissioners met in regular session, and the report of the Surveyor and Viewers appointed to survey and view the road, as described in the foregoing petition, was read the second time.

ATTEST:		
Henry J. Caren)	T.D. Cassady)	
County Auditor.	S.B. Biggert)	COMMISSIONERS.

COLUMBUS, OHIO, December, 6th 1893

The Commissioners met in regular session, and in the matter of the establishment of a county road in Jefferson Tp., petitioned for by S. Mann et al.

The report of the Viewers in favor of the establishment of said road was this day publicly read for the third time and said Viewers having filed a separate report in writing of the amount of compensation which they have assessed to land owners by reason of the opening of said road, which report was also publicly read, and the Board being of the opinion that the compensation awarded by said Viewers to the several claimants, to-wit: W.F. Havens heirs compensation for land \$12.00 is reasonable and just, that said road will be public utility and of sufficient importance to the public to justify the payment of said compensation out of the county Treasury and no petition for review being filed, it is ordered that the County Auditor draw his order upon the County Treasurer in favor of said claimant for the amount so awarded, that the several reports of the Viewers, with the survey and plat of said road be recorded and that said road be established a public highway. It is further ordered that the County Auditor issue in the name of the Board an order to the Trustees of Jefferson Twp., directing them to cause said road to be opened, according to law.

ATTEST:	Yeas; McDonald and Biggert
H. J. Caren,	Co. Commr's.
Co. Aud'r. Harmon Dpty.	

)
) County
) Commissioners.