

ROAD RECORD NO.11

ROAD RECORD NO.11

PAGE NO.401

IN THE MATTER OF THE ROACH COUNTY ROAD PETITIONED FOR BY PERRY A. ROACH AND OTHERS IN MARION TOWNSHIP, FRANKLIN COUNTY, OHIO.....

Fair Avenue - from Westland Avenue west to Alum Creek

ROW = 60'

ROAD NOTICE...

NOTICE IS HEREBY GIVEN, That a petition will be presented to the Commissioners of Franklin County, at the next session June 2nd, A.D.1902, praying for the opening and laying out of a County Road on the following line, to-wit:

Beginning at the East Corporation line of the City of Columbus, Ohio, in the center of Alum Creek, at the Eastern terminus of Fair Ave., in said City. The same being on the boundary line of said City and Marion Township, extending Sixty feet wide in Easterly direction through and along the boundary lines of the lands and premises owned by Andrew Morrison, Perry A. Roach, Effie Herrett, Geo. W. Lattimer and the Alum Creek Ice Co., and extending on an exact line with said Fair Ave., crossing at about right angles the Reese Road or Westland Ave., in said Marion Township and terminating and opening out into Park View Avenue in Bullett Park Addition, said Township and County. The said proposed Road being about 1400 feet in length....

Andrew Morrison, Perry A. Roach, et al, Petitioners.....

AFFIDAVIT THAT COPIES OF THE ABOVE NOTICE WERE DULY POSTED UP..

THE STATE OF OHIO,) Perry A. Roach having been first duly sworn states that on the 3rd day of May 1902, Franklin County, ss.) and at least thirty days before June 2nd, 1902, he set up copies of the foregoing notice at the Auditor's Office, in said County, and at three public places in the township of Marion in which said road is proposed to be laid out and established....

(signed) Perry A. Roach

Sworn to and subscribed before, this 2nd, day of June, A.D. 1902

G.M. Harshner.....

AFFIDAVIT OF PRINTER..

THE STATE OF OHIO,) I, R.A. Brenman being duly sworn, depose and say, that the foregoing notice was published one time a week for four consecutive weeks, June 14" 21" 28" and July 5" and immediately prior to the 7" day of July, A.D.1902, in The Columbus Citizen a newspaper printed in said County of Franklin, State of Ohio, and of general circulation therein, and that the first publication was made June 14th, A.D.1902,

R.A. Brenman

Sworn to before me, and signed in my presence, this 9th day of June, A.D.1902

Printers' Fees. \$ 12.50
Affidavit .40
\$ 12.90

R.E. Westfall Notary Public, in and for Franklin Co., Ohio....

ROAD PETITION..

FOR A COUNTY ROAD IN MARION TOWNSHIP..

TO THE BOARD OF COMMISSIONERS OF FRANKLIN COUNTY, OHIO:

The undersigned petitioners, resident freeholders of said County, respectfully represent that the public convenience requires the opening and laying out of a County road on the line hereinafter described; and pray that your body will institute and order the proper proceedings in the premises to open and lay out such road, to-wit: Beginning at the East Corporation Line of the City of Columbus, Ohio, in the center of Alum Creek, at the Eastern terminus of Fair Ave., in said City, the same being on the boundary line of said City and said Marion Township, extending Sixty feet wide in an Easterly direction through and along the boundary lines of the lands and premises owned by Andrew Morrison, Perry A. Roach, Effie Harrett, Geo. W. Lattimer, and the Alum Creek Ice Co., and extending on an exact line with said Fair Ave., crossing at about right angles the Reese Road or Westland Ave., in said Marion Township and terminating and opening out into Park View Avenue in Bullitt Park Addition, said Township and County, the said proposed road being about 1400 feet in length...

Dated this 2nd, day of May, A.D. 1902

Table with 4 columns: PETITIONERS' NAMES. Perry A. Roach, Andrew Morrison, H. Holtzman, W.M. Deeds, Wm. Shepard, Chas. M. Leesh, Effie Herritt, H.M. Hubbard, Jennie M. Geren, Ametta P. Coit, Eugene Porrelt, John W. Jackson, MacLee Wilson, Henrietta C. Geren, E.T. Affleck....., James D. Osborn, J.C. Lunn, D.T. Ramsey

COLUMBUS, OHIO, 18

The Commissioners met in regular session at the Auditor's Office, and the following proceedings were had, to-wit:

Now comes _____ one of the signers of the foregoing petition, and files his bond

which is in the words and figures following, to-wit:

KNOW ALL MEN BY THESE PRESENTS:

That we Andrew Morrison, Perry A. Roach are held and firmly bound unto the State of Ohio, for the use of Franklin County, in the penal sum Two Hundred Dollars, for the true and faithful payment of which, well and truly to be made, we bind ourselves jointly and severally, our heirs, executors and administrators, by these presents..

Sealed with our seals, and dated at Columbus, Ohio this 2nd day of May, 1902

THE CONDITIONS OF THE ABOVE OBLIGATION ARE SUCH, That whereas application has been made to the Board of Commissioners of said Franklin County for the opening and laying out of a County road on the following line, to-wit:

Beginning at the East Corporation Line of the City of Columbus, Ohio, in the center of Alum Creek, at the Eastern terminus of Fair Avenue in said City, the same being on the boundary line of said City and Marion Township extending Sixty feet wide in an Easterly direction, through and along the boundary lines of the lands and premises owned by Andrew Morrison, Perry A. Roach, Effie Herritt, Geo. W. Lattimer and the Alum Creek Ice Co., and extending on an exact line with said Fair Avenue crossing at about right angles the Reese Road or Westland Ave., in said Marion Township and terminating and opening out into Park View Avenue in Bullitt Park Addition, said township and County, the said proposed road being 1400 feet in length...

Now, if the said applicant shall pay into the treasury of the said county the amount of all costs and expenses accruing thereon, in case the prayer of said petitioners shall not be granted, or when the proceedings had in pursuance thereof shall not be finally confirmed and established, then this obligation to be void; otherwise to be in full force in law..

ATTEST:
F.B. Hofman)

Perry A. Roach (SEAL)
Andrew Morrison (SEAL)

Which bond is accepted and approved. And it appearing that the foregoing petitioners have fully complied with the law in regard to said petition, it is ordered that _____ three disinterested freeholders of Franklin County, Ohio, be and they are hereby appointed Viewers, and _____ Surveyor of said _____ and that they meet at _____ on the _____ day of _____ at ten o'clock A.M., and after being duly sworn, proceed to the discharge of the duties of their several appointments, according to law. It is further ordered that the County Auditor issue the necessary order to the said Viewers and Surveyor, and that said Viewers and Surveyor report their proceedings in the premises to this board at its next regular session....

Whereupon the County Auditor issued to said Viewers and Surveyor the following order, viz:

AUDITOR'S OFFICE, FRANKLIN COUNTY, OHIO
Columbus, June 2nd, 1902

Justin Pinney)
Frank Dean) VIEWERS.
William Jones)

Henry Maetzel SURVEYOR.

Gentlemen: You were appointed by the County Commissioners of Franklin County, Ohio, to view and lay out and open a proposed County Road on the following route, as petitioned for by Perry A. Roach et al..

You are therefore directed with Henry Maetzel the Surveyor appointed by us to meet at Perry A. Roach residence at 10 o'clock A.M., on the 7th day of July, 1902, and proceed to attend to the several duties of your appointment...

You will therefore meet on the _____ at the place designated as the beginning of said road, or alteration, and after taking an oath or affirmation, faithfully and impartially to discharge the duties of your appointments respectively, you shall take to your assistance two suitable persons as Chain Carriers, and one Marker, and proceed to view, survey and lay out said road, or alteration, as prayed for in the above petition, or as near the same as in your opinion a good road can be made at a reasonable expense; taking into consideration the utility, convenience, and inconvenience and expense which will result to individuals as well as to the public. And said Viewers shall, in addition to their duties as Viewers, also at the same time assess and determine the compensation to be made to the owners of the land across which the road is to be located, and the damages sustained by any person or persons through whose premises the road is proposed to be established; and the said Viewers shall make and sign a report in writing, stating their opinion in favor of or against the establishment or alteration of said road, or any part thereof, and set forth the reasons of the same; which report, together with the plan and survey of said road, or alteration, shall be delivered to the County Auditor by one of the Viewers on or before the first day of our session in _____ next. Said Viewers shall also determine the width of said road, which cannot be more than 60 feet wide...

AND FURTHER, it shall be the duty of the Viewers aforesaid, at the same time at which they are required to make their report of the view, to make a separate report in writing, stating the amount of the Compensation to be made to the owners of the land across which the road is to be located, and the damages, (if any,) and to whom, which by them have been assessed, and be further governed in their proceedings under this order by the provisions of the statute in such case made and provided,

By Order of the Commissioners,
L.E. Jones County Auditor.

NOTICE TO LAND OWNERS OF THE TIME AND PLACE OF HOLDING VIEW..

TO Geo. W. Lattimer, Effie Herritt, Henry M. McCracken, Andrew Morrison, Wm. Shepard, Chas. McLeish, Thos. J. McLeish, Joseph Busch, Perry A. Roach...

You are hereby notified that the Viewers and Surveyor appointed by the Commissioners of Franklin County, Ohio, in their order of June 2nd, 1902, to lay out and survey the County Road petitioned for by the undersigned and others, will meet at Perry A. Roach's Residence on said proposed road on the 7th day of July 1902, for the purpose set forth in said order..

Dated this 2nd day of June, A.D. 1902

Perry A. Roach and Andrew Morrison, Principal Petitioners..

THE STATE OF OHIO,) Perry A.Roach having been first duly sworn, states, that on the 11,13,14,16,22,day
Franklin County,ss.) of June,1902,(being not less than six days before the time appointed for the meeting
of said Viewers and Surveyor,) he served a copy of the foregoing notice upon Geo.W.Lattimer,Effie Herritt,
Andrew Morrison,Wm.Shepard and Chas.McLeish,Thos.J.McLeish, Jos.Busch,Perry A.Roach,

(signed) Perry A.Roach

Sworn to and subscribed before me, this 12th day of July, A.D.1902

L.E.Jones.....

CERTIFICATE OF MAKING OATH..

THE STATE OF OHIO,) BE IT REMEMBERED, That on this 1st.day of July, A.D.1902, personally appeared before
Franklin County,ss.) me, a Notary Public in and for said County, F.B.Dean, Wm.Jones and Justin Pinney Viewers,
of a County Road petitioned for by Perry Roach and others, and were by me duly sworn to the faithful and im-
partial performance of their respective duties...

SURVEYOR'S REPORT..

TO THE BOARD OF COMMISSIONERS OF FRANKLIN COUNTY, OHIO:

The undersigned, in obedience to your order dated June 2nd 1902, proceeded, on the 7th day of July to
survey and mark the line of said road described in said order, under the direction of the Viewers therein
named, and respectfully submits the following return of said survey:
*See Plat at end of Record.

REPORT OF VIEWERS..

TO THE BOARD OF COMMISSIONERS OF FRANKLIN COUNTY, OHIO:

In obedience to your order, dated June 2nd session, A.D.1902, we, the undersigned, Viewers, appointed
under said order, met with Henry Maetzel Surveyor, at the residence of Perry Roach on said proposed road and
were severally sworn to discharge, faithfully and impartially, the duties required of us in said order.

Walter Braun and F.B.Menely were selected by us as chain-carriers, and Clark Baumgarten as marker,
who were also duly sworn.

We then proceeded to view said proposed County road on the line described in your order, and caused
the same to be surveyed, "as prayed for in the petition, or as near the same as in our opinion a good road can
be made at a reasonable expense, taking into consideration the utility, convenience, and inconvenience and exp-
ense which will result to individuals as well as the public," by the opening and laying out of said road, as
follows:

Beginning at a stone in S.E. corner of Sec.No.11, being the S.E. corner of Andrew Morrison's land,
Marion Township; thence with the section line West to the center of the Alum Creek or Corporation line of
the City of Columbus, passing through the lands of Andrew Morrison, Effie Herritt, Alum Cree Ice Co., Perry A.
Roach.....

We would respectfully report that the said road ought to be granted for the following reasons:
That the property immediately joining desire it and ask no compensation. That it will be a benefit to the
City and general public.....

We have also determined that the public convenience requires that such road shall be established
and opened sixty feet in width,

All of which is respectfully submitted,
July 12th, 1902)

Justin Pinney)
Frank B.Dean) VIEWERS.
William Jones)

FEES..

Justin Pinney, Viewer, 3 days, \$ 4.50
Frank B.Dean, " 3 " \$ 4.50
Wm. Jones, " 3 " \$ 4.50
Paid 7-12-1902

Henry Maetzel Surveyor, _____ days, \$ _____
per Walter Braun, Dpty.....

COLUMBUS, OHIO, September, 2nd, 1902

The Commissioners met in regular session, and the report of the Surveyor and Viewers appointed to
survey and view the road, as described in the foregoing petition, was read the first time.

ATTEST:
L.E.Jones,)
County Auditor.

Z.E.Amlin)
Wm. Pinney) Commissioners.
W.S.Carlisle)

COLUMBUS, OHIO, Sept.3rd, 1902

The Commissioners met in regular session, and the report of the Surveyor and Viewers appointed to
survey and view the road, as described in the foregoing petition, was read the second time..

ATTEST:
L.E.Jones,)
County Auditor.


Z.E.Amlin)
Wm. Pinney) Commissioners.
W.S.Carlisle)

COLUMBUS, OHIO, Sept. 4th, 1902

The Commissioners met in regular session, and the report of the surveyor and Viewers appointed to survey and view the road, as described in the above petition, was this day publicly read for the third time, and was granted providing that the County have no damages or compensation to pay. Auditor is ordered to notify Trustees to open the said County Road for public use....

(Z.E.Amlin
Commissioners of) Wm. Pinney
Franklin County (W.S.Carlisle.....

* PLAT OF ROACH ROAD..
Marion Tp.

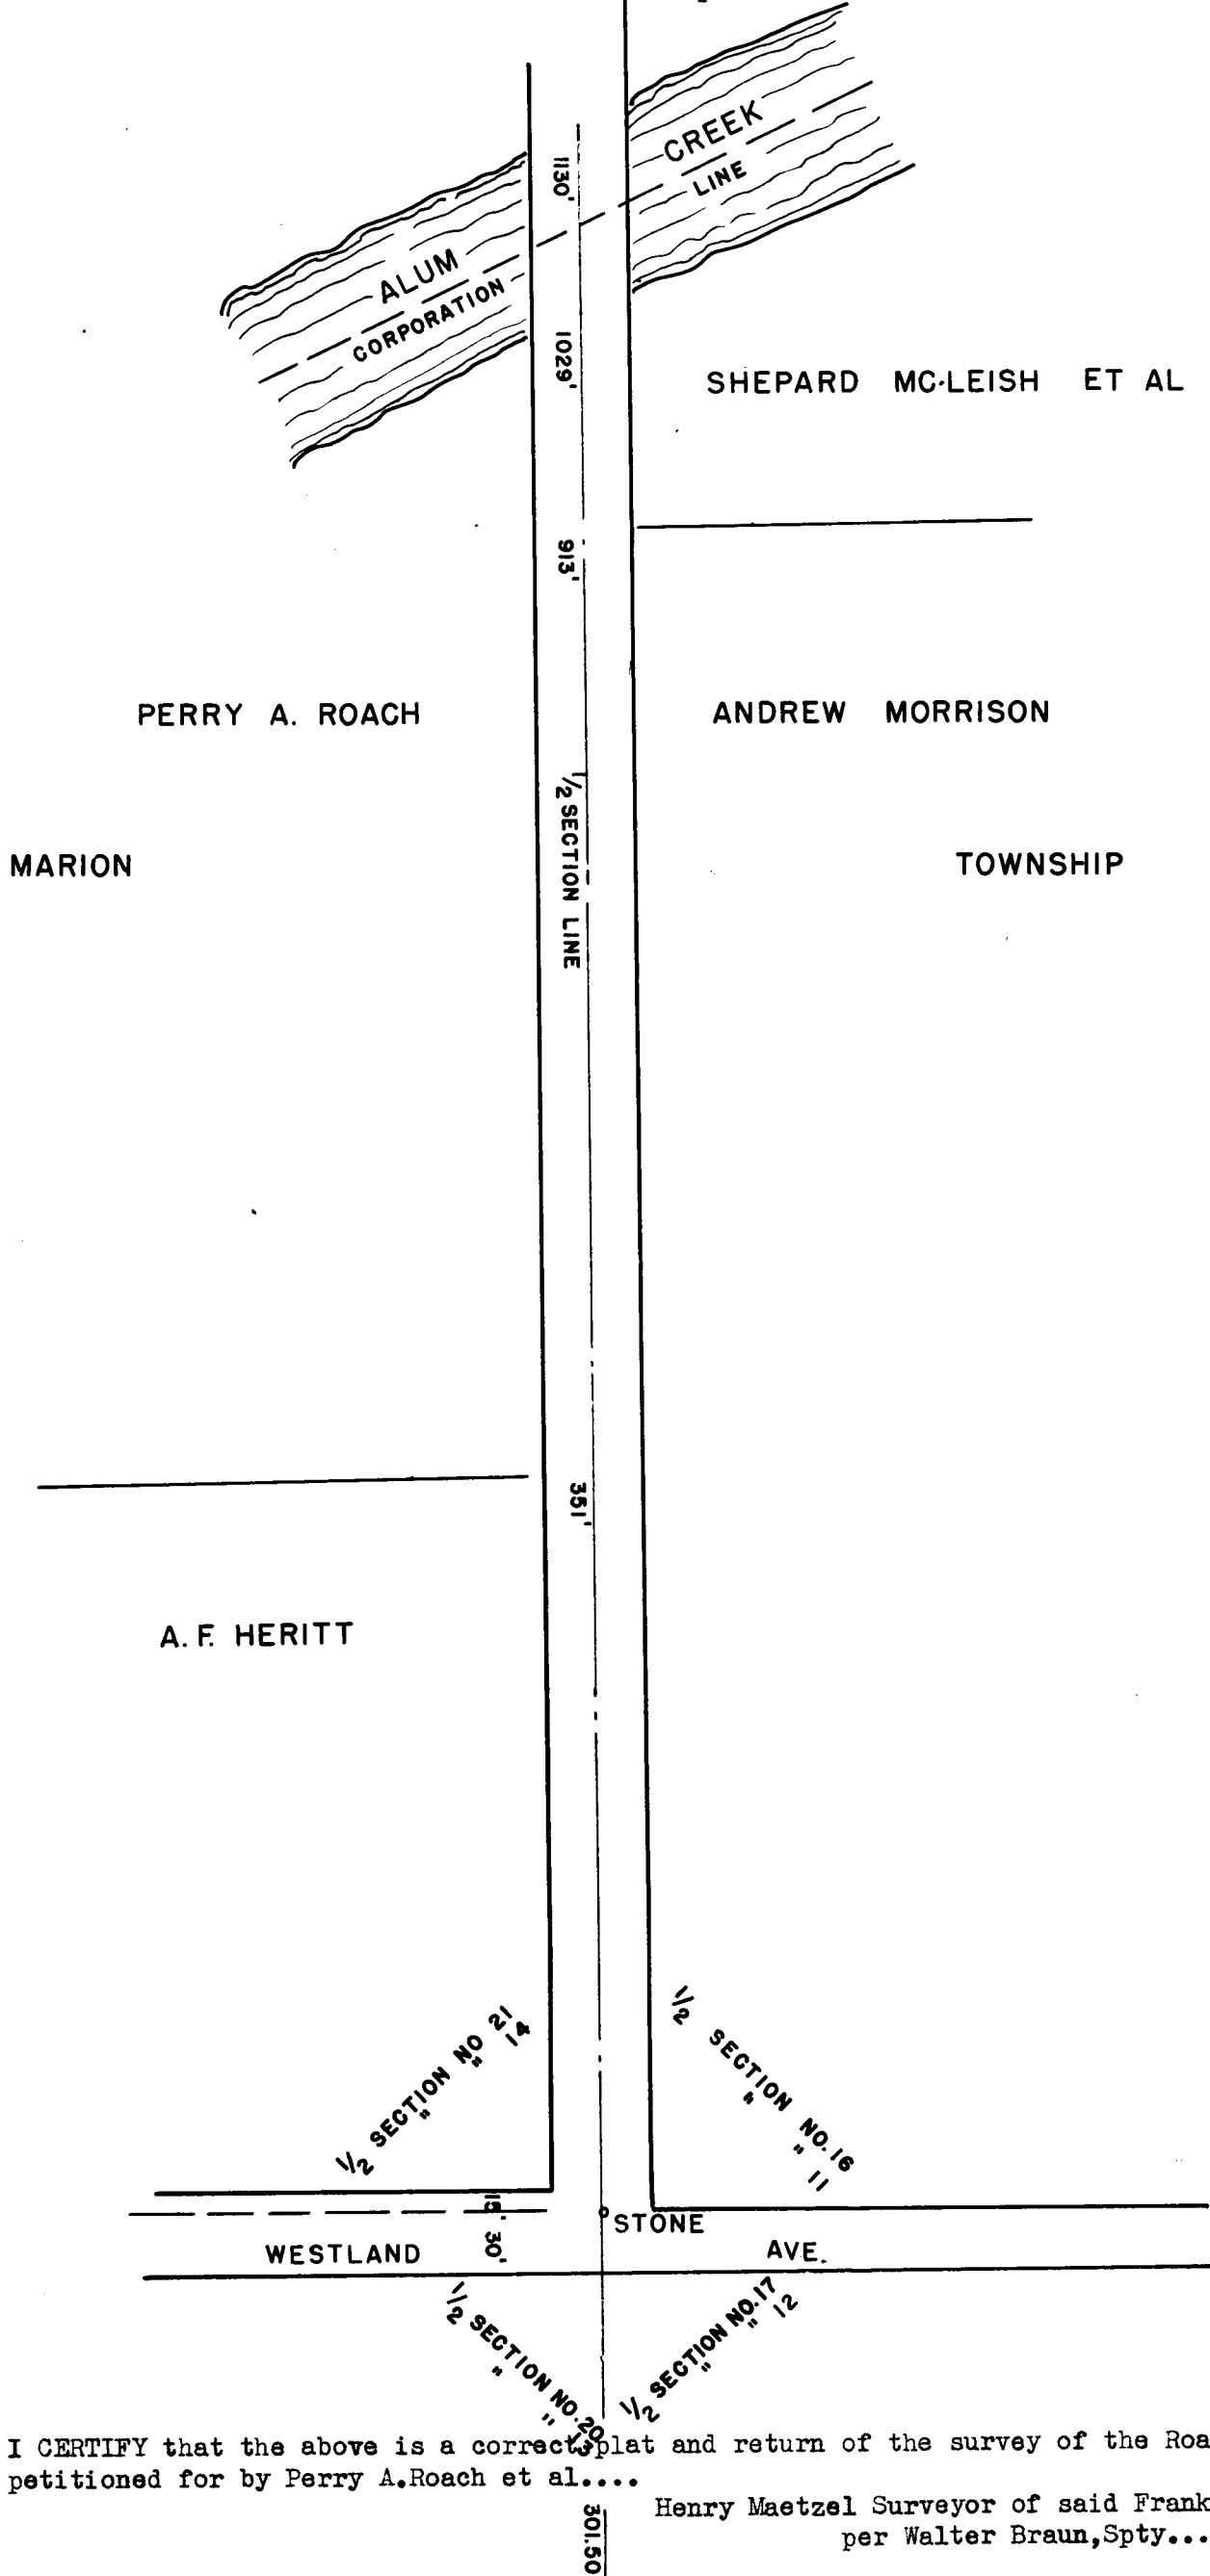

I CERTIFY that the above is a correct plat and return of the survey of the Roach County Road named above and petitioned for by Perry A. Roach et al....

Henry Maetzel Surveyor of said Franklin Co.,....
per Walter Braun, Spty.....