

ROAD RECORD NO.11

ROAD RECORD NO.11

PAGE NO.457

IN THE MATTER OF THE ESTABLISHMENT OF A COUNTY  
ROAD PETITIONED FOR BY J. A. O'HARRA AND OTHERS  
IN FRANKLIN TWP., FRANKLIN COUNTY, OHIO.....

Harrison Avenue - from Hague Avenue to McKinley Avenue \*\*\*\*\* ROW = 50'

ROAD NOTICE..

NOTICE IS HEREBY GIVEN, That a petition will be presented to the Commissioners of Franklin County, at the next session 16" day of January, A. D. 1906, praying for the establishment of a County Road on the following line, to-wit: Commencing at the intersection of Hague Avenue and the South line of the 100.74 Acre tract of land formerly owned by M. J. Harrison and situated in Franklin Township, Franklin County, Ohio, and running thence Easterly along said line to the stone Pike or river road in said Township and there terminate...

December 8, A. D. 1905

AFFIDAVIT THAT COPIES OF THE ABOVE NOTICE WERE DULY POSTED UP..

THE STATE OF OHIO, ) Wm. H. Harrison having been first duly sworn states that on the 8" day of December Franklin County, ss.) 1905, and at least thirty days before the 16" day of January 1906, he set up copies of the foregoing notice at the Auditor's Office, in said County, and at three public places in the township of Franklin in which said road is proposed to be laid out and established.

(signed) W. H. Harrison

Sworn to and subscribed before me, this 16" day of January A. D. 1906

F. A. Siegel, Notary Public,  
Franklin, O...

AFFIDAVIT OF PRINTER..

THE STATE OF OHIO, ) I, R. A. Brennan being duly sworn, depose and say, that the foregoing notice was Franklin County, ss.) published one time a week for four consecutive weeks Dec. 8, 15, 22, & 29, A. D. 1905, in The Columbus Citizen a newspaper printed in said County of Franklin, State of Ohio, and of general circulation therein, and that the first publication was made December 8, A. D. 1905

R. A. Brennan

Sworn to before me, and signed in my presence, this 16" day of January, A. D. 1906

Charles F. Fischer, Notary Public,  
Franklin County, O...

\*\*\*\*\*

ROAD PETITION..

FOR AN ESTABLISHMENT OF THE W. A. O'HARRA COUNTY "A" ROAD IN FRANKLIN TOWNSHIP...

TO THE BOARD OF COMMISSIONERS OF FRANKLIN COUNTY, OHIO:

The undersigned petitioners, resident freeholders of said County, respectfully represent that the public convenience requires the establishment of a County road on the line hereinafter described; and pray that your body will institute and order the proper proceedings in the premises to establish such road, to-wit: Beginning at the intersection of Hague Avenue and the South line of the 100.74 Acre tract of land

formerly owned by M. J. Harrison in Franklin Township, Franklin County, Ohio, and running thence Easterly along said line to the stone pike or road known as the Quarry Pike, in said township, and there terminate.

We respectfully ask that a County road be established along said route as provided by Law...

Dated this January 16th, A. D. 1906

PETITIONERS' NAMES.	PETITIONERS' NAMES.	PETITIONERS' NAMES.	PETITIONERS' NAMES.
Edmund Harrison,	Fanny A. Harrison,	J. A. O'Harra,	Bert Southard,
George Sommer,	Mary J. Harrison,	J. B. Hamblin,	F. H. Unkemiah,
Chas. P. Trabue,	Benj. Harrison,	W. B. Smith,	E. E. <u>Tone</u> or <u>Tom</u>
Geo. G. Trabue,	Lizzie H. Fairchild,	E. F. Smith,	J. W. Young,
Stephen Renner,	Patsy H. Gruber,	M. S. Milikin,	Jno. Lucas,
G. W. Renner,	DeWit C. John,	Geo. E. Gill,	John Brown,
Wm. W. Scoles,	Geo. C. Urlin,	D. T. Mitchell,	G. P. Pretz,
W. H. Harrison,	H. D. Freeman,	John Murnane,	Stafford Phillips,
A. D. Rodgers,	Jas. O'Hern	P. O'Hern,	J. L. Shrum.....

COLUMBUS, OHIO, \_\_\_\_\_ 18

The Commissioners met in regular session at the Auditor's Office, and the following proceedings were had, to-wit:

Now comes J. A. O'Harra one of the signers of the foregoing petition, and files his bond which is in the words and figures following, to-wit:

KNOW ALL MEN BY THESE PRESENTS:

That we W. H. Harrison, J. A. O'Harra and Edmund Harrison are held and firmly bound unto the State of Ohio, for the use of Franklin County in the penal sum of Two Hundred (\$ 200) Dollars, for the true and faithful payment of which, well and truly to be made, we bind ourselves jointly and severally, our heirs, executors and administrators, by these presents.

Sealed with our seals, and dated at Columbus this 16<sup>th</sup> day of January, 1906

THE CONDITIONS OF THE ABOVE OBLIGATION ARE SUCH, That whereas application has been made to the Board of Commissioners of said Franklin County for the laying out and establishment of a County road on the following line, to-wit:

Beginning at the intersection of Hague Avenue and the South line of the 100.74 Acre tract of land formerly owned by M. J. Harrison in Franklin Township, Franklin County, Ohio, and running thence Easterly and along said line to the stone Pike as Quarry road and there terminate..

Now, if the said applicant shall pay into the treasury of the said county the amount of all costs and expenses accruing thereon, in case the prayer of said petitioners shall not be granted, or when the proceedings had in pursuance thereof shall not be finally confirmed and established, then this obligation to be void; otherwise to be in full force in law..

ATTEST:

F. A. Siegel, )

W. H. Harrison, (SEAL)  
 J. A. O'Harra, (SEAL)  
 Edmund Harrison. (SEAL)

Which bond is accepted and approved. And it appearing that the foregoing petitioners have fully complied with the law in regard to said petition, it is ordered that C. L. Webster, Chas. Postle and E. C. Babbitt three disinterested freeholders of Franklin County, Ohio, be and they are hereby appointed Viewers, and Walter Braun Surveyor of said County and that they meet at on the line of said proposed road on the 20th, day of February, 1906 at ten o'clock A. M., and after being duly sworn, proceed to the discharge of their several appointments, according to law. It is further ordered that the County Auditor issue the necessary order to the said Viewers and Surveyor, and that said Viewers and Surveyor report their proceedings in the premises to this board at its next regular session..

Whereupon the County Auditor issued to said Viewers and Surveyor the following order, viz:

AUDITOR'S OFFICE, FRANKLIN COUNTY, OHIO.  
 Columbus, January 16, 1906

C. L. Webster )  
 Chas. Postle ) VIEWERS. Walter Braun SURVEYOR.  
 E. C. Babbitt )

Gentlemen: You were appointed by the County Commissioners of Franklin County, Ohio, to view and lay out a proposed County Road on the following route, as petitioned for by J. A. O'Harra et al...

Beginning at the intersection of Hague Avenue and the South line of the 100.74 Acre tract of land formerly owned by M. J. Harrison and situated in Franklin Township, Franklin County, Ohio, and running thence Easterly along said line to the stone Pike or river road in said Township and there to terminate...

You will therefore meet on the 20<sup>th</sup> day of February, 1906 at the place designated as the beginning of said road, or alteration, and after taking an oath or affirmation, faithfully and impartially to discharge the duties of your appointments respectively, you shall take to your assistance to suitable persons as Chain Carriers, and one Marker, and proceed to view, survey and lay out said road, or alteration, as prayed for in the above petition, or as near the same as in your opinion a good road can be made at a reasonable expense; taking into consideration the utility, convenience, and inconvenience and expense which will result to individuals as well as to the public. And said Viewers shall, in addition to their duties as Viewers, also at the same time assess and determine the compensation to be made to the owners of the land across which the road is to be located, and the damages sustained by any person or persons through whose premises the road is proposed to be established; and the said Viewers shall make and sign a report in writing, stating their opinion in favor of or against the establishment or alteration of said road, or any part thereof, and set forth the reasons of the same; which report, together with the plan and survey of said road, or alteration, shall be delivered to the County Auditor by one of the Viewers on or before the first day of our session in \_\_\_\_\_ next. Said Viewers shall also determine the width of said road, which cannot be more than 60 feet wide..

AND FURTHER, it shall be the duty of the Viewers aforesaid, at the same time at which they are required to make their report of the view, to make a separate report in writing, stating the amount of the compensation to be made to the owners of the land across which the road is to be located, and the damages, (if any,) and to whom, which by them have been assessed, and be further governed in their proceedings under this

order by the provisions of the statute in such case made and provided,  
By Order of the Commissioners,

County Auditor...

NOTICE TO LAND OWNERS OF THE TIME AND PLACE OF HOLDING VIEW...

TO W. H. Harrison.....

You are hereby notified that the Viewers and Surveyor appointed by the Commissioners of Franklin County, Ohio, in their order of January 16th, 1906, to lay out and survey the County road petitioned for by the undersigned and others, will meet at the line of the proposed road on the 20th day of February, 1906, for the purpose set forth in said order.

Dated this 1st, day of February, A. D. 1906

J. A. O'Harra Principal Petitioner...

PROOF OF SERVICE..

THE STATE OF OHIO, ) W. H. Harrison having been first duly sworn, states, that on the 1st, day of Feb-  
Franklin County, ss.) ruary, 1906, (being not less than six days before the time appointed for the meeting  
of said Viewers and Surveyor,) he served a copy of the foregoing notice upon J. A. O'Harra, W. H. Harrison,  
Benjamin Harrison, Fanny A. Harrison, Elizabeth R. Fairchild, Mary J. Harrison, and Macon M. Harrison, as  
required by law.

(SEAL)

(signed) W. H. Harrison


Sworn to and subscribed before me, this 3rd, day of February, A. D. 1906


F. A. Siegel, Notary Public....

CERTIFICATE OF MAKING OATH....

THE STATE OF OHIO, ) BE IT REMEMBERED, That on this 20th day of February, A. D. 1906, personally appeared  
Franklin County, ss.) before me, Walter Braun a County Surveyor, in and for said County, C. L. Webster,  
Chales Postle and E. C. Babbitt of a County Road petitioned for by J. A. O'Harra and others, and were by me  
duly sworn to the faithful and impartial performance of their respective duties.

Walter Braun, County Surveyor,  
Franklin Co., O.....

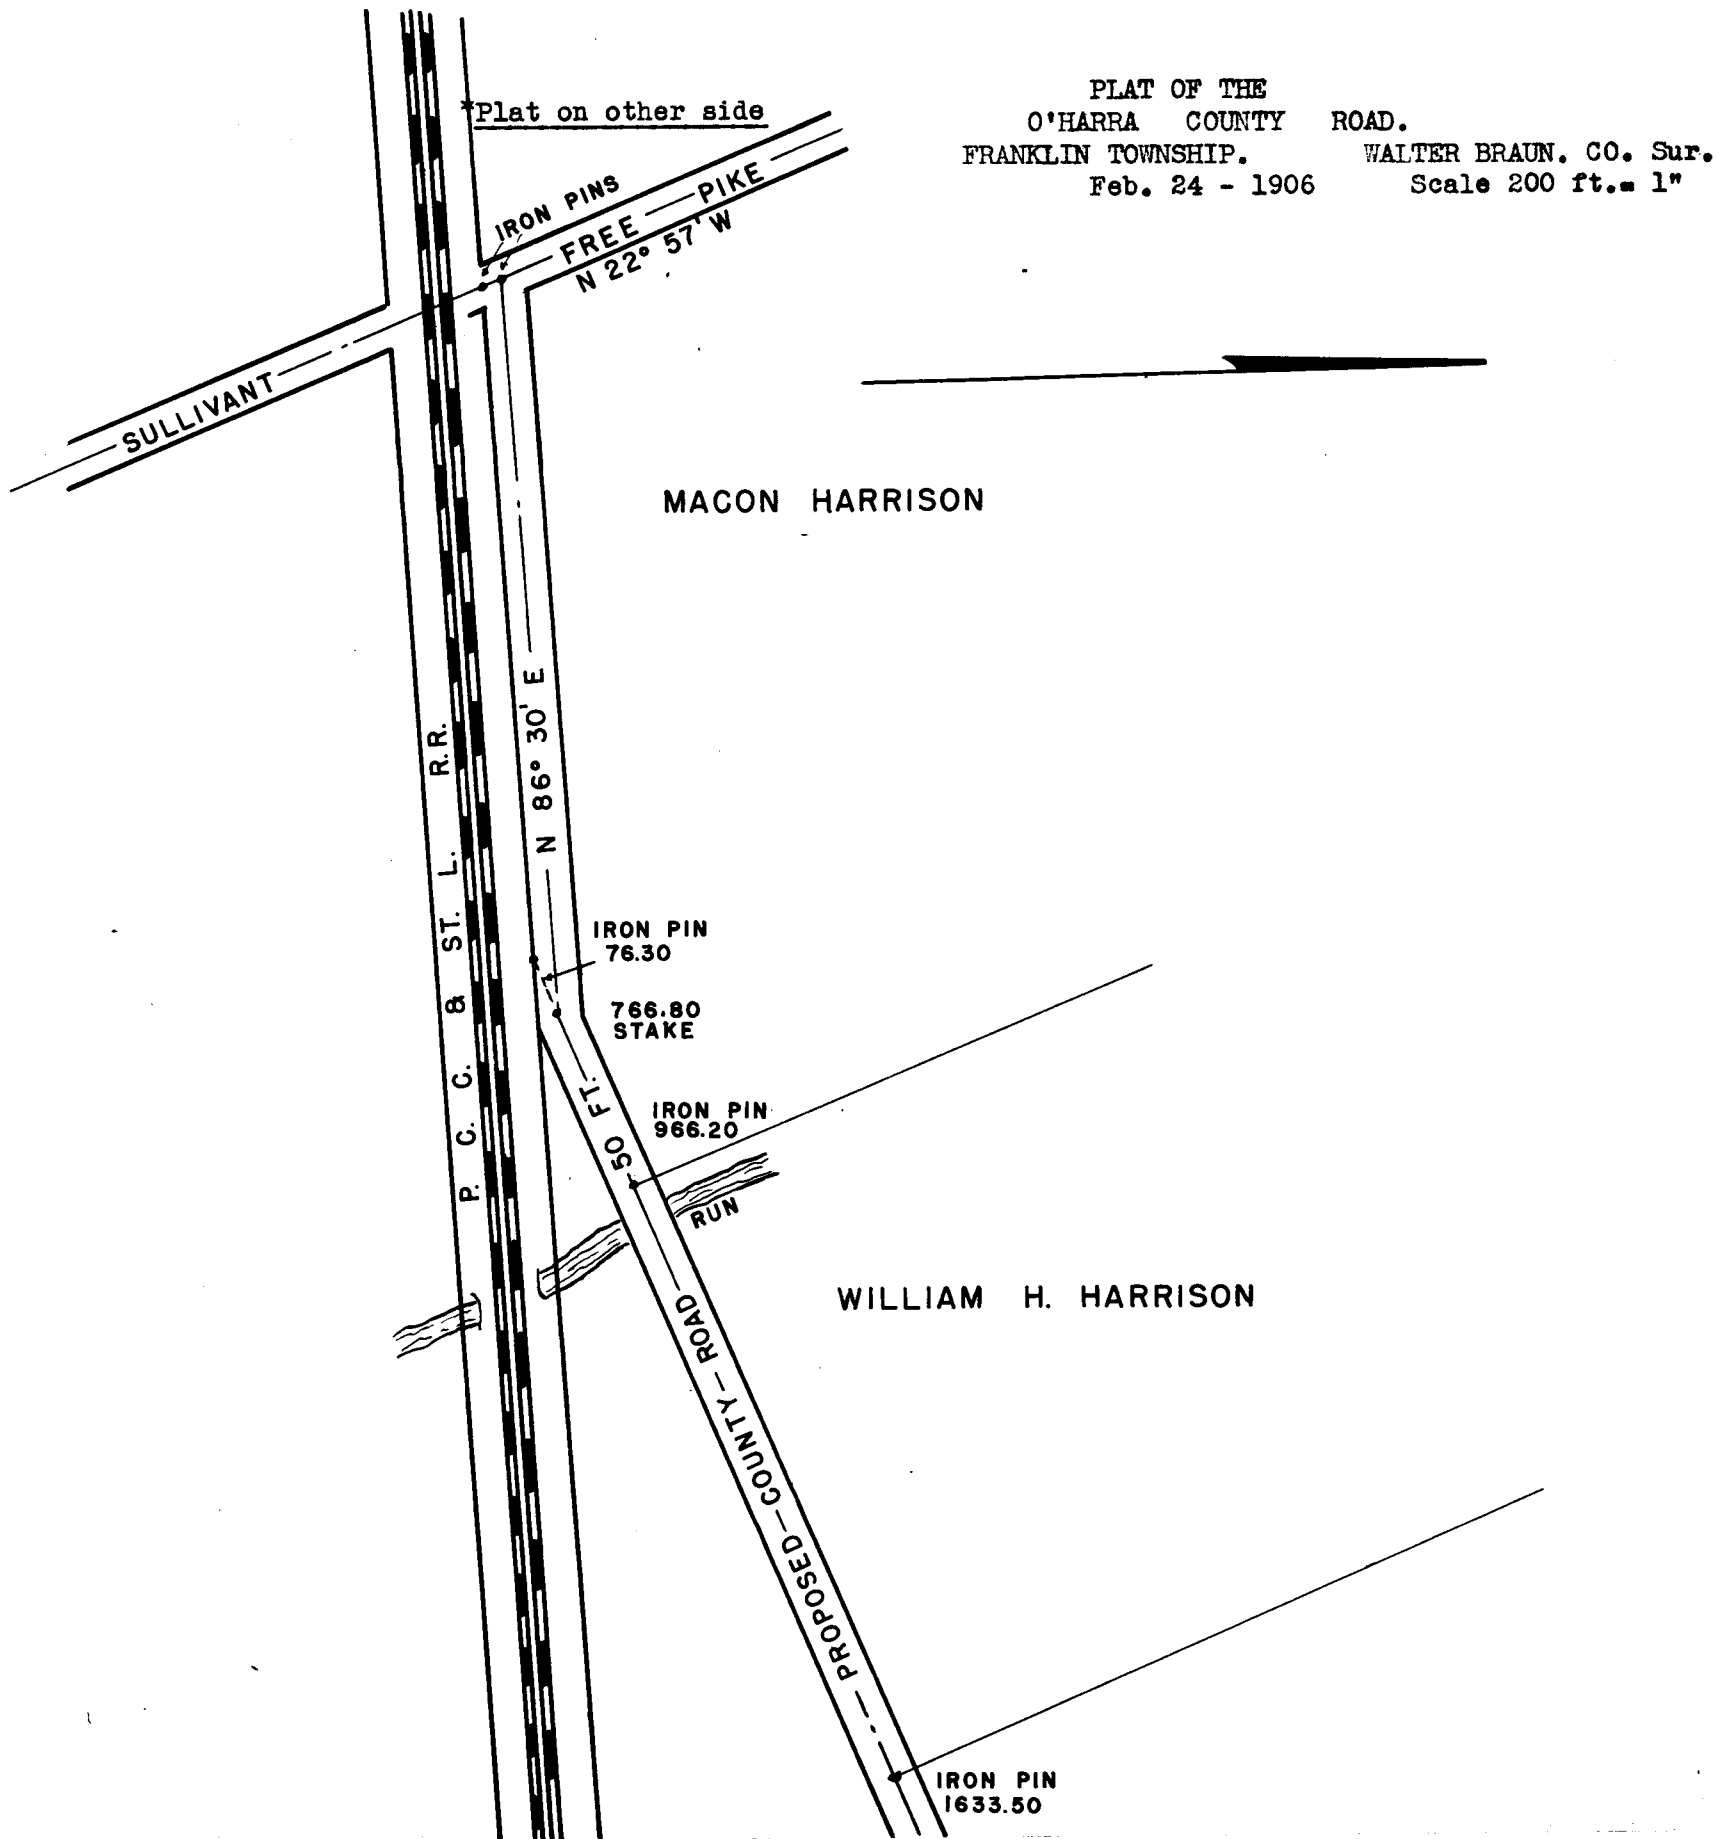

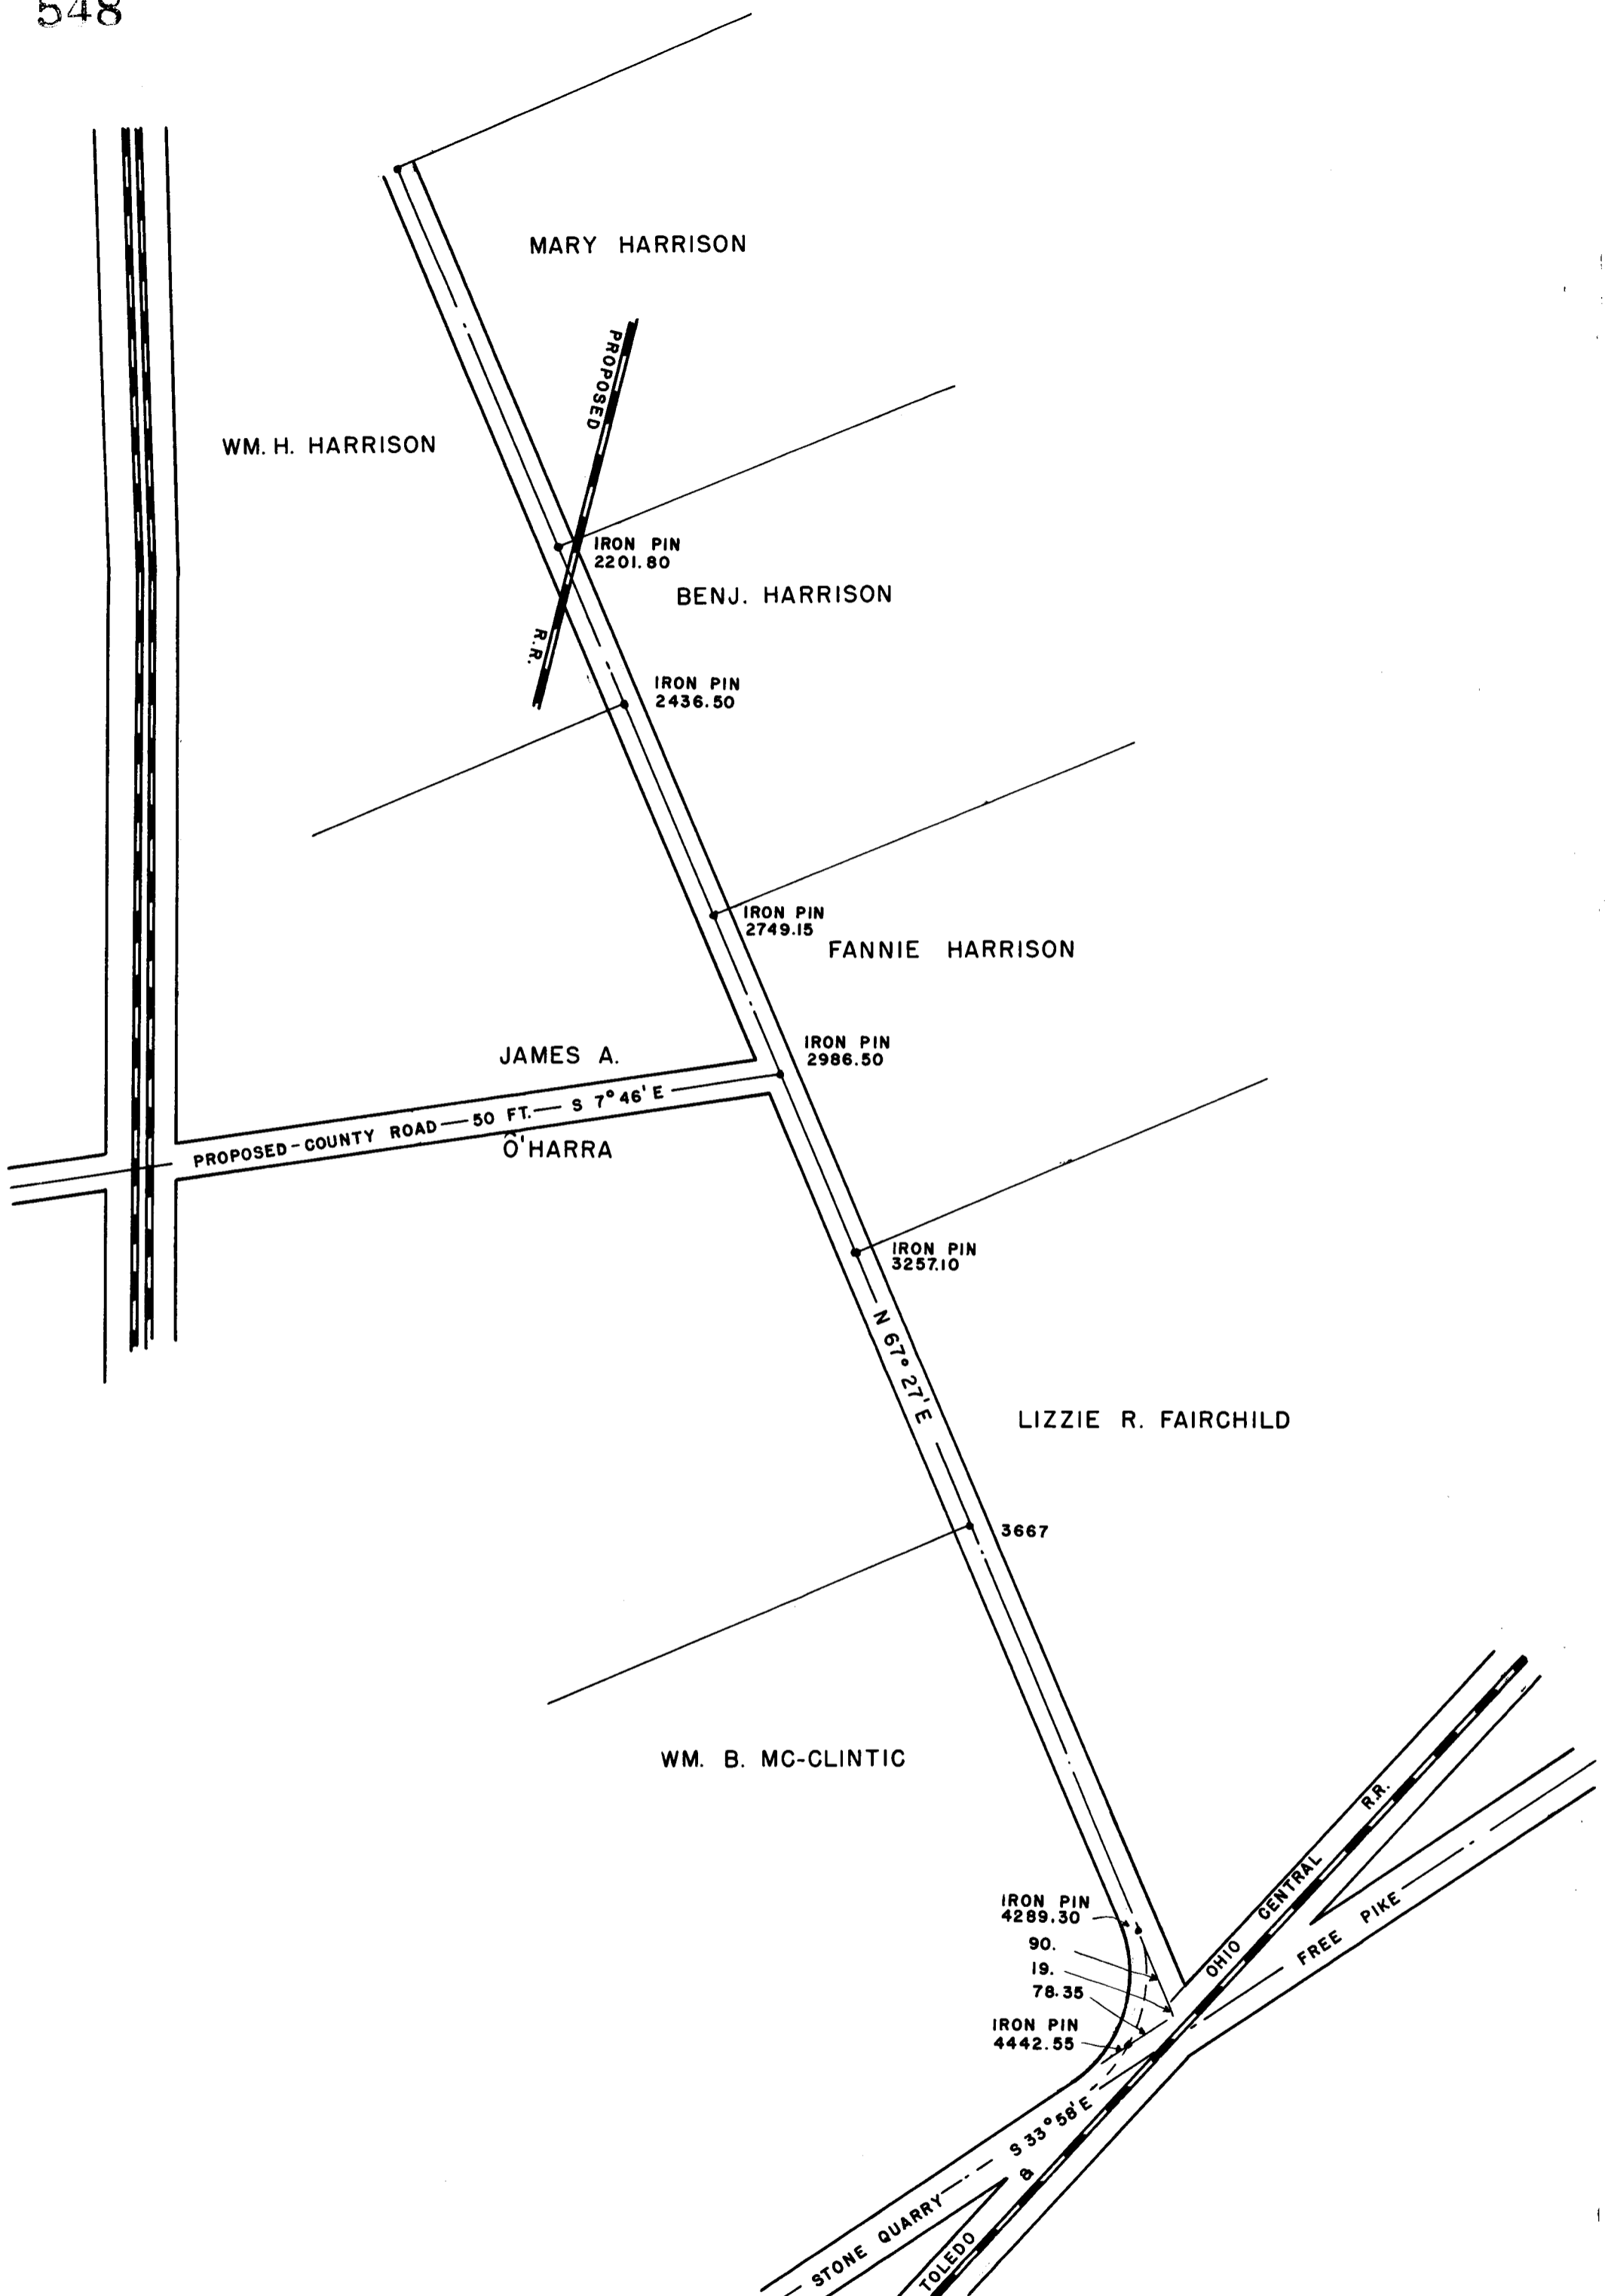

I CERTIFY that the above is a correct plat and return of the survey of the County Road named above.

Walter Braun, Surveyor of said Franklin County, Ohio..

\*\*\*\*\*

REPORT OF VIEWERS....

TO THE BOARD OF COMMISSIONERS OF FRANKLIN COUNTY, OHIO:

In obedience to your order, issued at your January 16 session, A. D. 1906, we, the undersigned, Viewers, appointed under said order, met with Walter Braun Surveyor, at the beginning of the road on 20" day of February, 1906 and were severally sworn to discharge, faithfully and impartially, the duties required of us in said order.

We then proceeded to view said proposed \_\_\_\_\_ on the line described in your order, and caused the same to be surveyed, "as prayed for in the petition, or as near the same as in our opinion a good road can be made at a reasonable expense, taking into consideration the utility, convenience, and inconvenience and expense which will result to individuals as well as the public," by the Alteration of said road, as follows:

Beginning in the center of Hague Avenue or in the Sullivant Free Pike at a point (25) ft. North of the North line of the right of way of the P.C.C & ST. L. Ry; thence N. 86 1/2 Deg. E. and parallel with said railroad and through the land of Macon Harrison 766.80 ft. to the intersection of the South line of the original Mary J. Harrison farm, being the North line of V. M. Survey No. 2668; thence with said line N. 67 Deg. 27 E. 966.20 feet to an iron pin in the East line of said Macon Harrison's; thence continuing same course through the lands of Wm. H. Harrison on the North and South 1001 feet to center of a run 1633.50 ft. to an iron pin in East line of said Wm. H. Harrison's line on the North; thence same course through the lands of Mary Harrison's on the North 2201.80 feet to an iron pin in said Mary Harrison's East line; thence same course 2230.30 ft. to a line of a proposed railroad 2436.50 feet to Wm. Harrison's East line on South; thence same course through lands of J. A. O'Harra on South and Benj. Harrison North 2749.15 feet to an iron pin in Benj. Harrison's East line; thence same course through lands of Fannie Harrison on North 2936.50 ft. to center of the proposed road South to Deshler Ave., and 3257.10 to an iron pin in Fannie Harrison's East line on North; thence same course 3667 ft. to line between O'Harra and McClintie on South; thence through lands of Lizzie R. Fairchild's on North and McClintie on South 4289.20 feet to an iron pin; thence with a curve of 5 1/2 Deg. in 25 feet, 4442.55 feet to an iron pin the West line of the Quarry Pike and continuing also from the Station 4289.30 N. 67 Deg. 27' E. to the West line of the right of way of the T. & O. C. Ry. and there terminate...

We would respectfully report that the said \_\_\_\_\_ ought \_\_\_\_\_ to be established for the following reasons: That after this road is opened and established and after Deshler Ave., is extended the same as now prayed for, it will open communication from the North West by way of the Sullivant Pike and from the North East by way of the Quarry Pike and will be a great benefit to that section of the County and the public in general..

We have also determined that the public convenience requires that such \_\_\_\_\_ shall be established 50 feet in width..

All of which is respectfully submitted, )  
24" day of February, 1906)

C. L. Webster, )  
Charles G. Postle ) VIEWERS.  
E. C. Babbitt )

\*\*\*\*\*

FEEES..

C. L. Webster, Viewer, 2 days, \$ 3.00  
Chas. Postle, " 2 " \$ 3.00  
E. C. Babbitt, " 2 " \$ 3.00

Walter Braun Surveyor, 3 days, \$ 15.00

\*\*\*\*\*

COLUMBUS, OHIO, March 5" 1906

The Commisioners met in regular session, and the report of the Surveyor and Viewers appointed to survey and view the road, as described in the foregoing petition, was read the first time.

ATTEST:

John Scott, )  
Cl'k of the Board of Commissioners.

Peter Swickard )  
Wm. S. Carlisle ) COMMISSIONERS.  
Morton Hayes )

\*\*\*\*\*

COLUMBUS, OHIO, \_\_\_\_\_ 18

The Commissioners met in regular session, and the report of the Surveyor and Viewers appointed to survey and view the road, as described in the foregoing petition, was read the second time.

ATTEST;

John Scott, )  
Cl'k of the Board.

Peter Swickard )  
Wm. S. Carlisle ) COMMISSIONERS.  
Morton Hayes )

\*\*\*\*\*

COLUMBUS, OHIO, March 7, 1906

The Commissioners met in regular session, and the report of the Viewers and Surveyor appointed to survey and view the road, as described in the petition, was this day publicly read for the third time and being in favor of the establishment of said road and no objection being made thereto, nor damages claimed, nor assessed nor petition for review filed, and the Board being of the opinion that said road as laid out, surveyed and established by said Viewers will be of public utility, it is ordered that the reports of said Viewers, with the survey and plat of said road be recorded and that said road be established a public highway fifty feet in width, as set forth in said report, and that a notice in accordance therewith be served at once, upon the Trustees of the township in which same is located...

ATTEST;-

John Scott..

Peter Swickard,  
Wm. S. Carlisle,  
Morton Hayes....

\*\*\*\*\*

\*\*\*\*\*

\*\*\*\*\*