

This road record entry is a combination of the original road record book found in the Franklin County Engineer's Tax Map Department and the WPA transcribed road record book found in the Franklin County Engineer's Records Department. The WPA information was added to the original record to aid in reading the text or plats.

The information below refers to the WPA transcribed entries and was included in the front of each of those books:

“THE HISTORICAL DATA IN THIS RECORD

WAS COMPILED BY RECORDS IN THE OFFICE OF THE FRANKLIN COUNTY ENGINEER

WORKS PROGRESS ADMINISTRATION IN OHIO OFFICIAL PROJECT 665-42-3-130

W P 17847

SPONSORED BY

ALLEN C. SLADE, COUNTY ENGINEER

FRANKLIN COUNTY, OHIO”

14
FRANKLIN CO. O., ROAD RECORD No. 13 Vacation Augusta Ave and Two alleys in Eberly Hts Add

Columbus, Ohio,

1930

To the Hon. Board of County Commissioners of Franklin County, Ohio.

The undersigned petitioners, freeholders of said County, residing in the vicinity of the proposed improvement hereinafter described, respectfully represent that the public convenience and welfare require the vacation of a public road and alleys on the line hereinafter described; and make application to you to institute and order proper proceedings in the premises for vacating such road and alleys; the same not being a road on the State Highway System.

The following is the general route and termini of said road;

Beginning at. Petition to vacate the following street and alleys in Eberly Heights; Augusta Avenue, from Kilgore Road to Marietta Road, and the alley north of Refugee Pike from Kilgore Road west, south and west to Marietta Road; also the alley west of Kilgore Road from Augusta Ave., to the first alley south, being located in Eberly Heights, as recorded in Plat Book 16, page 50, Recorder's office, Franklin County, Ohio, and located in Marion Township.

Petitioners names: Board of Education of Marion Township, R A Clickenger, Pres., A P Geist, Clerk, Louis A Mosser, Sophie H Mosser, Alfred A Hughes, Garnett M Hughes, Christ Borst, Max Borst, Jr. Kathleen Borst, Clarence Price, Kathryn Price, Jos F Rritz, Jr. Jos Rritz, Sr, C A Kinny, Goldie Kinny, Fred & Mary M Karch, Arthur H Moore, Christ Wagner, Carl M Schmidt, Amelia Aller, Julian Aller, I W Rohr, J Rohr.

Filed Dec 3, 1930.

December 3, 1930

Mr. Westlake offered the following preamble and resolution and moved the adoption of the same, which was duly seconded by Mr. Vigor.

WHEREAS, the Board of Education of Marion Township, et al., on the 3rd day of December 1930 presented a petition signed by at least twelve freeholders of Franklin County, Ohio, residing in the vicinity of the proposed vacation, requesting the board of county commissioners of Franklin County, Ohio, to vacate a public road and two alleys, the general route and termini thereof to be as follows:

Augusta Avenue, from Kilgore Road to Marietta Road, and the alley north of Refugee Pike from Kilgore Road west, south and west to Marietta Road; also the alley west of Kilgore Road from Augusta Avenue to the first alley south, being located in Eberly Heights, as recorded in Plat Book 16, page 50, Recorder's office, Franklin County, Ohio, and located in Marion Township;

therefore

BE IT RESOLVED, By the Board of County Commissioners of Franklin County, Ohio, that Friday December 19, 1930, at ten o'clock A.M. eastern standard time, is hereby fixed as the date and hour when the Board of County Commissioners will view the proposed vacation on and along the general route thereof; and that Saturday, January 3, 1931, at ten o'clock A.M., eastern standard time, is hereby fixed as the time and date for final hearing on said petition and proposed vacation, at the office of the Board of County Commissioners in the Court House of Franklin County, Ohio; and

BE IT FURTHER RESOLVED, that notice of the time and place for both such view and hearing be given by publication once a week for two consecutive weeks in the Ohio State Journal, a newspaper published in and having a general circulation in Franklin County, Ohio, where the proposed vacation is located, and that said notice in addition to the date and place of such view and place and time of the final hearing shall state briefly the character of the proposed vacations.

Voting Aye thereon: Atcherson, Westlake and Vigor.

December 19, 1930

In the matter of the petition filed with the Board of County Commissioners of Franklin County, Ohio, on December 3, 1930, for the vacation of Augusta Avenue and two alleys in Eberly Heights Addition, Marion Township, Mr. Westlake offered the following preamble and resolution and moved the adoption of the same, which was duly seconded by Mr. Vigor.

WHEREAS, On the 3rd day of December, 1930, a petition was filed with this Board by the Board of Education of Marion Township, et al., praying for the vacation of Augusta Avenue and two alleys in Eberly Heights Addition, Marion Township, Franklin County, Ohio; and

WHEREAS, On the 3rd day of December, 1930, said Board of County Commissioners did fix the 19th day of December, 1930, at ten o'clock A.M., eastern standard time, on the line of the proposed vacations as the time and place for the viewing thereof, and did further fix the 3rd day of January 1931, at ten o'clock A.M., eastern standard time, at the office of the board of county commissioners of Franklin County, Ohio, as the time and place for final hearing on said proposed vacations; and

WHEREAS, legal notice by publication in the Ohio State Journal, a newspaper published in and of general circulation in said County was given of the time and place for the viewing of said proposed improvements and of the final hearing thereon; and

FRANKLIN CO. O., ROAD RECORD No. 13 Vacating Augusta Ave. and two alleys in Eberly Heights Add.

WHEREAS, The Board of County Commissioners of Franklin County, Ohio, did, on the 19th day of December, 1930, the day fixed for the viewing of said proposed vacations, meet on the line of the said roads as described in the resolution, and heard all proof offered by parties interested in and affected thereby, and other persons competent to testify, and did go over and along the line of said roads, and by actual view of the same, and the premises along and adjacent thereto, which are to be affected thereby, does find that the said proposed vacations are of sufficient importance to require that the surveyor of Franklin County, Ohio, be instructed and directed to make a survey and plat thereof; therefore

BE IT RESOLVED, By the board of county commissioners of Franklin County, Ohio, that the surveyor of Franklin County, Ohio, be and he hereby is instructed and directed to make a plat and survey of the said roads proposed to be vacated, an accurate and detailed description of the lands bordering thereon, together with the names of each owner; shall set stakes at the termini of each right of way lines and at all angles between such termini, and at sufficient other points on the right of way lines so that the bounds of the roads may be discernible to property owners and others interested, and make report to the Board of county commissioners on or before the 3rd day of January, 1931, at ten o'clock A.M., eastern standard time. Said report shall set forth the opinion of the county surveyor either for or against the granting of the petition, which report, together with the plat and survey of said roads shall be deposited with the board of county commissioners.

Voting Aye thereon: Atcherson, Westlake and Vigor.

PROOF OF PUBLICATION

State of Ohio }
Franklin County } ss.

Paul Eisele, cashier of the Ohio State Journal, a newspaper published at Columbus, Franklin County, Ohio, with a paid circulation of more than 25,000, personally appeared and made oath that the attached printed advertisement was published for


Two times, December 4th
11th 1930

in said newspaper and that the rate charged therefor is the same as that charged to commercial advertisers for like spaces on annual contracts.

Subscribed and sworn to this 11th
day of December 1930

Notary Public in and for Franklin Co.

W. H. RIDLE
Notary Public, Franklin County, Ohio

 

Columbus, Ohio, December 30, 1930. To the Honorable Board of County Commissioners, Franklin County, Ohio. Gentlemen: As directed by your Board on December 19, 1930, I have prepared a plat, which I herewith submit, showing the proposed vacation of Augusta Avenue from Kilgore Road to Marietta Road, and the alley north of Refugee Pike from Kilgore Road west, south and west to Marietta Road; also the alley west of Kilgore Road from Augusta Avenue to the first alley south, being located in Eberly Heights, as recorded in plat book 16- page 50, Recorder's Office, Franklin County, Ohio, and located in Marion Township.

I would recommend that said above named street and alleys be vacated as prayed for in the petition and for the following reason, viz:

Augusta Avenue and the two alleys are not of real necessity or convenience to the general public or to the owners of lots in Eberly Heights Addition; furthermore, by the vacation of said thoroughfares as proposed, the two sites, or tracts, owned by the Board of Education of Marion Township will be thrown together, and not separated, as at present, by a thoroughfare. Respectfully submitted, R. S. Blackford, Deputy County Surveyor.


Filed Jan. 3, 1931.

PLAT
 Showing Augusta Ave and Alleys
 to be Vacated
 in EBERLY HEIGHTS, as
 Recorded in Plat Book 16 page 50
 Recorder's Office.

Scale 1" = 60'


and
 Land to be Dedicated by
 for Highways.
 Marion Twp.

Curtis C. Lattimore Robt S. Blackford
 County Surveyor Deputy.
 Dec 30th 1930.

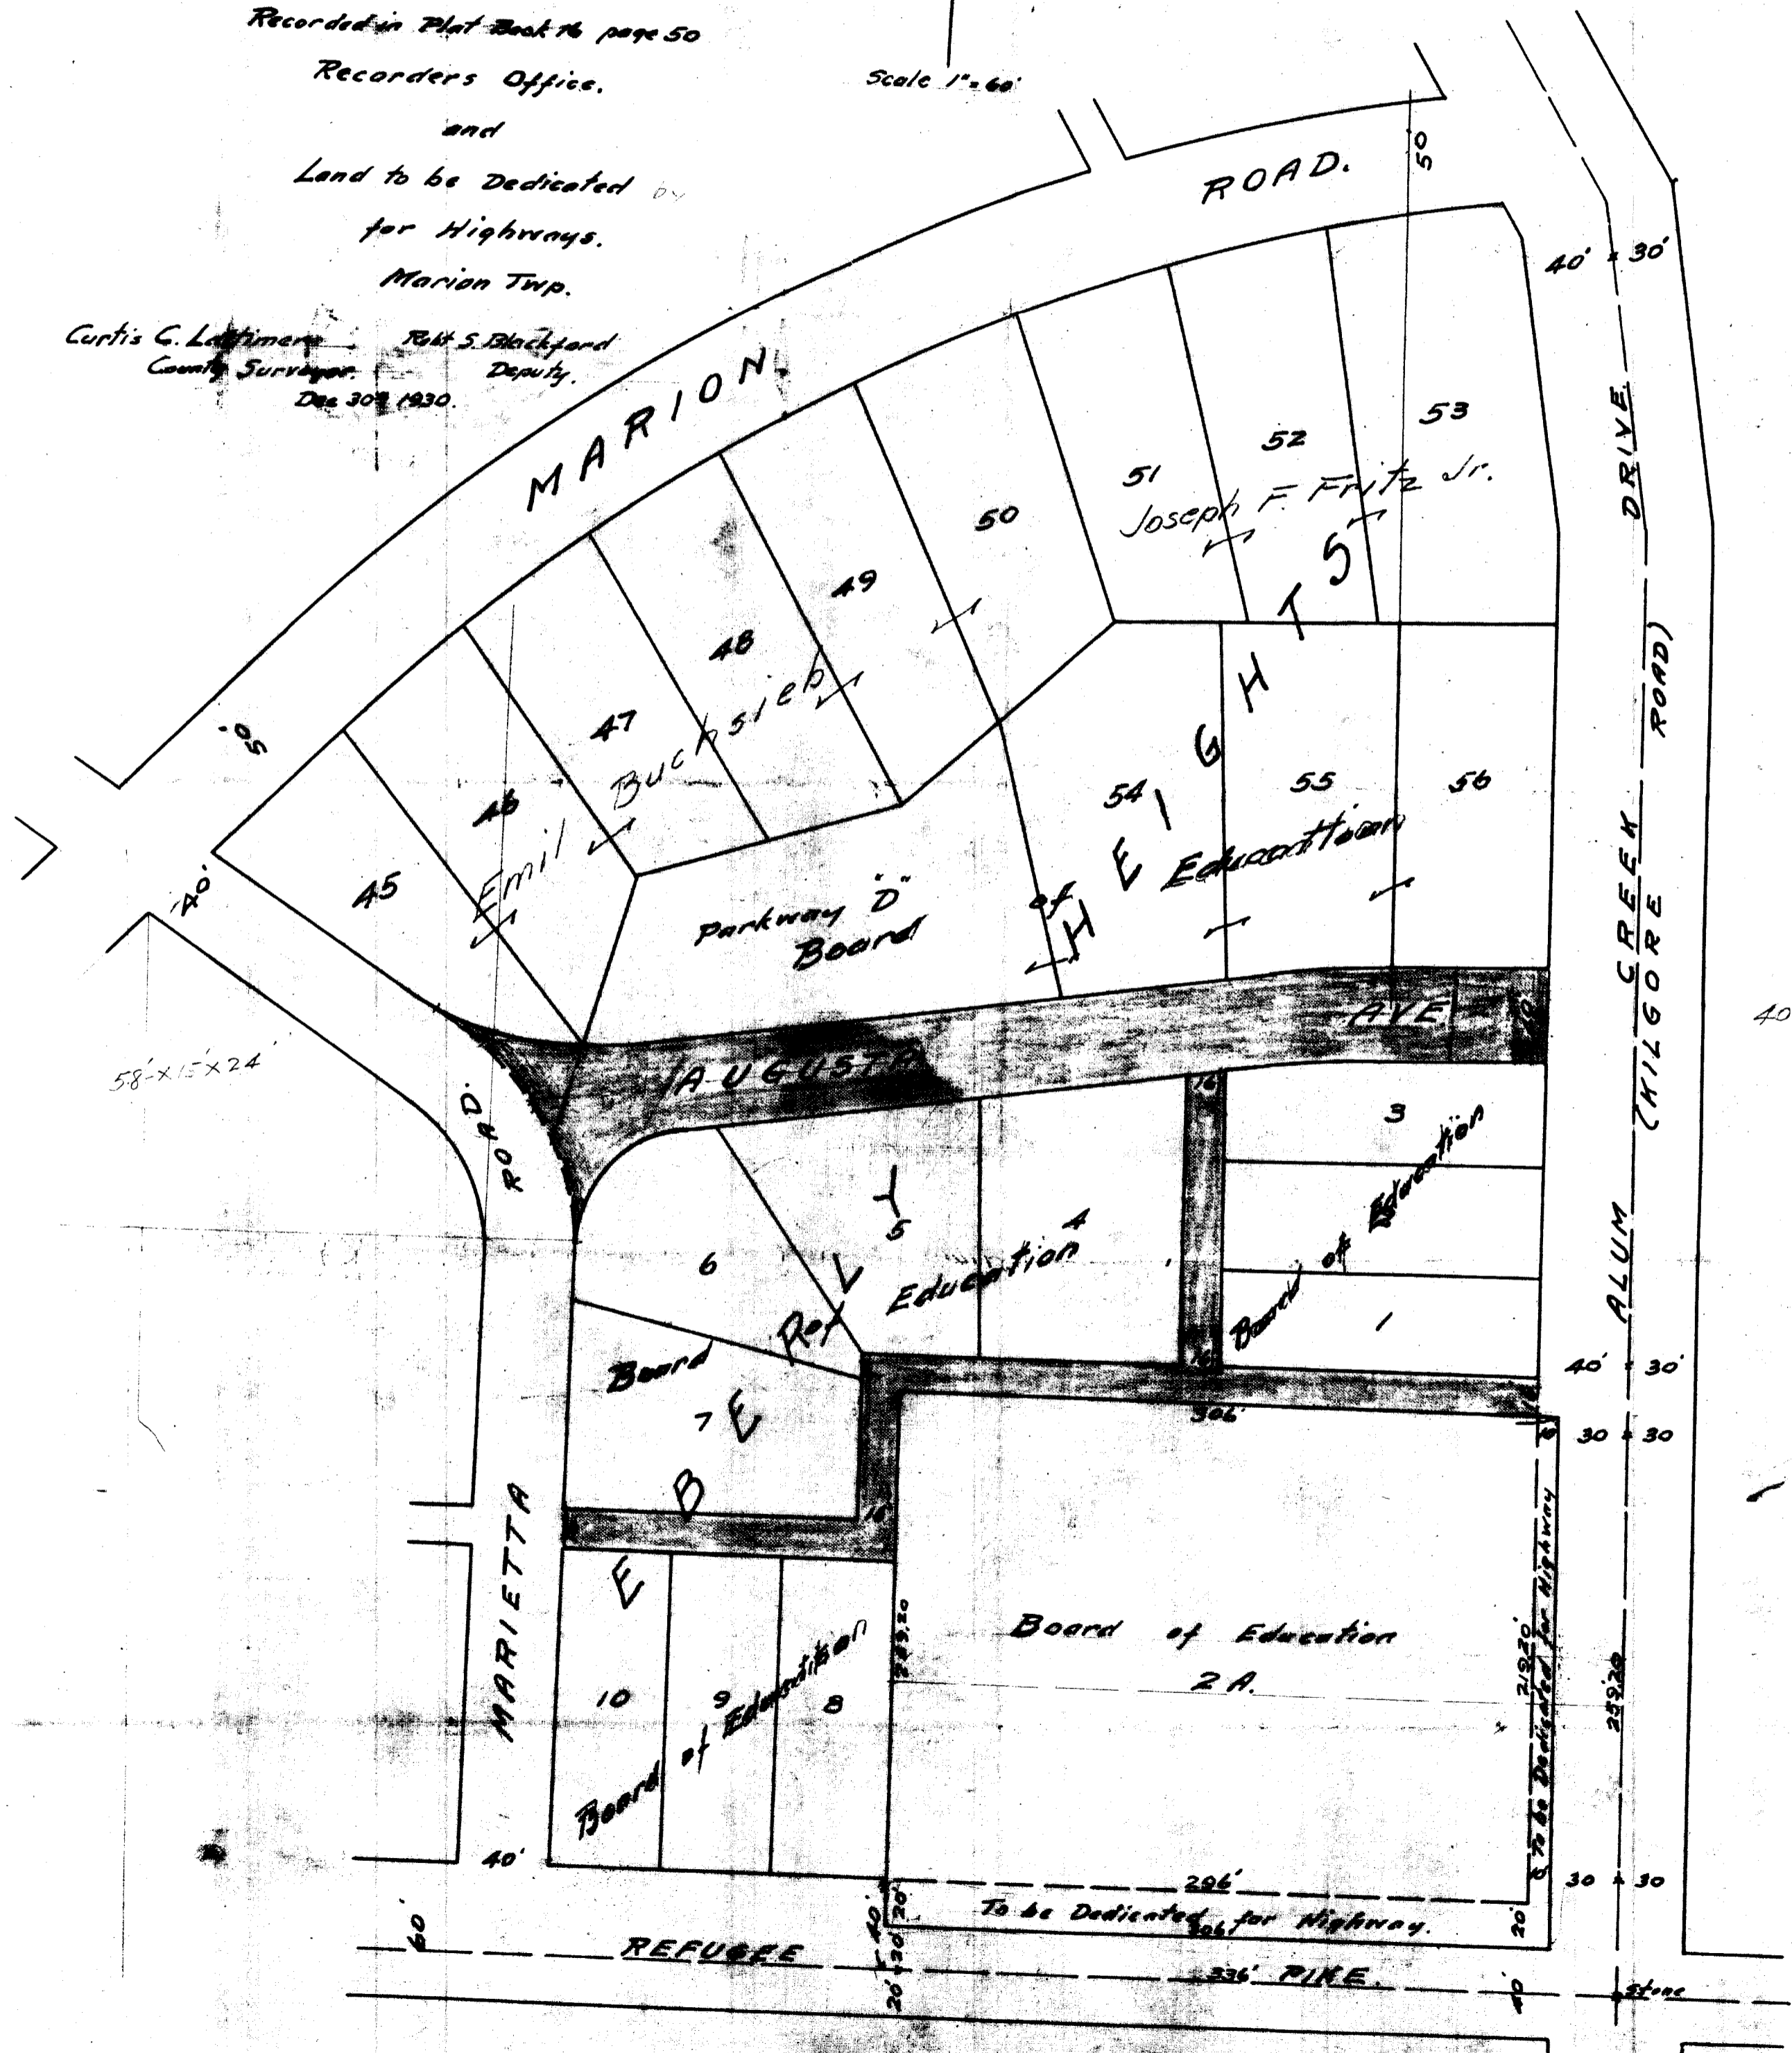

40 x 460'

PLAT SHOWING AUGUSTA AVENUE
 & ALLEYS TO BE VACATED IN EBERLY HEIGHTS,
 AS RECORDED IN PLAT BOOK NO. 16, PAGE NO. 50,
 RECORDERS OFFICE, & LAND TO BE DEDICATED
 FOR HIGHWAYS. MARION TWP., FRANKLIN CO., OHIO
 C. C. LATTIMER, CO. SUR., R. S. BLACKFORD, D. C. S.
 DEC. 30, 1930 SCALE 1" = 60'
 RESCALED 1" = 120'

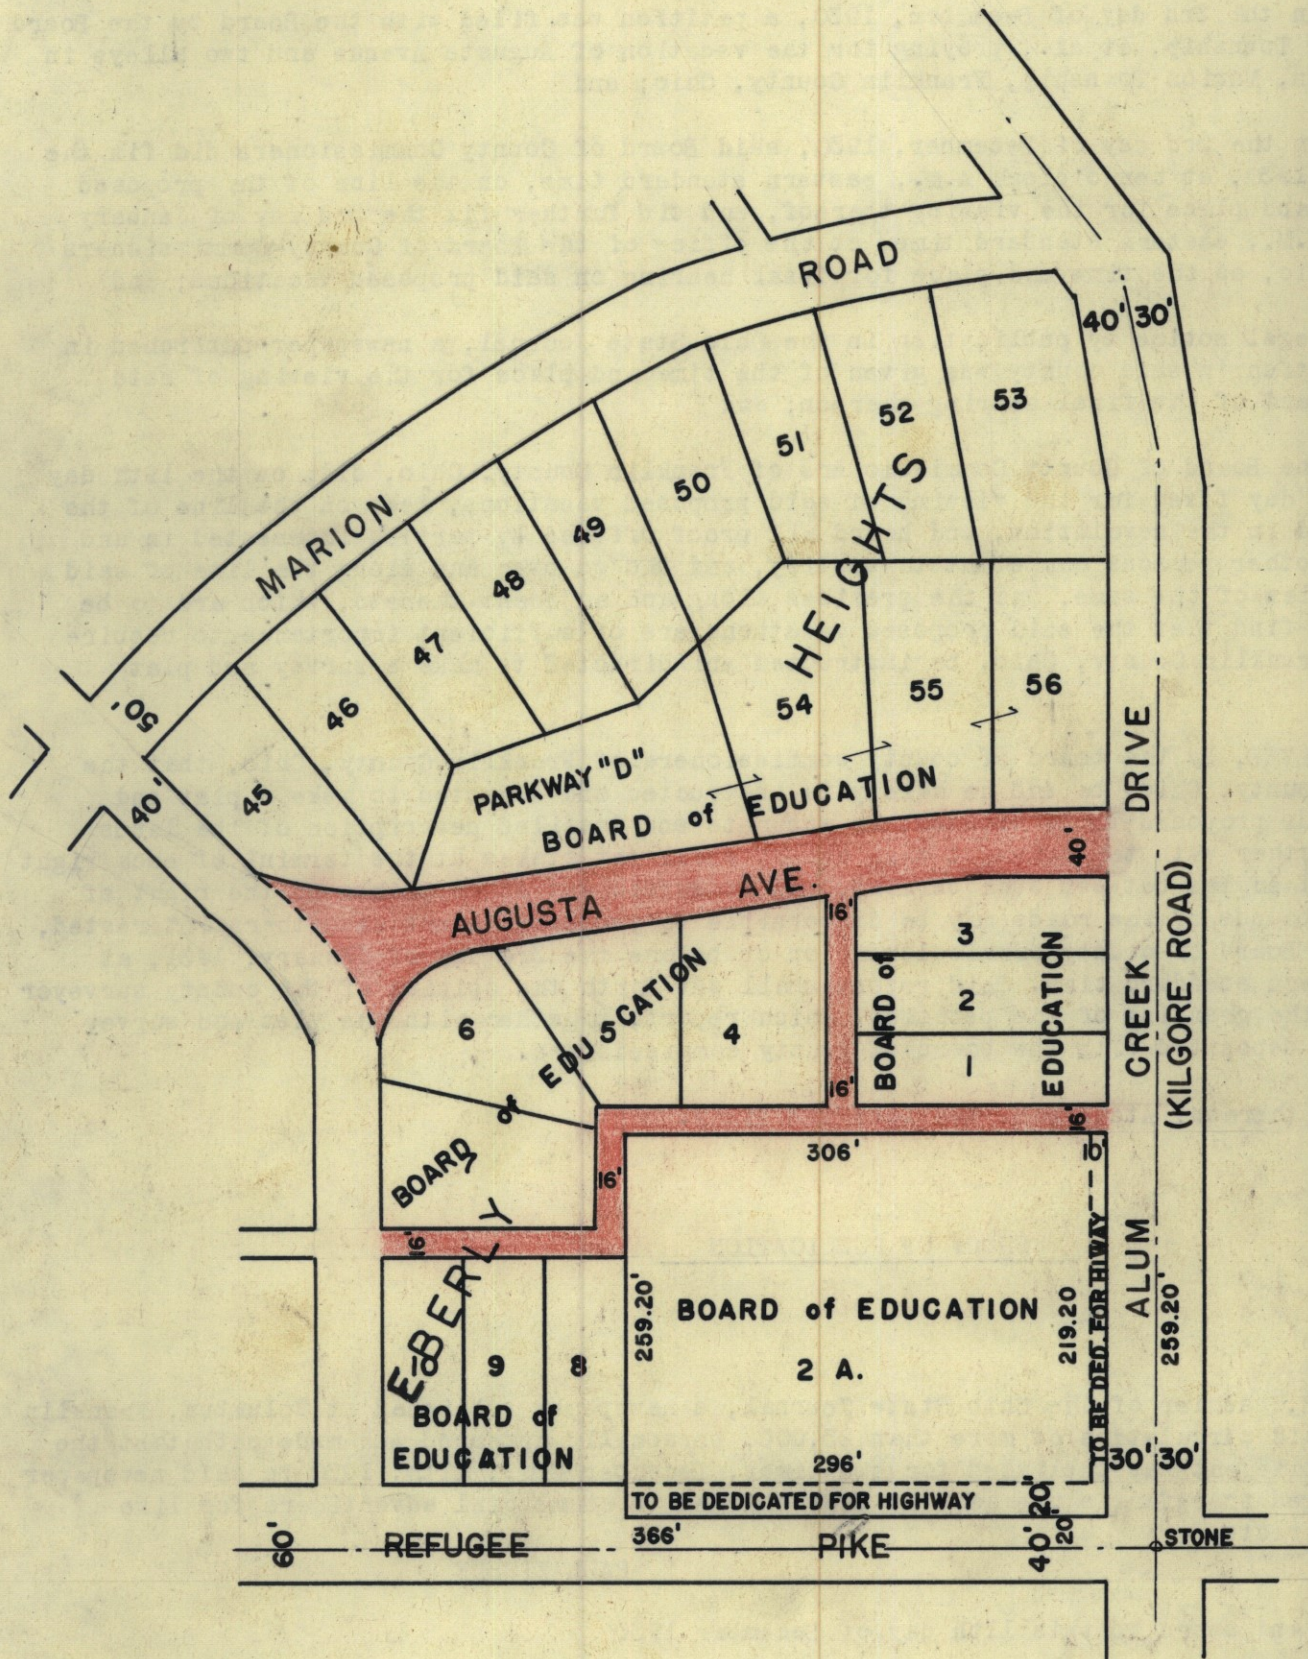

ROAD RECORD NO. 14.

continued from other page

(cont.)
 PAGE NO. 477.


VACATION OF AUGUSTA AVE AND TWO ALLEYS IN
 EBERLY HTS. ADDITION

BE IT RESOLVED, By the Board of County Commissioners of Franklin County, Ohio, that Friday December 19, 1930, at ten o'clock A.M., eastern standard time, is hereby fixed as the date and hour when the Board of County Commissioners will view the proposed vacation on and along the general route thereof; and that Saturday, January 3, 1931, at ten o'clock A.M., eastern standard time, is hereby fixed as the time and date for final hearing on said petition and proposed vacation, at the office of the Board of County Commissioners in the Court House of Franklin County, Ohio; and

BE IT FURTHER RESOLVED, that notice of the time and place for both such view and hearing be given by publication once a week for two consecutive weeks in the Ohio State Journal, a newspaper published in and having a general circulation in Franklin County, Ohio, where the proposed vacation is located, and that said notice in addition to the date and place of such view and place and time of the final hearing shall state briefly the character of the proposed vacations.

Voting Aye thereon: Atcherson, Westlake and Vigor.

continued on next page

 

Subscribed and sworn to this 26th

day of February 1931

W. H. Rible

Notary Public in and for Franklin Co.

W. H. RIBLE
Notary Public, Franklin County Ohio



FRANKLIN CO. O., ROAD RECORD No. ¹⁴~~13~~ Vacating Augusta Ave. and two alleys in Eberly Hts Add.

January 3, 1931

In the matter of the proceedings for the vacation of Augusta Avenue and two alleys in Eberly Heights Addition, Marion Township, Franklin County, Ohio, Mr. Westlake offered the following preamble and resolution and moved the adoption of the same, which was duly seconded by Mr. Vigor.

WHEREAS, On the 19th day of December, 1930, the board of county commissioners of Franklin County, Ohio, did, by proceedings duly adopted authorize and direct the Surveyor of Franklin County, Ohio, to make report in writing to the Board on or before ten o'clock A.M., of Saturday, January 3, 1931, relative to the proceedings for the vacation of Augusta Avenue and two alleys in Eberly Heights Addition; said report to be in manner and form set forth and required by section 6865 of the General Code of Ohio; and

WHEREAS, R. S. Blackford, Deputy County Surveyor on the 3rd day of January, 1931, made report thereon in writing recommending the vacation of said Augusta Avenue and two alleys in Eberly Heights Addition; and

WHEREAS, the Board of County Commissioners of Franklin County, Ohio, finds that the public utility and welfare do not require said roads proposed to be vacated, and described as follows:-

Augusta Avenue, from Kilgore Road to Marietta Road, and the alley north of Refugee Pike from Kilgore Road west, south and west to Marietta Road; also the alley west of Kilgore Road from Augusta Avenue to the first alley south, being located in Eberly Heights, as recorded in Plat Book 16, page 50, Recorder's office, Franklin County, Ohio, and located in Marion Township;

therefore

BE IT RESOLVED, By the Board of County Commissioners of Franklin County, Ohio, that said vacation of Augusta Avenue and two alleys in Eberly Heights Addition, in Marion Township, as described on the plat submitted by the surveyor of Franklin County, Ohio, be and the same are hereby declared vacated.

Voting Aye thereon: Atcherson, Westlake and Vigor.