

FRANKLIN CO. O., ROAD RECORD No. 16 Vacation portion Prushing Ave & 16 ft alley

THE COL. S. B. MFG. CO. 76473

April 6. 1940

Mr. Schneider offered the following preamble and resolution and moved the adoption of the same, which was duly seconded by Mr. Trabue.

WHEREAS, Section 6862 General Code of Ohio, provides that when the Board of County Commissioners is of the opinion that it will be for the public convenience and welfare to locate, establish, alter widen, straighten, vacate or change the direction of a public road, they shall so declare by resolution; therefore

BE IT RESOLVED, By the board of county commissioners of Franklin County, Ohio, all of said Board being present and voting thereon and in favor thereof, that they do hereby declare that it is necessary for the public convenience and welfare that proceedings be had and taken to vacate a portion of a road known as Prushing Avenue and a portion of a 16 foot alley in Englewood Heights Addition, Mifflin Township, Jefferson Township School District, along the following described lines:

PRUSHING AVENUE*

Being all that portion of Prushing Avenue extending eastwardly from the east line of Englewood Drive a distance of approximately 120 feet to the east line of the Englewood Heights Addition, Mifflin Township, Jefferson Township School District, as shown in Plat Book No. 18, page No. 60, Recorder's Office, Franklin County Ohio.

SIXTEEN (16) FOOT ALLEY-

Being a portion of the 16 foot alley situated between and paralleling the Columbus and Johnstown Pike and Prushing Avenue, and being that portion extending eastwardly from Englewood Drive a distance of approximately 120 feet to the east line of the Englewood Heights Addition, Mifflin Township, Jefferson Township School District, as shown in Plat Book No. 18, page No. 60, Recorder's Office, Franklin County, Ohio.

and

BE IT FURTHER RESOLVED, that Friday, April 26, 1940, at ten o'clock A M eastern standard time, on the line of said proposed improvements, be and the same is hereby fixed as the time and place for viewing same; and that Wednesday, May 8, 1940, at ten o'clock A M eastern standard time, at the office of the board of county commissioners of Franklin County, Ohio, be and hereby is fixed as the time and place for final hearing thereon, and that the clerk of the board be and hereby is directed to cause legal publication thereof to be made in the Tri Community News.

Voting Aye thereon: Harry T Vigor, Chas W Schneider and George G Trabue.

STATE OF OHIO } ss.
Franklin County }

Before me, the undersigned authority in and for Franklin County, personally appeared Charles A. Fugler

Fugler, who being duly sworn, deposes and says he is the Editor and Publisher of

The Tri-Community News

a Democratic weekly newspaper, printed at Gahanna, Ohio, and of general circulation in the said county of Franklin, and that a notice, of which a true copy is hereby attached, was published for two times in said newspaper as follows:

April 11th and 18th, 1940


----- 193-----

(Signed) Charles A. Fugler
Publisher.

Sworn to and subscribed before me this 18th day of April, 1940
193-----

Arthur J. Jones
Notary Public.
9/11/41

Printer's Fee \$-----

 

FRANKLIN CO. O., ROAD RECORD No. 16 Vacation portion of Prushing Ave & 16 ft alley

THE COL. B. B. MFG. CO. 79473

April 26.1940

In the matter of the resolution of April 6, 1940, adopted by the Board of County Commissioners for the vacation of a portion of Prushing Avenue and a portion of a 16 foot alley in Englewood Heights Addition, Mifflin Township, Jefferson Township School District, Franklin County, Ohio, Mr. Schneider offered the following preamble and resolution and moved the adoption of the same, which was duly seconded by Mr. Trabue.

WHEREAS, on the 6th day of April, 1940, the board of county commissioners of Franklin County, Ohio, adopted a resolution declaring it necessary to vacate a portion of Prushing Avenue, and a portion of a 16 foot alley in Englewood Heights Addition, Mifflin Township, Jefferson Township School District, Franklin County, Ohio; and

WHEREAS, on the 6th day of April, 1940, said board of county commissioners did fix the 26th day of April, 1940, at ten o'clock A M eastern standard time, on the line of said proposed vacations as the time and place for the viewing thereof, and did further fix the 8th day of May, 1940, at ten o'clock A M eastern standard time, at the office of the board of county commissioners of Franklin County, Ohio, as the time and place for final hearing on said vacations; and

WHEREAS, Legal notice by publication in the Tri Community News, a newspaper published in and of general circulation in said county, was given of the time and place for the viewing of said vacations and of the final hearing thereon; and

WHEREAS, The board of county commissioners of Franklin County, Ohio, did, on the 26th day of April, 1940, the day fixed for the viewing of the said proposed vacations, meet on the line thereof as described in the petition and heard all the proof offered by parties interested in and affected thereby and other persons competent to testify and did go over and along the line of said proposed vacations, and by actual view of same, and the premises along and adjacent thereto which are to be affected thereby, does find that the vacation of a portion of Prushing Avenue and a portion of a 16 foot alley in Englewood Heights Addition, Mifflin Township, Jefferson Township School District is of sufficient importance to require that the engineer of Franklin County, Ohio, be instructed and directed to make a survey and plat thereof; therefore

BE IT RESOLVED, By the board of county commissioners of Franklin County, Ohio, that the engineer of Franklin County, Ohio, be and he is hereby instructed and directed to make a plat and survey of the proposed vacation of a portion of Prushing Ave., and a portion of a 16 foot alley in Englewood Heights Addition, Mifflin Township, Jefferson Township School District, an accurate and detailed description of each tract of land which will be necessary to be taken, together with the names of each owner, shall set stakes at the termini of each right of way line and at all angles between such termini, and at sufficient other points in the right of way lines, so that the bounds of the proposed vacations may be discernible to property owners and others interested, and make report to the Board of County Commissioners on or before the 8th day of May, 1940, at ten o'clock A M eastern standard time. Said report shall set forth the opinion of the county engineer either for or against the granting of said vacations, which report, together with the Plat and survey of the proposed vacations, shall be deposited with the County Commissioners.

Voting Aye thereon: Chas W Schneider and George G Trabue. Absent and not voting, Harry T Vigor.

May 4, 1940

SUBJECT: Proposed vacation of a portion of Prushing Ave. and a portion of a 16 foot alley in Englewood Heights Addition, Mifflin Township, Jefferson Township School District, Franklin County, Ohio.

Hon. Board of County Commissioners, Franklin County, Ohio. Gentlemen: Pursuant to your order of April 26, 1940, I have made a survey and plat, which I hereby submit, of a portion of Prushing Avenue and a 16 foot alley in Englewood Heights Addition, Mifflin Township, Jefferson Township School District, Franklin County, Ohio, and which said portions are described as follows:

PRUSHING AVENUE: Being all that portion of Prushing Avenue extending eastwardly from the east line of Englewood Drive, a distance of approximately 120 feet to the east line of Englewood Heights Addition, Mifflin Township, Jefferson Township School District, as shown in Plat Book No. 18, page No. 60, Recorder's office, Franklin County, Ohio.


SIXTEEN (16) FOOT ALLEY: Being a portion of the 16 foot alley situated between and paralleling the Columbus and Johnstown Pike and Prushing Avenue, and being that portion extending easterly from Englewood Drive a distance of approximately 120 feet to the east line of the Englewood Heights Addition, Mifflin Township, Jefferson Township School District, as shown in Plat Book No. 18, page No. 60, Recorder's office, Franklin County, Ohio.

I am of the opinion that the proposed vacation of the aforesaid portions of Prushing Avenue and the sixteen (16) foot alley would be of no inconvenience to the general public, and I, therefore, recommend the said vacation as shown on the accompanying plat. Respectfully submitted, Allan Slade, County Engineer.

AS-H-Enc

FRANKLIN CO. O., ROAD RECORD No. 16 Vacation of portion of Prushing Ave. & 16' alley

THE COL. B. B. MFG. CO. 76473

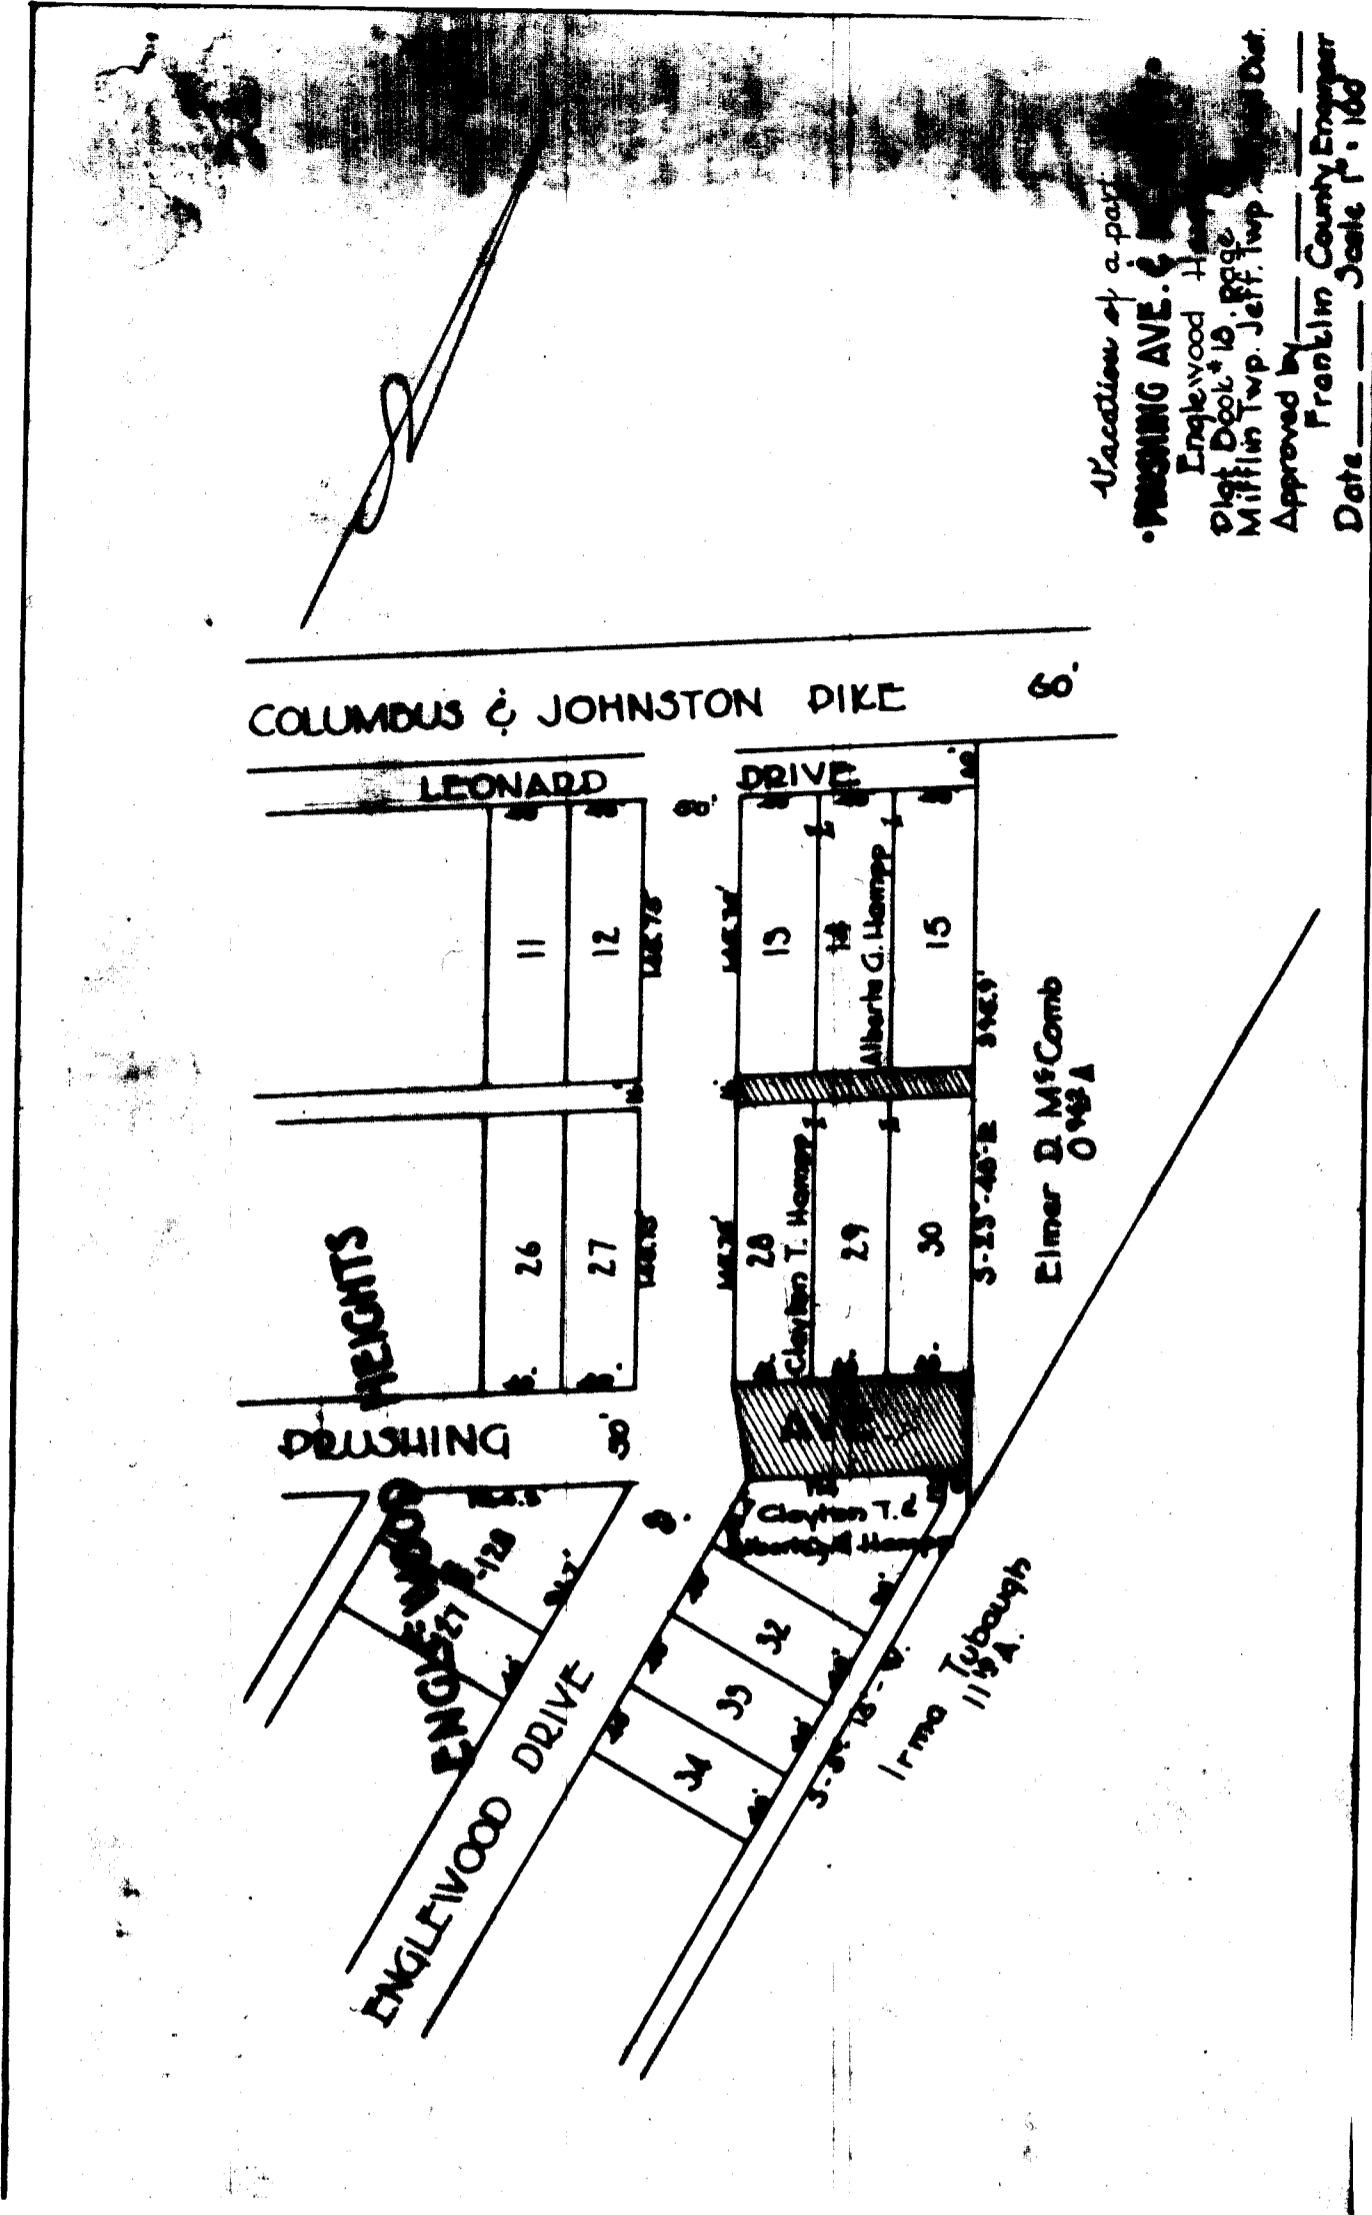

PORTION OF PRUSHING AVE. AND PORTION OF 16 FOOT ALLEY IN MIFFLIN TWP. DECLARED VACATED

May 8 1940

In the matter of the proceedings relative to the vacation of a portion of Prushing Avenue and a portion of a 16 foot alley in Mifflin Township, Mr. Schneider offered the following preamble and resolution, and moved the adoption of the same, which was duly seconded by Mr. Trabue.

WHEREAS, On the 26th day of April, 1940, the board of county commissioners of Franklin County, Ohio, did, by resolution duly adopted, direct the engineer of Franklin County, Ohio, to make report in writing to said Board on or before ten o'clock A.M. of Wednesday, May 8, 1940, relative to the vacation of a portion of Prushing Avenue and a portion of a 16 foot alley in Englewood Heights Addition, Mifflin Township; said report to be in manner and form set forth and required by section 6865 of the General Code of Ohio; and

WHEREAS, on the 4th day of May, 1940, Allan Slade County Engineer, did report thereon in writing which report contained the following recommendation, to wit:--

"Honorable Board of County Commissioners, Franklin County, Ohio. Gentlemen: Pursuant to your order of April 26, 1940, I have made a survey and plat, which I hereby submit, of a portion of Prushing Avenue and a sixteen foot alley in Englewood Heights Addition, Mifflin Township,

FRANKLIN CO. O., ROAD RECORD No. 16 Vacation of a portion of Prushing Ave. & 16' alley

THE COL. S. P. MFG. CO. 76473

Jefferson Township School District, Franklin County, Ohio, and which said portions are described as follows:-

PRUSHING AVENUE: Being all that portion of Prushing Avenue extending eastwardly from the east line of Englewood Drive, a distance of approximately 120 feet to the east line of Englewood Heights Addition, Mifflin Township, Jefferson Township School District, as shown in Plat Book No. 18, page No. 60, Recorder's office, Franklin County, Ohio.

Sixteen (16) FOOT ALLEY: Being a portion of the 16 foot alley situated between and paralleling the Columbus and Johnstown Pike and Prushing Avenue, and being that portion extending easterly from Englewood Drive a distance of approximately 120 feet to the east line of the Englewood Heights Addition, Mifflin Township, Jefferson Township School District, as shown in Plat book No. 18, page No. 60, Recorder's office, Franklin County, Ohio.

I am of the opinion that the proposed vacations of the aforesaid portions of Prushing Ave. and the 16 foot alley would be of no inconvenience to the general public, and I, therefore, recommend the said vacation as shown on the accompanying plat. Respectfully submitted, Allan Slade County Engineer."

and

WHEREAS, No objections to the vacation of said portion of Prushing Avenue and said portion of the 16 foot alley were filed, nor claims for compensation or damages on account thereof were filed; and

WHEREAS, The Board of County Commissioners of Franklin County, Ohio, finds that the public utility and welfare do not require said portion of Prushing Avenue and said portion of the 16 foot alley in Englewood Heights Addition, and that the vacation thereof would not inconvenience the public; therefore

BE IT RESOLVED, By the board of county commissioners of Franklin County, Ohio, that the portion of Prushing Avenue and the portion of the 16 foot alley in Englewood Heights Addition, Mifflin Township, above described, as recommended by the county engineer, to be vacated and as described in his report and shown on the plat submitted by him, be and the same hereby is declared vacated.

Voting Aye thereon: Harry T Vigor, Chas W Schneider and George G Trabue.