

FRANKLIN CO. O., ROAD RECORD No. 16 Petition to Vacate Part of Griswold St and alleys
in Sunnyview Addition

THE COL. B. B. MFG. CO. 76473

PUBLIC ROAD PETITION

To the Hon Board of County Commissioners Franklin County, Ohio. Rec. Co Commrs office
October 5, 1945

The undersigned petitioners, freeholders of said county, residing in the vicinity of the proposed improvement hereinafter described respectfully represent that the public convenience and welfare require the vacation of parts of streets and alleys on the line hereinafter described and make application to you to institute and order proper proceedings in the premises for the vacation of such road, the same not being a road on the state highway system.

The following is the general route and termini of said road:

Beginning at the southwest corner of Lot No. 26 of Sunnyview Addition (Plat Book 17, page 15, Recorder's office, Franklin County, Ohio). thence north along the west line of lots 26, 25, 24 and 23 of said Sunnyview Addition and the east line of Griswold Street 216 feet to the north terminus of Griswold Street and the south line of the farm lands on the north; thence west along the south line of said farm lands a distance of 50 feet to a point; thence south along the west line of Griswold Street and the east line of lots 52, 51, 50 and 49 of said Sunnyview Addition 216 feet to the south east corner of said lot No 49; thence east along the south line of said lot 49 projected, a distance of 50 feet to the place of beginning; being the north 216 feet of Griswold Street, including the intersection of the north end of Griswold Street with a 16 foot alley which extends in an easterly and westerly direction across the north end of said Sunnyview Addition. Said portion of Griswold Street sought to be vacated is not improved, has not been used by the public for more than 21 years, and in fact, has never been opened or used for highway purposes.

Also the following described premises—beginning at a point in the west line of Proprietors Road and in the northeast corner of Sunnyview Addition (Plat Book 17, page 15, Recorder's Office, Franklin County, Ohio); thence west along the north line of Sunnyview Addition to the northwest corner of said addition; thence south along the west line of said addition 16 feet to a point; thence east along the north line of lots Nos. 52, 23 and 22 of said addition to a point in the west line of Proprietors road; thence north 16 feet to the place of beginning, said tract to be vacated consisting of a 16 foot alley extending in an easterly and westerly direction across the north end of said addition; also the 16 foot alley extending from the north line of Sunnyview Addition south to the north line of the corporate limits of the Village of Worthington, Ohio, and abutting on lots 23, 24, 25, 26, 27, 28, 29, 30, 31, 32, 33 and 34 and lots 11, 12, 13, 14, 15, 16, 17, 18, 19, 20, 21, and 22 of Sunnyview Addition. Also the 10 foot alley extending from the north line of Sunnyview Addition south to the corporate limits of the Village of Worthington, Ohio and abutting on lots 41, 42, 43, 44, 45, 46, 47, 48, 49, 50, 51 and 52 of Sunnyview Addition.

Petitioners Names: James L Hagle, Geo T Harding, J Henry Mann, D K Nicole, Mary Virginia Harding Ruth Herding Evans Elsie W Harding, J A Caldwell, Mrs Ruby Caldwell, Wm W Lewis Rosemond Lewis, Charles Goering, John R Scatterday, Adelaide Hinkle Hall Gertrude Jones Hagle, Marion Ford, Naomi M Frederick. Byron E Ford, Melvin F Down Geo H Warner.

PETITION TO VACATE PART OF GRIDWOLD
ST AND ALLEYS IN SUNNYVIEW ADD. SHARON
TWP. FILED. VIEW OCT 24 FINAL HEARING
OCTOBER 30 1945

October 5 1945

Mr. Vigor offered the following preamble and resolution and moved the adoption of the same, which was duly seconded by Mr. Matson.

WHEREAS, James L Hagle et al. on the 5th day of October, 1945, presented a petition to the Board of County Commissioners of Franklin County, Ohio, signed by at least twelve freeholders of Franklin County, residing in the vicinity of the proposed vacations, requesting said Board to vacate a portion of Griswold street and alleys in Sunnyview Addition, Sharon Township, said street and alleys to be vacated more particularly described as follows:

Beginning at the southwest corner of Lot 25 of Sunnyview Addition (Plat Book 17, page 15, Recorder's office, Franklin County, Ohio), thence north along the west line of lots 26, 25, 24 and 23 of said Sunnyview Addition and the east line of Griswold Street 216 feet to the north terminus of Griswold Street and the south line of the farm lands on the north; thence west along the south line of said farm lands a distance of 50 feet to a point; thence south along the west line of Griswold Street and the east line of lots 52, 51, 40 and 49 of said Sunnyview Addition 216 feet to the southeast corner of said lot No. 49; thence east along the south line of said lot 49 projected, a distance of 50 feet to the place of beginning; being the north 216 feet of Griswold Street, including the intersection of the north end of Griswold Street with a 16 foot alley which extends in an easterly and westerly direction across the north end of said Sunnyview Addition. Said portion of Griswold Street sought to be vacated is not improved, has not been used by the public for more than 21 years and in fact, has never been opened or used for highway purposes.

Also the following described premises; beginning at a point in the west line of Proprietors Road and in the northeast corner of Sunnyview Addition, (Plat book 17, page 15, Recorder's Office, Franklin County, Ohio); thence west along the north line of Sunnyview Addition to the northwest corner of said addition; thence south along the west line of said addition 16 feet to a point; thence east along the north line of lots Nos. 52, 23, and 22 of said addition to a point in the west line of Proprietors Road; thence north 16 feet to the place of Beginning, said tract to be vacated consisting of a 16 foot alley extending in an easterly and westerly direction across the north end of said addition.

Also the 16 foot alley extending from the north line of Sunnyview Addition south to the north line of the corporate limits of the village of Worthington, Ohio, and abutting on lots 23, 24, 25, 26, 27, 28, 29, 30, 31, 32, 33, and 34 and lots 11, 12, 13, 14, 15, 16, 17, 18, 19, 20, 21, and 22 of Sunnyview Addition.

Also the 10 foot alley extending from the north line of Sunnyview Addition south to the corporate limits of the village of Worthington, Ohio, and abutting on lots 41, 42, 43, 44, 45, 46, 47, 48, 49, 50, 51 and 52 of Sunnyview Addition.

therefore

FRANKLIN CO. O., ROAD RECORD No. 16 Vacation of Part of Griswold Street and alleys in Sunnyview Addition.

THE COL. B. D. MFG. CO. 76473

BE IT RESOLVED, By the board of county commissioners of Franklin County, Ohio, that Wednesday October 24, 1945, at ten o'clock A M is hereby fixed as the date and hour when the board of county commissioners will view the proposed vacations along the general route thereof; and that Tuesday October 30, 1945, at ten o'clock A M is hereby fixed as the time and date for the final hearing on said petition and proposed vacations at the office of the board of county commissioners in the court house of Franklin County, Ohio; and

BE IT FURTHER RESOLVED, that notice of the time and place for both view and hearing be given by publication once a week for two consecutive weeks in the Ohio State Journal, a newspaper published in and having general circulation in Franklin County, Ohio, where the proposed vacations are located, and that said notice, in addition to the date and place of such view and place and time of the final hearing shall state briefly the character of the proposed vacations.

Voting Aye thereon: C.F. Hauderbaugh, Harry T Vigor and George W. Matson.

PROOF OF PUBLICATION

State of Ohio } ss.
Franklin County }
Robert W. Irwin
Secretary - Treasurer of the Ohio State Journal, a newspaper published at Columbus, Franklin County, Ohio, with a paid circulation of more than 25,000, personally appeared and made oath that the attached printed advertisement was published for

Two times, on Oct 6-13 1945

in said newspaper and that the rate charged therefor is the same as that charged to commercial advertisers for like services on annual contracts.


[Signature]

Suscribed and sworn to this 13th

day of Oct 1945

E.T. Spetnagel
Notary Public in and for Franklin Co.

E. T. SPETNAGEL, Notary Public

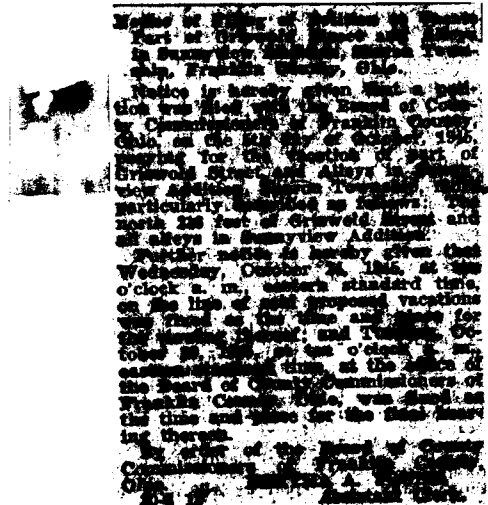

ENGINEER DIRECTED TO PREPARE PLAT AND SURVEY FOR VACATION OF PART OF GRISWOLD STREET AND ALLEYS IN SUNNYVIEW ADDITION, SHARON TOWNSHIP

October 24 1945

In the matter of the petition filed with the Board of County Commissioners of Franklin County Ohio, on the 5th day of October 1945, praying for the vacation of part of Griswold Street and alleys in Sunnyview Addition, Sharon Township, Mr. Vigor offered the following preamble and resolution and moved the adoption of the same, which was duly seconded by Mr. Matson.

WHEREAS, on the 5th day of October 1945, a petition was filed with the board of county commissioners by James L. Hagle, et al. praying for the vacation of part of Griswold Street and alleys in Sunnyview Addition, Sharon Township, Franklin County, Ohio; and

WHEREAS, On the 5th day of October 1945, said board of county commissioners did fix the 24th day of October, 1945, at ten o'clock A M on the line of the proposed vacations as the time and place for the viewing thereof; and did further fix the 30th day of October 1945, at ten o'clock A M at the office of the board of county commissioners as the time and place for final hearing on said proposed vacations; and

WHEREAS, Legal notice by publication in the Ohio State Journal, a newspaper published in and of general circulation in said county was given of the time and place for the viewing of said street and alley vacations and of the final hearing thereon; and

WHEREAS, The board of county commissioners of Franklin County, Ohio, did, on the 24th day of October, 1945, the day fixed for the viewing of the said proposed street and alley vacations meet on the line thereof, as described in the resolution and heard all the proof offered by parties interested in and affected thereby and other persons competent to testify and did go over and along the line of said proposed vacations in Sunnyview Addition and by actual view of same and the premises along and adjacent thereto, which are to be affected thereby, does find that the vacations of said Part of Griswold Street and alleys in Sunnyview Addition is of sufficient importance to require that the engineer of Franklin County, Ohio, be instructed and directed to make a survey and plat thereof; therefore

FRANKLIN CO. O., ROAD RECORD No. 16 Vacation Part Griswold Street and Alleys in Sunnyview Addition

THE COLL. B. S. MFG. CO. 76473

BE IT RESOLVED, By the Board of County Commissioners of Franklin County, Ohio, that the engineer of Franklin County, Ohio, be and he hereby is instructed and directed to make a plat and survey of the proposed vacation of a part of Griswold Street and alleys in Sunnyview Addition, Sharon Township, an accurate and detailed description of each tract of land affected together with the names of each owner, shall set stakes at the termini of each right of way line and at all angles between such termini, and at sufficient other points in the right of way lines, so that the bounds of the proposed street and alley vacations may be discernible to property owners and others interested, and make report to the Board of County Commissioners on or before the 30th day of October, 1945, at ten o'clock A.M. Said report shall set forth the opinion of the county engineer either for or against the granting of said vacations, which report, together with the plat and survey of the proposed part of Griswold Street and alleys in Sunnyview Addition vacations shall be deposited with the county Commissioners.

Voting Aye thereon: Harry T Vigor and George W Watson. Absent and not voting C P Leuderbaugh

Board of County Commissioners, Franklin County, Ohio. Subject: Vacation of a Part of Griswold Street and parts of alleys in Sunnyview Add. Sharon Twp.

October 30. 1945

Gentlemen:


Pursuant to your order of October 24, 1945, I have made a survey and plat of a part of Griswold Street and parts of alleys in Sunnyview Addition, Sharon Township, Franklin County, Ohio.

I have made a study and an investigation of the proposed vacation and submit the following report:

Elsie W Harding, owner of a number of lots in Sunnyview Addition, has donated to Seventh Day Adventist Church, lots numbered 26, 25, 24, 23 and Lots numbered 49, 50, 51 and 52 of said addition as a site for a new church.

The parts of alley that are situated within the Corporation of Worthington were vacated by action of the Village Council on December 6, 1937. The street and alleys sought to be vacated are unimproved and are not now used by the traveling public.

I see no harm or inconvenience to the travelling public by the vacation of this part of Griswold Street and the remaining alleys in this Addition, therefore I recommend the vacation of a part of Griswold Street and parts of alleys in Sunnyview Addition, Sharon Township, Franklin County, Ohio, as shown on the attached plat. Respectfully submitted. Allen Slade, County Engineer.

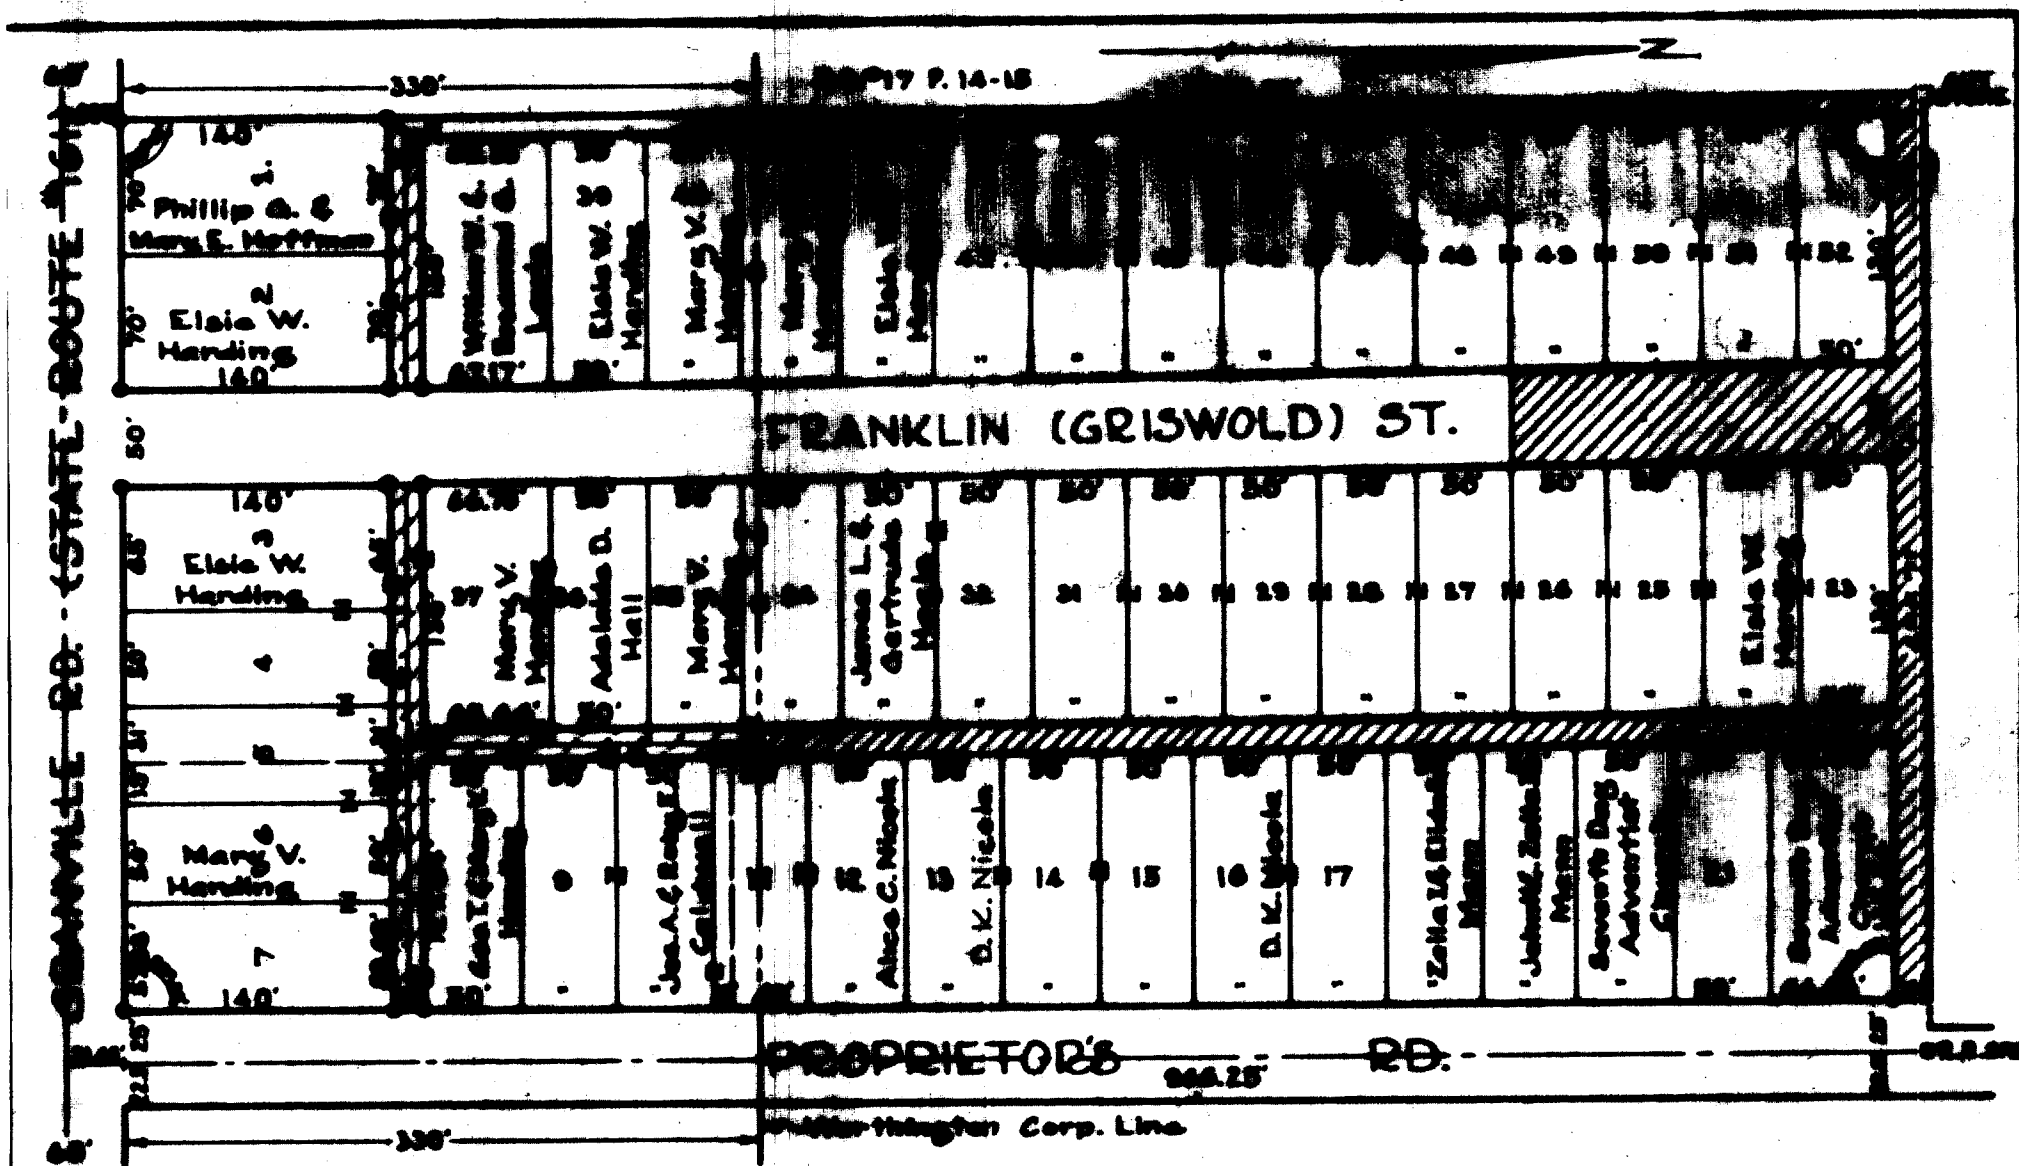

Vacated by Village of Worthington by Ord. 6546 on 12-6-37. To be vacated by Franklin County.

VACATION PORTION FRANKLIN ST. AND ALL ALLEYS IN SUNNYVIEW ADDITION SHARON TWP. FRANKLIN COUNTY O. Approved By [Signature] Franklin County Engineer Date: 10-30-45. Scale 1" = 100'

FRANKLIN CO. O., ROAD RECORD No. 16 Vacation Part of Griswold Street and Alleys in Sunnyview Addition

THE COL. B. B. MFG. CO. 76473

PRAYER OF PETITION TO VACATE PART OF
GRISWOLD STREET AND ALLEYS IN SUNNYVIEW
ADDITION, SHARON TWP GRANTED,

October 30 1945

In the matter of the petition filed by James L. Hagle, et al. praying for the vacation of part of Griswold Street and alleys in Sunnyview Addition, Sharon Township, Mr. Vigor offered the following preamble and resolution and moved the adoption of the same, which was duly seconded by Mr. Matson.

WHEREAS, On the 24th day of October 1945, the board of county commissioners of Franklin County Ohio, by resolution duly adopted directed the engineer of Franklin County, Ohio, to make report to this board on or before ten o'clock A M of Tuesday, October 30 1945 relative to the proceedings for the vacation of part of Griswold Street and alleys in Sunnyview Addition, Sharon Township, Franklin County, Ohio; said report to be made in manner and form set forth and required by section 6865 General Code of Ohio; and

WHEREAS, Allen Slade, County engineer, did on the 30th day of October, 1945, report thereon in writing, which report contained the following recommendation to wit:

"October 30 1945. Board of County Commissioners, Franklin County, Ohio. Re; Vacation of a part of Griswold Street and parts of alleys in Sunnyview Addition, Sharon Township. Gentlemen: Pursuant to your order of October 24, 1945, I have made a survey and plat of a part of Griswold Street and parts of alleys in Sunnyview Addition, Sharon Township, Franklin County, Ohio. I have made a study and an investigation of the proposed vacation and submit the following report:

Elsie W Harding, owner of a number of lots in Sunnyview Addition, has donated to Seventh Day Adventist Church lots numbered 26, 25, 24, 23 and lots numbered 49, 50, 51 and 52 of said Addition as a site for a new church. The parts of alley that are situated within the Corporation of Worthington were vacated by action of the Village Council on December 6, 1937. The street and alleys sought to be vacated are unimproved and are not now used by the traveling public. I see no harm or inconvenience to the traveling public by the vacation of this part of Griswold Street and the remaining alleys in this Addition, therefore I recommend the vacation of a part of Griswold Street and parts of alleys in Sunnyview Addition, Sharon Township, Franklin County, Ohio, as shown on the attached plat. Respectfully submitted, Allen Slade, County Engineer."

and

WHEREAS, The County Commissioners of Franklin County, Ohio, find that the public utility and welfare do not require said part of Griswold Street and alleys in Sunnyview Addition, Sharon Township, and that the vacation thereof would not inconvenience the public; therefore

BE IT RESOLVED, By the Board of County Commissioners of Franklin County, Ohio, that said Board hereby determines that the public utility and welfare do not require said part of Griswold Street and alleys in Sunnyview Addition, and therefore said street and parts of alleys be and the same are hereby declared vacated in accordance with the recommendation of the county engineer and as set forth in the plat submitted by said engineer.

Voting Aye thereon: C P Lauderbaugh, Harry T Vigor and George W. Matson.