

PUBLIC ROAD PETITION

Rev. Code Sec. 5553.042  
Rev. Code Sec. 5553.10

Columbus, Ohio, March 29, 1968

TO THE HONORABLE BOARD OF COUNTY COMMISSIONERS OF FRANKLIN COUNTY, OHIO:

The undersigned Petitioner respectfully represents that he is an abutting land owner of the alley hereinafter described. Petitioner further represents that said 15.00 foot alley has remained unimproved and unopened after its dedication as a part of Rome-Manor Subdivision, Recorder's Plat Book 16, Page 4, a period greater than seven (7) years. Said Plat was recorded on August 24, 1923.

The petitioner further represents that said alley has been abandoned and not used for a period of twenty-one (21) years. The following is the general route and termini of said alley: Said alley is in a block bounded by Owen Street on the North, Evergreen Terrace on the West, Sullivant Avenue on the South and Woodlawn Avenue on the East. More specifically, beginning at the Northeast corner of Lot Number 142 of said Subdivision; thence in a Westerly direction for 225.05 feet to a point at the Northwest corner of Lot Number 149; thence in a Northerly direction for a distance of 15.05 feet to the Southwest corner of Lot Number 393 of said Subdivision; thence in an Easterly direction for a distance of 225.05 feet to the Southeast corner of Lot Number 150 of said Subdivision; thence in a Southerly direction for a distance of 15.05 feet to the point of beginning.

Therefore, the Petitioner respectfully makes application to you to institute and order proper proceedings in the premises, for vacating such alley, subject to existing easements, the same not being a road on the state highway system.

William J. Ahern /S/

STATE OF OHIO  
FRANKLIN COUNTY, ss:

William J. Ahern, being first duly sworn, deposes and says that he is the Plaintiff herein; ; that the facts stated and the allegations contained in the foregoing Petition are true as he verily believes.

William J. Ahern /S/

Sworn to before me and sub-scribed in my presence this 1st day of April, 1968.

Barbara A. Hallsteine /S/  
Notary Public, Franklin County, Ohio  
My Commission Expires June 9, 1970

\* \* \* \* \*

June 3, 1968

Mr. Guy Elbin  
Franklin County Engineer  
970 Dublin Road  
Columbus, Ohio 43212

Re: Petition Submitted by William J. Ahern, for vacation of a 15.00 foot alley, located in Prairie Township, Franklin County, Ohio.

Dear Mr. Elbin:

Please determine that the above mentioned alley, named in the attached petition has not been used for a period of twenty-one (21) years immediately preceding the filing of this petition and that formal proceedings for the vacation thereof, as provided in Section 5553.04 of the Revised Code, have not been taken.

Very truly yours,

Robert T. Southwick, Chairman /S/  
Board of County Commissioners  
Franklin County, Ohio

\* \* \* \* \*

HEER PTG. CO., COLS., O. CDS2506

Cont'd. -Vac. of a 15.00 Ft. Alley "Rome Manor Subdivision", Prairie Township, Franklin County, Ohio.

June 18, 1968

Board of County Commissioners  
Court House  
Columbus, Ohio 43215

Re: Petition submitted by William J. Ahern, for vacation of a 15.00 foot alley, located in Prairie Township, Franklin County, Ohio

Gentlemen:-

Pursuant to your letter of June 3, 1968, it has been determined that said Alley has not been used for a period in excess of twenty-one years and said alley shall be vacated pursuant to Section 5553.042 of the Revised Code. A Plat of the above mentioned alley vacation is attached hereto.

Respectfully submitted,

Guy Elbin, P.E.  
Franklin County Engineer

By Cletus E. McPherson /s/

\* \* \* \* \*

June 18, 1968

PETITION TO VACATE A FIFTEEN FOOT ALLEY IN PRAIRIE TOWNSHIP, FRANKLIN COUNTY, OHIO - GRANTED.

In the matter of the petition filed March 29, 1968, by William J. Ahern, for the vacation of a fifteen (15.00) foot Alley in Rome-Manor Subdivision, Prairie Township, Franklin County, Ohio, Mr. Koontz offered the following preamble and resolution and moved the adoption of the same, which was duly seconded by Mr. Myers.

WHEREAS, on June 3, 1968, the Commissionees requested the Engineer of Franklin County, Ohio, to determine that the above mentioned Alley has not been used for a period in excess of twenty-one years immediately preceding the filing of this petition and that formal proceedings for the vacation thereof, as provided in Section 5553.04 of the Revised Code, have not been taken; and

WHEREAS, on June 18, 1968, Guy Elbin, County Engineer, did report thereon in writing that said Alley has not been used for a period in excess of twenty-one years and said Alley shall be vacated pursuant to Section 5553.042 of the Revised Code; therefore,

BE IT RESOLVED, by the Board of County Commissioners of Franklin County, Ohio, that the vacation of a fifteen (15.00) foot Alley in Rome-Manor Subdivision in Prairie Township, Franklin County, Ohio, be and the same is hereby declared vacated, subject to the preservation of any existing right-of-way in, over, or under such Alley by any public utility.

Voting aye thereon: Robert T. Southwick, Henry A. Koontz and Glenn L. Myers.

\* \* \* \* \*

*Handwritten notes:*  
June 18, 1968  
N. 111


NOT DRAWN TO SCALE




0.

used  
.042

EVERGREEN TERRACE (50')

OWEN ST. (50')

WOODLAWN AVE. (50')

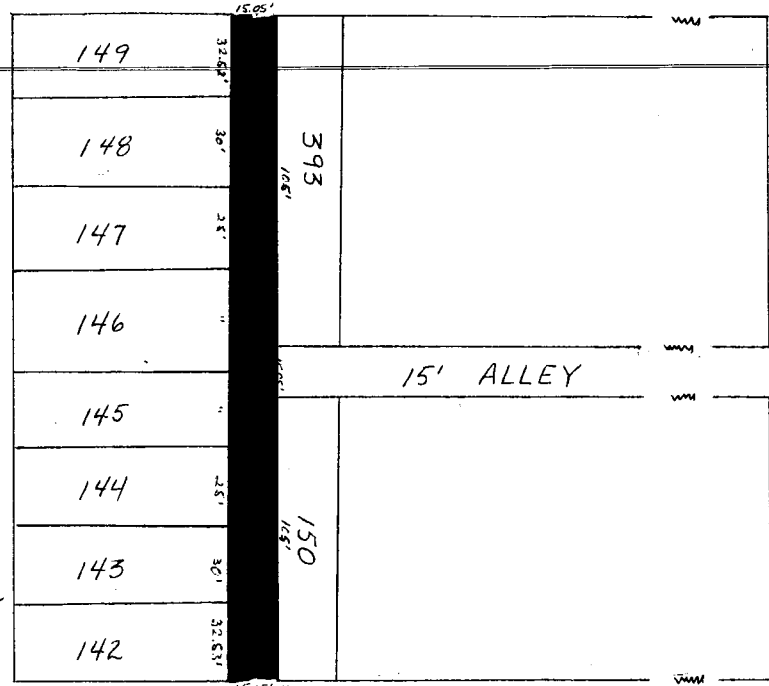

SULLIVANT AVE. (46.5')

FROM AUDITOR'S MAP BOOK "N"  
PAGE 116.

ROME MANOR SUBDIVISION

■ DENOTES PROPOSED VACATION

BY J.J.G.  
N-116

0.042

to  
35,

1

lan

HEER PTG. CO., COLS., O. CDB2506

NOT DRAWN TO SCALE




OWEN ST. (50')

EVERGREEN TERRACE (50')

WOODLAWN AVE. (50')

15' ALLEY

used .042

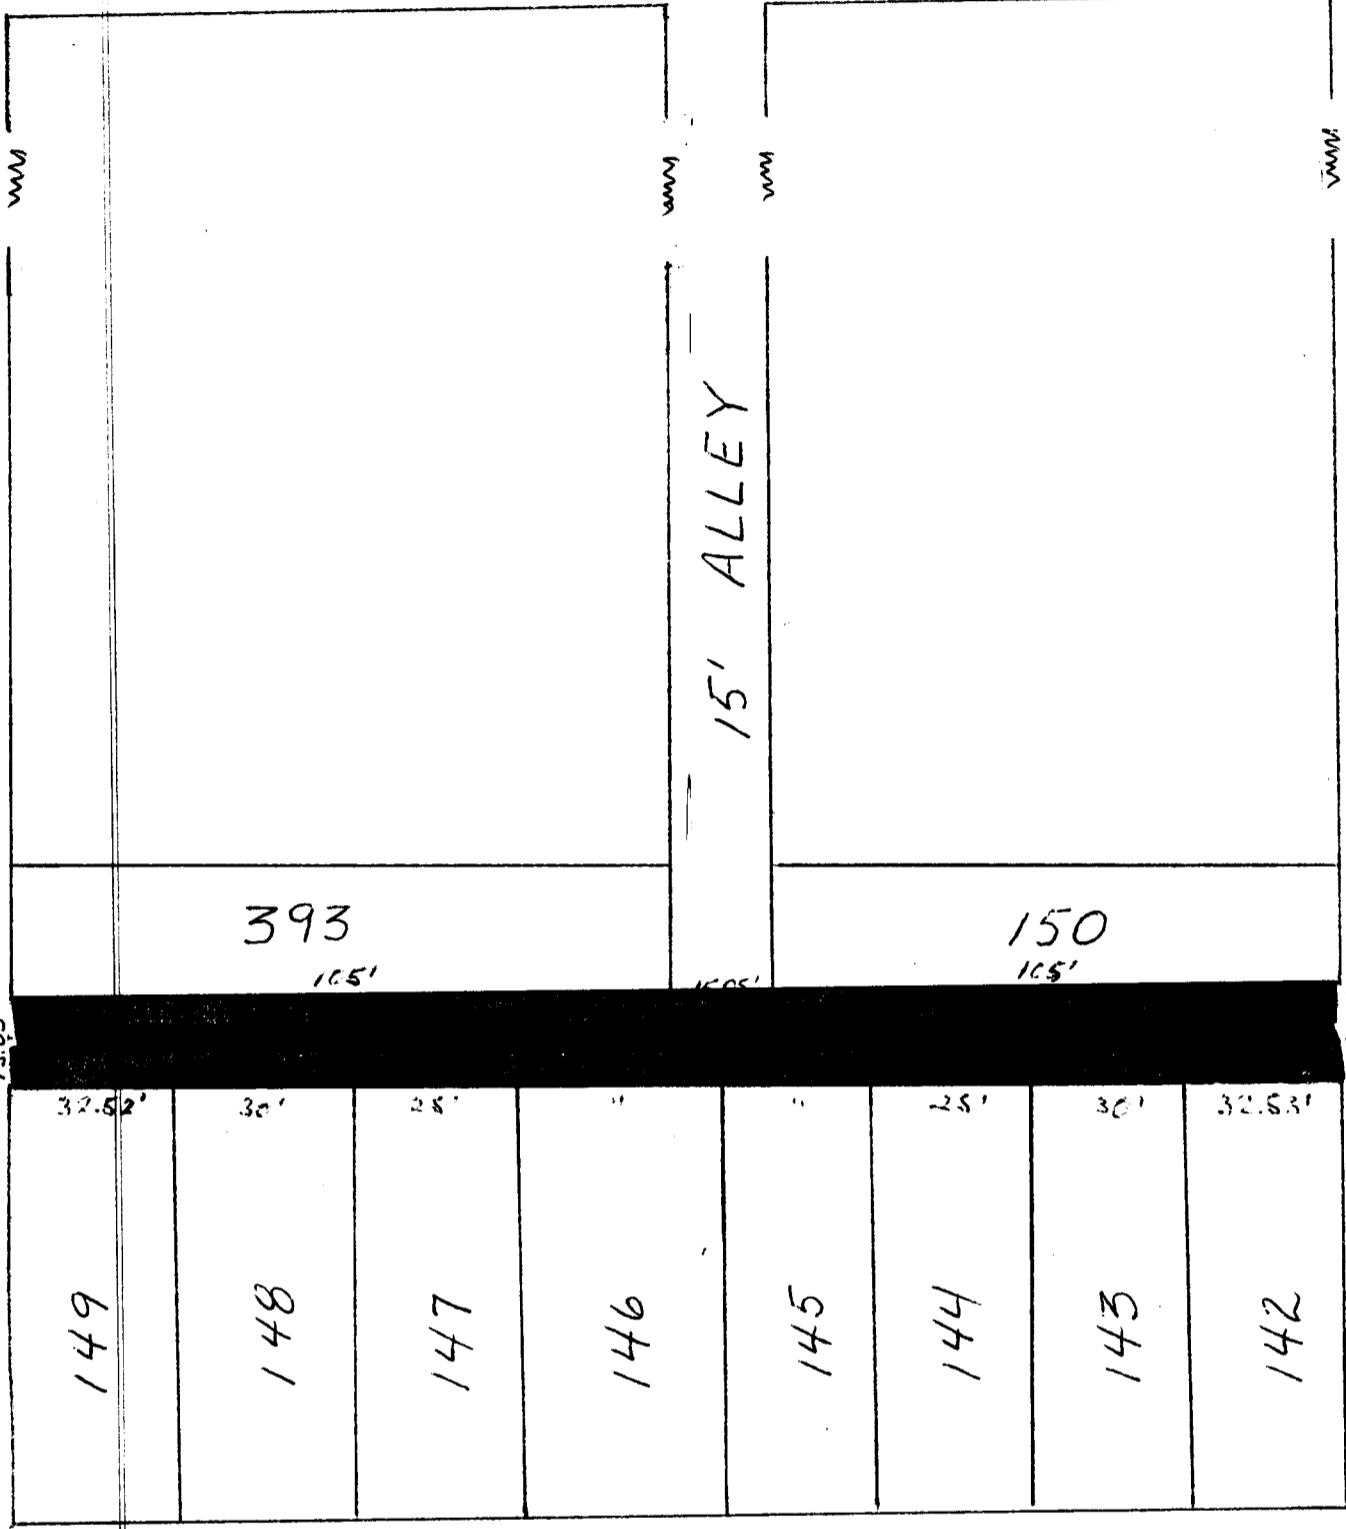

SULLIVANT AVE. (46.5')

FROM AUDITOR'S MAP BOOK "N"  
PAGE 116.

ROME MANOR SUBDIVISION



DENOTES PROPOSED VACATION

\*\*\*\*\*

Handwritten notes at the bottom right of the page.

to  
of,  
i  
lon