

HEER Ptg. Co., Columbus, O. C052506

PUBLIC ROAD PETITION

Rev. Code Sec. 5553.042  
Rev. Code Sec. 5553.10

Columbus, Ohio  
October 7, 1968

TO THE HONORABLE BOARD OF COUNTY COMMISSIONERS OF FRANKLIN COUNTY, OHIO:

The undersigned Petitioner respectfully represents that she is an abutting land owner of the alley hereinafter described. Petitioner further represents that said 15.00 foot alley has remained unimproved and unopened after its dedication as a part of Leonard Park Subdivision, Recorder's Plat Book 18, Page 18, a period greater than twenty-one (21) years. Said Plat was recorded on June 4, 1925.

The petitioner further represents that said alley has been abandoned and not used for a period of twenty-one(21) years. The following is the general route and termini of said alley: Said Alley is in a block bounded by Emmons Avenue on the North, Stelzer Road on the West, Missouri Avenue on the South and Mifflin Street on the East. More specifically, beginning at the southeast corner of Lot Number 29, Block G of said Subdivision; thence in a Westerly direction for 600.00 feet to a point at the Southwest corner of Lot Number 18, Block G; thence in a southerly direction for a distance of 15.00 feet to the northwest corner of Lot Number 46 Block "G" of said Subdivision; thence in an Easterly direction for a distance of 600.00 feet to the North corner of Lot Number 35, Block G of said Subdivision; thence in a Northerly direction for a distance of 15.00 feet to the point of beginning.

Therefore, the Petitioner respectfully makes application to you to institute and order proper proceedings in the premises, for Vacating such alley, subject to existing easements, the same not being a road on the state highway system.

Marie McCampbell /S/

STATE OF OHIO ss:  
FRANKLIN COUNTY,

Marie Campbell, being first duly sworn, deposes and says that she is the Plaintiff herein; that the facts stated and the allegations contained in the foregoing Petition are true as she verily believes.

Marie McCampbell /S/

Sworn to before me and subscribed in my presence this 9th day of October, 1968.

B. N. Murray /S/  
Notary Public, Franklin County, Ohio

SEAL

\* \* \* \* \*

Mifflin Township, Franklin County, Ohio, and that he has resided in Mifflin Township for a period of 27 years; that the alley bounded by Emmons Avenue on the north, Stelzer on the west and Missouri on the south, and Mifflin Boulevard on the east, although shown on the original plat of Leonard Park Addition has never been used, or paved since its platting and the same has been abandoned and defacto vacated by all abutting property owners.

Kenneth Baker /S/ 10-10-68

\* \* \* \* \*

October 14, 1968

Mr. Guy Elbin  
Franklin County Engineer  
970 Dublin Road  
Columbus, Ohio 43212

Re: Petition Submitted by Marie McCampbell, for Vacation of a 15.00 foot alley, located in Mifflin Township, Franklin County, Ohio.

Dear Mr. Elbin:

Please determine that the above mentioned alley, named in the attached petition has not been used for a period of twenty-one (21) years immediately preceding the filing of this petition and that formal proceedings for the vacation thereof, as provided in Section 5553.04 of the Revised Code, have not been taken.

Very truly yours,

Henry A. Koontz, Assisting Chairman  
BOARD OF COUNTY COMMISSIONERS  
FRANKLIN COUNTY, OHIO

Att:

Ji

\* \* \* \* \*

Plat for Alley vac. on Page 229



HEEN FTG. CO., COLS. O. CBS2506

Cont'd. - Vac. of a Fifteen (15) Ft. Alley in Mifflin Twp., Franklin County, Ohio

October 25, 1968

PETITION TO VACATE A FIFTEEN (15) FOOT ALLEY  
IN MIFFLIN TOWNSHIP, FRANKLIN COUNTY, OHIO - GRANTED.

In the matter of the petition filed October 11, 1968, by Marie McCampbell, for the vacation of a fifteen (15.00) foot Alley in Leonard Park Subdivision, Mifflin Township, Franklin County, Ohio, Mr. Koontz offered the following preamble and resolution and moved the adoption of the same, which was duly seconded by Mr. Shawan:

WHEREAS, on October 14, 1968, the Commissioners requested the Engineer of Franklin County, Ohio, to determine that the above mentioned Alley has not been used for a period in excess of twenty-one years immediately preceding the filing of this petition and that formal proceedings for the vacation thereof, as provided in Section 5553.04 of the Revised Code, have not been taken; and

WHEREAS, on October 24, 1968, Guy Elbin, County Engineer, did report thereon in writing that said Alley has not been used for a period in excess of twenty-one years and said Alley shall be vacated pursuant to Section 5553.042 of the Revised Code; therefore,

BE IT RESOLVED, by the Board of County Commissioners of Franklin County, Ohio, that the vacation of a fifteen (15.00) foot Alley in Leonard Park Subdivision in Mifflin Township, Franklin County, Ohio, be and the same is hereby declared vacated, subject to the preservation of any existing right-of-way in, over, or under such Alley by any public utility.



Voting Aye thereon: Robert T. Southwick, Henry A. Koontz and Jacob A. Shawan.

\* \* \* \* \*

# BLOCK "G" OF LEONARD PARK

P.B. 18 pg 18

## VACATION OF PORTION OF 15' ALLEY (shaded)

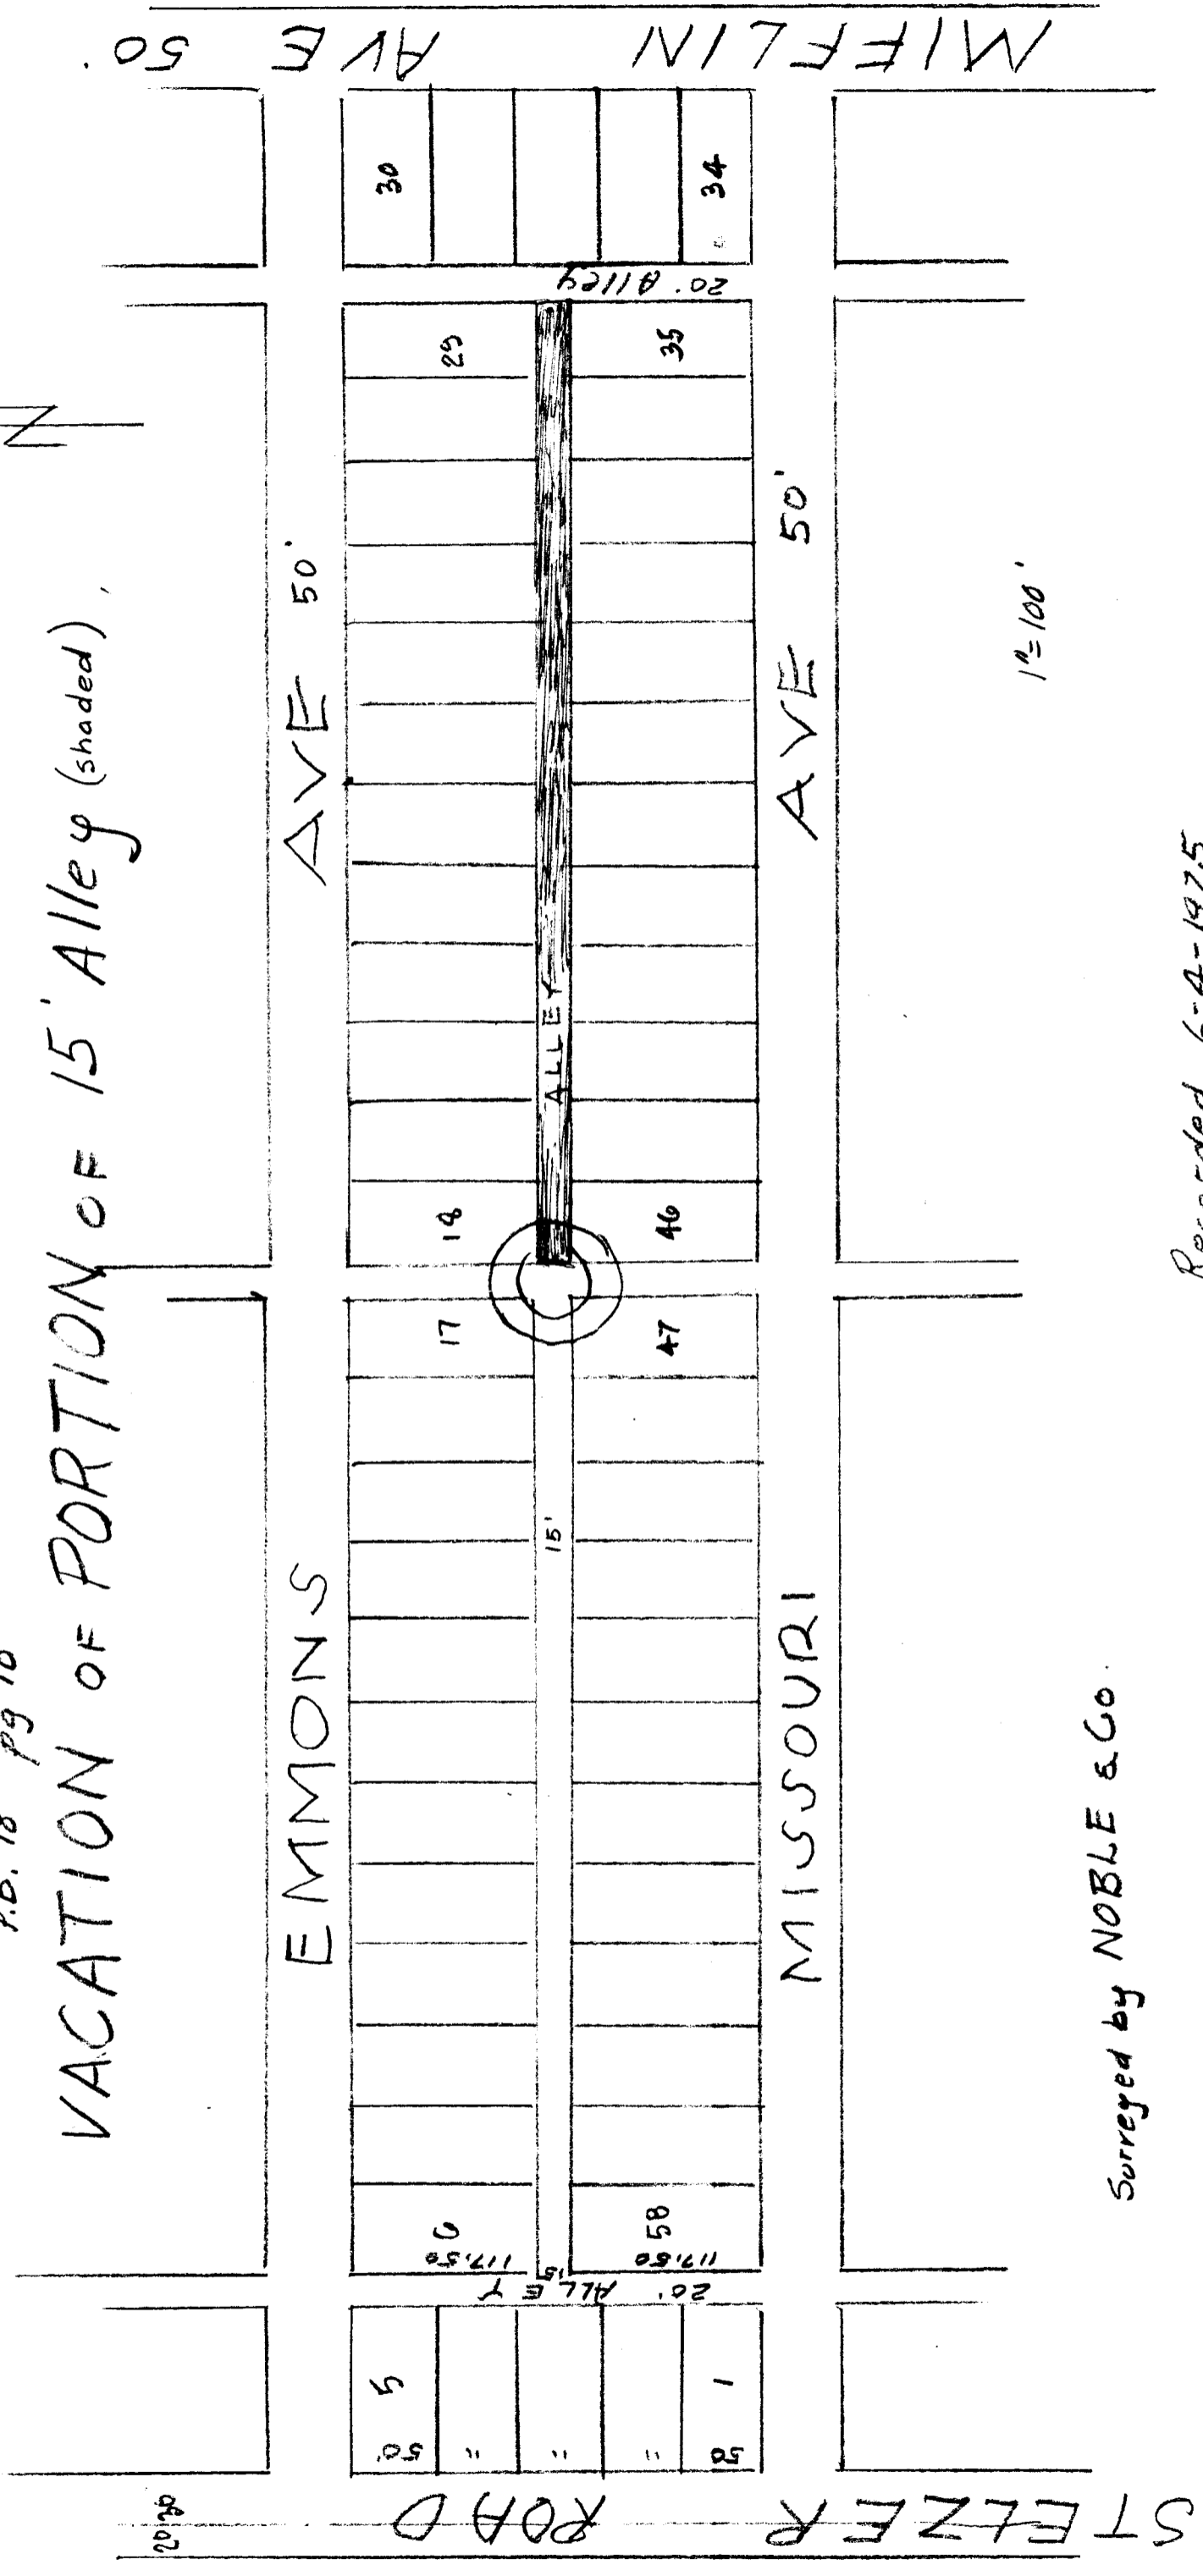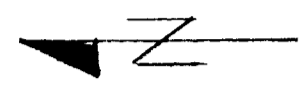

Surveyed by NOBLE & Co

Recorded 6-4-1925

10-23-68