

PETITION FOR VACATION OF PUBLIC ALLEY
(Revised Code, Sec. 5553.042)Columbus, Ohio
March 21, 1972

To the Honorable Board of Franklin County Commissioners:

The Petitioners, Gerald D. & Whilma D. Boyer are abutting land owners of a 20' alley hereinafter described, which alley has remained unimproved and unopened after its dedication as a part of Collin's Woodlawn Addition, of record in Plat Book, Volume 15, Page 36, Recorder's Office, Franklin County, Ohio. Said plat was recorded June 4, 1923.

The petitioners further represent that said alley has been abandoned and not used for a period greater than twenty-one (21) years.

The following is the general route of said alley:

Said alley is in a block bounded by West Broad Street on the North, Gladys Road on the East, Palmetto Street on the South and Inah Avenue on the West. More specifically, beginning at the southwest corner of lot #1 of said subdivision; thence in a southerly direction 20 feet to the northeast corner of lot #43; thence in a westerly direction 265 feet to the northwest corner of lot #11; thence in a northerly direction 20 feet to the southwest corner of lot #1, said point being the point of beginning.

The Petitioners are owners of lot #11 which is adjacent to the above described alley.

We, the undersigned petitioners respectfully ask your Honorable Board to institute and order proper proceedings for vacating the above described alley in accordance with Section 5553.042 of the Revised Code.

Respectfully submitted

Gerald D. Boyer Sr.
32 Inah Ave. - Col., Ohio
Present address - 780 Sagebrook Rd.
Columbis, S.C. 29204

Whilma D. Boyer
32 Inah Ave.
Present Address - 7808 Sagebrook Rd.
Columbia, S.C. 29204

John R. Richards
412 Riverside Drive - Galloway, Ohio 43119

Rachel Richards
310 Riverside Dr. - Galloway, Ohio 43119

* * * * *

March 22, 1972

The Honorable Cletus E. McPherson
Franklin County Engineer
970 Dublin Road
Columbus, Ohio 43215

Re: Petition by Gerald D. & Whilma D. Boyer for the vacation of a
20' alley located in *Collin's* Woodlawn Addition".

Dear Mr. McPherson:



Please determine that the above mentioned alley, named in the attached petition has not been used for a period of twenty-one (21) years, immediately preceding the filing of the petition and that formal proceedings for the vacation thereof, as provided in Section 5553.04 of the Revised Code, has not been taken.

Very truly yours,

Michael J. Dorrian, President
Board of County Commissioners
Franklin County, Ohio.


* * * * *

PRAIRIE TWP. N-

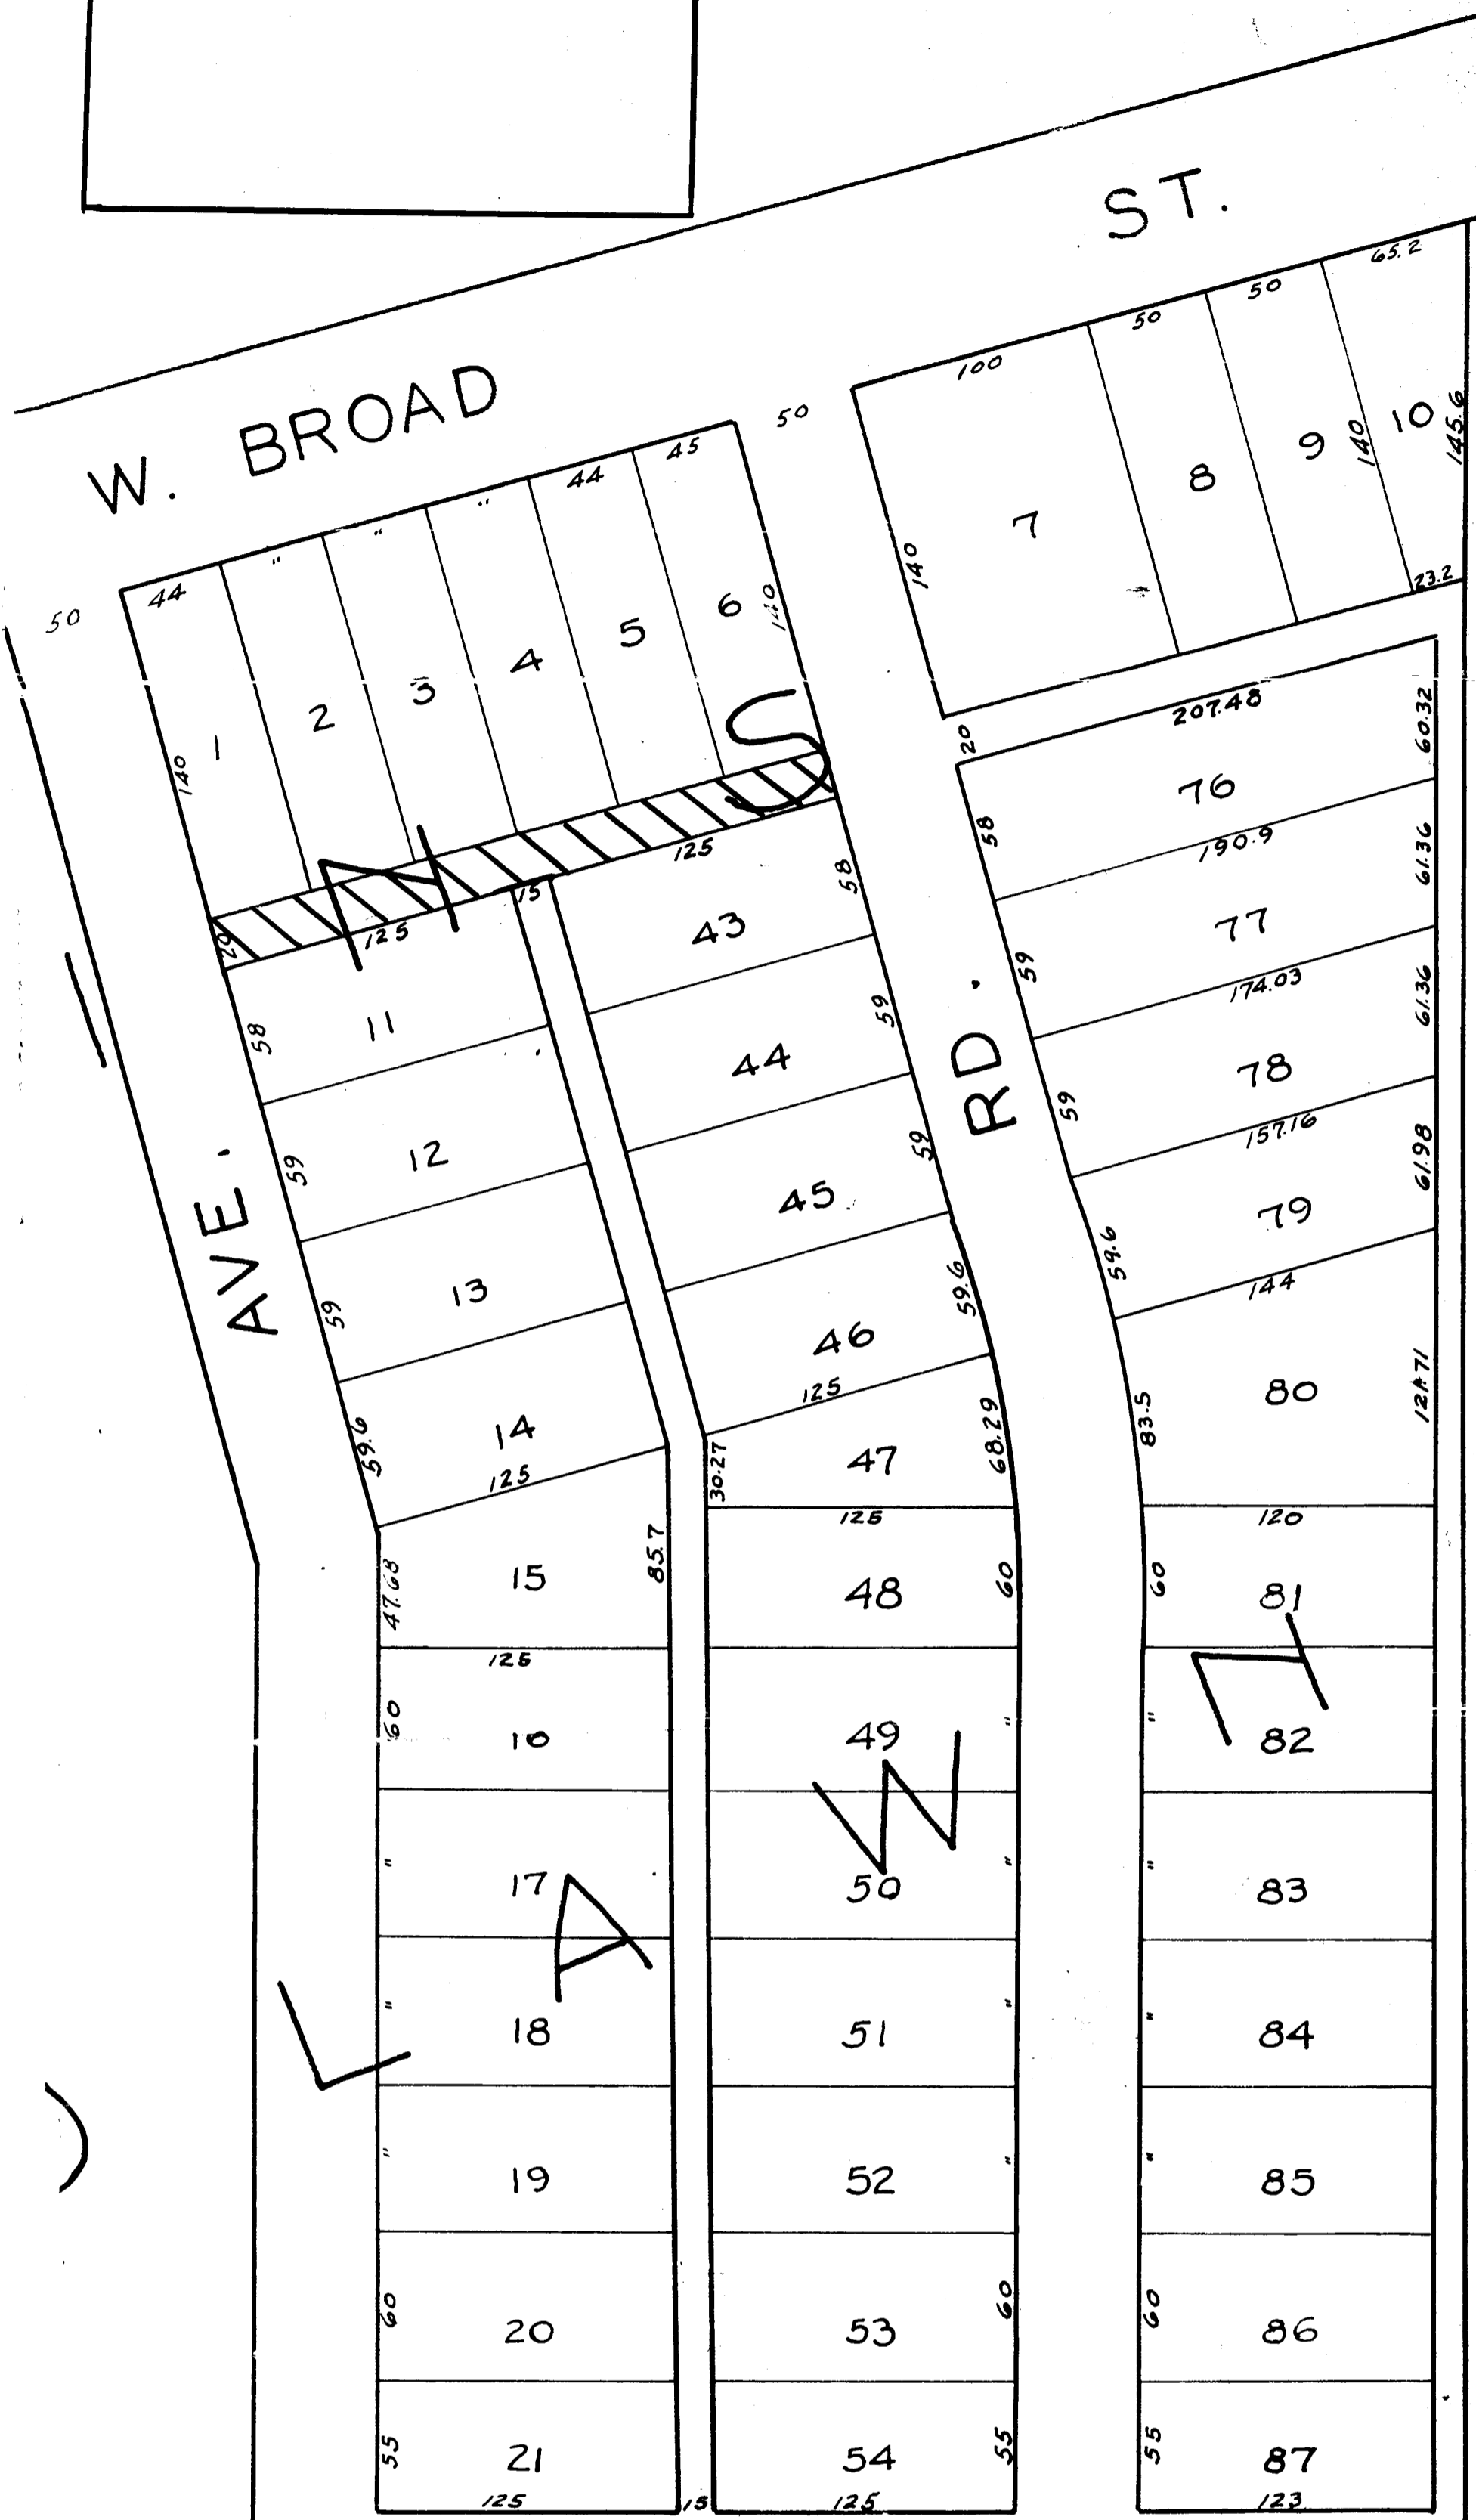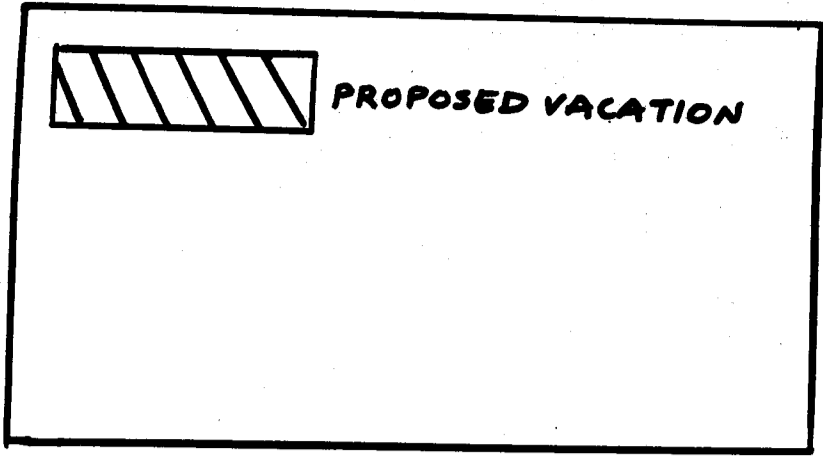

DUBS PALMETTO ST.

CO. ENGR. 10-24-63

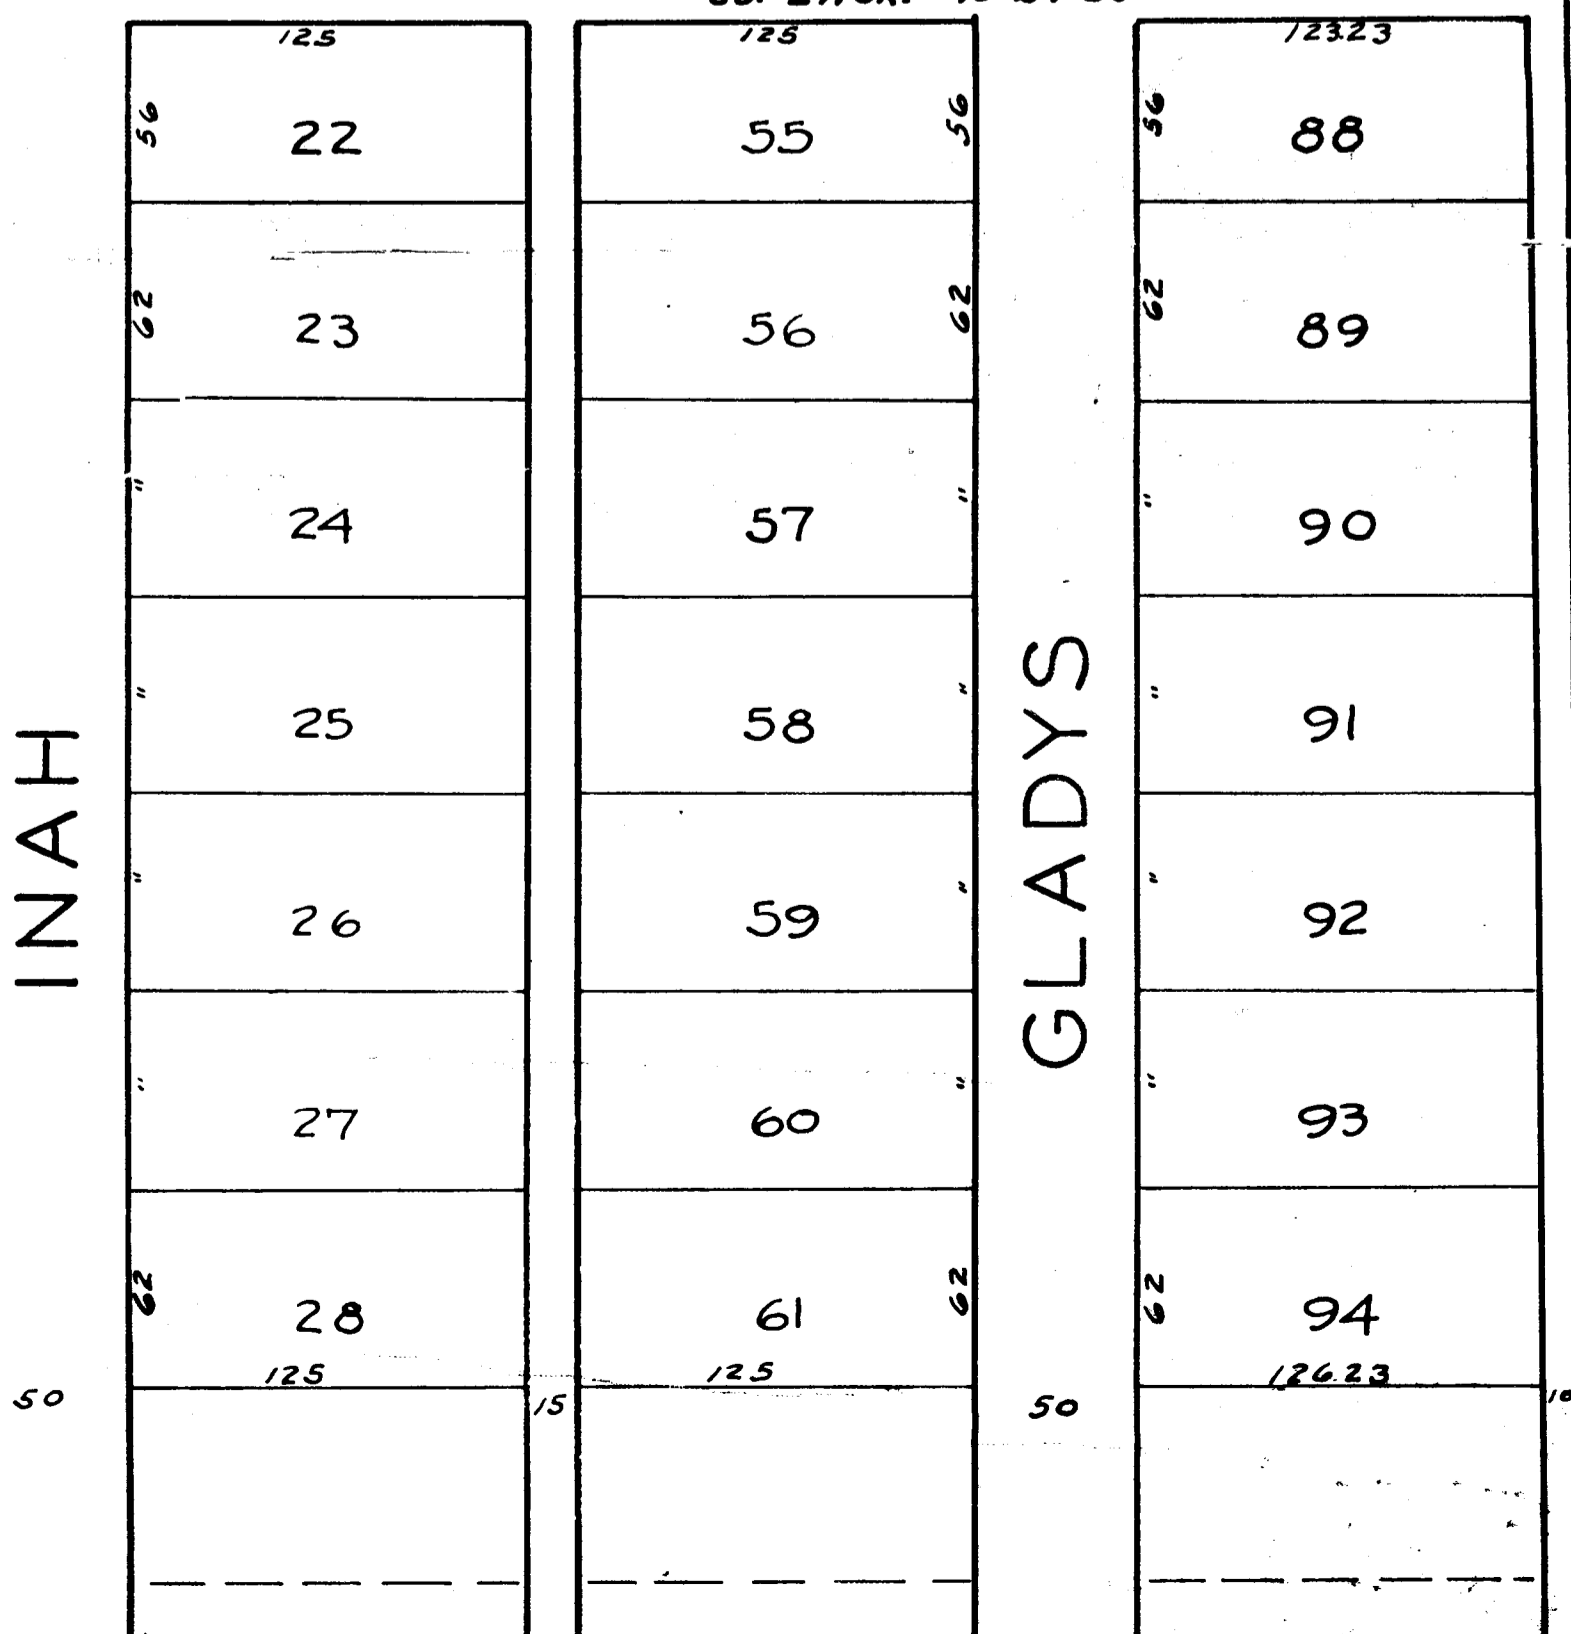

Vec. 20' Alley -
Crillins "tallies Woodlawn Allen"
Prin. Imp.

S. R. # 21 - 160 - 161

Cont'd. - Vac. of a Twenty (20) Ft. Alley in "Collin'S Woodlawn Addition",
Prairie Twp., Franklin County, Ohio.

April 3, 1972

Board of County Commissioners
Franklin County Court House
Columbus, Ohio 43215

Re: Petition by Gerald D. and Whilma D. Boyer for the vacation of a
20' Alley located in ~~Collin's Woodlawn Addition~~,
Collin's

Gentlemen:-

Pursuant to your letter of March 22, 1972, it has been determined that said Alley has not been used for a
period in excess of twenty-one years and said Alley shall be vacated pursuant to Section 5553.042 of
the Revised Code.

Respectfully submitted,

Cletus E. McPherson, P.E.
Franklin County Engineer

By Robert F. Koerner, P.E. /s/
Chief Deputy Engineer

* * * * *

April 3, 1972

PETITION TO VACATE A TWENTY (20) FOOT ALLEY LOCATED IN
"COLLIN'S WOODLAWN ADDN.", PRAIRIE TWP., FRANKLIN CO., OHIO
Collin's

In the matter of the petition filed by Gerald D. and Whilma D. Boyer for the vacation of a 20 Foot
Alley located in "Collin's Woodlawn Addition", Prairie Township, Franklin County, Ohio, Mr. Cooper offered
the following preamble and resolution and moved the adoption of the same, which was duly seconded by Mr. Dorrian.

WHEREAS, on March 22, 1972, the County Commissioners requested the Engineer of Franklin County, Ohio,
to determine that the above mentioned Alley has not been used for a period in excess of twenty-one (21) years
immediately preceding the filing of this petition and that formal proceedings for the vacation thereon,
as provided in Section 5553.04 of this Revised Code has not been taken; and

WHEREAS, on April 3, 1972, the County Engineer Cletus E. McPherson, did report thereon in writing that
said alley has not been used for a period in excess of twenty-one (21) years and said Alley (as described in
the petition and plat) shall be vacated pursuant to Section 5553.042 of the Revised Code; now therefore,

BE IT RESOLVED, by the Board of County Commissioners ^{*Collin's*} of Franklin County, Ohio, that the vacation of said
Alley (as described in the petition and plat), located in ~~"Collin's Woodlawn Addition"~~, Prairie Township, Franklin
County, Ohio, be, and the same is hereby declared vacated, subject to the preservation of any existing right-
of-way in, over or under said Alley by any public utility.

Voting Aye thereon: Michael J. Dorrian, Harold M. Cooper and Robert T. Southwick. *MAP PAGE 10*

* * * * *