



FRONT ST

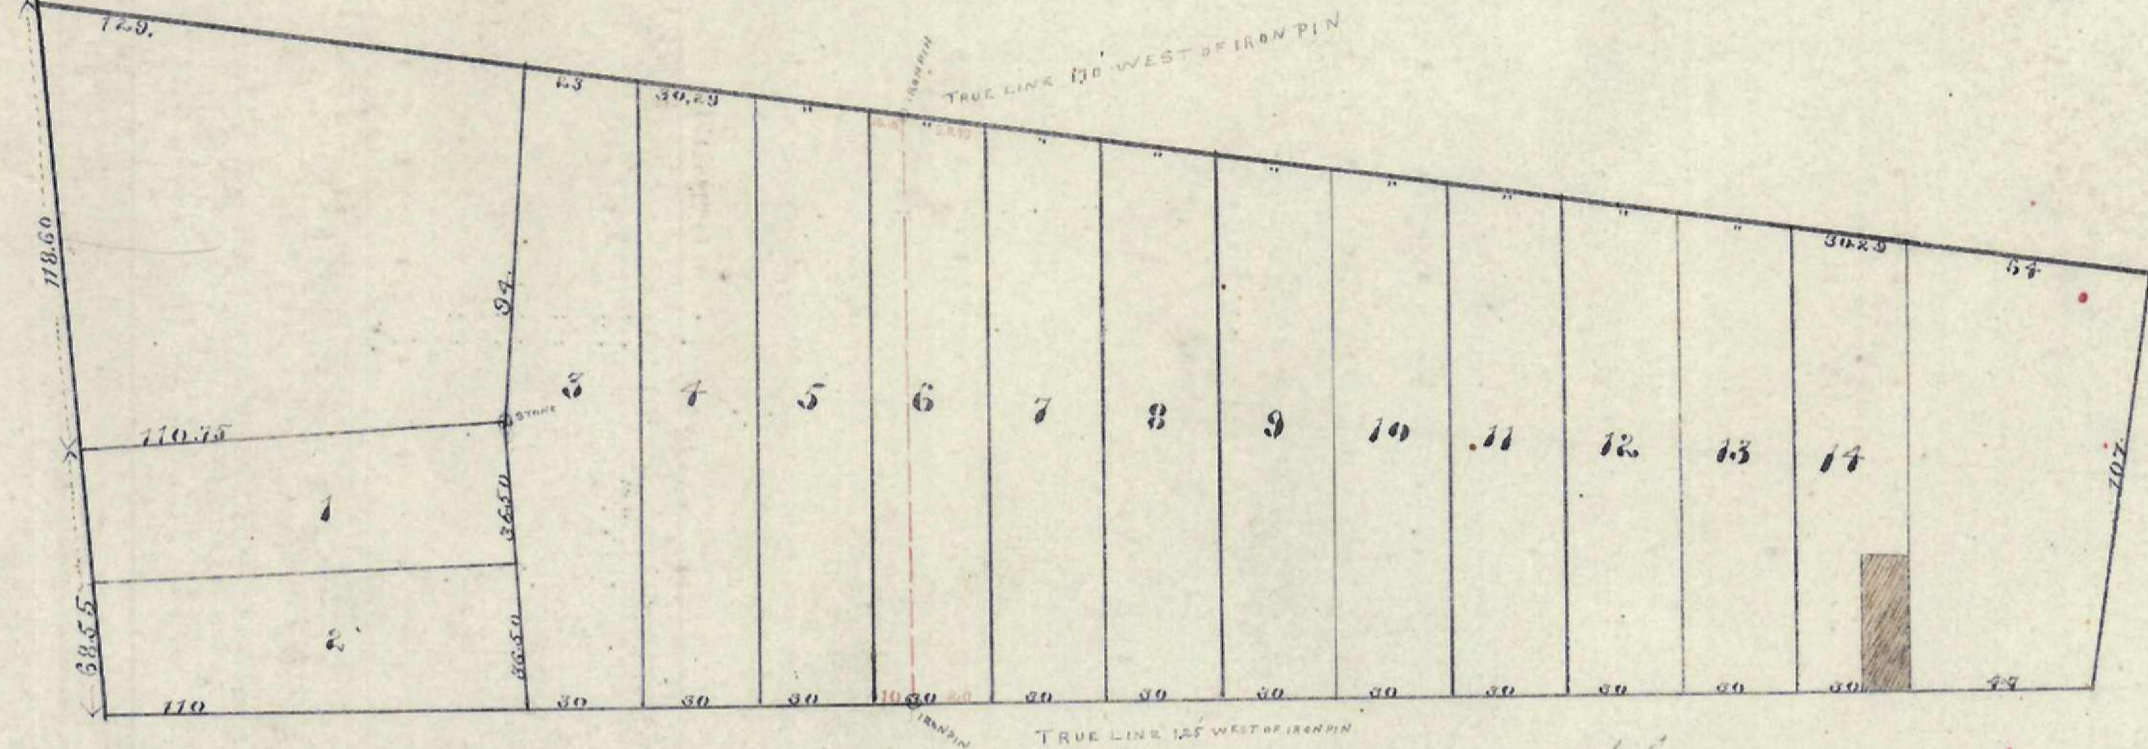


LIBERTY ST

PLAT  
OF  
ARMSTRONG  
ADD. INDEX

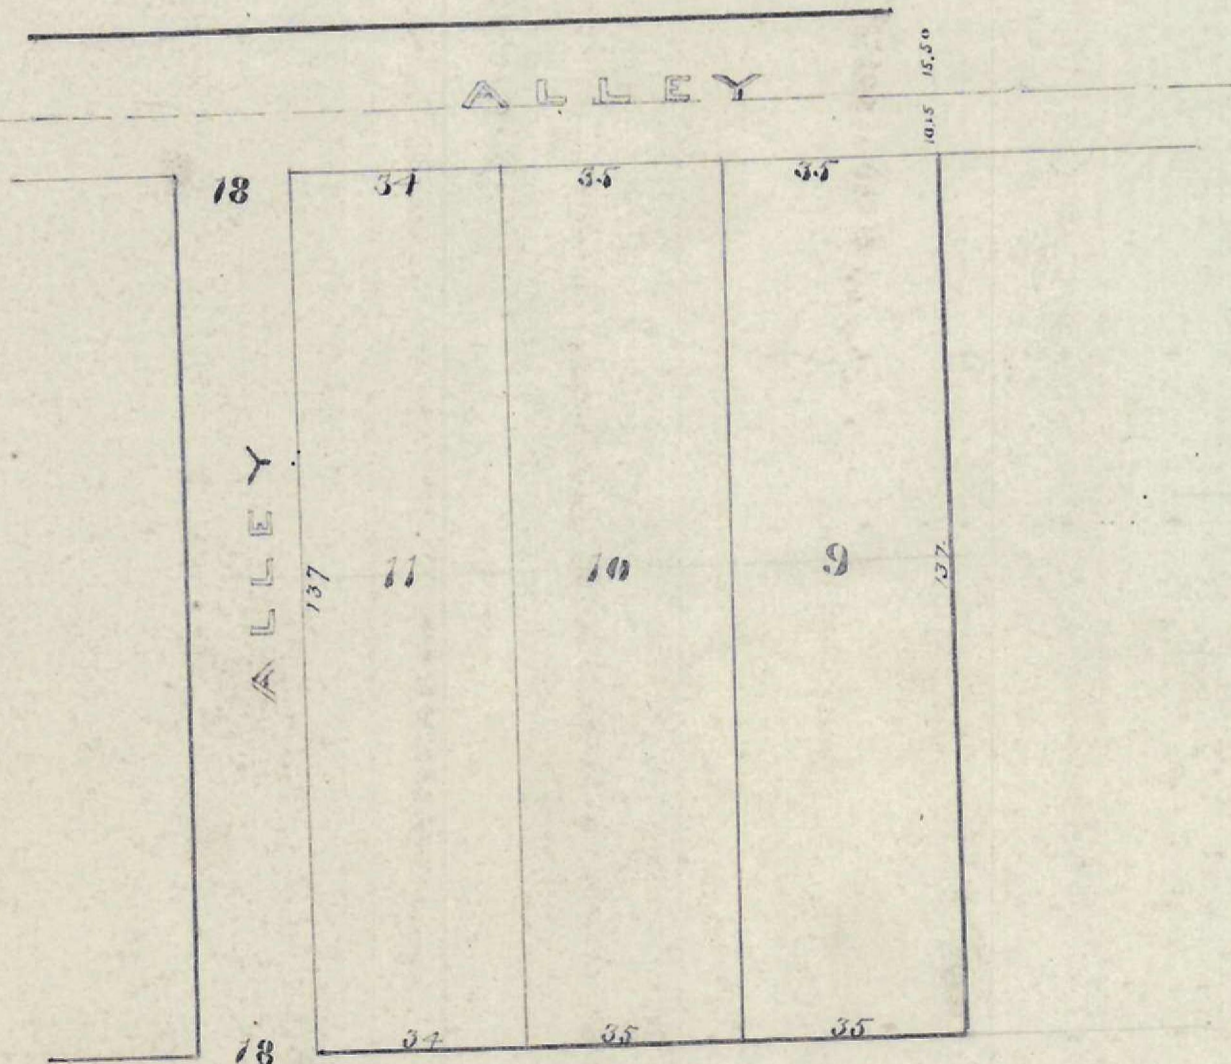

STARR AVE 60

PLAT  
OF THE  
SUB'D  
OF  
LOTS 9, 10 & 11  
OF  
LABOR'S SUB  
OF  
LOT 16 STARR'S SUB INDEX  
PB-3 P22

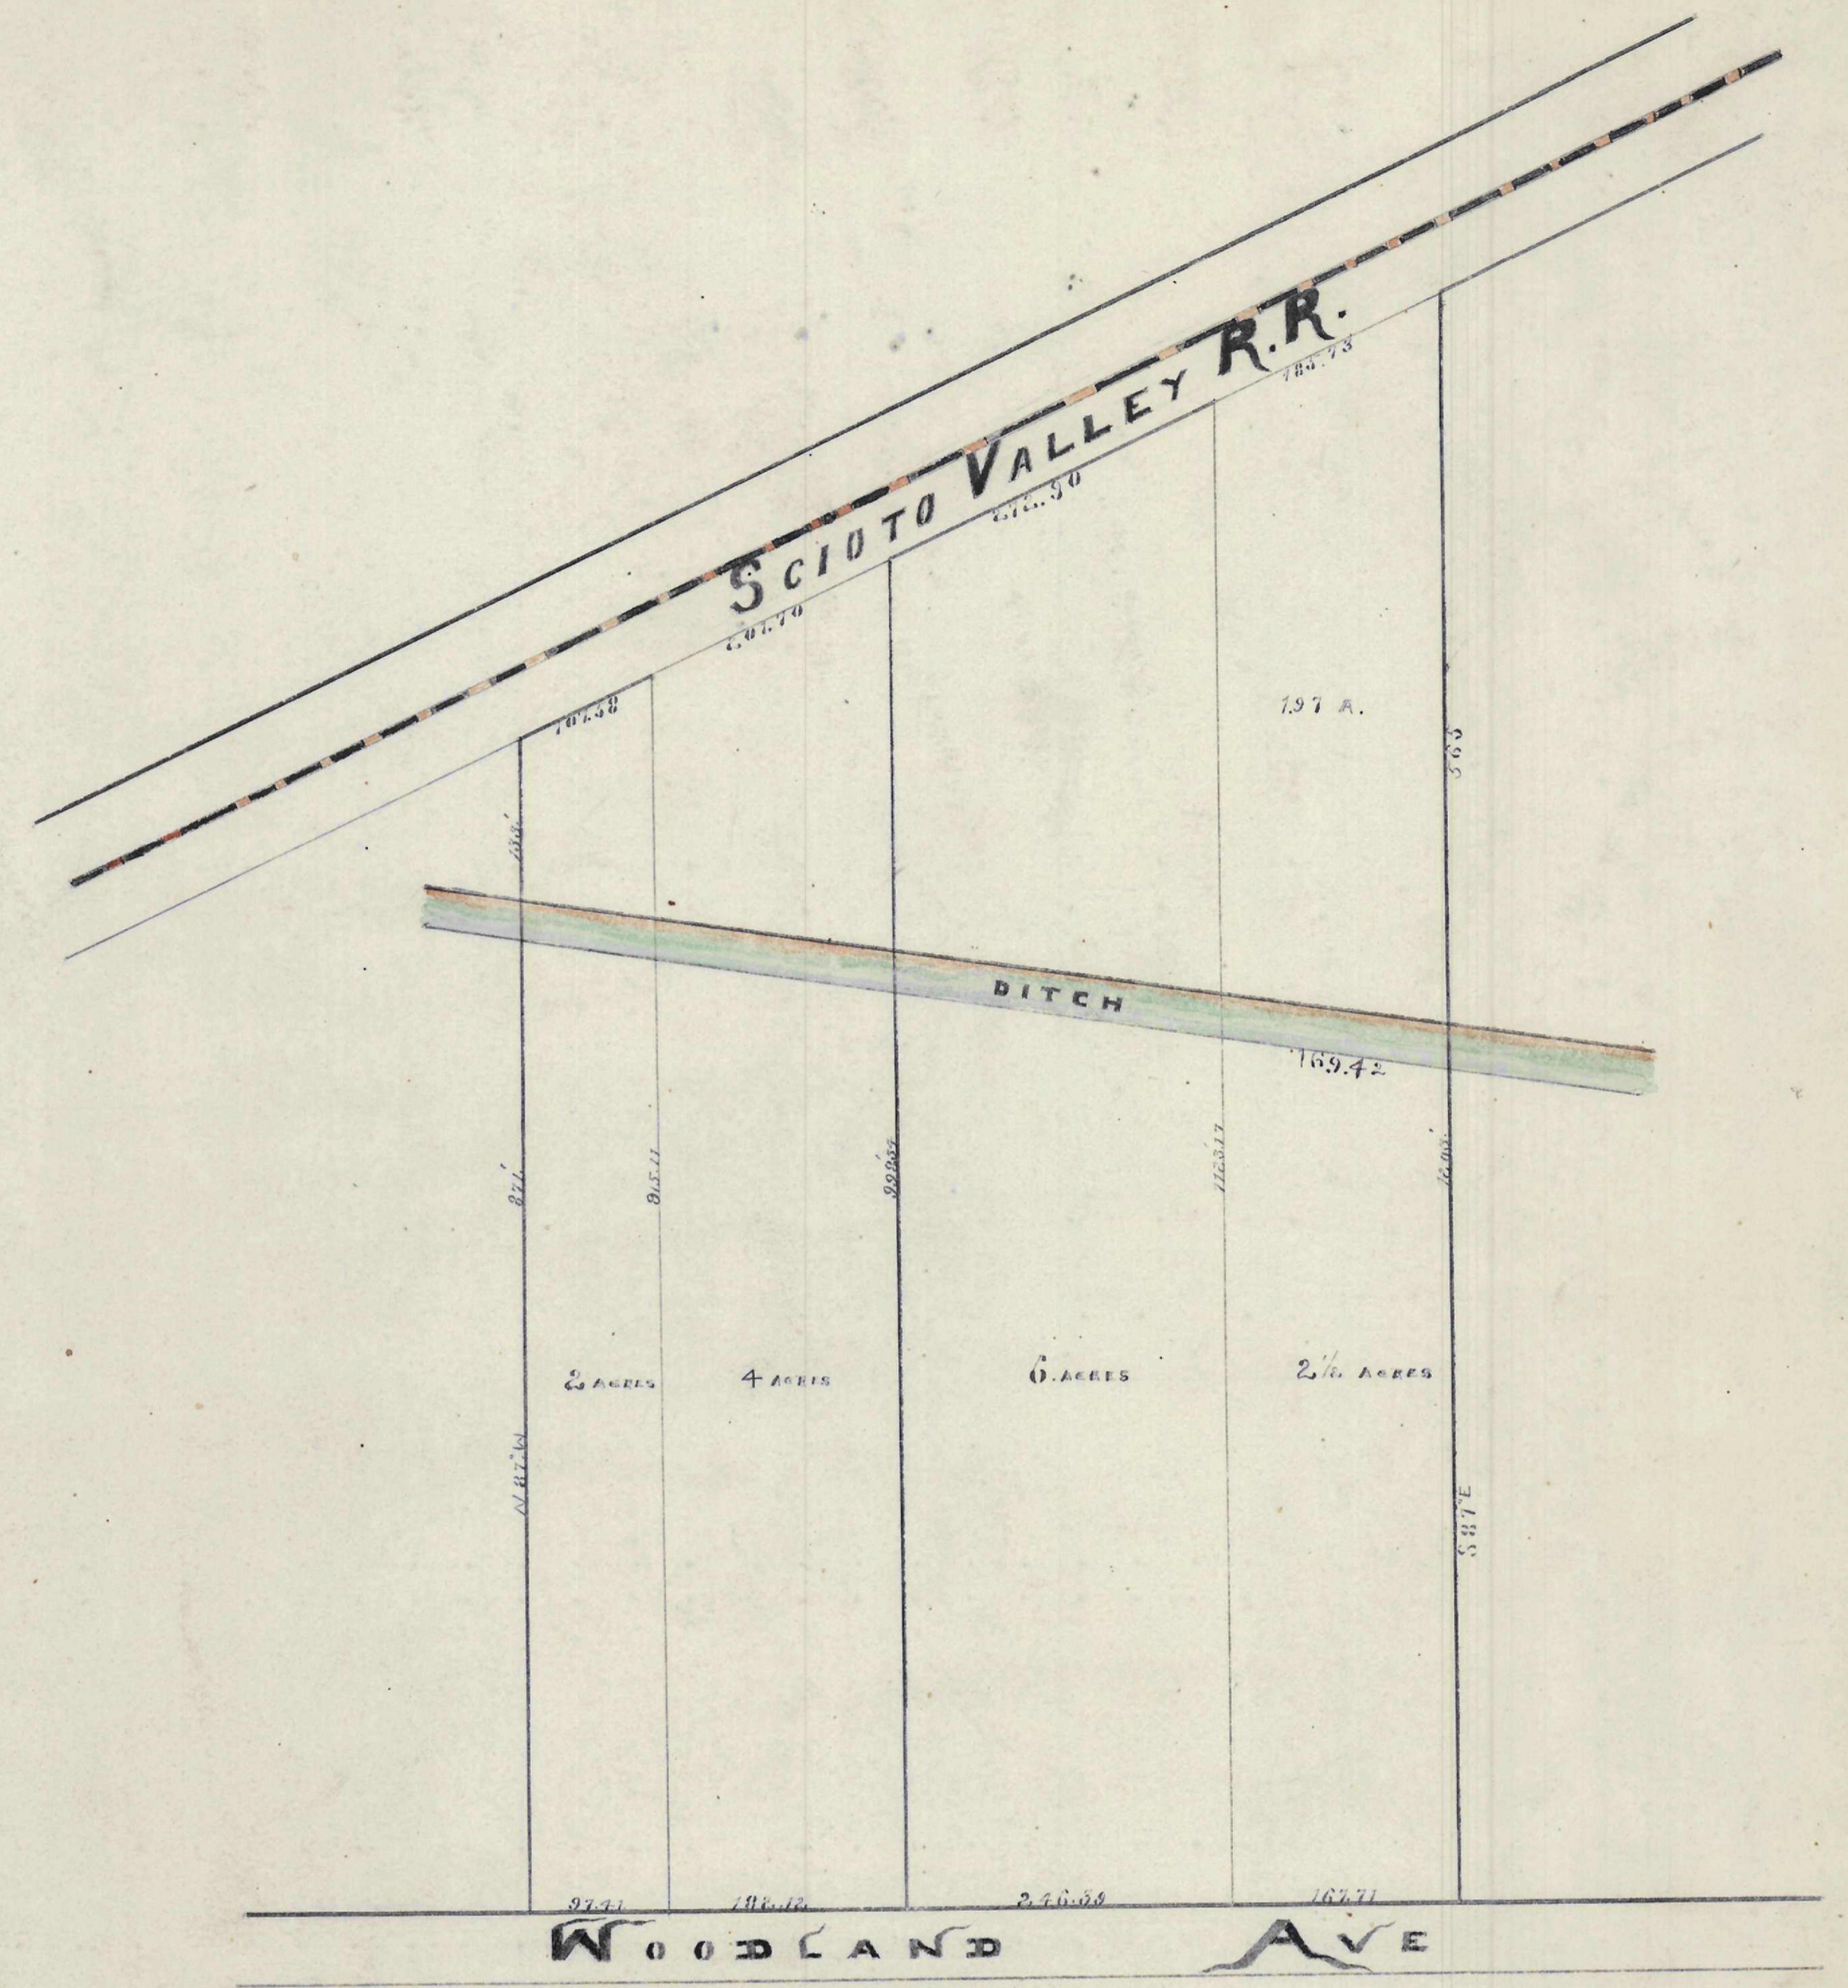

WOODLAND AVE

PLAT  
OF  
NELSON'S SUB.  
INDEX