


Wm Miller 120 1/4 acres being
a part of Survey No 424 Franklin Tp.
Wm District Franklin Co, Ohio.
J. Kinnear F. Co. S.
INDEX

PLAT
PART OF
SURVEY 2668

FRANKLIN TP
J. Kinnear F. Co. S.

See Complete Record 61-80

J^{no} W. Jenkins Farm
Franklin Tp.
J. Kinnear F. Co. S.
INDEX

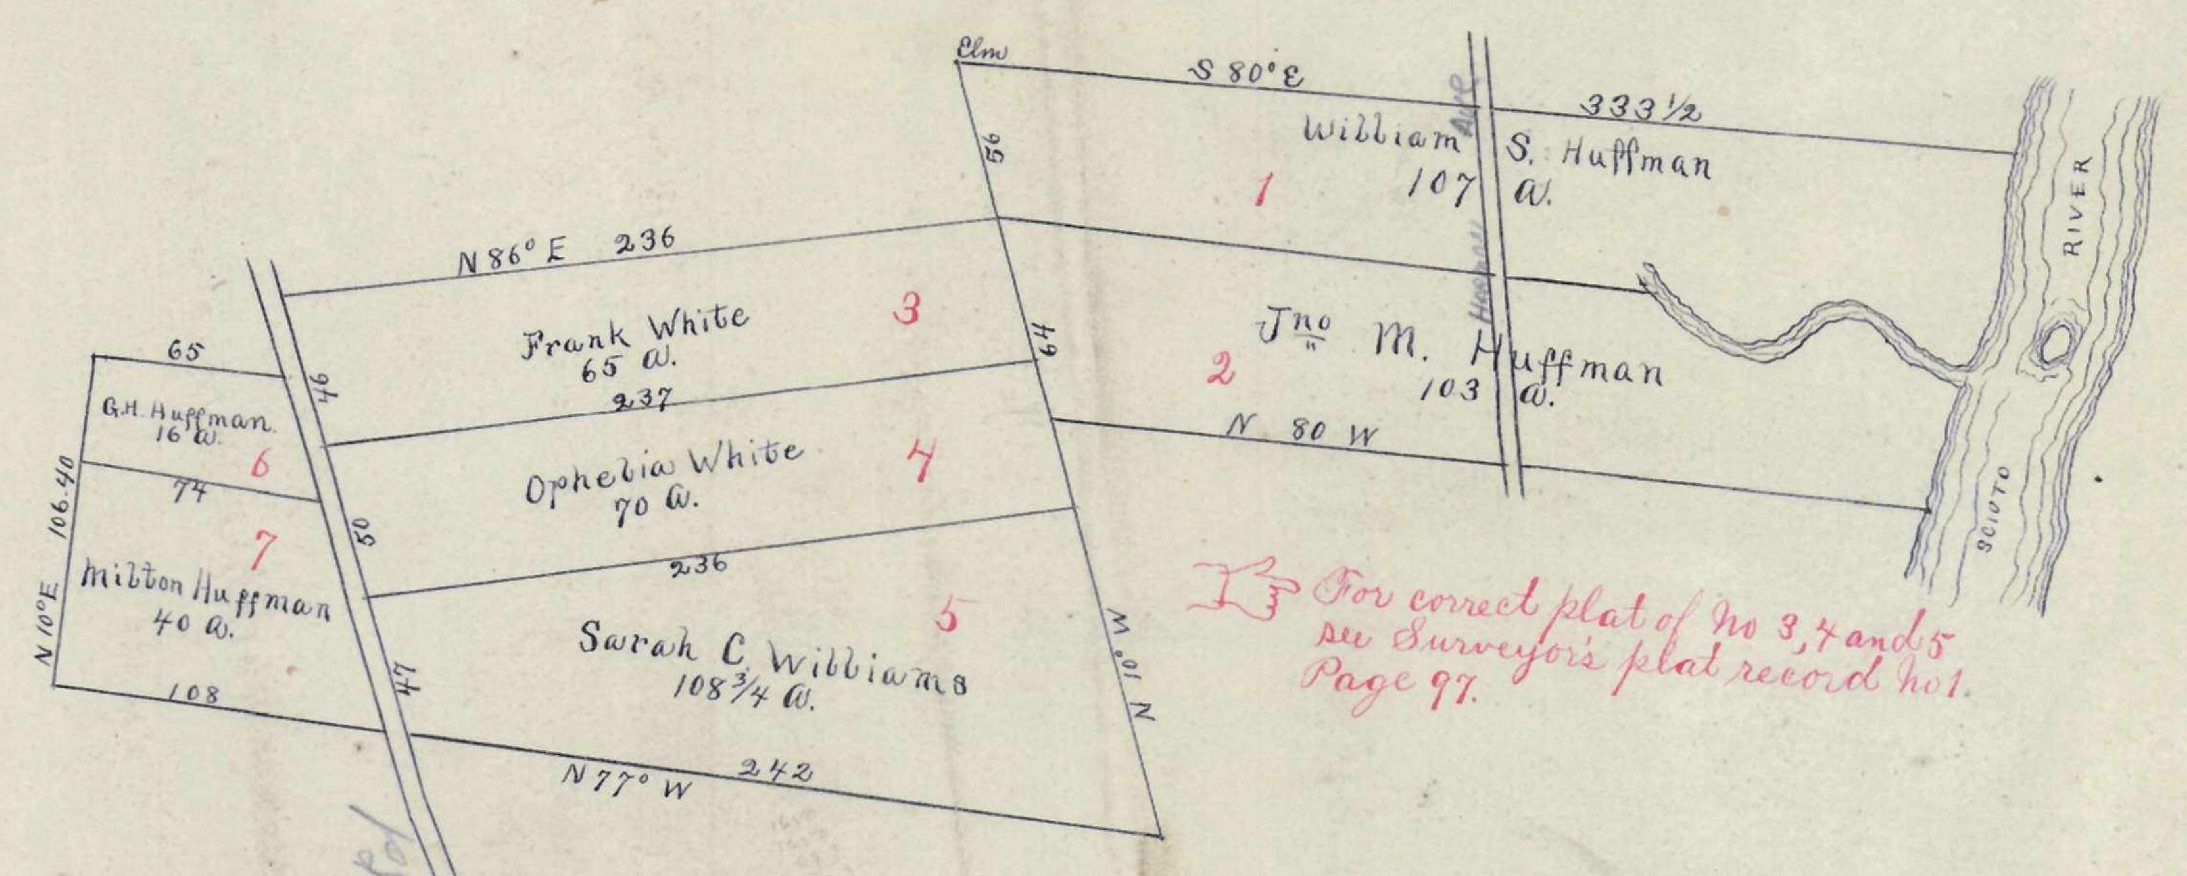

For correct plat of No 3, 4 and 5
see Surveyors plat record vol.
Page 97.

Jacob Huffmans Heirs' Subdivisions
of part of Survey No. 420 and 417
Franklin Tp. J. Kinnear F. Co. S.
INDEX

