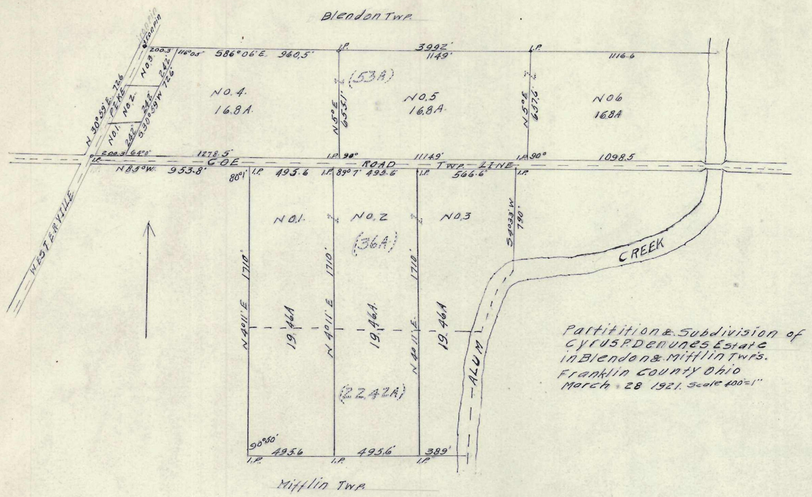

Partition & Subdivision of Cyrus P. Devin's Estate in Blendon & Mifflin Twps. Franklin County Ohio March 28 1921. Scale 100'=1"

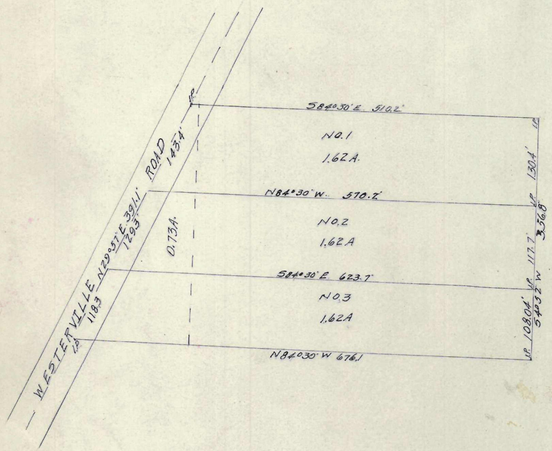

Partition & Subdivision of Cyrus P. Devin's Estate in Mifflin Twp. Franklin Co. O. Scale 100'=1"

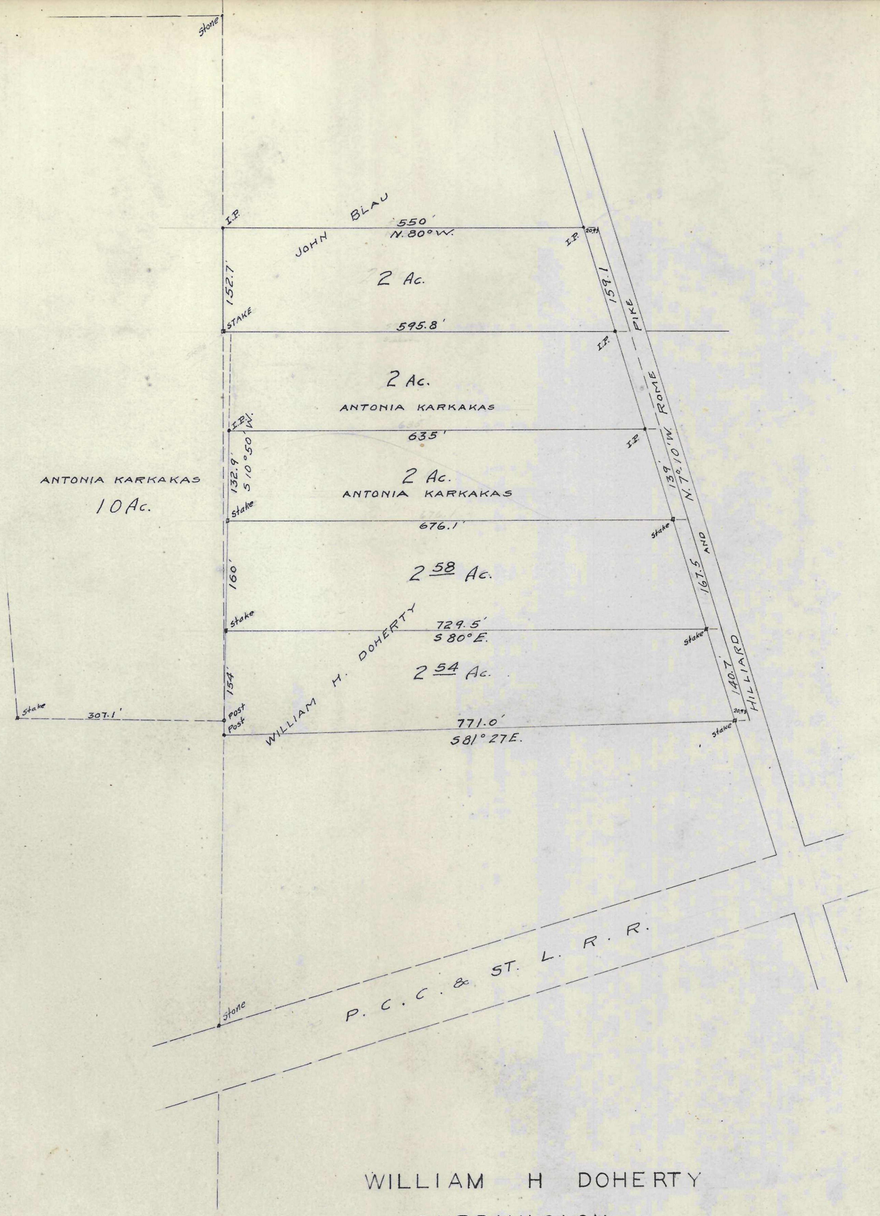

WILLIAM H DOHERTY
SUBDIVISION