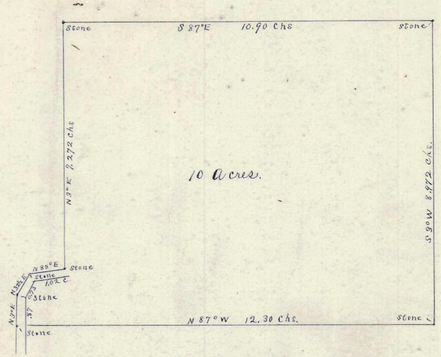

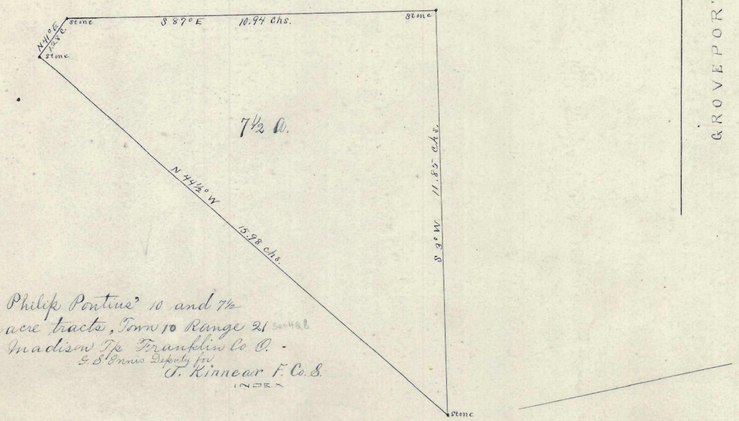

Philip Pontius' 10 and 7½ acre tracts, Town 10 Range 21 Madison Tp Franklin Co O. -
E. S. Innis Deputy for
J. Kinnear F. Co. S.
INDEX

L. D. DAVIES'

SUBDIVISION

OF

D. SPADE'S HEIRS' 8 ACRES

IN MARION TP FRANKLIN Co. O.

Jan. 4. 1888

J. Kinnear F. Co. S.
INDEX

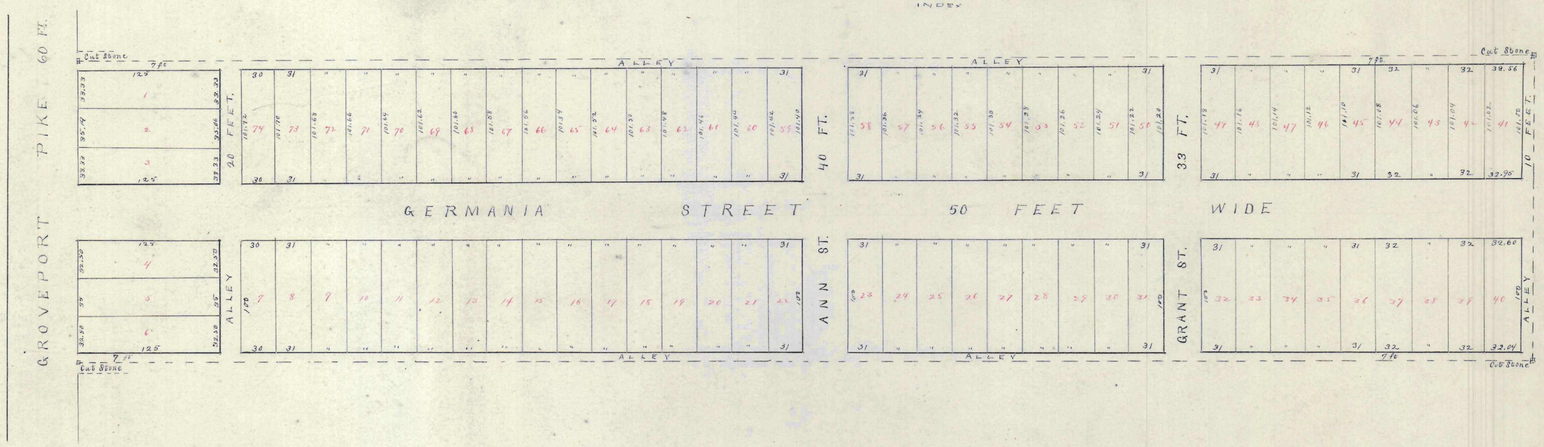

J. W. AND L. A. DURRETT'S

SUBDIVISION

Of lot no 7 of their former subdivision of a part of Half Sec 43, Town 5 Range 22 Refugee lands Marion Tp Franklin Co O.

J. Kinnear F. Co. S.
INDEX

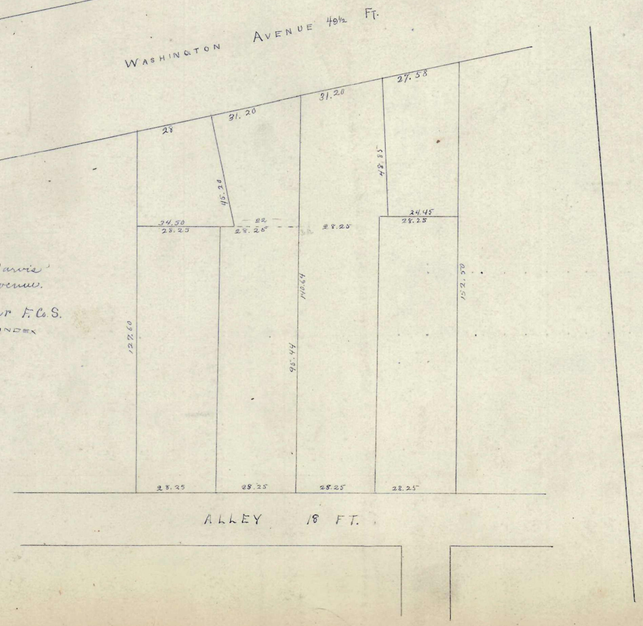
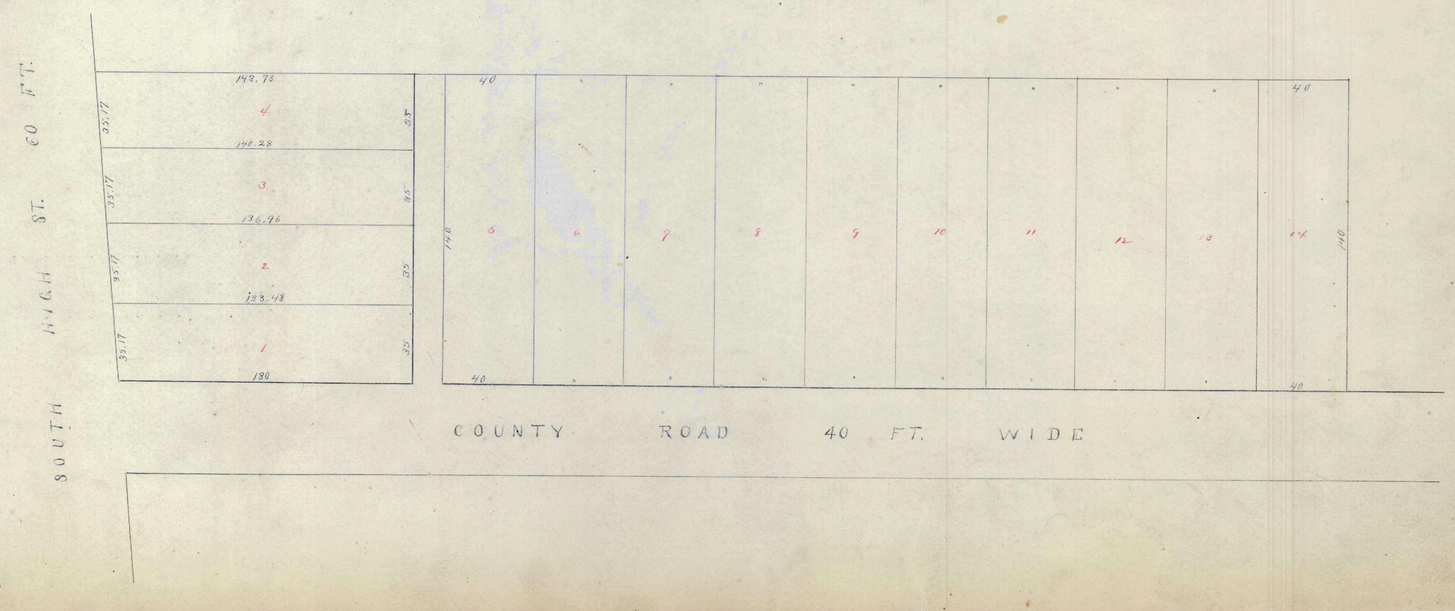
Emrich Subdivision
Of lot 23 & 24 and a part of lot 22 in Jarvis' addition on north Washington Avenue.
as I for
Oct. 8. 1887.
J. Kinnear F. Co. S.
INDEX