



M. KINNEAR'S
 SUBDIVISION
 OF
 LOTS 3, 17 AND 20
 North Columbus
 Feb 23 1885 INDEX J. Kinnear F. Co. S.

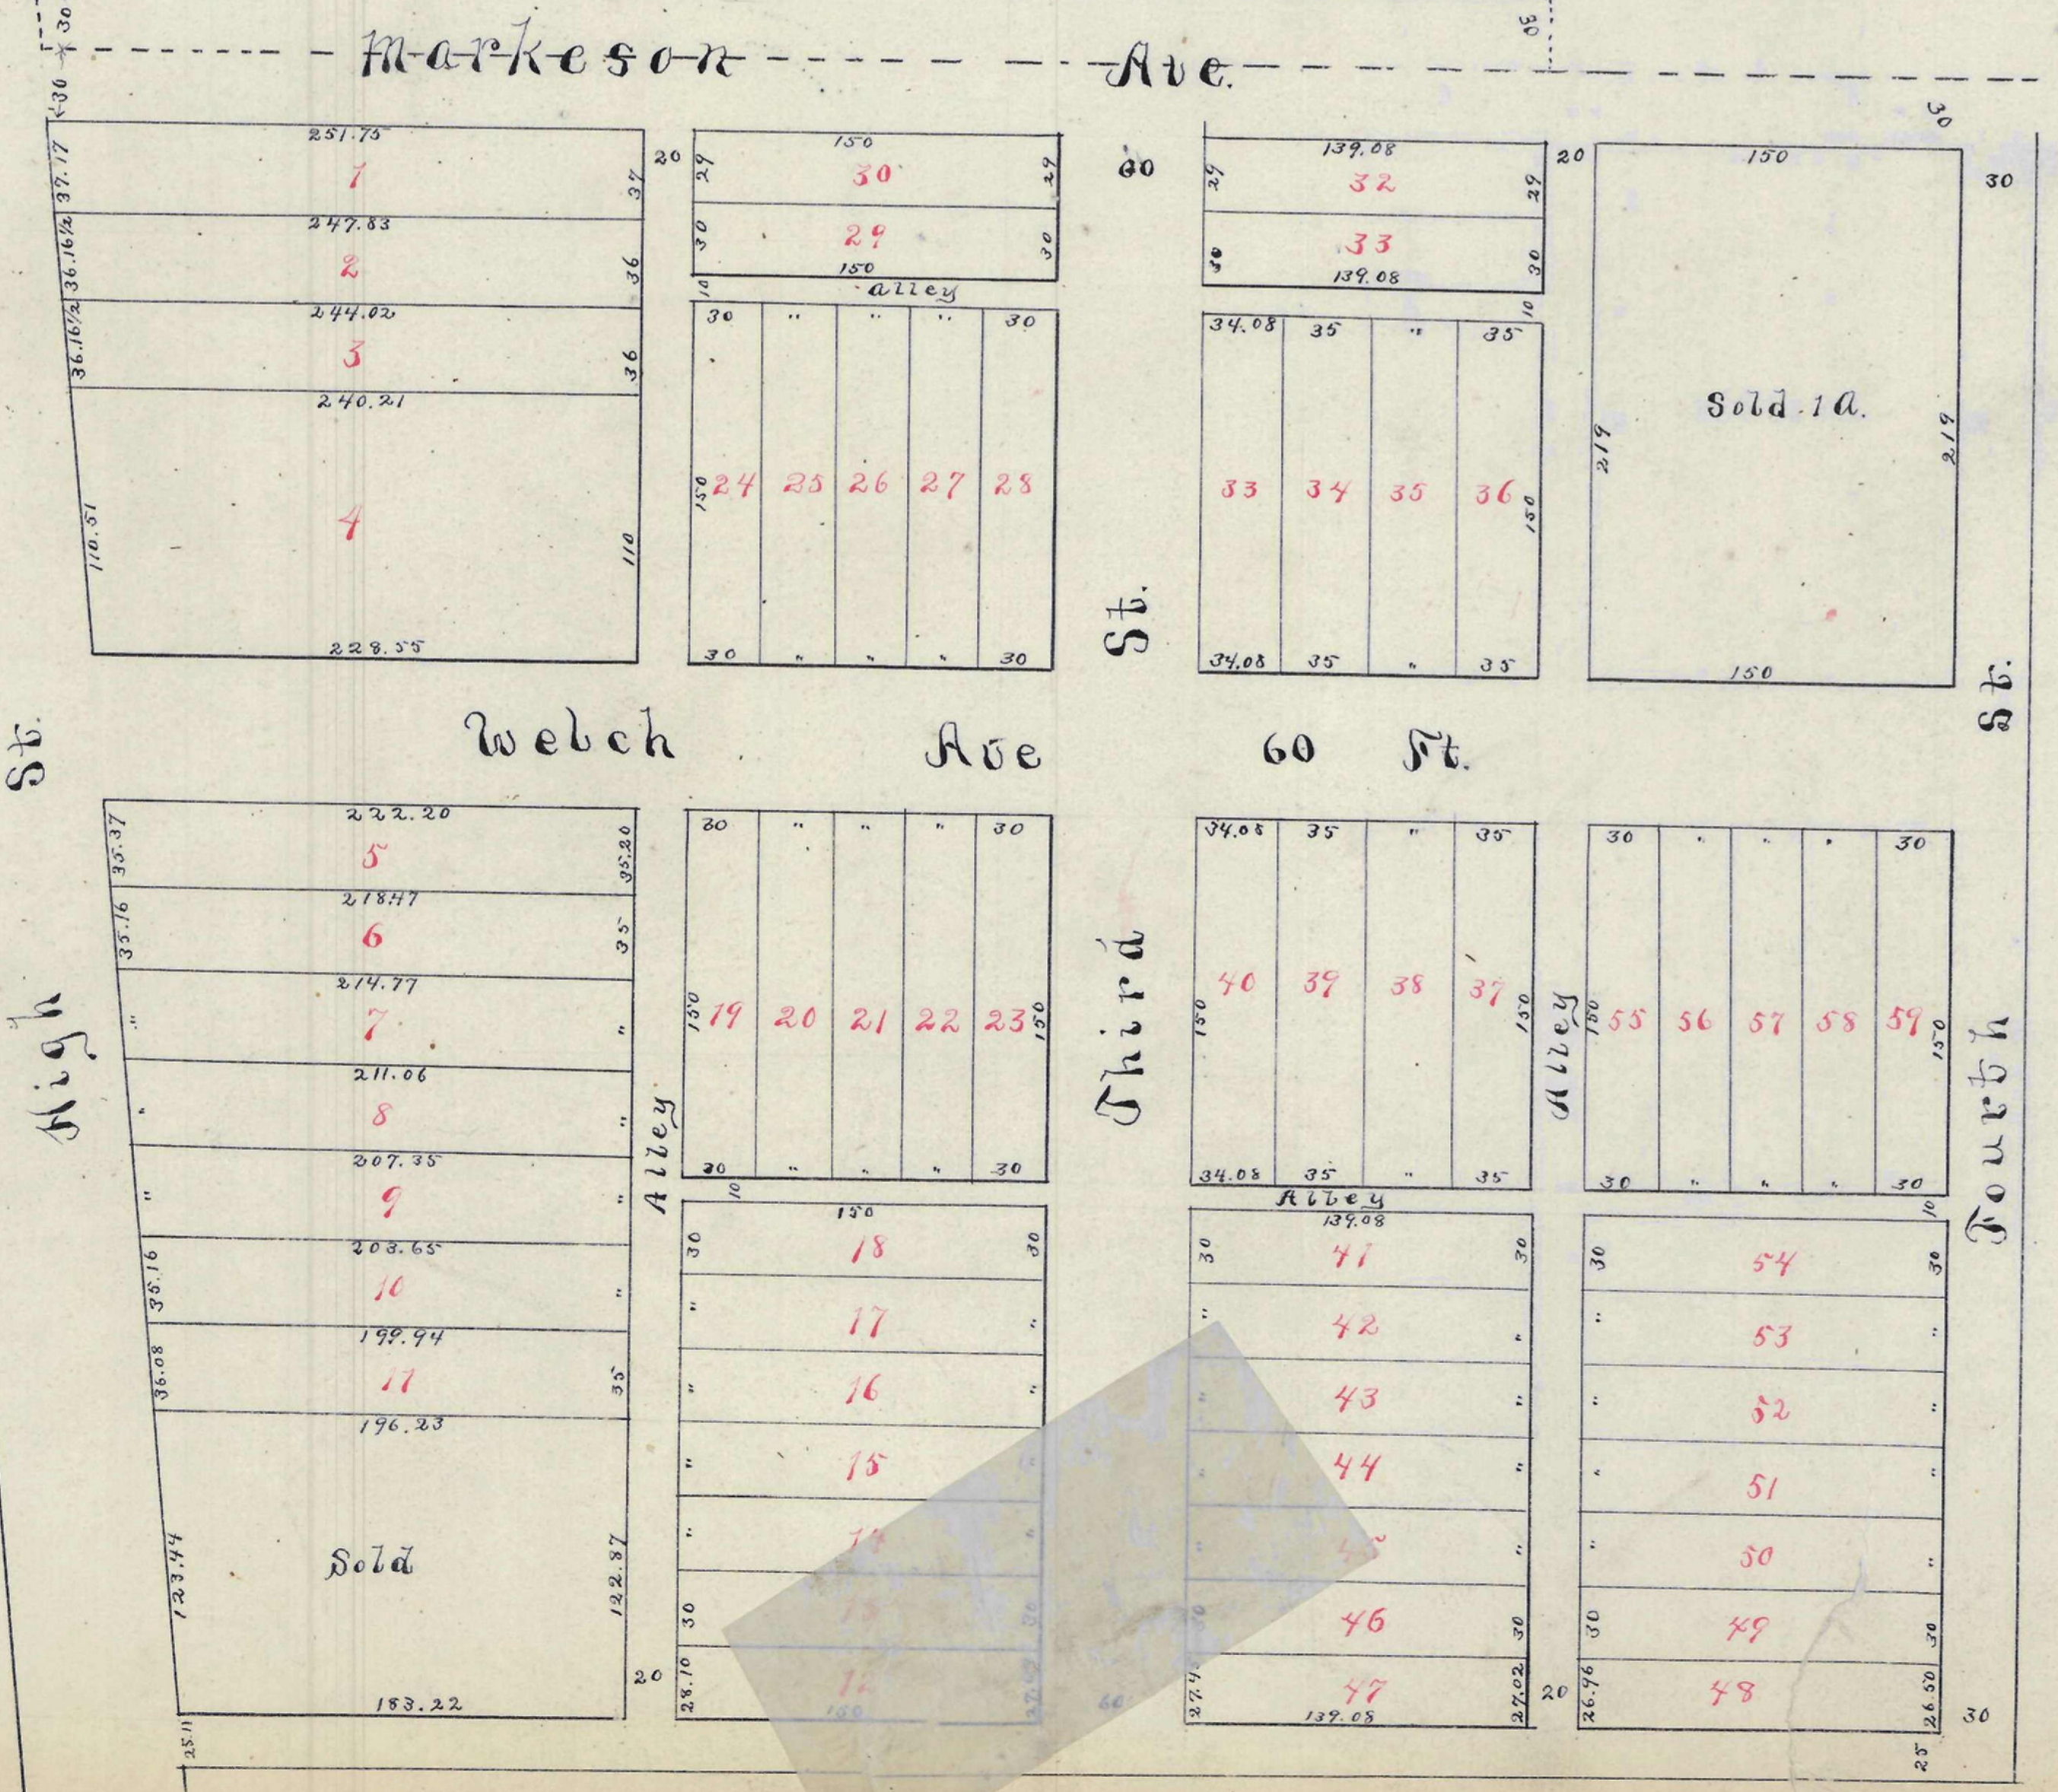

D. B. Welch's Marion Sp.
 Subdivision.
 INDEX J. Kinnear F. Co. S.

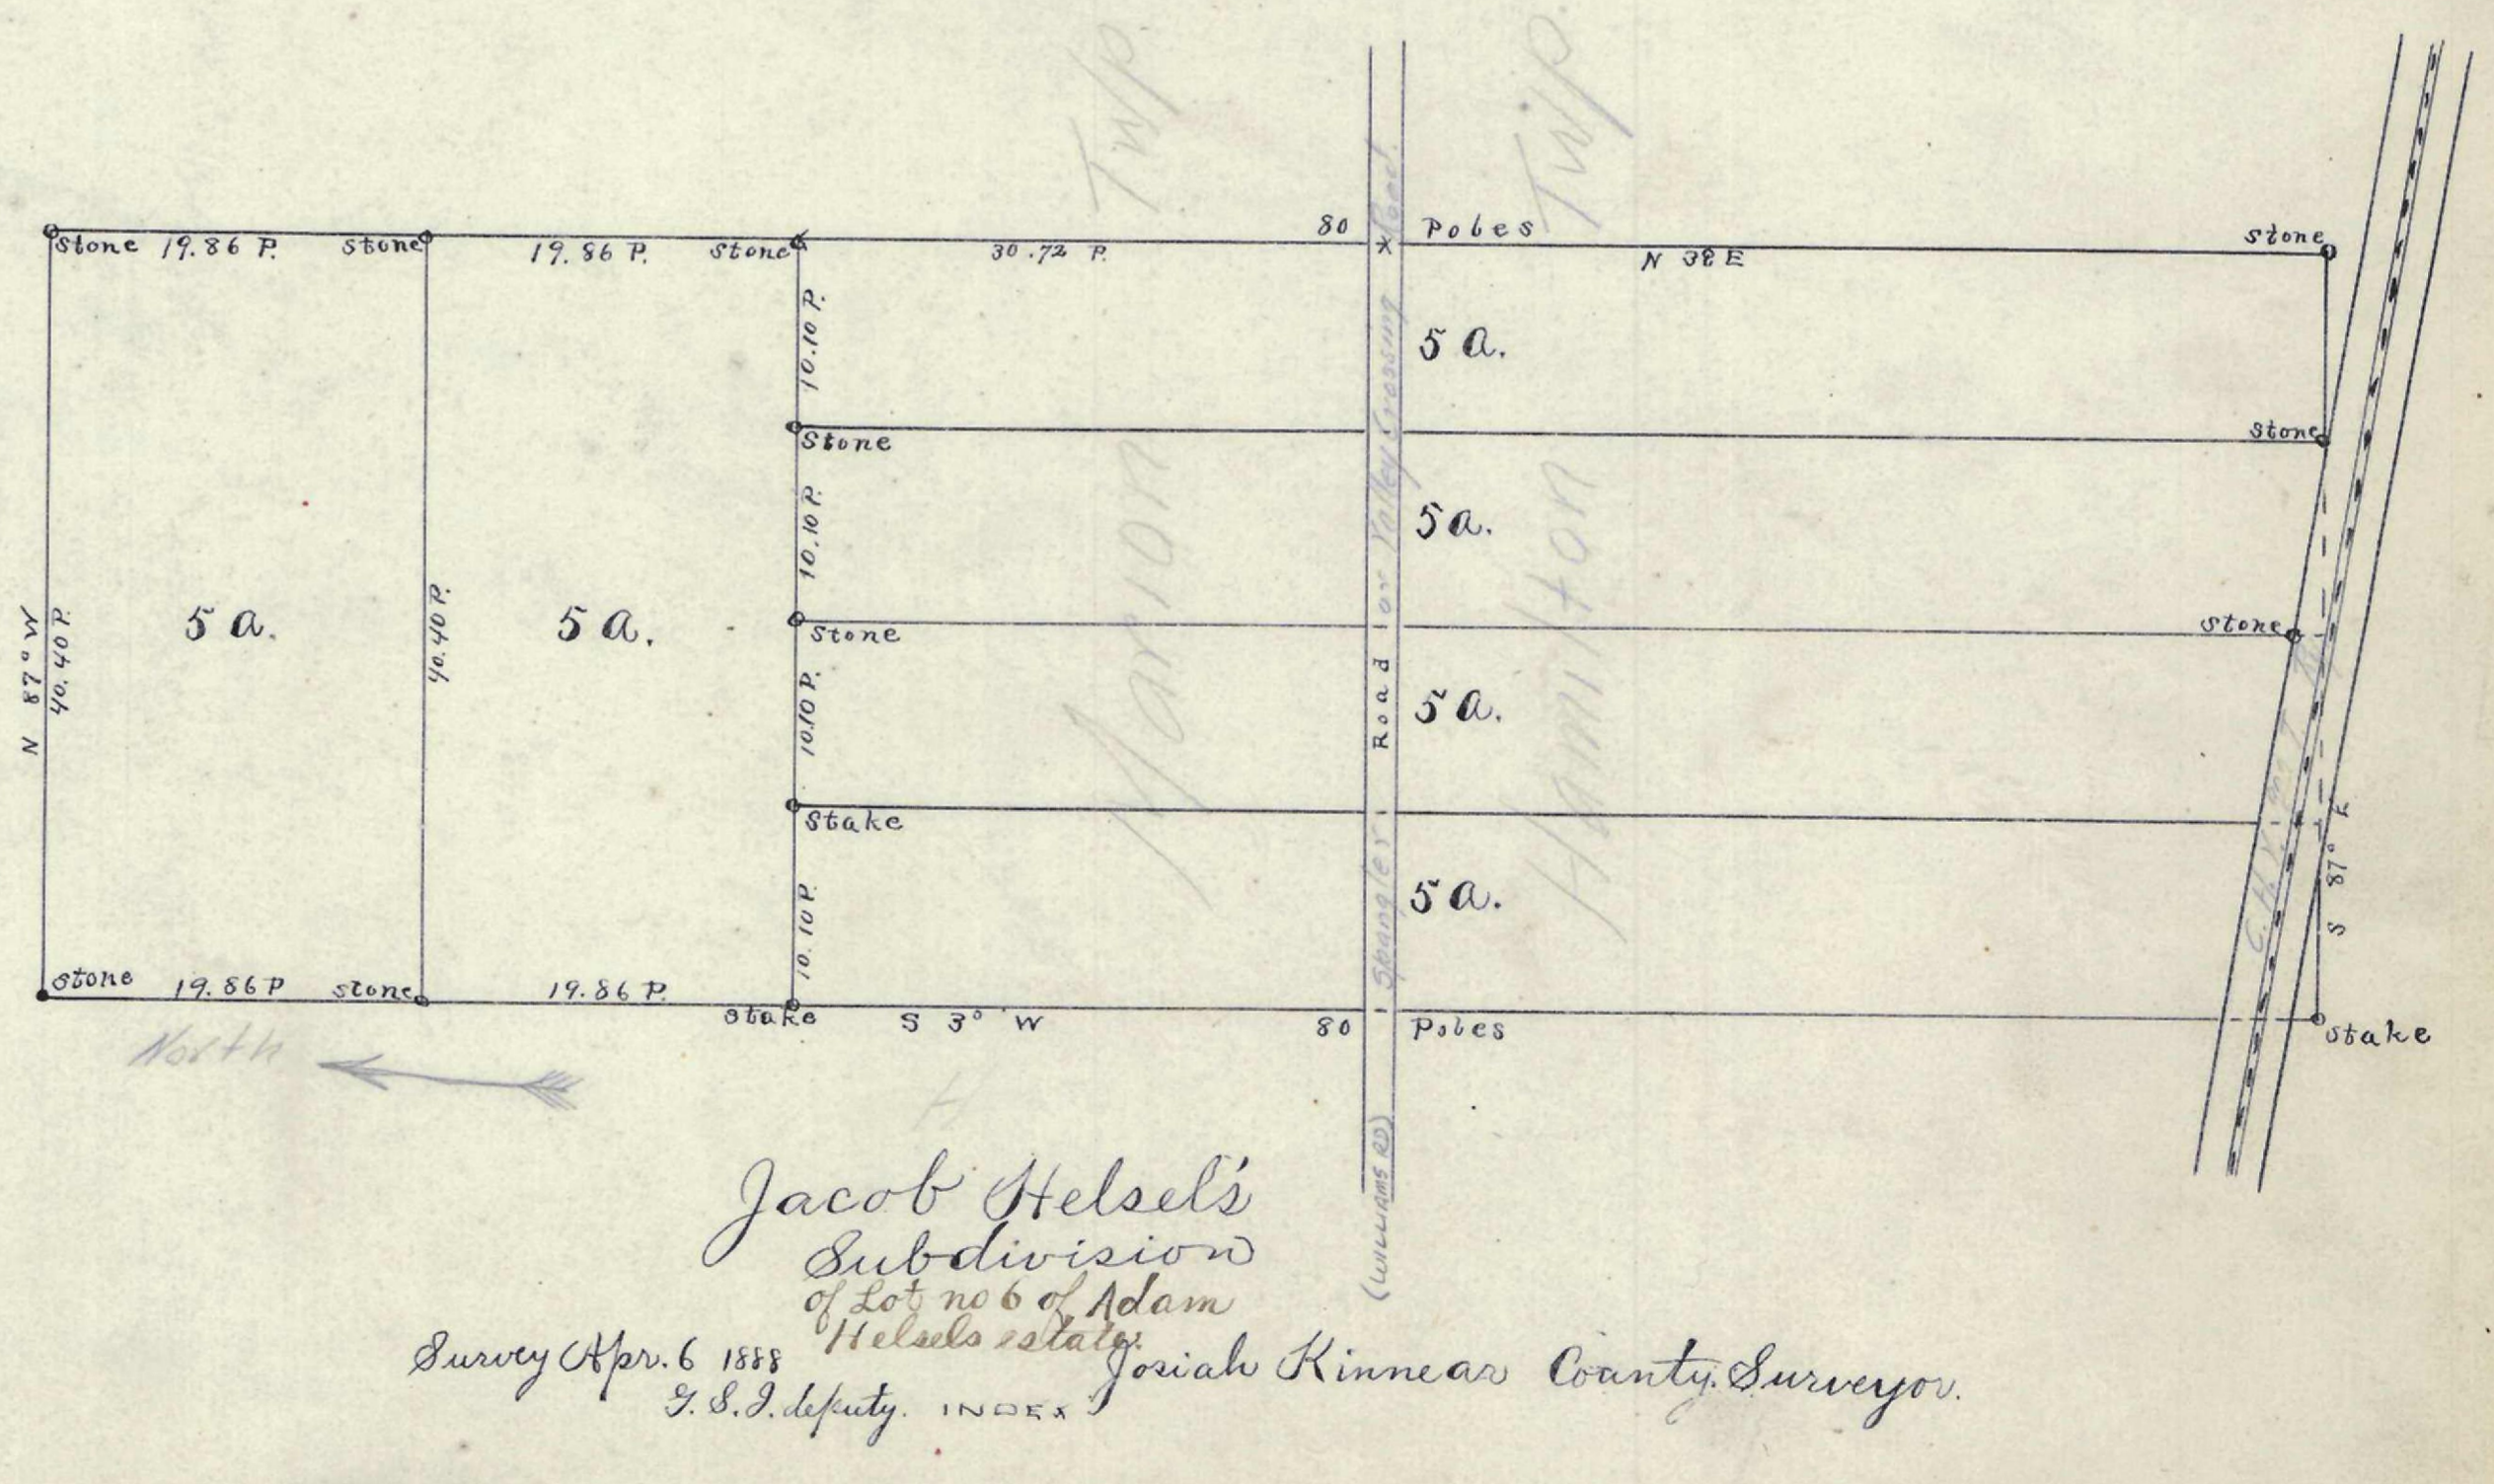

Jacob Helsel's
 Subdivision
 of lot no 6 of Adam
 Helsel's estate.
 Survey Apr. 6 1888
 J. S. J. Deputy INDEX Josiah Kinnear County Surveyor.