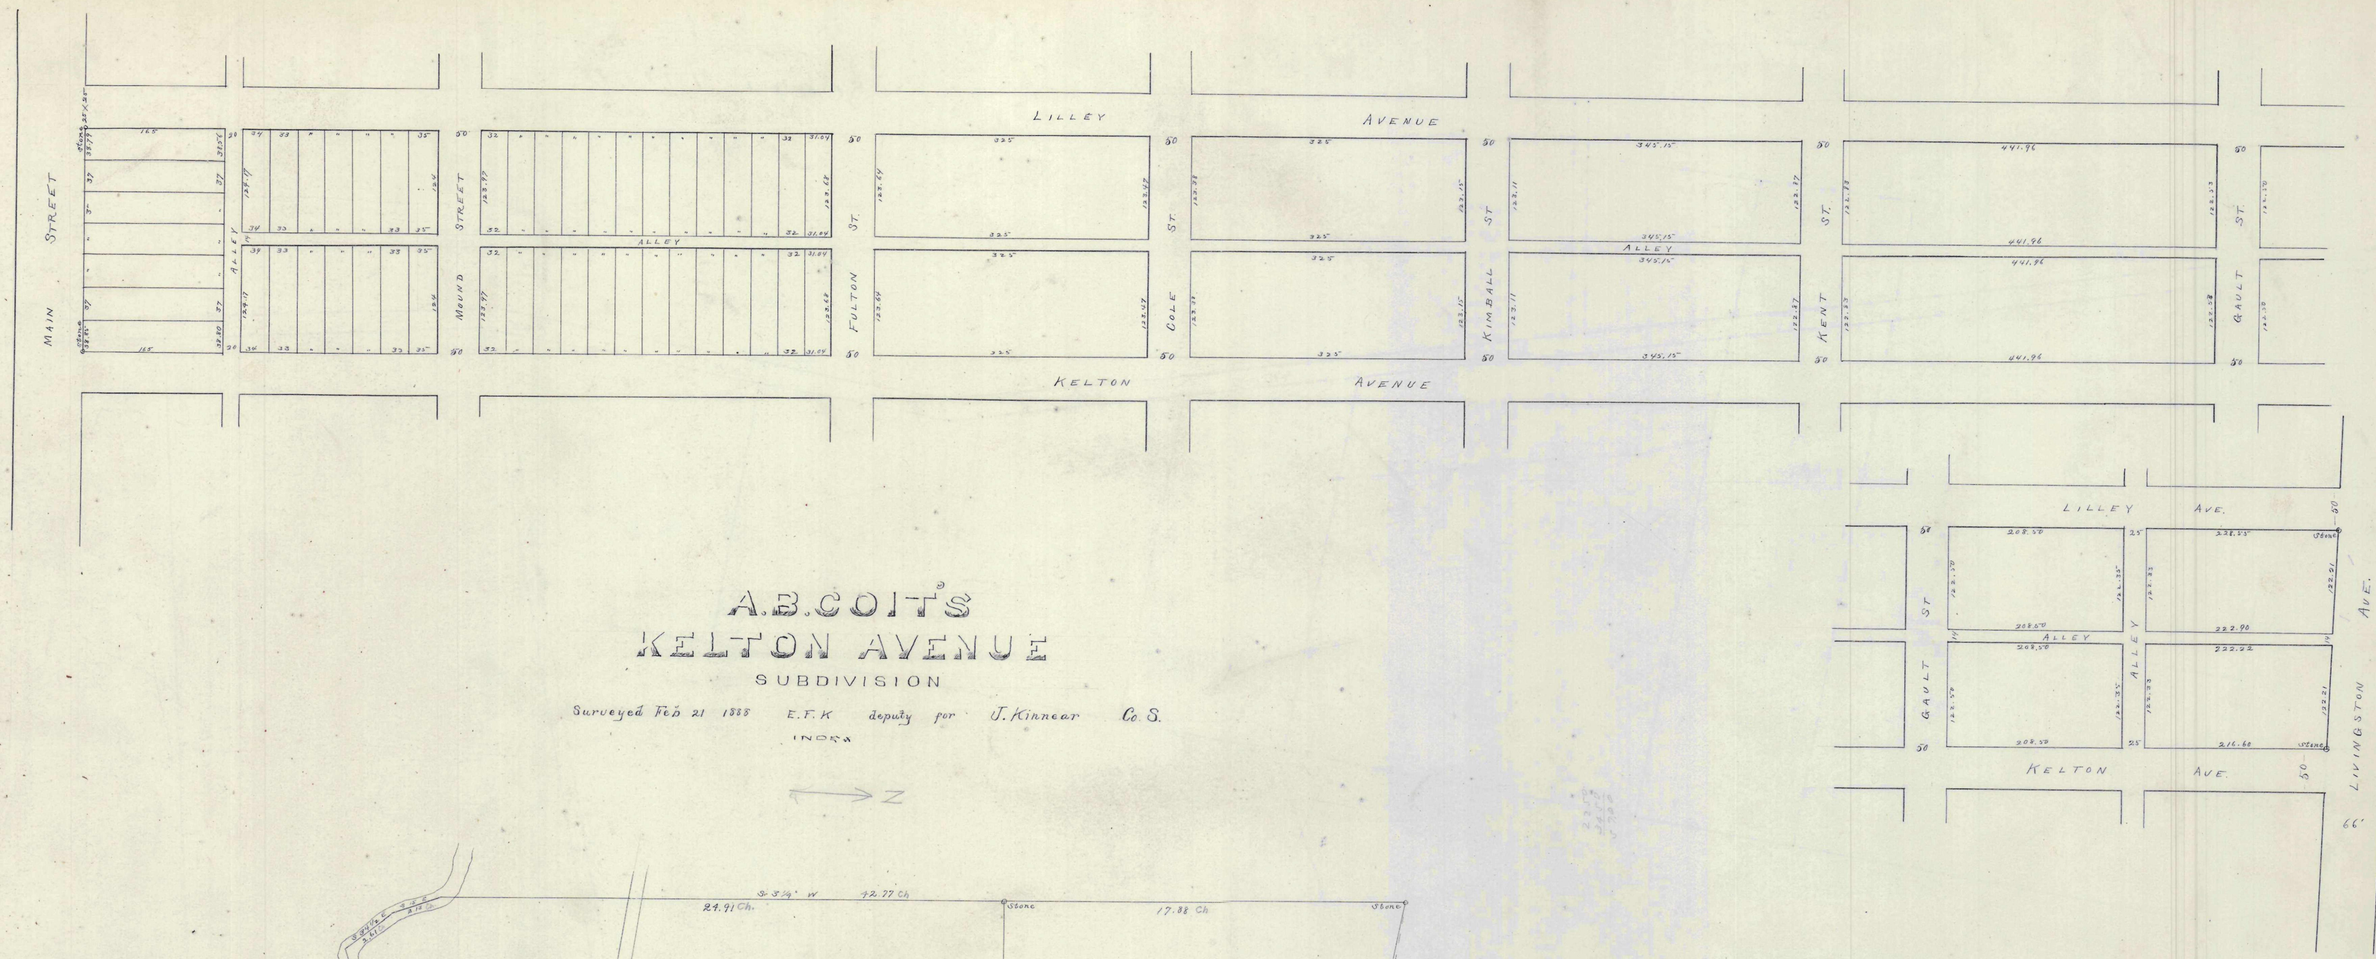

A.B.COIT'S KELTON AVENUE SUBDIVISION

Surveyed Feb 21 1888 E.F.K deputy for J. Kinnear Co. S.

INDEX

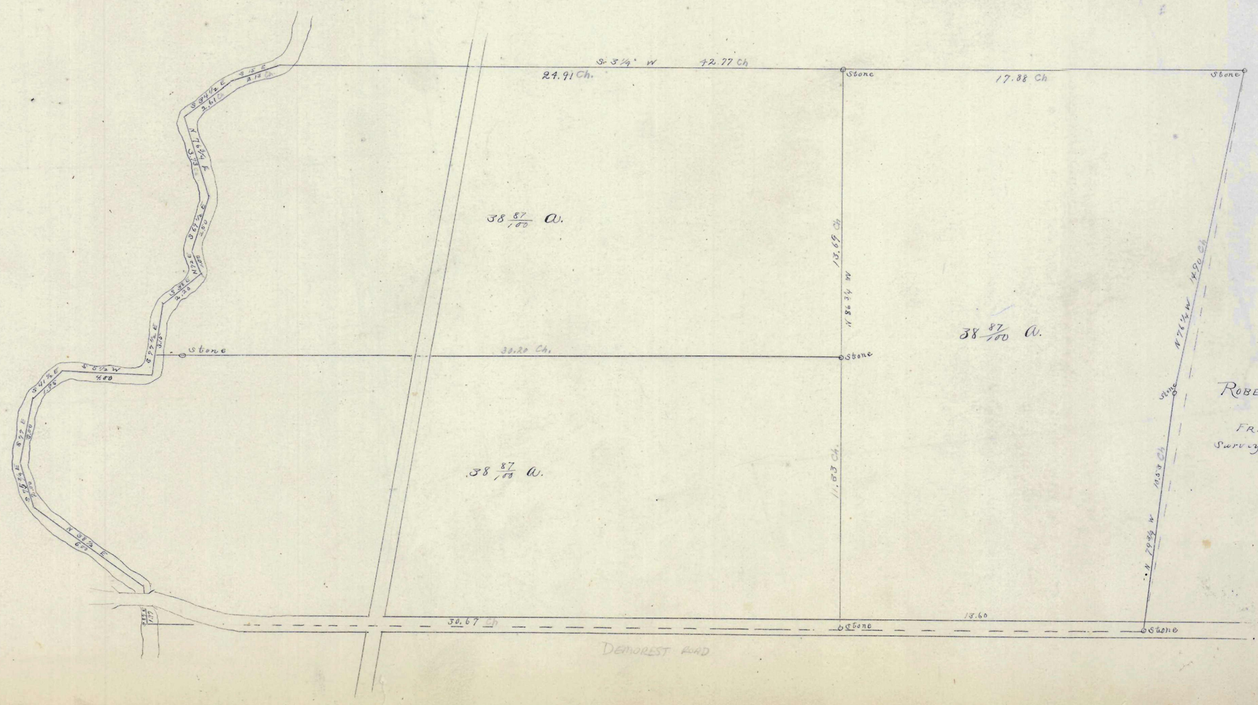

PLAT OF THE ROBERT D. ANDERSON FARM

FRANKLIN TP

Survey Apr 26 '88 C.S.I. deputy for J. Kinnear Co. S.

INDEX

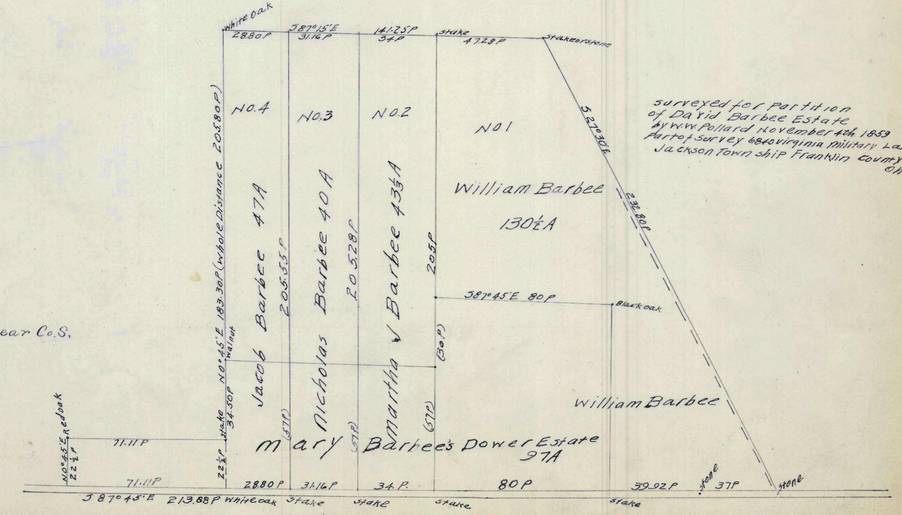

Surveyed for partition of David Barbee Estate by W.W. Pollard November 4th 1859 Area: Survey 6800 Virginia Military Lands Jackson Town Ship Franklin County Ohio