PLAT OF R. 18. T. 1. S. 2.

surveyed and conducted Oct. 31. 1809. for John Rathbone of New York by James Kilbourne District Surveyor. Nov. '19.

By W. Brown INDEX
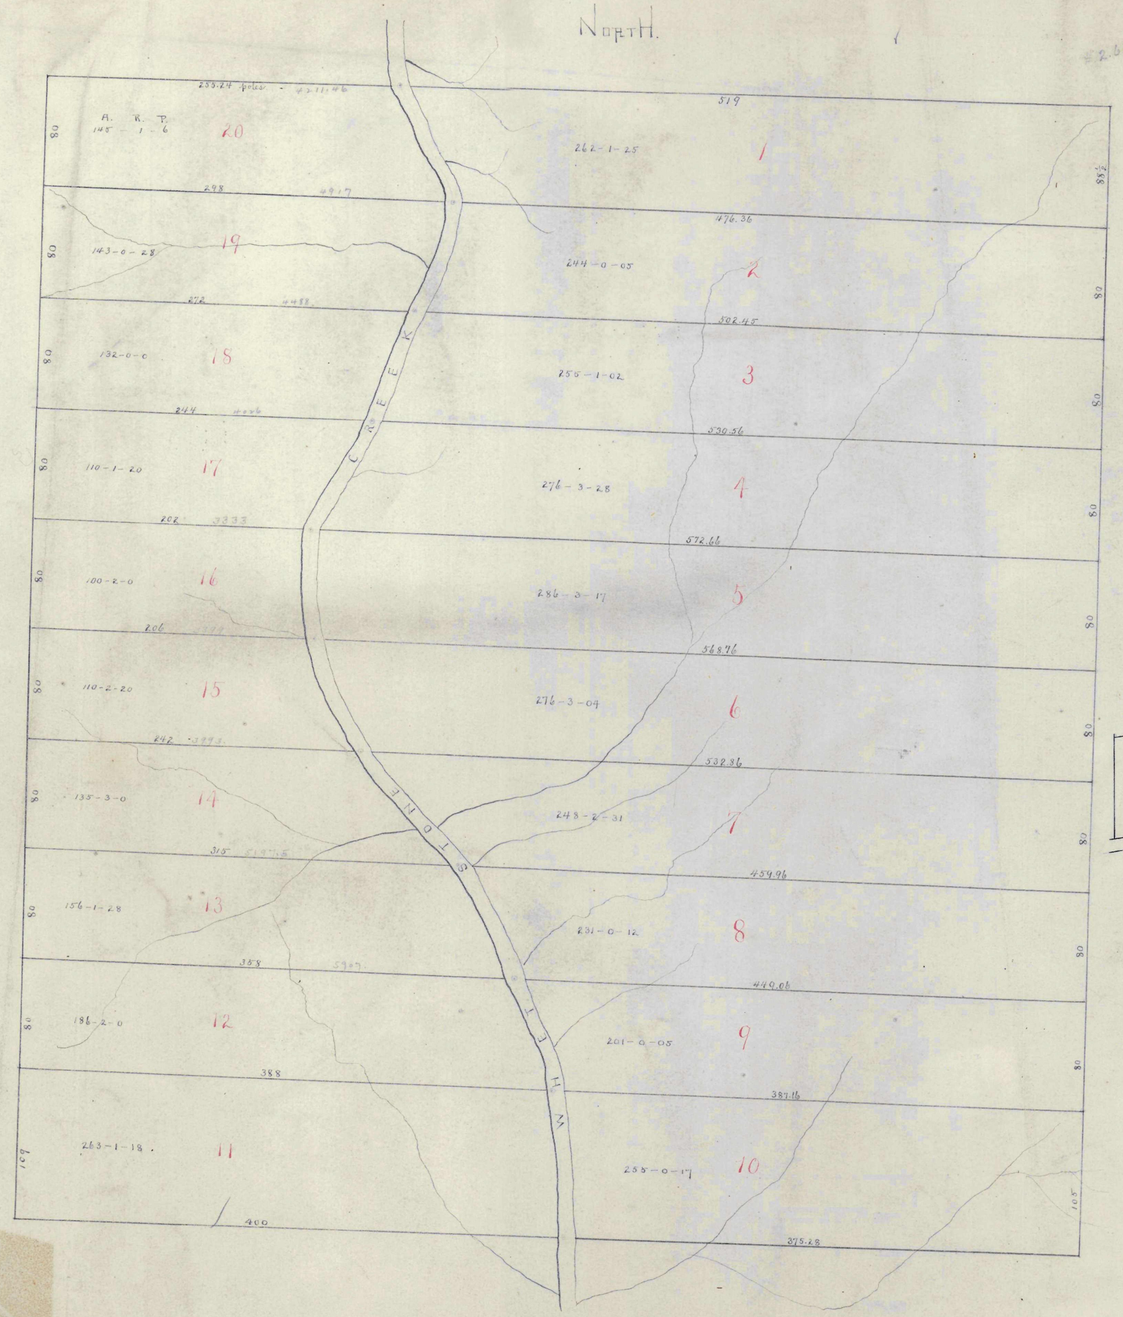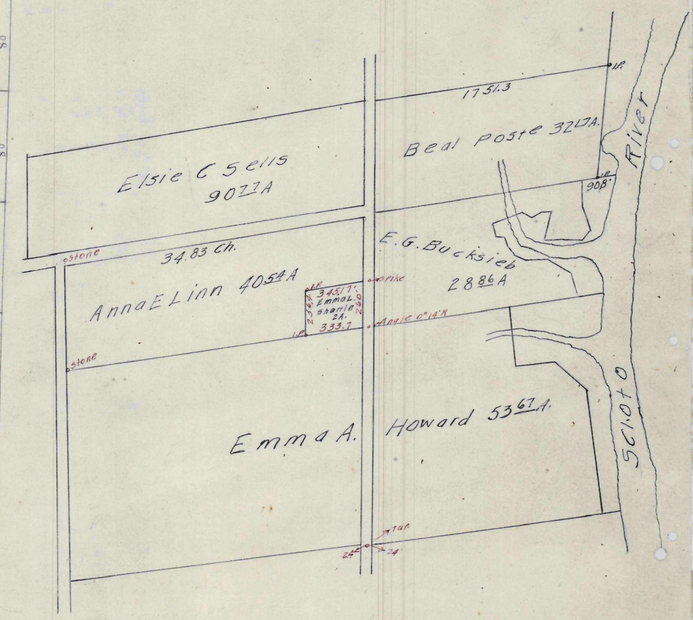
Tpe. 18. Twp. 1, N.W. 1/4 Tp #2. Clinton Twp.